

# California High-Speed Train Project



## Request for Proposal for Design-Build Services

**RFP No.: HSR 11-16  
Geotechnical Data Report  
HYBRID Alternative  
Ave 17 to Veterans Blvd  
Part 2 of 2**

# CALIFORNIA HIGH-SPEED TRAIN

## Engineering Reports

Record Set  
15% Design Submittal

**Merced to Fresno Section**

## Geotechnical Report UPRR/SR99 Alternative

May 2011



 **CALIFORNIA**  
High-Speed Rail Authority

 **U.S. Department of Transportation**  
Federal Railroad Administration





PRELIMINARY GEOTECHNICAL REPORT  
**A2-UPRR/SR99 ALIGNMENT**  
**CALIFORNIA HIGH-SPEED TRAIN PROJECT**  
**(MERCED - FRESNO SECTION)**  
MERCED-MADERA-FRESNO, CALIFORNIA



For

**AECOM TRANSPORTATION**  
2020 L Street, Suite 300  
Sacramento CA, 95811



**PARIKH CONSULTANTS, INC.**  
2360 Qume Drive, Suite A, San Jose, CA 95131  
(408) 452-9000

June 1, 2010

Job No. 209138.10

## TABLE OF CONTENTS

	PAGE
<b>1.0 INTRODUCTION.....</b>	<b>1</b>
<b>2.0 REVIEW OF EXISTING DATA .....</b>	<b>2</b>
<b>3.0 GEOLOGIC SETTING.....</b>	<b>2</b>
3.1 REGIONAL GEOLOGY AND SOILS .....	2
3.2 LOCAL GEOLOGY AND SOILS .....	3
3.3 REGIONAL SEISMICITY .....	6
3.4 REGIONAL SIGNIFICANT ACTIVE FAULTS .....	7
<b>4.0 SITE CONDITIONS.....</b>	<b>8</b>
4.1 GENERAL SURFACE CONDITIONS .....	8
4.2 SURFACE-WATER HYDROLOGY .....	8
4.3 GENERAL SUBSURFACE SOIL CONDITIONS .....	9
4.4 GENERAL GROUNDWATER CONDITIONS .....	9
<b>5.0 PRELIMINARY EVALUATIONS AND RECOMMENDATIONS.....</b>	<b>9</b>
5.1 GEOLOGIC HAZARDS .....	10
5.1.1 <i>Fault Rupture</i> .....	10
5.1.2 <i>Seismic Ground Shaking</i> .....	10
5.1.3 <i>Liquefaction</i> .....	11
5.1.4 <i>Lateral Spreading</i> .....	11
5.1.5 <i>Slope Instability</i> .....	12
5.1.6 <i>Subsidence</i> .....	12
5.1.7 <i>Collapsible Soils</i> .....	13
5.1.8 <i>Expansive Soils</i> .....	13
5.1.9 <i>Erosion</i> .....	13
5.2 NATURAL CHEMICAL HAZARDS – CORROSION POTENTIAL .....	14
5.3 FOUNDATION SUPPORT FOR BRIDGE STRUCTURES .....	15
5.3.1 <i>Bridge Structures - Fresno County</i> .....	15
5.3.2 <i>Bridge Structures - Madera County</i> .....	19
5.3.3 <i>Bridge Structures - Merced County</i> .....	32
5.3.4 <i>Seismic Design Considerations</i> .....	49
<b>6.0 ADDITIONAL GEOTECHNICAL EXPLORATIONS AND STUDIES.....</b>	<b>50</b>
<b>7.0 LIMITATIONS .....</b>	<b>50</b>
PROJECT LOCATION MAP.....	Plate 1
GEOLOGIC MAP AND SITE PLAN .....	Plate 2
FAULT MAP .....	Plate 3
GENERAL GROUNDWATER CONDITIONS .....	Plate 4
REPRESENTATIVE DESIGN MCE SPECTRA .....	Plate 5

### Appendix A

LOGS OF TEST BORINGS – REFERENCE BORINGS





**PRELIMINARY GEOTECHNICAL REPORT  
A2-UPRR/SR99 ALIGNMENT  
CALIFORNIA HIGH-SPEED TRAIN PROJECT  
(MERCED - FRESNO SECTION)  
MERCED-MADERA-FRESNO, CALIFORNIA**

## **1.0 INTRODUCTION**

This report presents the results of our preliminary geotechnical data analyses for the Merced – Fresno Section of California High-Speed Train Project located along State Route (SR) 99 within the following three Counties: Merced, Madera and Fresno in the southeastern portion of the Central Valley of California as indicated on the Project Location Map, Plate 1.

Based on the information published on the official website of The California High-Speed Rail Authority (Authority) (<http://www.cahighspeedrail.ca.gov/>), the Authority is proposing an 800 mile-long high-speed train system that would connect the San Francisco Bay Area and Sacramento in the north, through the Central Valley to Los Angeles, Orange County and San Diego in the south. This fast, safe and reliable system is forecast to carry 93 million passengers annually by the year 2030. Comprehensive program-level environmental studies to determine overall route and station locations were completed in 2005 and 2008. The November 2008 California voter approval of \$9.95 billion in bonds helped to move the program forward and project-specific environmental studies are now underway.

The Merced to Fresno section of the High-Speed Train (HST) system is 60 miles long and includes the junction that permits high-speed trains to be routed either to Sacramento or San Francisco in the north. Proposed route alternatives generally follow either the Burlington Northern Santa Fe (BNSF), the Union Pacific (UP) railroads or a new alignment a few miles west of SR 99 throughout the section. HST stations are proposed in Downtown Merced and Fresno and a heavy maintenance and repair facility will be evaluated in the Merced to Fresno HST project area. The study of this report is mainly focused on the corridor which is 0.5 mile on both sides of SR 99 (1 mile wide). All Post Mile (PM) numbers referred to in this report are PM along SR 99.

The scope of services of Parikh Consultants, Inc. included the following main elements:

1. Research available literature and geotechnical studies within the project limits for use to identify and resolve geotechnical-related design and cost issues;
2. Discuss preliminary Geotechnical (Typical Foundation Design) recommendations based on available geotechnical data.



## **2.0 REVIEW OF EXISTING DATA**

The subsurface conditions along the proposed alignment were studied by reviewing readily available existing subsurface data. A variety of published and unpublished references related to geotechnical, geologic, and seismic conditions along the alignment were reviewed. Subsoil information was collected mainly from the following three (3) sources:

1. Logs of Test Borings (LOTBs) in Caltrans As-Built plans for existing bridges along SR 99;
2. LOTBs from Geotracker (<http://geotracker.swrcb.ca.gov/>). Geotracker is a database and geographic information system (GIS) that provides online access to underground storage tank leak case data.
3. Several geotechnical investigations conducted for projects in the immediate vicinity of the alignment by Parikh Consultants, Inc.

Geotechnical data collected from previous investigations are listed in the table of Bridge and Reference Project List in Appendix A. The approximate project locations are shown in the Geologic Map and Site Plan (Plate 2). The projects are referenced from Fresno County moving north to Merced County. Details of the subsurface conditions encountered at each boring location are presented in Appendix A. Where appropriate, data from these explorations have been used to evaluate the subsurface conditions along the alignment and provide preliminary geotechnical engineering recommendations.

## **3.0 GEOLOGIC SETTING**

### **3.1 Regional Geology and Soils**

The Project Site is located in the southeastern portion of the Great Valley geomorphic province, a relatively flat alluvial plain composed of a deep sequence of sediments in a bedrock trough. The Great Valley is bounded on the west by the South Coast Ranges and on the east by the Sierra Nevada Mountains. Erosion of the South Coast Ranges and the Sierras has produced the sediments deposited in the Great Valley. Deposition in the Valley was mainly marine until the beginning of the Pliocene epoch (approximately 5.3 million years ago) when the Valley's seas retreated beyond the Carquinez Strait and were replaced by freshwater rivers and lakes. Today, the Valley is drained by the Sacramento River from the north and the San Joaquin River from the south. Geographically



**AECOM Transportation**

Job No. 209138.10 (A2-UPRR/SR99 Alignment, California High-Speed Train Project, Merced – Fresno Section)

June 1, 2010

Page 3

and topographically, the Valley has been shaped by the Sacramento and San Joaquin Rivers and their tributaries. The rivers meet approximately 35 miles south of Sacramento and discharge through the Sacramento–San Joaquin Delta into San Francisco Bay and the Pacific Ocean.

A series of predominately nonmarine Tertiary clastic deposits rest upon granite and metamorphic basement along the northeastern margin of the San Joaquin Valley and Cretaceous marine sedimentary rocks at depth beneath the valley floor. Bedding within these sediments generally dip gently southwestward beneath the alluvial deposits which cover most of the valley bottom.

The North Merced pediment is an erosional surface of low relief that cuts across a variety of rock types with regional extent and is covered by a thin (usually less than 2 meters thick) deposit of coarse locally derived gravel (North Merced Gravel) that appears to have been deposited in a semiarid climate similar to that of the present. Subsequently, younger deposits were laid down on topography that had been deeply incised into the North Merced surface.

Soil development in these well-drained relatively uneroded arkosic parent materials of similar grain size distribution shows several trends with increasing age: (1) increased thickness of horizons and depth to fresh parent material, (2) redder hues, (3) brighter chromas, (4) lower pH, (5) sharper definition of horizon boundaries and more horizons, and (6) sequential development of Cox, AC, cambic B, weak argillic horizons and finally, a very strong argillic horizon.

### **3.2 Local Geology and Soils**

General geologic features pertaining to the site were evaluated by reference to the Generalized Geologic Map of the Merced-Madera Area, Northeastern San Joaquin Valley, California (PLATE 1) in Late Cenozoic Stratigraphic Units, Northeastern San Joaquin Valley, California; U.S. by Marchand, D.E.; and Allwardt, A.; 1981; Geological Survey Bulletin 1470. Refer to Plates 2-1 through 2-22.

Soils mapping and related data for Madera Area (CA651) and Eastern Fresno Area (CA654) were acquired from the Natural Resources Conservation Service (NCRS) website (<http://websoilsurvey.nrcs.usda.gov/app/WebSoilSurvey.aspx>) by U.S. Department of Agriculture, NRCS (formerly the Soil Conservation Service). Refer to Plates 2-23 through 2-27.



**AECOM Transportation**

Job No. 209138.10 (A2-UPRR/SR99 Alignment, California High-Speed Train Project, Merced – Fresno Section)

June 1, 2010

Page 4

In general, the mapped geologic units within the project corridor include (from oldest to youngest) the Turlock Lake, Riverbank, and Modesto Formations and post-Modesto Deposits.

The Modesto, Riverbank, and Turlock Lake Formations are all Pleistocene in age and comprise the major surface and near-subsurface stratigraphic and lithologic units in the project area. These three formations are similar because of the arkosic nature of their sand and silt fractions, a tendency toward upward coarsening sedimentation cycles, deposition as sequential overlapping alluvial terrace and fan systems, and probable glacial origin of most of the sediment. However, they may be distinguished from each other on the basis of soil profile development, topographic position and expression, local lithologic differences, and unconformities associated with buried soils. These stratigraphic units represent separate alluvial episodes, recorded by fill terraces opening westward onto alluvial fans. Substantial time intervals between periods of aggradation are represented by buried paleosols.

Deposits younger than the Turlock Lake Formation occur as a series of nested terraces incised into older deposits near the Sierra Nevada foothills and opening westward onto alluvial fans. Each alluvial fan commonly spills out west of and over the next oldest fan, such that the youngest fans are found close to the San Joaquin River and the oldest fans have their heads near the foothills to the east. Toward the basin, depositional surfaces converge so that soils and superposition of deposits separated by buried soils are the primary distinguishing criteria. However, lateral and vertical lithologic variations within a single unit are frequently more pronounced than differences between units.

These formations are similar to one another in four respects: (1) the arkosic nature of their sand and silt fraction, (2) a tendency toward upward coarsening sedimentation cycles, (3) deposition as sequential overlapping alluvial terrace and fan systems, and (4) probable glacial origin of much of the sediment.

These formations differ in age, topographic expression, geomorphic position, post-depositional soil development, and geographic occurrence. Some minor lithological differences in present surface exposures are apparent although not necessarily significant: well-stratified silt and fine sand seem to be more commonly exposed in both units of the Turlock Lake Formation and the Modesto Formation than in the three units of the Riverbank Formation; gravel tends to be common in both members of the Modesto Formation and in the upper part of the lower Turlock Lake but



**AECOM Transportation**

Job No. 209138.10 (A2-UPRR/SR99 Alignment, California High-Speed Train Project, Merced – Fresno Section)

June 1, 2010

Page 5

less abundant in the upper unit of the Turlock Lake and in the Riverbank. The gravel in the upper member of the Modesto is confined to relatively narrow channels and may reflect reworking of coarse fragments from older deposits.

Following are generalized descriptions of the four geologic units (from the oldest to the youngest) that are exposed within the project area. Refer to Plates 2-1 through 2-23 for the mapped extent of each unit within the project area.

***Turlock Lake Formation:*** The Turlock Lake Formation overlies the North Merced Gravel Formation and forms extensive subsurface deposits throughout the San Joaquin Valley. It is the oldest unit exposed in the project area.

The Turlock Formation consists primarily of arkosic alluvium, mostly fine sand, silt, and in places clay at the base grading upward into coarse sand and occasional coarse pebbly sand or gravel. The pebbles are of granitic as well as metamorphic, volcanic, and quartz-vein rocks and are in most places not as large nor as abundant as those in the underlying older units. The gravel and sand beds are typically massive, lenticular, cross-bedded, and difficult to trace laterally. The beds of finer grained sediment are commonly well-sorted, well stratified, and internally laminated. In many places the beds contain virtually unweathered grains of micas, feldspars, and mafic minerals. The Turlock Lake Formation slopes westward beneath the overlying younger alluvial deposits at a very gentle gradient of about 3 meters per kilometer. Its thickness varies from 50 to 230 meters in the Chowchilla area, thickening toward the west.

The Turlock Lake Formation was deposited between 1,000,000 and 600,000 years before present.

***Riverbank Formation:*** The Riverbank Formation underlies the Modesto Formation and is composed of heterogeneous sediments that are poorly sorted with a variety of mineralogies. It consists primarily of sand containing some scattered pebbles, gravel lenses, and some interbedded fine sand and silt.

The Riverbank Formation consists primarily of arkosic sediment derived mainly from weathering and erosion the interior of the Sierra Nevada granite batholith. Its terraces and fans truncate or cut into Turlock Lake alluvium or fill in post-Turlock Lake gullies and ravines. They slope gently toward the west beneath fan deposits of early Modesto age.





## **AECOM Transportation**

Job No. 209138.10 (A2-UPRR/SR99 Alignment, California High-Speed Train Project, Merced – Fresno Section)

June 1, 2010

Page 6

The Riverbank Formation is similar to the overlying Modesto Formation in its distinguishable features but is more massively bedded with a few gradational bedding planes.

The Riverbank Formation was deposited between about 450,000 and 130,000 years before present.

**Modesto Formation:** The Modesto Formation and the associated post-depositional alluvium comprise the youngest unit of the alluvial fans that blanket much of the project area. These deposits cover a large part of the central San Joaquin Valley, and include fan, axial basin, and river channel deposits. In the project area, Modesto Formation sediments are generally a 10 to 30 feet thick veneer that shows little if any erosional modification. The Modesto Formation is a heterogeneous unit comprised of a wide spectrum of mineralogies, principally of granitic and metamorphic origins but include some volcanics. Modesto Formation is typically massive, without any distinguishable gradational bedding planes.

The Modesto Formation was deposited between 100,000 and 9,000 years before the present.

**Post-Modesto Deposits:** Holocene deposits that have been deposited upon the Modesto Formation in the northeastern San Joaquin Valley are located close to modern drainageways. Most small foothill streams have not built post-Modesto fans. In general, post-Modesto deposits are relatively thin and essentially unweathered, having been laid down within the past 8,000 years.

Weathering has produced soils on the geologic units described above. Detailed soil survey mapping has been completed over the entire project area. Soils units mapped within the southern portion of the project area (not covered by the USGS geologic map in Bulletin 1470) include the sandy loams and loams of the Delhi, Exeter, Hanford, Hesperia, and San Joaquin Series. Refer to Plates 2-23 through 2-27.

### **3.3 Regional Seismicity**

The proposed corridor is located within the Great Valley seismo-tectonic province, a region of relative seismic quiescence and tectonic inactivity. This is bounded to the west by the seismically-active central Coast Ranges. The Coast Ranges are traversed by faults of the San Andreas Fault system, including the San Andreas Fault itself, as well as several other active faults.



**AECOM Transportation**

Job No. 209138.10 (A2-UPRR/SR99 Alignment, California High-Speed Train Project, Merced – Fresno Section)

June 1, 2010

Page 7

These faults accommodate the movement between the Pacific and North American tectonic plates, which has been the source of a number of large, damaging earthquakes during historic time.

The Fault Map, Plate 3, shows the approximate position of the major fault zones, and the location of the Project Site in relation to them. The following table (Summary of Major Faults Affecting the Project Site) contains the estimated parameters for earthquakes on several known faults affecting the vicinity.

**Summary of Major Faults Affecting the Project Site**

<b>Fault Name</b>	<b>Fault ID</b>	<b>Type</b>	<b>Mmax</b>	<b>Distance KM / mile</b>
San Andreas Fault Zone	310, 311, 312	RLSS	7.9	97.2 / 60.7
Calaveras fault zone (Paicines Fault)	324	RLSS	7.4	88.0 / 55.0
Calaveras fault zone (Southern Calaveras section)	323	RLSS	7.4	89.0 / 55.6
Sargent Fault (Southeastern section)	405	RLSS	6.8	92.5 / 57.8
Quien Sabe Fault zone	149	RLSS	6.4	81.0 / 50.6
Ortogonalita Fault	386, 387, 388, 389	RLSS	7.1	57.8 / 36.1
Owens Valley Fault	392, 391	RLSS	7.6	136.5 / 85.3

### **3.4 Regional Significant Active Faults**

The active or potentially active faults of most significance to the project are the San Andreas Fault Zone and Ortigalita Fault. Earthquakes originating on both of these faults have caused severe ground shaking at the site in the past and have the potential to do so in the future.

**San Andreas Fault:** The alignment is located approximately 60.7 miles (97.2 KM) northeast of the San Andreas Fault. This fault is the largest active fault in California and extends from the Gulf of California to Cape Mendocino in northern California. The 1906 San Francisco Earthquake originated along the San Andreas Fault and had a magnitude of Mw 7.9. The United States Geological Survey's Working Group (WGCEP, 2003) have estimated the probability of at least one earthquake with magnitude greater or equal to 6.7, occurring along San Andreas Fault before 2031, to be 21%.



**AECOM Transportation**

Job No. 209138.10 (A2-UPRR/SR99 Alignment, California High-Speed Train Project, Merced – Fresno Section)

June 1, 2010

Page 8

***Ortigalita Fault:*** The Ortigalita fault is a 41 miles (66 KM) long, north-northwest-striking, right-lateral strike-slip fault located in the southern Diablo Range, 36.1 miles (57.8 KM) southwest of the project site. The surface trace of the Ortigalita fault extends from Panoche to southeast of Mount Stakes. The fault consists of two distinct geometric segments, separated by a 3.1-mile (5 KM) wide right-step across San Luis Reservoir. Much of the fault is delineated by persistent micro-seismicity, the fault is marked by numerous indicators of recent strike-slip faulting, such as deflected drainages, shutter ridges, side-hill benches, and vegetation lineaments. The Maximum Credible Earthquake (MCE) for the Ortigalita fault is Mw 6.9, with an effective recurrence of 1100 years.

## **4.0 SITE CONDITIONS**

### **4.1 General Surface Conditions**

The Great Valley province comprises a large, elongated, north-trending valley situated between the Coast Ranges on the west and the Sierra Nevada on the east. Much of the Great Valley is at elevations near sea level. Although most of the valley is rural, it does contain urban cities such as Fresno, Madera, Chowchilla and Merced within the project limits.

The project site is generally between 170 and 300 feet above mean sea level, with rolling terrain of varying grades with occasional exposures of non-marine sediments. Based on the published information (<http://en.wikipedia.org/wiki/>), along the project alignment from south to north, the average elevations are approximately 296 feet (90 M) at Fresno area, 271 feet (83 M) at Madera area, 240 feet (73 M) in Chowchilla area and 171 feet (52 M) in Merced area.

### **4.2 Surface-Water Hydrology**

The San Joaquin River receives water from tributaries draining the Sierra Nevada and Coast Ranges, and except for streams discharging directly to the Sacramento–San Joaquin Delta, is the only surface-water outlet from the project area. The other main waterways within the project area are the Chowchilla River and the Fresno River. The surface-water distribution systems within the project area also include numerous creeks, canals and laterals.



### **4.3 General Subsurface Soil Conditions**

Soils throughout the project corridor are generally uniform. Alluvial sediments characteristics are layers of silty sand, clayey sand, and sandy silt, underlain by poorly graded sand (generally derived from erosion of decomposed granite) and sandy silt.

The project is located in the southeastern part of the San Joaquin Valley. Alluvial, Pleistocene non-marine, and other non-marine deposits of the eastern part of the valley were derived primarily from the weathering of granitic intrusive rocks of the Sierra Nevada, with lesser contributions from the sedimentary and metasedimentary rocks of the foothills. In the eastern part of the valley, sediments derived primarily from the Sierra Nevada are highly permeable, medium-to coarse-grained sands with low total organic carbon, forming broad alluvial fans where the streams enter the valley. These deposits generally are coarsest near the upper parts of the alluvial fans and finest near the valley trough. Dune sand consists of well-sorted medium-to-fine sand, as much as 140 feet thick.

Stream-channel deposits of coarse sand occur along the San Joaquin River and its major east side tributaries. In the valley trough, the stream-channel deposits are flanked by basin deposits of varying extent. The basin deposits are interbedded lacustrine, marsh, overbank, and stream-channel sediments deposited by the numerous sloughs and meanders of the major rivers. The soils that have developed on these deposits generally have a high clay content and low permeability.

### **4.4 General Groundwater Conditions**

Based on the USGS Water-Resources Investigation Report 97-4205, groundwater is generally within 10 to 50 feet of the land surface in the project area; this coincides roughly with the findings from review of existing geotechnical data in the project area. Please refer to Plate 4, General Groundwater Conditions for more details.

## **5.0 PRELIMINARY EVALUATIONS AND RECOMMENDATIONS**

The following preliminary evaluation and recommendations are based upon our understanding of the proposed construction and the findings from review of existing data. If the above-described project conditions are incorrect or changed subsequently, or subsurface conditions encountered



**AECOM Transportation**

Job No. 209138.10 (A2-UPRR/SR99 Alignment, California High-Speed Train Project, Merced – Fresno Section)

June 1, 2010

Page 10

during construction are significantly different from those reported, Parikh Consultants should be notified and these discussions and recommendations must be re-evaluated to make appropriate revisions. These preliminary discussions and recommendations are to assist in defining the overall design program. Detail studies will be required during the Design Phase of the project.

## **5.1 Geologic Hazards**

The following subsections discuss the potential geologic hazards that might exist in the project area based on the literature search and research of the existing data. More detailed studies for the California High-Speed Train program should be undertaken in the design phase. The discussions in the following sections are therefore preliminary.

### **5.1.1 Fault Rupture**

A surface fault rupture occurs when an active fault intercepts and offsets the earth's surface. The State of California has delineated zones around active faults in accordance with the Alquist-Priolo Earthquake Fault Zone Act of 1971 in order to mitigate for the effects of surface faulting. No portion of the project alignment is within a State of California Alquist-Priolo Earthquake Fault Zone, and no active faults are known to cross the alignment. Therefore, the risk of fault rupture occurring across the alignment is considered low.

### **5.1.2 Seismic Ground Shaking**

During an earthquake, seismic waves are produced that radiate in all directions from the source fault rupture. Seismic waves can produce strong ground shaking that is typically strongest near the source fault and attenuates as the waves move away from the source. The severity of ground shaking is controlled by the interaction of source magnitude, distance travelled, and the type, thickness, and condition of underlying geologic materials. Areas underlain by unconsolidated, recent alluvium or fill may amplify the amplitude and duration of strong ground motions.

The strongest ground shaking at the project area is expected to be as a result of an earthquake originating on the San Andreas Fault ( $M_{max}=7.9$ ) or the Ortigalita Fault ( $M_{max}=7.1$ ) at a distance of about 60.7 miles and 36.1 miles, respectively. Both of these faults can produce a peak horizontal ground acceleration (PGA) of approximately 0.06g at the project site based on our





**AECOM Transportation**

Job No. 209138.10 (A2-UPRR/SR99 Alignment, California High-Speed Train Project, Merced – Fresno Section)

June 1, 2010

Page 11

preliminary evaluation. This potential ground motion value is relatively low compared with more active regions of California. Therefore, strong earthquake ground shaking is not considered to be a significant seismic hazard at the project site. Nevertheless, severe ground shaking could cause structural damages and the derailment of moving or stopped trains, resulting in injuries or deaths. Since the consequences could be significant, it is recommended that all structures, foundations and embankments must be designed per project specifications for the maximum accelerations estimated based on detailed geotechnical investigations during the design stage.

Measures to reduce ground shaking impacts may include ground improvement such as deep soil mixing, jet grouting, soil densification, pile supported structures, etc. The use of specific measures would depend on soil type and stratigraphy, which would be determined at the project design stage.

### **5.1.3 Liquefaction**

Liquefaction is a phenomenon in which saturated cohesionless soils are subject to a temporary but essentially total loss of shear strength under the reversing, cyclic shear stresses associated with earthquake shaking. Submerged cohesionless sands and silts with low relative density are the type of soils usually susceptible to liquefaction. Clays are generally not susceptible to liquefaction.

The formations mapped in the project area are Tertiary and Quaternary alluvial deposits. These are likely to contain deposits of sand and silt, which are potentially liquefiable when saturated. However, a PGA of 0.06g is not likely to result in liquefaction of soils at the project site based on the geotechnical data collected. We recommend that the liquefaction potential should be further evaluated based on the more detailed geotechnical investigation at the design phase.

### **5.1.4 Lateral Spreading**

Lateral spreading refers to lateral ground failure/movement that occurs at sites underlain by liquefied soil. It is generally believed that the magnitude of lateral movement of liquefaction induced lateral spreading will be small at sites with surface gradients less than about one percent where no free face (an abrupt difference in elevation) is present. The project site has a low liquefaction potential and relatively flat topography which means there are minimal cuts and excavation of slopes necessary for the project. Therefore, seismically-induced liquefaction and



**AECOM Transportation**

Job No. 209138.10 (A2-UPRR/SR99 Alignment, California High-Speed Train Project, Merced – Fresno Section)

June 1, 2010

Page 12

lateral spreading are not considered potential hazards along the project alignment. However, there are river/stream crossings that are subject to such conditions, therefore site specific studies should address such impacts.

**5.1.5 Slope Instability**

Stability of slopes depends on steepness of the slope, strength of underlying soils, and pore pressures in the soil. The relatively flat terrain along the majority of the proposed alignment minimizes landslide potential. There may be potential slope stability issues at the banks of rivers/creeks that will be crossed with bridges. New slopes may be created at the approaches to overcrossing structures, but these embankments will generally be made of engineering fills. Significant excavating, grading, or fill placement during construction could introduce temporary slope stability hazards at bridge sites or along the track.

**5.1.6 Subsidence**

Tectonic subsidence, which occurs over a long period of time is currently occurring as a result of large scale sediment loading due to erosion of the Sierra Nevada. However, this subsidence is very gradual, occurring over an extremely long period of time relative to the project life. Thus, tectonic subsidence is not considered to be a hazard along the project alignment. Subsidence due to oxidation or dewatering organic-rich soil is not expected to be a problem along the project alignment since there are no significant thicknesses of organic-rich sediments present.

In general, subsidence due to rapid sedimentation is not considered a likely mechanism for triggering subsidence along the project alignment based on the regional geology. Collapse of subsurface cavities in underlying soils or bedrock can result in localized areas of subsidence. The sediments and rocks that comprise the various Tertiary and Quaternary stratigraphic along the project alignment are sands, silts and clays. These deposits are not considered to contain cavities that could collapse and result in surface subsidence.

Subsidence can also result from construction activities, such as withdrawal of water from the subsurface soils and loads exerted by construction such as mass fill placement and new heavy structures. Subsidence due to groundwater withdrawal has occurred in the past in the San Joaquin Valley and continues in some localities today. However, areas that are known to have this type of



**AECOM Transportation**

Job No. 209138.10 (A2-UPRR/SR99 Alignment, California High-Speed Train Project, Merced – Fresno Section)

June 1, 2010

Page 13

subsidence are well to the south and east of the site and it is not considered a hazard in the project site. Changes in groundwater use within and adjacent to the site in the future may result in potential subsidence.

**5.1.7 Collapsible Soils**

Collapsible soils consist of loose, dry, low-density materials that collapse and compact under the addition of water or excessive loading. These soils are distributed throughout the southwestern United States, specifically in areas of young alluvial fans, debris flow sediments, and loess (wind-blown sediment) deposits. Soil collapse occurs when the land surface is saturated at depths greater than those reached by typical rain events. This saturation eliminates the clay bonds holding the soil grains together (Mulvey, 1992). Similar to expansive soils, collapsible soils can result in structural damage such as cracking of the foundation in response to settlement of the ground surface. More detailed site-specific study is needed to evaluate the level of hazard of potential collapsible soils in the design phase.

**5.1.8 Expansive Soils**

Expansive soils are clay-rich soils that have the ability to swell and shrink with wetting and drying. The shrink-swell capacity of expansive soils, combined with seasonal variations in moisture, can result in differential settlement of foundations and embankments. Based on the subsoil information collected, clays and clayey soils were encountered in some portions of the project site, especially within Merced County. Even some silts and clays though intermixed with granular soil, could have expansion potential. However, the limited extent of these potentially expansive soils within the project area indicates the hazard is relatively low. A detailed site-specific geotechnical investigation is needed to determine the level of expansion potential for specific locations of the site.

**5.1.9 Erosion**

Wind and water are the primary agents of erosion. Wind erosion is not considered to be a substantial hazard within the site region because the surface deposits are older and more consolidated and not as susceptible to wind erosion. However, much of the project alignment crosses agricultural lands in production, which may at times be more susceptible to erosion when



**AECOM Transportation**

Job No. 209138.10 (A2-UPRR/SR99 Alignment, California High-Speed Train Project, Merced – Fresno Section)

June 1, 2010

Page 14

the soils are exposed or tilled. The relatively flat terrain along the project alignment reduces the potential for water erosion impacts except along the rivers/creeks. If the bridge structures are designed with footings within the creeks/rivers, there is the potential for erosion and scour to affect them.

**5.2 Natural Chemical Hazards – Corrosion Potential**

Several parameters influence soil corrosivity, including soil resistivity, degree of saturation, pH level, dissolved salts, redox potential and total acidity. Soil resistivity is a measure of the ability of a soil to conduct electrical current and is usually related to the amount of soluble salts in the soil. Low resistivity generally indicates a more corrosive condition. Another factor influencing corrosion potential is pH level. Soils or water with pH values below pH 7 indicate acidic conditions, and hence, a corrosive environment for metals and concrete. Chloride and sulfate concentrations in soil also can have a corrosive effect on the buried utilities and foundation elements.

The only corrosion testing data available is from the Campus Parkway Overhead (BR. No. 39-0249 L/R) project done by Parikh Consultants in March 2010. The project site is in Merced County at approximate PM 12.50. A summary of the corrosion test results is presented in the following table.

**Summary of Corrosion Test Results**

Boring	Depth (ft)	pH	Minimum Resistivity (ohms-cm)	Sulfate (ppm)	Chloride (ppm)
A-07-003	6	8.07	2280	17.8	8.3

Just for reference, per Caltrans Corrosion Guidelines, September 2003, Version 1.0, for structural elements, Caltrans considers a site to be corrosive if one or more of the following conditions exist for the representative soil and/or water samples taken at the site:

- Chloride concentration is 500 ppm or greater, sulfate concentration is 2000 ppm or greater, or the pH is 5.5 or less.

Based on the corrosion test results, the subsoils at the referenced boring location are not considered corrosive per Caltrans corrosion design guidelines. More detailed study should be done at the



**AECOM Transportation**

Job No. 209138.10 (A2-UPRR/SR99 Alignment, California High-Speed Train Project, Merced – Fresno Section)

June 1, 2010

Page 15

design phase to evaluate the soil corrosivity at each structure location. Special considerations and guidelines for foundations and underground facilities in corrosive environments should be included in the design documents. This is an important aspect of the foundation design since structures at many of the locations may require steel piles for foundation support.

### **5.3 Foundation Support for Bridge Structures**

The study performed for this report focuses on improvements within the one-mile wide project corridor that extends 0.5 mile on both sides of SR 99. All Post Mile (PM) numbers referenced in this report are the PM along SR 99 per Caltrans. Caltrans As-Built LOTBs for existing bridges along SR 99 were the main references in summarizing subsurface conditions. Several project references within the studied corridor were collected from Parikh Consultants, Inc. project library and from Geotracker database. These were also referred to in making preliminary recommendations.

The feasibilities of several foundation systems were evaluated for bridge structures at locations of the existing highway bridges along the project corridor based on the geotechnical information collected. We evaluated three (3) commonly used pile foundations types for preliminary design considerations. These include Cast-In-Drilled-Hole (CIDH) pile, PreCast/PreStressed (PC/PS) Concrete pile, and driven steel pile (open-ended pipe pile or H pile).

#### **5.3.1 Bridge Structures - Fresno County**

##### **PM 024.42 (SR 99)**

Reference: As-Built LOTB (Boring Nos. B-1, B-2, B5 and B8 drilled in 1953, and Boring Nos. B-1, B-2 and B3 drilled in 1990) for Clinton Avenue OC (Bridge No. 42-0183), (Caltrans, 1993), existing grade elevation: 292 feet ± to 299 feet ±.

The subsoils generally consist of medium dense to dense sand in the upper 15 to 30 feet (SPT blow counts range from 11 to 50+) followed by dense to very dense sand/silty sand (SPT blow counts range from 65 to 100+) to the maximum explored depth of 70 feet (B2, March 1990) below ground surface. Groundwater was not encountered during field investigation to a depth of 55 feet in September 1953 (maximum explored depth: 55 feet). Groundwater was not indicated in the LOTBs of March 1990 field exploration.





**AECOM Transportation**

Job No. 209138.10 (A2-UPRR/SR99 Alignment, California High-Speed Train Project, Merced – Fresno Section)

June 1, 2010

Page 16

Driven PC/PS concrete piles are recommended because they are both feasible and cost effective. If higher bearing capacity is required and the pile must be driven through the very dense sand layer, then steel pile is preferred to avoid the possible difficult driving conditions. An allowable bearing capacity of 100 tons is recommended for 14-inch square PC/PS pile with embedded pile length of 55 feet for preliminary estimation. Deep borings at the proposed bridge site based on the final design are recommended to derive design recommendations for bridge foundations.

**PM 026.22 (SR 99)**

Reference: As-Built LOTB (Boring Nos. B-1 & B-3) for SR 99 On-Ramp By Dakota (Bridge No. 42-0148) (Caltrans, 1959), existing grade elevation: 290 feet  $\pm$ .

The subsoils generally consist of medium dense to dense sand in the upper 60 feet (SPT blow counts range from 11 to 50+) followed by very stiff to hard clayey silt (SPT blow counts range from 20 to 50) to the maximum explored depth of 70 feet below ground surface. Groundwater was not encountered during field investigation in February 1957.

CIDH piles of 16-inch diameter were used for the existing bridge. Considering lateral capacity and/or uplift requirement and possible difficult driving conditions, CIDH pile is recommended for this site. But steel piles may also feasible depend on the structural loads. An allowable bearing capacity of 100 tons is recommended for 2 feet diameter CIDH pile with embedded pile length of 55 feet for preliminary estimation. Deep borings at the proposed bridge site based on the final design are recommended to derive design recommendations for bridge foundations.

**PM 026.55 (SR 99)**

Reference: As-Built LOTB (Boring Nos. B-1, B-5 & B-6) for Ashlan Avenue OC (Bridge No. 42-0140) (Caltrans, 1959), existing grade elevation: 292 feet  $\pm$  to 293 feet  $\pm$ .

The subsoils generally consist of medium to dense sand (SPT blow counts range from 20 to 50+) in the upper 70 feet followed by hard sandy silt to a maximum explored depth of 75 feet below ground surface. Groundwater was not encountered during field investigation in February 1957.

Steel piles appear to be the most suitable foundation type at this site due to the possible difficult driving conditions. An allowable bearing capacity of 100 tons is recommended for 16-inch diameter open-ended steel pipe pile with embedded pile length of 60 feet for preliminary



**AECOM Transportation**

Job No. 209138.10 (A2-UPRR/SR99 Alignment, California High-Speed Train Project, Merced – Fresno Section)

June 1, 2010

Page 17

estimation. Deep borings at the proposed bridge site based on the final design are recommended to derive design recommendations for bridge foundations.

**PM 027.31 (SR 99)**

Reference: As-Built LOTB (Boring Nos. B-1 and B-3) for Biola Junction (Bridge No. 42-0131) (Caltrans, 1959), existing grade elevation: 294 feet ±.

The subsoils generally consist of medium dense to very dense sand to silty sand (SPT blow counts range from 29 to 90) with interbedded layers of very stiff silt pockets to a depth of approximately 40 feet, underlain by very dense silty sand to hard sandy silt (SPT blow counts range from 29 to 42) to the maximum explored depth of 65 feet below ground surface. Groundwater was encountered at elevation 239 feet ± (56 feet ± below ground surface) in February 1957.

Steel piles appear to be the most suitable foundation type at this site due to the possible difficult driving conditions. An allowable bearing capacity of 100 tons is recommended for 16-inch diameter open-ended steel pipe pile with embedded pile length of 58 feet for preliminary estimation. Deep borings at the proposed bridge site based on the final design are recommended to derive design recommendations for bridge foundations.

**PM 028.10 (SR 99)**

Reference: As-Built LOTB (Boring Nos. B-2, B-3 & B-4) for Shaw Avenue OC (Bridge No. 42-0130) (Caltrans, 1959), existing grade elevation: 293 feet ± to 296 feet ±.

The subsoils generally consist of medium dense to dense sand (SPT blow counts range from 23 to 33) with interbedded very stiff silt pockets in the upper 54 feet, followed by dense silty sand (SPT blow counts range from 36 to 48) to the maximum explored depth of 60 feet below ground surface. Groundwater was not encountered during field investigation in February 1957.

Driven PC/PS concrete pile is recommended because it is both feasible and cost effective. An allowable bearing capacity of 100 tons is recommended for 14-inch square PC/PS pile with embedded pile length of 55 feet for preliminary estimation. Deep borings at the proposed bridge site based on the final design are recommended to derive design recommendations for bridge foundations.



**AECOM Transportation**

Job No. 209138.10 (A2-UPRR/SR99 Alignment, California High-Speed Train Project, Merced – Fresno Section)

June 1, 2010

Page 18

**PM 028.40 (SR 99)**

Reference: As-Built LOTB (Boring Nos. B-1, B-3 & B-11) for Herndon Canal (Bridge No. 42-0129) (Caltrans, 1958), existing grade elevation: 300 feet ±.

The subsoils generally consist of dense sand/silty sand (SPT blow counts range from 40 to 42) in the upper 10 feet, underlain by very stiff sandy silt (SPT blow counts range from 26 to 30) to a depth of approximately 40 feet, followed by dense sand/silty sand (SPT blow counts range from 32 to 40) to a maximum explored depth of 55 feet below ground surface. Groundwater was not encountered during field investigation in February 1957.

Steel piles appear to be the most suitable foundation type at this site due to the possible difficult driving conditions. An allowable bearing capacity of 100 tons is recommended for 16-inch diameter open-ended steel pipe pile with embedded pile length of 60 feet for preliminary estimation. Deep borings at the proposed bridge site based on the final design are recommended to derive design recommendations for bridge foundations.

**PM 030.48 (SR 99)**

Reference: As-Built LOTB (Boring No. B-1) for Grantland Avenue UC (Bridge No. 42-0127) (Caltrans, 1958), existing grade elevation: 291 feet ±.

The subsoils generally consist of very loose sand with gravel (SPT blow count 3) in the upper 10 feet, underlain by dense sand/silty sand (SPT blow counts range from 32 to 34) with few interbedded hard sandy silt lenses to the maximum explored depth of 45 feet below ground surface. Groundwater was not encountered during field investigation in February 1957.

Driven PC/PS concrete pile is recommended because it is both feasible and cost effective. An allowable bearing capacity of 100 tons is recommended for 14-inch square PC/PS pile with embedded pile length of 50 feet for preliminary estimation. Deep borings at the proposed bridge site based on the final design are recommended to derive design recommendations for bridge foundations.

**PM 030.99 (SR 99)**

Reference: As-Built LOTB (Boring Nos. B-1, B-4) for Herndon Canal (Bridge No. 42-0126) (Caltrans, 1958), existing grade elevation: 285 feet ± to 287 feet ±.



**AECOM Transportation**

Job No. 209138.10 (A2-UPRR/SR99 Alignment, California High-Speed Train Project, Merced – Fresno Section)

June 1, 2010

Page 19

The subsoils generally consist of medium dense to dense silty sand with gravel (SPT blow counts range from 15 to 43) in the upper 20 feet, underlain by medium dense to very dense sand/silty sand (general SPT blow count of 17 to 70) with few interbedded stiff to very stiff sandy silt lenses to a maximum explored depth of 50 feet below ground surface. Groundwater was not encountered during field investigation in February 1955.

Steel piles appear to be the most suitable foundation type at this site due to the possible difficult driving conditions. An allowable bearing capacity of 100 tons is recommended for 16-inch diameter open-ended steel pipe pile with embedded pile length of 60 feet for preliminary estimation. Deep borings at the proposed bridge site based on the final design are recommended to derive design recommendations for bridge foundations.

**5.3.2 Bridge Structures - Madera County****PM 00.08 (SR 99)**

Reference: As-Built LOTB (Boring Nos. B-1, B-2, B-6 & B-7) for San Joaquin River (Bridge No. 41-0008) (Caltrans, 1987), existing grade elevation: 225 feet ± to 264 feet ±.

The subsoils generally consist of dense sand to hard sandy silt (SPT blow counts range from 34 to 45) with intermediate layers of very stiff sandy clay to the maximum explored depth of approximately 90 feet below ground surface. Groundwater was encountered at elevation 251 feet ± (3 feet ± below ground surface) in July 1984. Further field investigation might be required to analyze liquefaction potential due to high ground water table.

Steel piles appear to be the most suitable foundation type at this site due to the possible difficult driving conditions. An allowable bearing capacity of 100 tons is recommended for 16-inch diameter open-ended steel pipe pile with embedded pile length of 75 feet for preliminary estimation. Deep borings at the proposed bridge site based on the final design are recommended to derive design recommendations for bridge foundations.

**PM 00.99 (SR 99)**

Reference: As-Built LOTB (Boring Nos. B-2 & B-4) for Avenue 7 OC (Bridge No. 41-0064) (Caltrans, 1962), existing grade elevation: 284 feet ± to 285 feet ±.



**AECOM Transportation**

Job No. 209138.10 (A2-UPRR/SR99 Alignment, California High-Speed Train Project, Merced – Fresno Section)

June 1, 2010

Page 20

The subsoils generally consist of very dense sand (generally SPT blow count more than 70) up to a depth of approximately 15 feet, underlain by dense to very dense sand to silty sand layers (SPT blow count of 34 to 45) to the maximum explored depth of approximately 60 feet below ground surface. Groundwater was not encountered during field investigation in August 1961.

Steel piles appear to be the most suitable foundation type at this site due to the possible difficult driving conditions. An allowable bearing capacity of 100 tons is recommended for 16-inch diameter open-ended steel pipe pile with embedded pile length of 55 feet for preliminary estimation. Deep borings at the proposed bridge site based on the final design are recommended to derive design recommendations for bridge foundations.

**PM 002.23 (SR 99)**

Reference: As-Built LOTB (Boring Nos. B-1 & B-6) for Avenue 8 OC (Bridge No. 41-0060) (Caltrans, 1963), existing grade: 281 feet ±.

The subsoils generally consist of medium dense sand (generally SPT blow count range from 15 to 23) with occasional silty sand layer up to a depth of approximately 30 feet, underlain by very dense sand (generally SPT blow count range from 58 to 100) up to a maximum explored depth of about 45 feet below ground surface. Groundwater was not encountered during field investigation in March 1961.

Driven PC/PS concrete pile is recommended because it is both feasible and cost effective. An allowable bearing capacity of 100 tons is recommended for 14-inch square PC/PS pile with embedded pile length of 50 feet for preliminary estimation. Deep borings at the proposed bridge site based on the final design are recommended to derive design recommendations for bridge foundations.

**PM 03.56 (SR 99)**

Reference: As-Built LOTB (Boring Nos. B-2 & B-4) for Avenue 9 OC (Bridge No. 41-0063) (Caltrans, 1962), existing grade elevation: 274 feet ± to 276 feet ±.

The subsoils generally consist of medium dense to dense sand to silty sand (SPT blow counts range from 24 to 43) with intermediate layers of sandy silt to a maximum explored depth of about 60 feet





**AECOM Transportation**

Job No. 209138.10 (A2-UPRR/SR99 Alignment, California High-Speed Train Project, Merced – Fresno Section)

June 1, 2010

Page 21

below ground surface. Groundwater was not encountered during field investigation in June 1961.

Steel piles appear to be the most suitable foundation type at this site due to the possible difficult driving conditions. An allowable bearing capacity of 100 tons is recommended for 16-inch diameter open-ended steel pipe pile with embedded pile length of 58 feet for preliminary estimation. Deep borings at the proposed bridge site based on the final design are recommended to derive design recommendations for bridge foundations.

**PM 06.15 (SR 99)**

Reference: As-Built LOTB (Boring Nos. B-3 & B-4) for Avenue 11 OC (Bridge No. 41-0061) (Caltrans, 63), existing grade elevation: 268 feet  $\pm$  to 271 feet  $\pm$ .

The subsoils generally consist of medium dense to dense sand (SPT blow counts range from 16 to 31) with few pockets of loose silty sand to a depth of approximately 30 feet, underlain by dense to very dense sandy silt layers (SPT blow count of 35 to 100) to the maximum explored depth of approximately 80 feet below ground surface. Groundwater was not encountered during field investigation in August 1961.

Steel piles appear to be the most suitable foundation type at this site due to the possible difficult driving conditions. An allowable bearing capacity of 100 tons is recommended for 16-inch diameter open-ended steel pipe pile with embedded pile length of 60 feet for preliminary estimation. Deep borings at the proposed bridge site based on the final design are recommended to derive design recommendations for bridge foundations.

**PM 07.28 (SR 99)**

Reference: As-Built LOTB (Boring Nos. B-3, B-7 & B-12) for Cottonwood Creek (Bridge No. 41-0065) (Caltrans, 1967), existing grade elevation: 270 feet  $\pm$ .

The subsoils generally consist of medium dense silty sand (SPT blow counts range from 18 to 27) with pockets of soft to stiff sandy silt and loose sand to the maximum explored depth of approximately 70 feet below ground surface. Groundwater was encountered at elevation 243 feet  $\pm$  to 257 feet  $\pm$  (27 feet  $\pm$  to 9 feet  $\pm$  below ground surface) in August 1961.

Driven PC/PS concrete pile is recommended because it is both feasible and cost effective. An



**AECOM Transportation**

Job No. 209138.10 (A2-UPRR/SR99 Alignment, California High-Speed Train Project, Merced – Fresno Section)

June 1, 2010

Page 22

allowable bearing capacity of 100 tons is recommended for 14-inch square PC/PS pile with embedded pile length of 65 feet for preliminary estimation. Deep borings at the proposed bridge site based on the final design are recommended to derive design recommendations for bridge foundations.

**PM 07.46 (SR 99)**

Reference: As-Built LOTB (Boring Nos. B-1 & B-3) for Avenue 12 OC (Bridge No. 41-0066) (Caltrans, 67), existing grade elevation: 269 feet  $\pm$  to 272 feet  $\pm$ .

The subsoils generally consist of medium dense to dense sand to silty sand (SPT blow counts range from 17 to 35) with intermediate very stiff sandy silt layers and pockets of loose sand to the maximum explored depth of approximately 70 feet below ground surface. Groundwater was encountered at elevation 249 feet  $\pm$  to 253 feet  $\pm$  (20 feet  $\pm$  to 19 feet  $\pm$  below ground surface) in September 61.

Driven PC/PS concrete pile is recommended because it is both feasible and cost effective. An allowable bearing capacity of 100 tons is recommended for 14-inch square PC/PS pile with embedded pile length of 55 feet for preliminary estimation. Deep borings at the proposed bridge site based on the final design are recommended to derive design recommendations for bridge foundations.

**PM 08.72 (SR 99)**

Reference: As-Built LOTB (Boring Nos. B-2, B-4 & B-5) for Avenue 13 OC (Bridge No. 41-0062) (Caltrans, 1967), existing grade elevation: 265 feet  $\pm$  to 267 feet  $\pm$ .

The subsoils generally consist of loose sand (SPT blow counts range from 6 to 9) to a depth of approximately 6 feet, underlain by medium dense to dense sand to silty sand layers (SPT blow count of 24 to 36) with intermediate very stiff sandy silt layers to the maximum explored depth of approximately 70 feet below ground surface. Groundwater was not encountered during field investigation in August 1961.

Driven PC/PS concrete pile is recommended because it is both feasible and cost effective. An allowable bearing capacity of 100 tons is recommended for 14-inch square PC/PS pile with embedded pile length of 55 feet for preliminary estimation. Deep borings at the proposed bridge



**AECOM Transportation**

Job No. 209138.10 (A2-UPRR/SR99 Alignment, California High-Speed Train Project, Merced – Fresno Section)

June 1, 2010

Page 23

site based on the final design are recommended to derive design recommendations for bridge foundations.

**PM 09.74 (SR 99)**

Reference: As-Built LOTB (Boring Nos. B-1, B-2 & B-3) for South Madera OC (Bridge No. 41-0046) (Caltrans, 2007), existing grade elevation: 267 feet ±.

The subsoils generally consist of medium dense to dense sand (SPT blow counts range from 21 to 35) with intermediate very stiff to hard sandy silt and silty clay layers to the maximum explored depth of approximately 70 feet below ground surface. Groundwater was encountered at elevation 230 feet ± (37 feet ± below ground surface) in February 01.

Driven PC/PS concrete pile is recommended because it is both feasible and cost effective. An allowable bearing capacity of 100 tons is recommended for 14-inch square PC/PS pile with embedded pile length of 55 feet for preliminary estimation. Deep borings at the proposed bridge site based on the final design are recommended to derive design recommendations for bridge foundations.

**PM 010.27 (SR 99)**

Reference: As-Built LOTB (Boring Nos. B-1, B-3 & B-4) for Route 145/99 Separation (Bridge No. 41-0047) (Caltrans, 58), existing grade elevation: 268 feet ±.

The subsoils generally consist of loose sand (SPT blow counts range from 6 to 8) up to a depth of about 20 feet, underlain by medium dense to dense sand to clayey sand (SPT blow count of 23 to 35) with intermediate very stiff silt layers up to a maximum explored depth of about 45 feet below ground surface. Groundwater was considered to be at or below elev. 226 feet ± (42 feet ± below ground surface) in May 1954.

Driven PC/PS concrete pile is recommended because it is both feasible and cost effective. An allowable bearing capacity of 100 tons is recommended for 14-inch square PC/PS pile with embedded pile length of 55 feet for preliminary estimation. Deep borings at the proposed bridge site based on the final design are recommended to derive design recommendations for bridge foundations.



**AECOM Transportation**

Job No. 209138.10 (A2-UPRR/SR99 Alignment, California High-Speed Train Project, Merced – Fresno Section)

June 1, 2010

Page 24

**PM 010.84 (SR 99)**

Reference: As-Built LOTB (Boring Nos. B-3, B-4) for West Yosemite Avenue (Bridge No. 41-0049) (Caltrans, 1954), existing grade elevation: 268 feet  $\pm$ .

The subsoils generally consist of medium dense sand to silty sand with intermediate very stiff silt layer (SPT blow counts range from 19 to 22) and few pockets of very loose sand to the maximum explored depth of approximately 48 feet below ground surface. Groundwater was encountered at elevation 220 feet  $\pm$  (48 feet  $\pm$  below ground surface) in April 1954. Further field investigation might be required to analyze liquefaction potential due to soil types, densities and ground water table.

Driven PC/PS concrete pile is recommended because it is both feasible and cost effective. An allowable bearing capacity of 100 tons is recommended for 14-inch square PC/PS pile with embedded pile length of 55 feet for preliminary estimation. Deep borings at the proposed bridge site based on the final design are recommended to derive design recommendations for bridge foundations.

**PM 011.01 (SR 99)**

Reference: As-Built LOTB (Boring Nos. B-1& B-4) for West Fourth Street OC (Bridge No. 41-0050) (Caltrans, 1958), existing grade elevation: 267 feet  $\pm$ .

The subsoils generally consist of medium dense sand with intermediate very stiff silt layers (SPT blow counts range from 17 to 27) up to a maximum explored depth of 70 feet below ground surface. Groundwater was encountered at elevation 220 feet  $\pm$  (47 feet  $\pm$  below ground surface) in April 1954. Further field investigation might be required to analyze liquefaction potential due to soil types, densities and ground water table.

Driven PC/PS concrete pile is recommended because it is both feasible and cost effective. An allowable bearing capacity of 100 tons is recommended for 14-inch square PC/PS pile with embedded pile length of 56 feet for preliminary estimation. Deep borings at the proposed bridge site based on the final design are recommended to derive design recommendations for bridge foundations.

**PM 011.09 (SR 99)**

Reference: As-Built LOTB (Boring Nos. B-1& B-5) for Madera UP (Bridge No. 41-0051)



**AECOM Transportation**

Job No. 209138.10 (A2-UPRR/SR99 Alignment, California High-Speed Train Project, Merced – Fresno Section)

June 1, 2010

Page 25

(Caltrans, 58), existing grade elevation: 267 feet  $\pm$  to 269 feet  $\pm$ .

The subsoils generally consist of loose to medium dense sand layer (SPT blow counts range from 12 to 14) with few pockets of very loose sand and soft silt up to a maximum explored depth of 80 feet below ground surface. Groundwater was encountered at elevation 224 feet  $\pm$  (45 feet  $\pm$  below ground surface) in April 1954. Further field investigation might be required to analyze liquefaction potential due to soil types, densities and ground water table.

Driven PC/PS concrete pile is recommended because it is both feasible and cost effective. An allowable bearing capacity of 100 tons is recommended for 14-inch square PC/PS pile with embedded pile length of 60 feet for preliminary estimation. Deep borings at the proposed bridge site based on the final design are recommended to derive design recommendations for bridge foundations.

**PM 011.65 (SR 99)**

Reference: As-Built LOTB (Boring Nos. B-3, B-4 & B-6) for Fresno River Bridge (Bridge No. 41-0052) (Caltrans, 1989), existing grade elevation: 256 feet  $\pm$  to 271 feet  $\pm$ .

The subsoils generally consist of stiff to very stiff sandy clay to medium dense clayey sand (SPT blow counts range from 15 to 20) up to a depth of about 20 feet, underlain by medium dense sand layer (SPT blow count of 22 to 30) to the maximum explored depth of approximately 65 feet below ground surface. Groundwater was encountered at elevation 232 feet  $\pm$  (24 feet  $\pm$  below ground surface) in July 1987.

Based on the Boring MW-6 from the Geotracker database (T0603900177) at PM 11.80, the upper 65 feet soil conditions are generally consistent with the findings of Caltrans LOTBs at PM 11.65 except a very dense sand/silty sand layer (SPT blow count of 100+), about 10 feet thick, was encountered at the depth of 72 feet followed by dense to medium dense sand/silty sand to the maximum explored depth of 125 feet. Groundwater was encountered in MW-6 at the depth of 110 feet below the existing ground surface on March 21, 2005.

Driven PC/PS concrete pile is recommended because it is both feasible and cost effective. If higher bearing capacity is required and the pile must be driven through the very dense sand layer (at the depth of 72 feet in MW-6), then the steel pile is preferred to avoid the possible difficult driving



**AECOM Transportation**

Job No. 209138.10 (A2-UPRR/SR99 Alignment, California High-Speed Train Project, Merced – Fresno Section)

June 1, 2010

Page 26

conditions. An allowable bearing capacity of 100 tons is recommended for 14-inch square PC/PS pile with embedded pile length of 55 feet for preliminary estimation. Deep borings at the proposed bridge site based on the final design are recommended to derive design recommendations for bridge foundations.

**PM 012.13 (SR 99)**

Reference: As-Built LOTB (Boring Nos. B-1, B-2 & B-3) for Cleveland Avenue OC (Bridge No. 41-0053) (Caltrans, 1996), existing grade elevation: 248 to 269 feet  $\pm$ .

The subsoils generally consist of medium dense sand with trace silt and clay (SPT blow counts range from 14 to 18) to a depth of approximately 60 feet, underlain by medium dense silty sand layer (SPT blow count of 16 to 22) to the maximum explored depth of approximately 45 feet below ground surface. Groundwater was not encountered during field investigation in July 1993.

Driven PC/PS concrete pile is recommended because it is both feasible and cost effective. An allowable bearing capacity of 100 tons is recommended for 14-inch square PC/PS pile with embedded pile length of 60 feet for preliminary estimation. Deep borings at the proposed bridge site based on the final design are recommended to derive design recommendations for bridge foundations.

**PM 012.75 (SR 99)**

Reference: As-Built LOTB (Boring No. B-1) for Avenue 16 OC (Bridge No. 41-0058) (Caltrans, 1958), existing grade elevation: 260 feet  $\pm$ .

The subsoils generally consist of medium dense silty sand to a depth of approximately 10 feet, underlain by dense sand with gravel to the maximum explored depth of approximately 15 feet below ground surface. Groundwater was not encountered during field investigation in 1956. Further field investigation might be required to obtain standardized blow counts, in-situ samples, and sufficient depth for foundation design.

Driven PC/PS concrete pile or steel piles may be used for structures at this site based on existing borings and local geology. The existing boring is too shallow (15 feet) to develop a meaningful preliminary recommendation for foundation support at this site. Further geotechnical exploration is required for the preliminary foundation type selection and detailed recommendations.



**AECOM Transportation**

Job No. 209138.10 (A2-UPRR/SR99 Alignment, California High-Speed Train Project, Merced – Fresno Section)

June 1, 2010

Page 27

**PM 014.22 (SR 99)**

Reference: As-Built LOTB (Boring Nos. B-2, B-4, & B-6) for Avenue 17 OC (Bridge No. 41-0068) (Caltrans, 1971), existing grade elevation: 260 feet ± to 262 feet ±.

The subsoils generally consist of hard clayey silt to silty clay layer (SPT blow counts range from 35 to 71) to a depth of approximately 10 feet, underlain by hard sandy silt layer to dense to very dense silty sand layer (SPT blow count of 37 to 68) with few medium dense silty sand pockets to the maximum explored depth of approximately 50 feet below ground surface. Groundwater was not encountered during field investigation in December 1968.

Steel piles appear to be the most suitable foundation type at this site due to the possible difficult driving conditions. An allowable bearing capacity of 100 tons is recommended for 16-inch diameter open-ended steel pipe pile with embedded pile length of 55 feet for preliminary estimation. Deep borings at the proposed bridge site based on the final design are recommended to derive design recommendations for bridge foundations.

**PM 016.10 (SR 99)**

Reference: As-Built LOTB (Boring No. B-1) for Dry Creek Bridge (Bridge No. 41-0005) (Caltrans, 1975), existing grade elevation: 248 feet ±.

The subsoils generally consist of soft to medium stiff sandy clay to clayey silt layer (SPT blow counts range from 6 to 9) to a depth of approximately 20 feet, underlain by hard sandy silt layer (SPT blow count of 56 to 100+) to the maximum explored depth of approximately 40 feet below ground surface. Groundwater was encountered at elevation 242 feet ± (6 feet ± below ground surface) in March 69. Further field investigation might be required to analyze liquefaction potential due to high groundwater table.

Steel piles appear to be the most suitable foundation type at this site due to the possible difficult driving conditions. The existing boring is too shallow to develop a meaningful preliminary recommendation for foundation support at this site. Further geotechnical exploration is required for detailed recommendations.

**PM 016.33 (SR 99)**





**AECOM Transportation**

Job No. 209138.10 (A2-UPRR/SR99 Alignment, California High-Speed Train Project, Merced – Fresno Section)

June 1, 2010

Page 28

Reference: As-Built LOTB (Boring Nos. B-1, B-3 & B-4) for Avenue 18 ½ OC (Bridge No. 41-0069) (Caltrans, 1975), existing grade elevation: 248 feet ± to 251 feet ±.

The subsoils generally consist of medium dense to dense sand to silty sand layers and very stiff to hard sandy silt (SPT blow counts range from 24 to 37) up to a maximum explored depth of 70 feet below ground surface. Groundwater was encountered at elevation 198 feet ± (53 feet ± below ground surface) in March 1969.

Driven PC/PS concrete pile is recommended because it is both feasible and cost effective. An allowable bearing capacity of 100 tons is recommended for 14-inch square PC/PS pile with embedded pile length of 53 feet for preliminary estimation. Deep borings at the proposed bridge site based on the final design are recommended to derive design recommendations for bridge foundations.

**PM 017.85 (SR 99)**

Reference: As-Built LOTB (Boring No. 97-1) for Beranda Creek (Bridge No. 41-0004) (Caltrans, 1998), existing grade elevation: 244 feet ±.

The subsoils generally consist of stiff to very stiff silt with some medium dense to dense sand layers and few gravel pockets (SPT blow counts range from 18 to 35) up to a depth of approximately 45 feet, underlain by dense to very dense sand layer (SPT blow count of 46 to 70) up to a maximum explored depth of 80 feet below ground surface. Groundwater was encountered at elevation 200 feet ± (50 feet ± below ground surface) in May 1997.

Driven PC/PS concrete pile is recommended because it is both feasible and cost effective. An allowable bearing capacity of 100 tons is recommended for 14-inch square PC/PS pile with embedded pile length of 50 feet for preliminary estimation. Deep borings at the proposed bridge site based on the final design are recommended to derive design recommendations for bridge foundations.

**PM 022.73 (SR 99)**

Reference: As-Built LOTB (Boring Nos. B-2 & B-3) for N99-W152 Connector Sep (Bridge No. 41-0043) (Caltrans, 1957), existing grade elevation: 246 feet ±.



**AECOM Transportation**

Job No. 209138.10 (A2-UPRR/SR99 Alignment, California High-Speed Train Project, Merced – Fresno Section)

June 1, 2010

Page 29

The subsoils generally consist of medium dense to dense sand to silty sand layers with few pockets of stiff to hard silt (SPT blow counts ranging from 19 to 35) to the maximum explored depth of approximately 100 feet below ground surface. Groundwater was not encountered during field investigation in October 1957.

Driven PC/PS concrete pile is recommended because it is both feasible and cost effective. An allowable bearing capacity of 100 tons is recommended for 14-inch square PC/PS pile with embedded pile length of 55 feet for preliminary estimation. Deep borings at the proposed bridge site based on the final design are recommended to derive design recommendations for bridge foundations.

**PM 023.09 (SR 99)**

Reference: As-Built LOTB (Boring Nos. B-1, B-5 & B-7) for California OH (Bridge No. 41-0014) (Caltrans, 1993), existing grade elevation: 248 feet  $\pm$ .

The subsoils generally consist of medium dense sandy silt in upper 10 feet depth, underlain by very dense silty sand with few gravel up to a depth of 30 feet (SPT blow counts ranging from 125 to 167) followed by dense to very dense sand/silty sand and hard silt (SPT blow counts ranging from 33 to 100) to the maximum explored depth of approximately 50 feet below ground surface. Groundwater was not encountered during field investigation in February 1991.

Steel piles appear to be the most suitable foundation type at this site due to the possible difficult driving conditions. An allowable bearing capacity of 100 tons is recommended for 16-inch diameter open-ended steel pipe pile with embedded pile length of 55 feet for preliminary estimation. Deep borings at the proposed bridge site based on the final design are recommended to derive design recommendations for bridge foundations.

**PM 023.77 (SR 99)**

Reference: As-Built LOTB (Boring Nos. B-1, B-5 & B-6) for Avenue 24 OC (Bridge No. 41-0054) (Caltrans, 1957), existing grade elevation: 250 feet  $\pm$  to 251 feet  $\pm$ .

The subsoils generally consist of medium dense to dense sand layers (generally SPT blow count ranged from 23 to 40) with few silty clay and silty sand pockets to the maximum explored depth of approximately 65 feet below ground surface. Groundwater was encountered at elevation 209 feet  $\pm$



**AECOM Transportation**

Job No. 209138.10 (A2-UPRR/SR99 Alignment, California High-Speed Train Project, Merced – Fresno Section)

June 1, 2010

Page 30

(41 feet  $\pm$  below ground surface) in July, 1954.

Steel piles appear to be the most suitable foundation type at this site due to the possible difficult driving conditions. An allowable bearing capacity of 100 tons is recommended for 16-inch diameter open-ended steel pipe pile with embedded pile length of 60 feet for preliminary estimation. Deep borings at the proposed bridge site based on the final design are recommended to derive design recommendations for bridge foundations.

**PM 024.78 (SR 99)**

Reference: As-Built LOTB (Boring Nos. B-1, B-2, B-3 & B-4) for Brenda Slough (Bridge No. 41-0044) (Caltrans, 1995), existing grade elevation: 235 feet  $\pm$  to 240 feet  $\pm$ .

The subsoils generally consist of medium dense to dense sand and very stiff to hard silt (generally SPT blow count ranged from 16 to 33) to the maximum explored depth of approximately 50 feet below ground surface. Groundwater was encountered at elevations ranging from 231 feet  $\pm$  to 232 feet  $\pm$  (7 feet  $\pm$  to 8 feet  $\pm$  below ground surface) in August 1990. Further field investigation might be required to analyze liquefaction potential due to high groundwater.

Driven PC/PS concrete pile is recommended because it is both feasible and cost effective. The existing boring is too shallow to develop a meaningful preliminary recommendation for foundation support at this site. Further geotechnical exploration is required for detailed recommendations.

**PM 026.58 (SR 99)**

Reference: As-Built LOTB (Boring Nos. B-2, B-5, B-6 & B-7) for N99 & 233 Connector (Bridge No. 41-0055) (Caltrans, 1957), existing grade elevation: 244 feet  $\pm$ .

The subsoils generally consist of medium dense to dense sand (SPT blow counts range from 16 to 37) with few gravel lenses and occasional soft sandy silt pocket up to a maximum explored depth of 35 feet below ground surface. Groundwater was encountered at elevation 219 feet  $\pm$  (25 feet  $\pm$  below ground surface) in July 1954.

Based on the Boring MW-24 from the Geotracker database (SL0603935695) at PM 26.40, subsoils from the depth of 10 feet to the depth 70 feet are mainly very dense sand/silty sand with SPT blow



**AECOM Transportation**

Job No. 209138.10 (A2-UPRR/SR99 Alignment, California High-Speed Train Project, Merced – Fresno Section)

June 1, 2010

Page 31

count of 70 to 100+. Groundwater was encountered in MW-24 at the depth of 51 feet below the existing ground surface on December 23, 2008.

For preliminary consideration, driven PC/PS concrete pile is recommended because it is both feasible and cost effective. More detailed geotechnical exploration is needed to further evaluate the site subsurface conditions at the design stage due to the potential of thick very dense sand layer caused difficult driving conditions. Steel pile may be needed based on the findings of additional geotechnical information. An allowable bearing capacity of 100 tons is recommended for 14-inch square PC/PS pile with embedded pile length of 50 feet for preliminary estimation. Deep borings at the proposed bridge site based on the final design are recommended to derive design recommendations for bridge foundations.

**PM 026.80 (SR 99)**

Reference: As-Built LOTB (Boring Nos. B-1& B-4) for Ash Slough (Bridge No. 41-0045L/R) (Caltrans, 1995), existing grade elevation: 239 feet  $\pm$  to 245 feet  $\pm$ .

The subsoils consist of medium dense to dense sand to silty and clayey sand layers (SPT blow count of 16 to 52) with few gravel lenses up to a maximum explored depth of 45 feet below ground surface. Groundwater was encountered at elevations ranging from 232 feet  $\pm$  to 237 feet  $\pm$  (6 to 13 feet  $\pm$  below ground surface) in July 1954. Further field investigation might be required to analyze liquefaction potential due to high groundwater.

Steel piles appear to be the most suitable foundation type at this site due to the possible difficult driving conditions. The existing boring is too shallow to develop a meaningful preliminary recommendation for foundation support at this site. Further geotechnical exploration is required for detailed recommendations.

**PM 028.17 (SR 99)**

Reference: As-Built LOTB (Boring Nos. B-1& B-3) for Le Grand Avenue Overcrossing (Bridge No. 41-0057) (Caltrans, 1956), existing grade elevation: 233 feet  $\pm$ .

The subsoils generally consist of loose silty sand layer (SPT blow count of 6) up to approximately 6 feet depth, underlain by medium dense to dense sand to silty sand (generally SPT blow count ranged from 35 to 56) up to a maximum explored depth of 30 feet below ground surface.



**AECOM Transportation**

Job No. 209138.10 (A2-UPRR/SR99 Alignment, California High-Speed Train Project, Merced – Fresno Section)

June 1, 2010

Page 32

Groundwater was not encountered during field investigation in August 1955.

Steel piles appear to be the most suitable foundation type at this site due to the possible difficult driving conditions. The existing boring is too shallow to develop a meaningful preliminary recommendation for foundation support at this site. Further geotechnical exploration is required for detailed recommendations.

**PM 029.33 (SR 99)**

Reference: As-Built LOTB (Boring Nos. B-1, B-4) for Chowchilla River Bridge (Bridge No. 41-0001) (Caltrans, 1996), existing grade elevation: 226 feet ± to 232 feet ±.

The subsoils generally consist of medium dense to dense sand/silty sand with few loose sandy silt lenses (SPT blow counts range from 14 to 25) up to a depth of approximately 50 feet, underlain by medium dense to very dense sand to sandy silt (generally SPT blow count of 20 to 48) up to a maximum explored depth of 80 feet below ground surface. Groundwater was encountered at elevation about 225 feet ± (1 foot ± to 5 feet ± below ground surface) in July, 1992. Further field investigation might be required to analyze liquefaction potential due to high groundwater.

Steel piles appear to be the most suitable foundation type at this site due to the possible difficult driving conditions. An allowable bearing capacity of 100 tons is recommended for 16-inch diameter open-ended steel pipe pile with embedded pile length of 80 feet for preliminary estimation. Deep borings at the proposed bridge site based on the final design are recommended to derive design recommendations for bridge foundations.

**5.3.3 Bridge Structures - Merced County****PM 1.65 (SR 99)**

Reference: As-Built LOTB (Boring Nos. B-1, B-2) for South Dutchman Creek Right and Left Bridges (Widen) (Bridge No. 39-01L) (Caltrans, 1993), existing grade elevations: 213± to 221± feet.

The subsoils on the east bank of the creek consist of stiff to very stiff clays with Modified California (MC) sampler (3" OD and 2.5" ID) blow counts ranging from 18 to 34 in the upper 15 to 20 feet, underlain predominantly by dense to very dense sands (MC blow counts ranging from 72



**AECOM Transportation**

Job No. 209138.10 (A2-UPRR/SR99 Alignment, California High-Speed Train Project, Merced – Fresno Section)

June 1, 2010

Page 33

to 50/6”) to a depth of approximately 30 feet. Very stiff to hard clays are noted below 30 feet, Very stiff to hard sandy clays are noted below 30 feet to a depth of 35 feet (the maximum depth explored). The subsoils on the west bank consist of loose to medium dense clayey sand (MC blow counts ranging from 17 to 39) to a depth of 10 feet, underlain by 5 feet of hard clay (MC blow count of 60). The subsoils below 15 feet depth are noted as dense to very dense clayey and silty sand (MC blow counts ranging from 77 to 50/3”) to a depth of approximately 70 feet, underlain by very stiff to hard clay to a depth of 80 feet (the maximum depth explored). Groundwater was not encountered in January, 1991. Groundwater was encountered in June, 1939 at elev. 198± to 201± (±20’ below ground surface).

Considering lateral capacity and/or uplift requirement and possible difficult driving conditions, driven piles are not preferred at this bridge location. CIDH pile is recommended. An allowable bearing capacity of 100 tons is recommended for 2 feet diameter CIDH pile with embedded pile length of 55 feet for preliminary estimation. Deep borings at the proposed bridge site based on the final design are recommended to derive design recommendations for bridge foundations.

**PM 2.62 (SR 99)**

Reference: As-Built LOTB (Boring Nos. B-1, B-2) for Dutchman Creek Bridge (Replace) (Bridge No. 39-01L) (Caltrans, 1986), existing grade elevation: 205± feet.

The subsoils on the west bank of the creek consist of medium dense sandy soils (SPT blow counts ranging from 15 to 19) to a depth of approximately 17 feet, underlain by dense to very dense silty sand (SPT blow counts ranging from 42 to 90) to a depth of approximately 32 feet. Layers of medium dense sands and very stiff silts (SPT blow counts ranging from 18 to 26) are noted below 32 feet to a depth of 65 feet (the maximum depth explored), an exception being a 5 feet layer of very hard clayey silt (SPT blow count of 51) at a depth of 40 feet. On the east bank, The subsoils consist of very stiff silt (SPT blow count of 24) to a depth of approximately 10 feet, underlain by dense to very dense sands and hard silts (SPT blow counts ranging from 44 to 58 to a depth of approximately 33 feet. Very stiff silts and sandy silts (SPT blow counts ranging from 23 to 29) are noted below 33 feet depth to a maximum explored depth of 60 feet. Groundwater was encountered at elevation 160 feet ± (45 feet ± below ground surface) in 1984.

Considering lateral capacity and/or uplift requirement and possible difficult driving conditions, driven piles are not preferred at this bridge location. CIDH pile is recommended. An allowable



**AECOM Transportation**

Job No. 209138.10 (A2-UPRR/SR99 Alignment, California High-Speed Train Project, Merced – Fresno Section)

June 1, 2010

Page 34

bearing capacity of 100 tons is recommended for 2 feet diameter CIDH pile with embedded pile length of 55 feet for preliminary estimation. Deep borings at the proposed bridge site based on the final design are recommended to derive design recommendations for bridge foundations.

**PM 5.22 (SR 99)**

Reference: As-Built LOTB (Boring Nos. B-1, B-2) for Deadman Creek Bridge (Replace) Bridge No. 39-0002R/L) (Caltrans, 1986), existing grade elevation: 198 feet  $\pm$ .

The subsoils consist of stiff to very stiff silts and medium dense sands (SPT blow counts ranging from 12 to 35) to a depth of 54 feet, underlain by very stiff to hard clay (SPT blow counts ranging from 23 to 33) to 70 feet, the maximum depth explored. A 3 to 4-foot thick layer of very dense coarse sand and gravel is noted at a depth of approximately 45 feet. Groundwater was encountered at elevation 161 feet  $\pm$  (36 feet  $\pm$  below ground surface) in 1984.

Driven PC/PS concrete pile is recommended because it is both feasible and cost effective. An allowable bearing capacity of 100 tons is recommended for 14-inch square PC/PS pile with embedded pile length of 53 feet for preliminary estimation. Deep borings at the proposed bridge site based on the final design are recommended to derive design recommendations for bridge foundations.

**PM 9.35 (SR 99)**

Reference: As-Built LOTB (Boring Nos. B-1 and B-2) for Mariposa Creek Bridge (Widen) (Bridge No. 39-81R/L) (Caltrans, 1986), existing grade elevation: 186 feet  $\pm$  to 189 feet  $\pm$ .

The subsoils below an 8 feet thick clay fill layer consist of predominantly very stiff to hard silty soils (including clayey silts and sandy silts) and occasional sand layers to 70 feet depth, the maximum depth explored. The SPT blow counts generally range from 11 to 36. Notable exceptions include: a 3 to 4 feet layer of very hard silt (SPT blow count of 63) at approximately 40 feet depth on the west bank; a 3 to 4 feet layer of very dense sand (SPT blow count of 61) at approximately 48 feet depth on the east bank; and 5-foot layer of soft clayey silt (SPT blow count of 4) at a depth of 15 feet on the west bank. Groundwater was encountered at elevation 180 feet  $\pm$  (6 feet  $\pm$  below ground surface) in 1984.

Driven PC/PS concrete pile is recommended because it is both feasible and cost effective. An





**AECOM Transportation**

Job No. 209138.10 (A2-UPRR/SR99 Alignment, California High-Speed Train Project, Merced – Fresno Section)

June 1, 2010

Page 35

allowable bearing capacity of 100 tons is recommended for 14-inch square PC/PS pile with embedded pile length of 70 feet for preliminary estimation. Deep borings at the proposed bridge site based on the final design are recommended to derive design recommendations for bridge foundations.

**PM 9.43 (SR 99)**

Reference: As-Built LOTB (Boring Nos. B-1, B-3, B-8 and others for groundwater) for Duck Slough Bridge (Widen) (Bridge No. 39-04) (Caltrans, 1986), existing grade elevation: 186 feet  $\pm$  to 188 feet  $\pm$  on the banks.

The subsoils consist predominantly of silts, including clayey silts and sandy silts with occasional layers of sand and silty clay. On the eastern side, below a layer of very hard silt (SPT blow counts ranging from 57 to  $>100$ ) at approximately 15 feet depth, the SPT blow counts range from 15 to 35 to depths ranging from 50 to 60 feet. Dense to very dense silty sands (SPT blow counts ranging from 49 to  $>100$ ) are noted below 50-60 feet depth. On the western side, The SPT blow counts generally range from 8 to 39 to 70 feet depth, the maximum depth explored. A 4 feet thick very hard silt layer (SPT blow count of 92) is noted at approximately 35 feet depth. Groundwater was encountered at elevation 179 feet  $\pm$  (9 feet  $\pm$  below ground surface) in July, 1984.

Steel piles appear to be the most suitable foundation type at this site due to the possible difficult driving conditions. An allowable bearing capacity of 100 tons is recommended for 16-inch diameter open-ended steel pipe pile with embedded pile length of 65 feet for preliminary estimation. Deep borings at the proposed bridge site based on the final design are recommended to derive design recommendations for bridge foundations.

**PM 9.86 (SR 99)**

Reference: As-Built LOTB (Boring Nos. B-1, B-2, B-3; others for groundwater) for Duck Slough Overflow (Widen) (Bridge No. 39-05) (Caltrans, 1986), existing grade elevation: 183 feet  $\pm$  to 185 feet  $\pm$  on the banks; 175 feet  $\pm$  at bottom of slough.

The subsoils on the east bank consist of soft silty clay (SPT blow count of 4 to 6) to a depth of 20 feet, underlain by approximately 5 feet of firm silt (SPT blow count of 8). The firm silt layer is underlain by interbedded layers of very stiff to hard clays and silts and medium dense to very dense sands (SPT blow counts generally ranging between 16 and 35) to 65 feet depth (the



**AECOM Transportation**

Job No. 209138.10 (A2-UPRR/SR99 Alignment, California High-Speed Train Project, Merced – Fresno Section)

June 1, 2010

Page 36

maximum depth explored). A 5 feet layer of very dense gravelly sand (SPT blow count of 60) is noted at 40 feet depth and a 5 feet layer of very hard clayey silt (SPT blow count of 92) is noted at 50 feet depth. On the west bank, The subsoils consist of soils varying from very stiff to hard sandy/clayey silts and loose to medium dense sands (SPT blow counts ranging from 18 to 35, with a 6 feet layer of sand at 5 feet depth with a blow count of 8) to a depth of approximately 30 feet. Very hard silts and dense to very dense sands are noted below 30 feet depth to 65 feet depth, the maximum depth explored. SPT blow counts range from 31 to 59, except a 3 feet layer of very dense sand and silt (SPT blow count of 82) is noted at a depth of approximately 45 feet. Groundwater was encountered at elevation 175 feet  $\pm$  (8 feet  $\pm$  to 10 feet  $\pm$  below ground surface) in October, 1984

Steel piles appear to be the most suitable foundation type at this site due to the possible difficult driving conditions. An allowable bearing capacity of 100 tons is recommended for 16-inch diameter open-ended steel pipe pile with embedded pile length of 72 feet for preliminary estimation. Deep borings at the proposed bridge site based on the final design are recommended to derive design recommendations for bridge foundations.

**PM 10.55 (SR 99)**

Reference: As-Built LOTB (Boring Nos. B-1, B-2, B-3 and B-02-1) for Owens Creek Bridge (Bridge No. 39-06R/L) (Caltrans, 1986), existing grade elevation: 181 feet  $\pm$  to 185 feet  $\pm$ .

The subsoils consist of very loose to loose sands (SPT blow counts ranging from 2 to 5) to depths ranging from 10 to 15 feet, underlain by soft to very stiff clays and with occasional medium dense sand layers silts (SPT blow counts ranging from 4 to 27) to approximately 45-foot depth. An approximately 5 feet thick layer of very dense sand and gravel (SPT blow counts ranging from 56 to  $>100$ ) is noted at approximately 45 feet depth, underlain by hard clays and silts to a depth of approximately 70 feet, the maximum depth explored. Groundwater was encountered at elevation 175 feet  $\pm$  (10 feet  $\pm$  below ground surface) in July, 1984 and 170 feet  $\pm$  (10 feet  $\pm$  below ground surface) in September, 2002.

Steel piles appear to be the most suitable foundation type at this site due to the possible difficult driving conditions. Due to the weak soils in the upper 45 feet, the existing boring is too shallow to develop a meaningful recommendation for foundation design at this site. More detailed geotechnical study with deep borings is needed for detailed foundation recommendations.



**AECOM Transportation**

Job No. 209138.10 (A2-UPRR/SR99 Alignment, California High-Speed Train Project, Merced – Fresno Section)

June 1, 2010

Page 37

**PM 10.83 (SR 99)**

Reference: As-Built LOTB (Boring Nos. B-1 and 02-1) for Miles Creek Bridge (Bridge No. 39-07R/L) (Caltrans, 1986, 2003), existing grade elevation: 177 feet  $\pm$  to 180 feet  $\pm$  (on the banks).

The subsoils as noted in 1984 consist of stiff to very stiff clay and clayey silt (SPT blow counts ranging from 16 to 25) to a depth of approximately 13 feet underlain by an 8 feet thick layer of very loose to medium dense silty sand with SPT blow counts ranging from 3 to 12. Predominantly medium dense to dense silty sands (SPT blow counts ranging from 28 to 47) are noted below the loose silty sand layer to a depth of approximately 48 feet. Hard clay with SPT blow count of 50 was then encountered to the depth of 50 feet, the maximum depth explored. The boring drilled in 2002 indicates stiff clays (SPT blow counts ranging from 11 to 15) in the upper 15 feet, underlain by predominantly medium dense silty sands and very stiff sandy silts (SPT blow counts ranging from 18 to 21) to a depth of approximately 55 feet. Stiff to very stiff clays (SPT blow counts ranging from 6 to 15) were then encountered to a depth of 72 feet, underlain by medium dense sands (SPT blow counts ranging from 24 to 27) to a depth of approximately 90 feet, followed by dense sands (SPT blow counts ranging from 39 to 45) to a depth of 100 feet, the maximum depth explored. Groundwater was encountered at elevation 171 feet  $\pm$  (7 feet  $\pm$  below ground surface) June, 1984; measured 170 feet  $\pm$  at nearby Owens Creek Bridge.

Steel piles appear to be the most suitable foundation type at this site due to the possible difficult driving conditions. An allowable bearing capacity of 100 tons is recommended for 16-inch diameter open-ended steel pipe pile with embedded pile length of 75 feet for preliminary estimation. Deep borings at the proposed bridge site based on the final design are recommended to derive design recommendations for bridge foundations.

**PM 10.98 (SR 99)**

Reference: As-Built LOTB (Boring No. B-1, others for Groundwater) for Miles Creek Overflow (Widen) (Bridge No. 39-57) (Caltrans, 1986), existing grade elevation: 178 feet  $\pm$  to 180 feet  $\pm$  (on the banks).

The subsoils consist of medium dense to dense silty and clayey sands (SPT blow counts ranging from 23 to 37) to a depth of 24 feet, underlain by dense to very dense sand (SPT blow counts ranging from 45 to 70) to a depth of 33 feet. A 5-foot thick loose silty sand layer (SPT blow count of 8) is noted below 33 feet, underlain by hard clays and silts (SPT blow counts ranging from 32 to



**AECOM Transportation**

Job No. 209138.10 (A2-UPRR/SR99 Alignment, California High-Speed Train Project, Merced – Fresno Section)

June 1, 2010

Page 38

48) to a depth of 60 feet, the maximum depth explored. Groundwater was encountered at elevation 159 feet  $\pm$  to 161 feet  $\pm$  (18 feet  $\pm$  to 20 feet  $\pm$  below ground surface) December, 1984.

Steel piles appear to be the most suitable foundation type at this site due to the possible difficult driving conditions. An allowable bearing capacity of 100 tons is recommended for 16-inch diameter open-ended steel pipe pile with embedded pile length of 75 feet for preliminary estimation. Deep borings at the proposed bridge site based on the final design are recommended to derive design recommendations for bridge foundations.

**PM 11.41 (SR 99)**

Reference: As-Built LOTB (Boring Nos. B-1 & B-2) for Miles Creek Overflow (Widen) (Bridge No. 39-58) (Caltrans, 1986), existing grade elevation: 179 feet  $\pm$  to 180 feet  $\pm$  (on the banks).

The subsoils on the east bank consists of very stiff silts (SPT blow counts ranging from 22 to 26) to a depth of 20 feet, underlain by predominantly hard silts with layers dense sands (SPT blow counts ranging from 35 to 43) to a depth of 50 feet, the maximum depth explored. This includes a 4 feet layer of very dense layer of silty sand with gravel at a depth of 32 feet. On the west bank, fill and medium stiff clay are noted to a depth of 8 feet underlain by very stiff to hard silts and clays (SPT blow counts ranging from 14 to 34) to a depth of approximately 29 feet. Hard silts and dense sands (SPT blow counts ranging from 47 to 56) are noted to a depth of approximately 39 feet, underlain by stiff to hard silts and clays (SPT blow counts ranging from 16 to 35 to a depth of 65 feet, the maximum depth explored. Groundwater was encountered at elevation 170 feet  $\pm$  (9 feet  $\pm$  below ground surface) in July, 1984.

Steel piles appear to be the most suitable foundation type at this site due to the possible difficult driving conditions. An allowable bearing capacity of 100 tons is recommended for 16-inch diameter open-ended steel pipe pile with embedded pile length of 70 feet for preliminary estimation. Deep borings at the proposed bridge site based on the final design are recommended to derive design recommendations for bridge foundations. Shallow groundwater may also pose liquefaction concerns that need to be further addressed in the foundation design phase.

**PM 11.47 (SR 99)**

Reference: As-Built LOTB (Boring No. 02-1) for Miles Creek Overflow No. 2 (Bridge No. 39-0229/L) (Caltrans, 2003), existing grade elevation: 177 feet  $\pm$ .



**AECOM Transportation**

Job No. 209138.10 (A2-UPRR/SR99 Alignment, California High-Speed Train Project, Merced – Fresno Section)

June 1, 2010

Page 39

The subsoils consist of predominantly stiff to very stiff silts and clays and medium dense sands (SPT blow counts ranging from 11 to 29) in the 100 feet boring. Exceptions include a 5 feet thick dense sand layer (SPT blow count of 35) at approximately 45 feet depth; a 10 feet thick lean clay/sandy silt layer (SPT blow count of 38/39) at approximately 75 feet depth and a 5 feet thick dense sand layer (SPT blow count of 35 and 41 near the bottom of the boring). Groundwater was not measured but observed between 165 feet  $\pm$  and 170 feet  $\pm$  at nearby borings drilled for Bridge No. 39-0228.

Driven PC/PS concrete pile is recommended because it is both feasible and cost effective. An allowable bearing capacity of 100 tons is recommended for 14-inch square PC/PS pile with embedded pile length of 75 feet for preliminary estimation. Deep borings at the proposed bridge site based on the final design are recommended to derive design recommendations for bridge foundations. Shallow groundwater may also pose liquefaction concerns that need to be further addressed in the foundation design phase.

**PM 13.86 (SR 99)**

Reference: As-Built LOTB (Boring Nos. B-1, B-2 and B-3) for Route 99/140 Separation (Bridge No. 39-140R/L) (Caltrans, 1960), existing grade elevation: 170 feet  $\pm$  to 171 feet  $\pm$ .

The subsoils consist of predominantly stiff to hard silt and sandy silt (SPT blow counts ranging from 17 to 42) to approximately 10 feet depth on the north side and approximately 18 feet depth on the south side. On the north side, compact to dense clayey and silty sands and hard plastic silts (SPT blow counts ranging from 23 to 63) are noted below 10 feet depth, to a depth of approximately 23 feet, underlain by dense medium to coarse sand (SPT blow counts ranging from 31 to 60) to a depth of approximately 38 feet. On the south side, dense coarse to fine sand (SPT blow counts ranging from 35 to 56) are noted from approximately 18 feet to 35 feet depth. On both sides, very hard clays and silts (SPT blow counts ranging from 64 to  $>100$ ) are noted below the dense sand layers to 46 feet depth, the maximum depth explored. Groundwater was encountered at elevation 164 feet  $\pm$  (6 feet  $\pm$  below ground surface) in March/April, 1958.

Steel piles appear to be the most suitable foundation type at this site due to the possible difficult driving conditions. The existing borings are too shallow to develop a meaningful preliminary recommendation for foundation support at this site. Further geotechnical exploration is required



**AECOM Transportation**

Job No. 209138.10 (A2-UPRR/SR99 Alignment, California High-Speed Train Project, Merced – Fresno Section)

June 1, 2010

Page 40

for detailed recommendations. Shallow groundwater may also pose liquefaction concerns that need to be further addressed in the foundation design phase.

**PM 13.09 (SR 99)**

Reference: As-Built LOTB (Boring No. B-1; others for Groundwater) for Childs Avenue Overcrossing (Bridge No. 39-143) (Caltrans, 1962), existing grade elevation: 173 feet  $\pm$ .

The subsoils consist of very stiff to hard silts and medium dense to dense sands (SPT blow counts ranging from 28 to 41) to a depth of 26 feet underlain by hard silt interbedded with very dense clean sand to a depth of 40 feet (the maximum depth explored). Groundwater was encountered at elevation 168 feet  $\pm$  (5 feet  $\pm$  below ground surface) in 1958.

Based on LOTB of boring BH-3 drilled by Parikh Consultants for Campus Parkway Overhead project (PM 12.50) on October 24, 2007, and the Soil Boring Report (Geotracker ID T0604713690, PM 13.20), the soil conditions in the upper 40 feet soils are generally consistent with the findings of the Caltrans As-Built LOTBs. The soils below the depth of 40 feet are generally hard lean clay and very stiff silt to the depth of 100 feet below the existing ground surface. Groundwater was encountered in BH-3 at the depth of about 38 feet on October 24, 2007.

Steel piles appear to be the most suitable foundation type at this site due to the possible difficult driving conditions. An allowable bearing capacity of 100 tons is recommended for 16-inch diameter open-ended steel pipe pile with embedded pile length of 65 feet for preliminary estimation. Deep borings at the proposed bridge site based on the final design are recommended to derive design recommendations for bridge foundations.

**PM 13.90 (SR 99)**

Reference: As-Built LOTB (Boring No. B-1; others for Groundwater) for Yosemite Way On-Ramp Undercrossing (Bridge No. 39-141) (Caltrans, 1960), existing grade elevation: 169 feet  $\pm$ .

The subsoils consist of a very dense silty sand layer (SPT blow count of 50) at 5 feet depth underlain by medium dense to dense silty fine sand (SPT blow counts ranging from 24 to 31) to a depth of approximately 30 feet. Dense to very dense sand (SPT blow counts ranging from 44 to 70+) were then encountered to a depth of approximately 38 feet, underlain by very hard silt (SPT



**AECOM Transportation**

Job No. 209138.10 (A2-UPRR/SR99 Alignment, California High-Speed Train Project, Merced – Fresno Section)

June 1, 2010

Page 41

blow count of 50) to a depth of 45 feet, the maximum depth explored. Groundwater was encountered at elevation 164 feet  $\pm$  (5 feet  $\pm$  below ground surface) in 1958.

Steel piles appear to be the most suitable foundation type at this site due to the possible difficult driving conditions. An allowable bearing capacity of 100 tons is recommended for 16-inch diameter open-ended steel pipe pile with embedded pile length of 65 feet for preliminary estimation. Deep borings at the proposed bridge site based on the final design are recommended to derive design recommendations for bridge foundations.

**PM 14.08 (SR 99)**

Reference: As-Built LOTB (Boring Nos. B-1, B-2, B-9 and B-10 for subsoils; others for Groundwater) for East Merced Overhead (Bridge No. 39-130R/L) (Caltrans, 1960), existing grade elevation: 168 feet  $\pm$  to 170 feet  $\pm$ .

The subsoils on the east side consist of a very hard silt layer (SPT blow count of 51) to a depth of approximately 8 feet, underlain predominantly by very stiff silts and medium dense sands (SPT blow counts ranging from 17 to 26) to a depth of 40 feet. Hard sandy silts and sandy clays (SPT blow counts ranging from 30 to 56) were then encountered to a depth 65 feet depth, the maximum depth explored. On the west side, the subsoils consist of medium dense to dense silty sands (SPT blow counts ranging from 25 to 39) underlain by very hard sandy clay and concretionary silt (SPT blow counts of 70 to 100) to a depth of approximately 32 feet. Layers of medium dense sands and stiff to hard silts and clays (SPT blow counts ranging from 15 to 48) are noted below 32 feet to a depth of 75 feet, underlain by very stiff to hard silts and very dense sands (SPT blow counts 100+ below 75 feet depth to 90 feet depth). Groundwater was encountered at elevation 162 feet  $\pm$  to 164 feet  $\pm$  (5 feet  $\pm$  to 7 feet  $\pm$  below ground surface).

Steel piles appear to be the most suitable foundation type at this site due to the possible difficult driving conditions. An allowable bearing capacity of 100 tons is recommended for 16-inch diameter open-ended steel pipe pile with embedded pile length of 65 feet for preliminary estimation. Deep borings at the proposed bridge site based on the final design are recommended to derive design recommendations for bridge foundations. Shallow groundwater may also pose liquefaction concerns that need to be further addressed in the foundation design phase.

**PM 14.22 (SR 99)**



**AECOM Transportation**

Job No. 209138.10 (A2-UPRR/SR99 Alignment, California High-Speed Train Project, Merced – Fresno Section)

June 1, 2010

Page 42

Reference: As-Built LOTB (Boring Nos. B-1 & B-2 for subsoils; others for Groundwater) for 15th Street Undercrossing (Bridge No. 39-139R/L) (Caltrans, 1960), existing grade elevation: 168 feet  $\pm$ .

The subsoils on the west side consist of a hard silt layer (SPT blow count  $>100$ ) in the upper 8 feet underlain by very stiff silt (SPT blow counts ranging from 17 to 22) to a depth of approximately 16 feet, followed by dense sand and very hard silt (SPT blow counts ranging from 44 to 54) to a depth of approximately 33 feet. Very stiff silts and medium dense sands (SPT blow counts ranging from 18 to 28) were then encountered to a depth of 65 feet, the maximum depth explored. On the east side, a 5 feet thick very hard surficial silt layer is underlain by very stiff to hard silts and medium dense to dense sands to 65 feet depth, the maximum depth explored. Groundwater was encountered at elevation 162 feet  $\pm$  to 164 feet  $\pm$  (5 feet  $\pm$  to 7 feet  $\pm$  below ground surface).

Steel piles appear to be the most suitable foundation type at this site due to the possible difficult driving conditions. An allowable bearing capacity of 100 tons is recommended for 16-inch diameter open-ended steel pipe pile with embedded pile length of 65 feet for preliminary estimation. Deep borings at the proposed bridge site based on the final design are recommended to derive design recommendations for bridge foundations. Shallow groundwater may also pose liquefaction concerns that need to be further addressed in the foundation design phase.

**PM 14.42 (SR 99)**

Reference: As-Built LOTB (Boring Nos. B-1 & B-2 for subsoils; others for Groundwater) for G Street Undercrossing (Bridge No. 39-142R/L) (Caltrans, 1960), existing grade elevation: 167 feet  $\pm$ .

The subsoils consist of a surficial hard to very hard silt layer (SPT blow count of 60), extending to a depth of approximately 8 feet. On the west side, the surficial silt layer is underlain by medium dense to very dense sand layers and sandy/clayey silt (SPT blow counts ranging from 18 to 66) to approximately 28 feet depth, underlain by a very hard silt layer (SPT blow count  $>70$ ) to a depth of approximately 36 feet. Very stiff to hard silts and clays (SPT blow counts of 27) are noted below 36 feet depth, to 50 feet depth, the maximum depth explored. On the east side, the surficial silt layer is underlain by very stiff to hard silts and sandy silts (SPT blow counts ranging from 24 to 50) to a depth of approximately 34 feet, underlain by a very hard clayey silt layer (SPT blow count  $>70$ ) to a depth of approximately 42 feet. Hard clayey silt (SPT blow count of 37) is noted below



**AECOM Transportation**

Job No. 209138.10 (A2-UPRR/SR99 Alignment, California High-Speed Train Project, Merced – Fresno Section)

June 1, 2010

Page 43

42 feet depth, to 50 feet depth (the maximum depth explored). Groundwater was encountered at elevation 158 feet  $\pm$  to 160 feet  $\pm$  (7 feet  $\pm$  to 8 feet  $\pm$  below ground surface).

Steel piles appear to be the most suitable foundation type at this site due to the possible difficult driving conditions. The existing borings are too shallow to develop a meaningful preliminary recommendation for foundation support at this site. Further geotechnical exploration is required for detailed recommendations. Shallow groundwater may also pose liquefaction concerns that need to be further addressed in the foundation design phase.

**PM 14.67 (SR 99)**

Reference: As-Built LOTB (Boring Nos. B-1 & B-3 for subsoils; others for Groundwater) for Route 99/59 Separation (Bridge No. 39-136R/L) (Caltrans, 1960), existing grade elevation: 165 feet  $\pm$  to 166 feet  $\pm$ .

The subsoils consist of a hard to very hard silt layer (SPT blow counts ranging from 34 to 72), extending to a depth of approximately 8 to 10 feet. The silt layer is underlain predominantly by medium dense to dense sand layers (SPT blow counts ranging from 17 to 32) to approximately 32 feet depth, underlain by a hard sandy clay/clayey silt layer (SPT blow counts ranging from 35 to 52) to a depth of approximately 40 feet. Hard to very hard clay is noted from a depth of 40 feet to a depth of 50 feet, the maximum depth explored. Groundwater was encountered at elevation 157 feet  $\pm$  (9 feet  $\pm$  to 10 feet  $\pm$  below ground surface).

Steel piles appear to be the most suitable foundation type at this site due to the possible difficult driving conditions. An allowable bearing capacity of 100 tons is recommended for 16-inch diameter open-ended steel pipe pile with embedded pile length of 65 feet for preliminary estimation. Deep borings at the proposed bridge site based on the final design are recommended to derive design recommendations for bridge foundations. Shallow groundwater may also pose liquefaction concerns that need to be further addressed in the foundation design phase.

**PM 14.87 (SR 99)**

Reference: As-Built LOTB (Boring Nos. B-1 and B-6 for subsoils; others for Groundwater) for L Street UC (Bridge No. 39-133R/L) (Caltrans, 1960), existing grade elevation: 165 feet  $\pm$ .

The subsoils consist of very hard silt layer (SPT blow count ranging from 52 to > 100) within 10



**AECOM Transportation**

Job No. 209138.10 (A2-UPRR/SR99 Alignment, California High-Speed Train Project, Merced – Fresno Section)

June 1, 2010

Page 44

feet near the surface. On the north side, stiff to very stiff silts and medium dense silty sands (SPT blow counts ranging from 13 to 23) are noted below 10 feet depth to a depth of approximately 25 feet, underlain by very dense sand (SPT blow counts ranging from 52 to >70) to 40 feet depth (the maximum depth explored). On the south side, a stiff to hard silt layer (SPT blow counts ranging from 14 to 35) is noted below 10 feet depth to a depth of approximately 17 feet, underlain by compact to dense silty sand (SPT blow counts ranging from 28 to 42) to a depth of approximately 27 feet. The silty sand layer is underlain by hard silt, dense sand and hard clay (SPT blow counts ranging from 47 to 49) to 40 feet depth, the maximum depth explored. Groundwater was encountered at elevation 153 feet  $\pm$  to 155 feet  $\pm$  (10 feet  $\pm$  to 12 feet  $\pm$  below ground surface).

Steel piles appear to be the most suitable foundation type at this site due to the possible difficult driving conditions. The existing borings are too shallow to develop a meaningful preliminary recommendation for foundation support at this site. Further geotechnical exploration is required for detailed recommendations. Shallow groundwater may also pose liquefaction concerns that need to be further addressed in the foundation design phase.

**PM 14.96 (SR 99)**

Reference: As-Built LOTB (Boring Nos. B-1 & B-6 for subsoils; others for Groundwater) for M Street UC (Bridge No. 39-134R/L) (Caltrans, 1960), existing grade elevation: 164 feet  $\pm$ .

The subsoils consist of a very hard silt layer ( SPT blow count > 70) within 5 feet near the surface, underlain by hard clayey silts and dense silty fine sands (SPT blow counts ranging from 38 to 56) to a depth of approximately 40 feet. Very dense sands and hard silty clays (SPT blow counts ranging from 37 to 70+) were then encountered to a depth of 50 feet, the maximum depth explored. Groundwater was encountered at elevation 152 feet  $\pm$  to 154 feet  $\pm$  (9 feet  $\pm$  to 11 feet  $\pm$  below ground surface).

Steel piles appear to be the most suitable foundation type at this site due to the possible difficult driving conditions. An allowable bearing capacity of 100 tons is recommended for 16-inch diameter open-ended steel pipe pile with embedded pile length of 65 feet for preliminary estimation. Deep borings at the proposed bridge site based on the final design are recommended to derive design recommendations for bridge foundations. Shallow groundwater may also pose liquefaction concerns that need to be further addressed in the foundation design phase.



**AECOM Transportation**

Job No. 209138.10 (A2-UPRR/SR99 Alignment, California High-Speed Train Project, Merced – Fresno Section)

June 1, 2010

Page 45

**PM 15.15 (SR 99)**

Reference: As-Built LOTB (Boring Nos. B-1&B-6 for subsoils; others for Groundwater) for O Street UC (Bridge No. 39-135R/L) (Caltrans, 1960), existing grade elevation: 163 feet ±.

The subsoils consist of a surficial layer of stiff silt to depths of 6 feet at the northern end and 3 feet at the southern end, underlain by interbedded layers of compact to hard/dense silts (including clayey silts and sandy silts) and sands to depths of 40 feet to 43 feet. The SPT blow counts in the silt layer range from 26 to 44, except at both ends a very hard clayey silt layer (SPT blow counts of 64 and 70) is noted. The very hard clayey silt layer occurs at 20 feet depth at the southern end and is 10 feet thick; at the northern end it occurs at 30 feet depth and only about 3 feet thick. The interbedded layer is underlain by very stiff to hard silty clay (SPT blow count of 50) to 45 feet depth, the maximum depth explored. Groundwater was encountered at elevation 152 feet ± to 154 feet ± (9 feet ± to 11 feet ± below ground surface).

Steel piles appear to be the most suitable foundation type at this site due to the possible difficult driving conditions. The existing borings are too shallow to develop a meaningful preliminary recommendation for foundation support at this site. Further geotechnical exploration is required for detailed recommendations. Shallow groundwater may also pose liquefaction concerns that need to be further addressed in the foundation design phase.

**PM 15.42 (SR 99)**

Reference: As-Built LOTB (Boring No. B-4 for subsoils; others for Groundwater) for R Street UC (Bridge No. 39-137R/L) (Caltrans, 1960), existing grade elevation: 161 feet ± to 162 feet ±.

The subsoils on the south side consist of hard silt/sandy silt (SPT blow counts ranging from 33 to 37) to a depth of approximately 15 feet, grading to very stiff to hard clayey silt (SPT blow counts ranging from 26 to 32) to 40 feet depth. A 12 feet layer of softer clayey silt (SPT blow count of 10) is noted between 40 feet and 52 feet depths, underlain by a compact sand and gravel (SPT blow count of 17) to 68 feet depth. Very stiff clay and dense sand are noted to 75 feet depth, the maximum depth explored. On the north side, stiff clay and hard silt/sandy silt (SPT blow counts ranging from 36 to 39) are noted to a depth of approximately 15 feet, underlain by a 5 feet thick compact sand layer (SPT blow count of 14). The compact sand layer is underlain by dense silty sand and sandy silt (SPT blow counts ranging from 31 to 51) to a depth of approximately 57 feet. Very stiff clayey silt is noted below 57 feet depth to 60 feet depth, the maximum depth explored.



**AECOM Transportation**

Job No. 209138.10 (A2-UPRR/SR99 Alignment, California High-Speed Train Project, Merced – Fresno Section)

June 1, 2010

Page 46

Groundwater was encountered at elevation 152 feet  $\pm$  to 154 feet  $\pm$  (8 feet  $\pm$  to 10 feet  $\pm$  below ground surface).

Driven PC/PS concrete pile is recommended because it is both feasible and cost effective. An allowable bearing capacity of 100 tons is recommended for 14-inch square PC/PS pile with embedded pile length of 60 feet for preliminary estimation. Deep borings at the proposed bridge site based on the final design are recommended to derive design recommendations for bridge foundations. Shallow groundwater may also pose liquefaction concerns that need to be further addressed in the foundation design phase.

**PM 15.78 (SR 99)**

Reference: As-Built LOTB (Boring Nos. B-1& B-2 for subsoils; others for Groundwater) for Route 90/140 Separation (Br. No. 39-138R/L) (Caltrans, 1960), existing grade elevation: 161 feet  $\pm$ .

The subsoils consist of very hard silt (SPT blow counts ranging from 38 to 70+) in the upper 12 feet, underlain by layers of compact to very dense sandy silt to silty sand (SPT blow counts ranging from 23 to 70+). Very stiff to hard clay (SPT blow counts ranging from 28 to 50) was then encountered to a depth of 50 feet, the maximum depth explored. Groundwater was encountered at elevation 152 feet  $\pm$  to 157 $\pm$  (4 feet  $\pm$  to 9 feet  $\pm$  below ground surface).

Steel piles appear to be the most suitable foundation type at this site due to the possible difficult driving conditions. The existing borings are too shallow to develop a meaningful preliminary recommendation for foundation support at this site. Further geotechnical exploration is required for detailed recommendations. Shallow groundwater may also pose liquefaction concerns that need to be further addressed in the foundation design phase.

**PM 16.38 (SR 99)**

Reference: As-Built LOTB (Boring No. B-4 for subsoils; others for Groundwater) for Bear Creek (Bridge No. 39-132R/L) (Caltrans, 1960), existing grade elevation: 160 feet  $\pm$  to 165 feet  $\pm$ .

The subsoils consist of soft to stiff clayey silt in the upper 10 feet, underlain by approximately 4 feet thick of very stiff clay followed by loose to slightly compact clayey sand (SPT blow counts ranging from <1 to 11) to a depth of approximately 22 feet. A medium dense silty sand layer (SPT



**AECOM Transportation**

Job No. 209138.10 (A2-UPRR/SR99 Alignment, California High-Speed Train Project, Merced – Fresno Section)

June 1, 2010

Page 47

blow count of 23) was then encountered to a depth of 30 feet underlain by hard clayey/sandy silts and hard clay (SPT blow counts ranging from 59 to 67) to a depth of approximately 55 feet followed by a very dense sand layer to a depth of 60 feet, the maximum depth explored. Groundwater was encountered at elevation 152 feet  $\pm$  (10 feet  $\pm$  below ground surface).

Steel piles appear to be the most suitable foundation type at this site due to the possible difficult driving conditions. Due to the weak soils in the upper 22 feet, the existing borings are too shallow to develop a meaningful preliminary recommendation for foundation support at this site. Further geotechnical exploration is required for detailed recommendations. Shallow groundwater may also pose liquefaction concerns that need to be further addressed in the foundation design phase.

**PM 16.54 (SR 99)**

Reference: As-Built LOTB (Boring Nos. B-4, B-6, B-8) for West Merced Overhead (Bridge No. 39-131L/R) (Caltrans, 1960), existing grade elevation: 159 feet  $\pm$  to 161 feet  $\pm$ .

The subsoils consist of predominantly of loose to compact silts and sands (SPT blow counts ranging from 7 to 27) to approximately 20 feet depth, underlain by approximately 5 feet of very dense sand (SPT blow counts ranging from 50 to  $>70$ ). Hard silts and silty clays (SPT blow counts ranging from 33 to  $>70$ ) underlie the very dense sands to depths of approximately 45 feet, the maximum depths explored in two of three borings. A stiff silty clay layer (SPT blow count of 12), was encountered in the northernmost boring below 45 feet depth to the bottom of the boring at approximately 50 feet depth. Groundwater was encountered at elevation 153 feet  $\pm$  to 156 feet  $\pm$  (6 feet  $\pm$  to 9 feet  $\pm$  below ground surface) in February, 1959.

Steel piles appear to be the most suitable foundation type at this site due to the possible difficult driving conditions. The existing borings are too shallow to develop a meaningful preliminary recommendation for foundation support at this site. Further geotechnical exploration is required for detailed recommendations. Shallow groundwater may also pose liquefaction concerns that need to be further addressed in the foundation design phase.

**PM 17.30 (SR 99)**

Reference: As-Built LOTB (Boring Nos. B-1, B-3) for Black Rascal Canal (Br. Nos. 39-10R/L, 39C-37) (Caltrans, 1960), existing grade elevation: 157 feet  $\pm$  to 162 feet  $\pm$ .



**AECOM Transportation**

Job No. 209138.10 (A2-UPRR/SR99 Alignment, California High-Speed Train Project, Merced – Fresno Section)

June 1, 2010

Page 48

The subsoils at the west side of the bridge consist of very loose to slightly compact silts and sands (SPT blow counts ranging from 4 to 19) in the upper 26 feet, underlain by medium dense sand (SPT blow count of 26) to a depth of 33 feet. Very stiff to hard silts and dense to very dense sands and silty sands (SPT blow counts ranging from 38 to 52) were then encountered to a depth of approximately 55 feet, the maximum depth explored. At the east side of the bridge, the subsoils consist of stiff to hard silts and sandy silts (SPT blow counts of 44) in the upper 10 feet, underlain by loose to slightly compact sand and silty sand (SPT blow counts ranging from 9 to 17) to approximately 24 feet depth. Hard to very hard silts (SPT blow counts ranging from 29 to 60) were then encountered to a depth of 42 feet, underlain by medium dense sand (SPT blow count of 21) to the maximum depth explored (60 feet). Groundwater was encountered at elevation 146 feet  $\pm$  (11 feet  $\pm$  below ground surface) in March, 1959.

Steel piles appear to be the most suitable foundation type at this site due to the possible difficult driving conditions. An allowable bearing capacity of 100 tons is recommended for 16-inch diameter open-ended steel pipe pile with embedded pile length of 65 feet for preliminary estimation. Deep borings at the proposed bridge site based on the final design are recommended to derive design recommendations for bridge foundations. Shallow groundwater may also pose liquefaction concerns that need to be further addressed in the foundation design phase.

**PM 18.51 (SR 99)**

Reference: As-Built LOTB (Boring Nos. B-1, B-6) for Franklin Road Overcrossing (Bridge No. 39-84) (Caltrans, 1962), existing grade elevation: 151 to 153 feet  $\pm$ .

The subsoils consist of loose to medium dense silty sand (SPT blow counts ranged from 15 to 24) in the upper 5 feet, underlain by dense to very dense sand and silty sand and hard to very hard silt and sandy silt (SPT blow counts ranged from 41 to 70+) to a depth of 45 feet, the maximum depth explored. Groundwater was encountered at elevation 143 feet  $\pm$  to 145 feet  $\pm$  (5 feet  $\pm$  to 9 feet  $\pm$  below ground surface) in January, 1959.

Steel piles appear to be the most suitable foundation type at this site due to the possible difficult driving conditions. The existing borings are too shallow to develop a meaningful preliminary recommendation for foundation support at this site. Further geotechnical exploration is required for detailed recommendations. Shallow groundwater may also pose liquefaction concerns that need to be further addressed in the foundation design phase.





### 5.3.4 Seismic Design Considerations

Based on the California High-Speed Train Project Technical Memorandum: 15% Seismic Design Benchmarks (TM 2.10.5) dated March 15, 2010: in the absence of any project specific seismic design spectra, designers are directed to United States Geological Survey (USGS) Earthquake Hazards Program. USGS has developed 2002 United States National Seismic Hazard Maps of contours of seismic design parameters for the Maximum Considered Earthquake (MCE) event. These mapped parameters are accessible through USGS earthquake ground motion Java calculator, which may be used during 15% seismic design.

For details regarding the seismic ground motion parameters, refer to ASCE7-05 [9, Section 11.4], which defines the parameters  $S_{MS}$  and  $S_{M1}$ : the 0.2-second and 1.0-second site adjusted spectral response acceleration for the MCE-type event, respectively. The default spectral damping is 5%.

Within the Java calculator, 15% Design MCE spectra are to be developed as follows:

1. Choose ASCE 7 Standard.
2. Input project specific latitude and longitude.
3. If no soil data is available, assume Site Class D.
4. Establish site modified  $S_a$  vs.  $T$  spectral ordinates for MCE.
5. Multiply the Site Modified  $S_a$  vs.  $T$  spectral ordinates for MCE by an Importance Factor,  $I = 1.25$  (i.e., Occupancy Category III per ASCE 7-05).

We have developed four (4) representative Design MCE spectra for preliminary seismic design considerations. Based on the geotechnical information collected and our experience with the geological formation in the project area, the site can be generally classified as Site Class D. The seismic design parameters obtained based on the procedures described above are summarized in following table. The Design MCE spectra, as presented in Plate 5, were developed based on the  $S_{DS}$  and  $S_{D1}$  values and a Importance Factor of 1.25.

**Summary of Seismic Design Parameters**

Site	Site Location (Lat. –Long.)	Site Classification	$S_s$	$S_1$	$F_a$	$F_v$	$S_{DS}$	$S_{D1}$	$I$
Fresno	36.71768° -119.78458°	D	0.531g	0.229g	1.375	1.943	0.487g	0.296g	1.25
Madera	36.96151° -120.06479°	D	0.549g	0.228g	1.361	1.943	0.498g	0.296g	1.25
Chowchilla	37.12691° -120.25230°	D	0.545g	0.229g	1.364	1.942	0.495g	0.296g	1.25
Merced	37.29573° -120.47280°	D	0.553g	0.235g	1.358	1.931	0.500g	0.302g	1.25



## **6.0 ADDITIONAL GEOTECHNICAL EXPLORATIONS AND STUDIES**

This preliminary geotechnical study was conducted for the Merced – Fresno Section of California High-Speed Train Project; this report is intended to help define the overall design program and evaluate cost impacts. This study was planned so as to provide an overview of the subsurface conditions along the project alignment and not necessarily for use in structure specific foundation designs. Additional subsurface explorations should be conducted as part of the 30% design. At a minimum the intent of the detail program should be to:

1. Collect data where no readily available LOTB exist;
2. Refine soil data at critical structures;
3. Update/confirm data to more effectively develop design parameters;
4. In-fill locations to develop a better understanding of the subsurface conditions;
5. Address specific locations where “problem” soil and groundwater conditions may exist.

## **7.0 LIMITATIONS**

Our services consist of professional opinions and recommendations made in accordance with generally accepted geotechnical engineering principles and practices for the defined scope and are based on our data research and the assumption that the subsurface conditions do not deviate from reported conditions. All work done is in accordance with generally accepted geotechnical engineering principles and practices. No warranty, expressed or implied, of merchantability or fitness, is made or intended in connection with our work or by the furnishing of oral or written reports or findings.

The scope of our services did not include any environmental assessment or investigation for the presence or absence of hazardous or toxic materials in structures, soil, surface water, groundwater or air, below or around this site. Unanticipated soil conditions are commonly encountered and cannot be fully determined by taking soil samples and excavating test borings; different soil conditions may require that additional expenditures be made during construction to attain a properly constructed project. Some contingency fund is thus recommended to accommodate these possible extra costs.

This report has been prepared for the proposed project as described earlier, to assist the engineer in the preliminary (15%) design of this project. In the event any changes in the design or location of the facilities are planned, or if any variations or undesirable conditions are encountered during



**AECOM Transportation**

Job No. 209138.10 (A2-UPRR/SR99 Alignment, California High-Speed Train Project, Merced – Fresno Section)

June 1, 2010

Page 51

subsequent studies or during construction, our conclusions and recommendations shall not be considered valid unless the changes or variations are reviewed and our recommendations modified or approved by us in writing.

This report is issued with the understanding that it is the designer's responsibility to ensure that the information and recommendations contained herein are incorporated into the project and that necessary steps are also taken to see that the recommendations are carried out in the field. Additional studies are required to refine and/or update the design to a 30% level.


The findings in this report are valid as of the present date. However, changes in the subsurface conditions can occur with the passage of time, whether they are due to natural processes or to the works of man, on this or adjacent properties. In addition, changes in applicable or appropriate standards occur, whether they result from legislation or from the broadening of knowledge. Accordingly, the findings in this report might be invalidated, wholly or partially, by changes outside of our control.

Respectfully submitted,


**PARIKH CONSULTANTS, INC.**



Zengxuan (Frank) Li, Ph.D., P.E. C69415  
Project Engineer

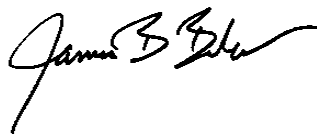

James B. Baker, CEG 1021  
Project Engineering Geologist

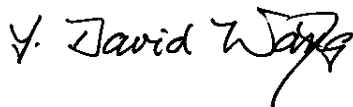


Y. David Wang, Ph.D., P.E. C52911  
Senior Engineer



Gary Parikh, P.E., G.E., 666  
Project Manager






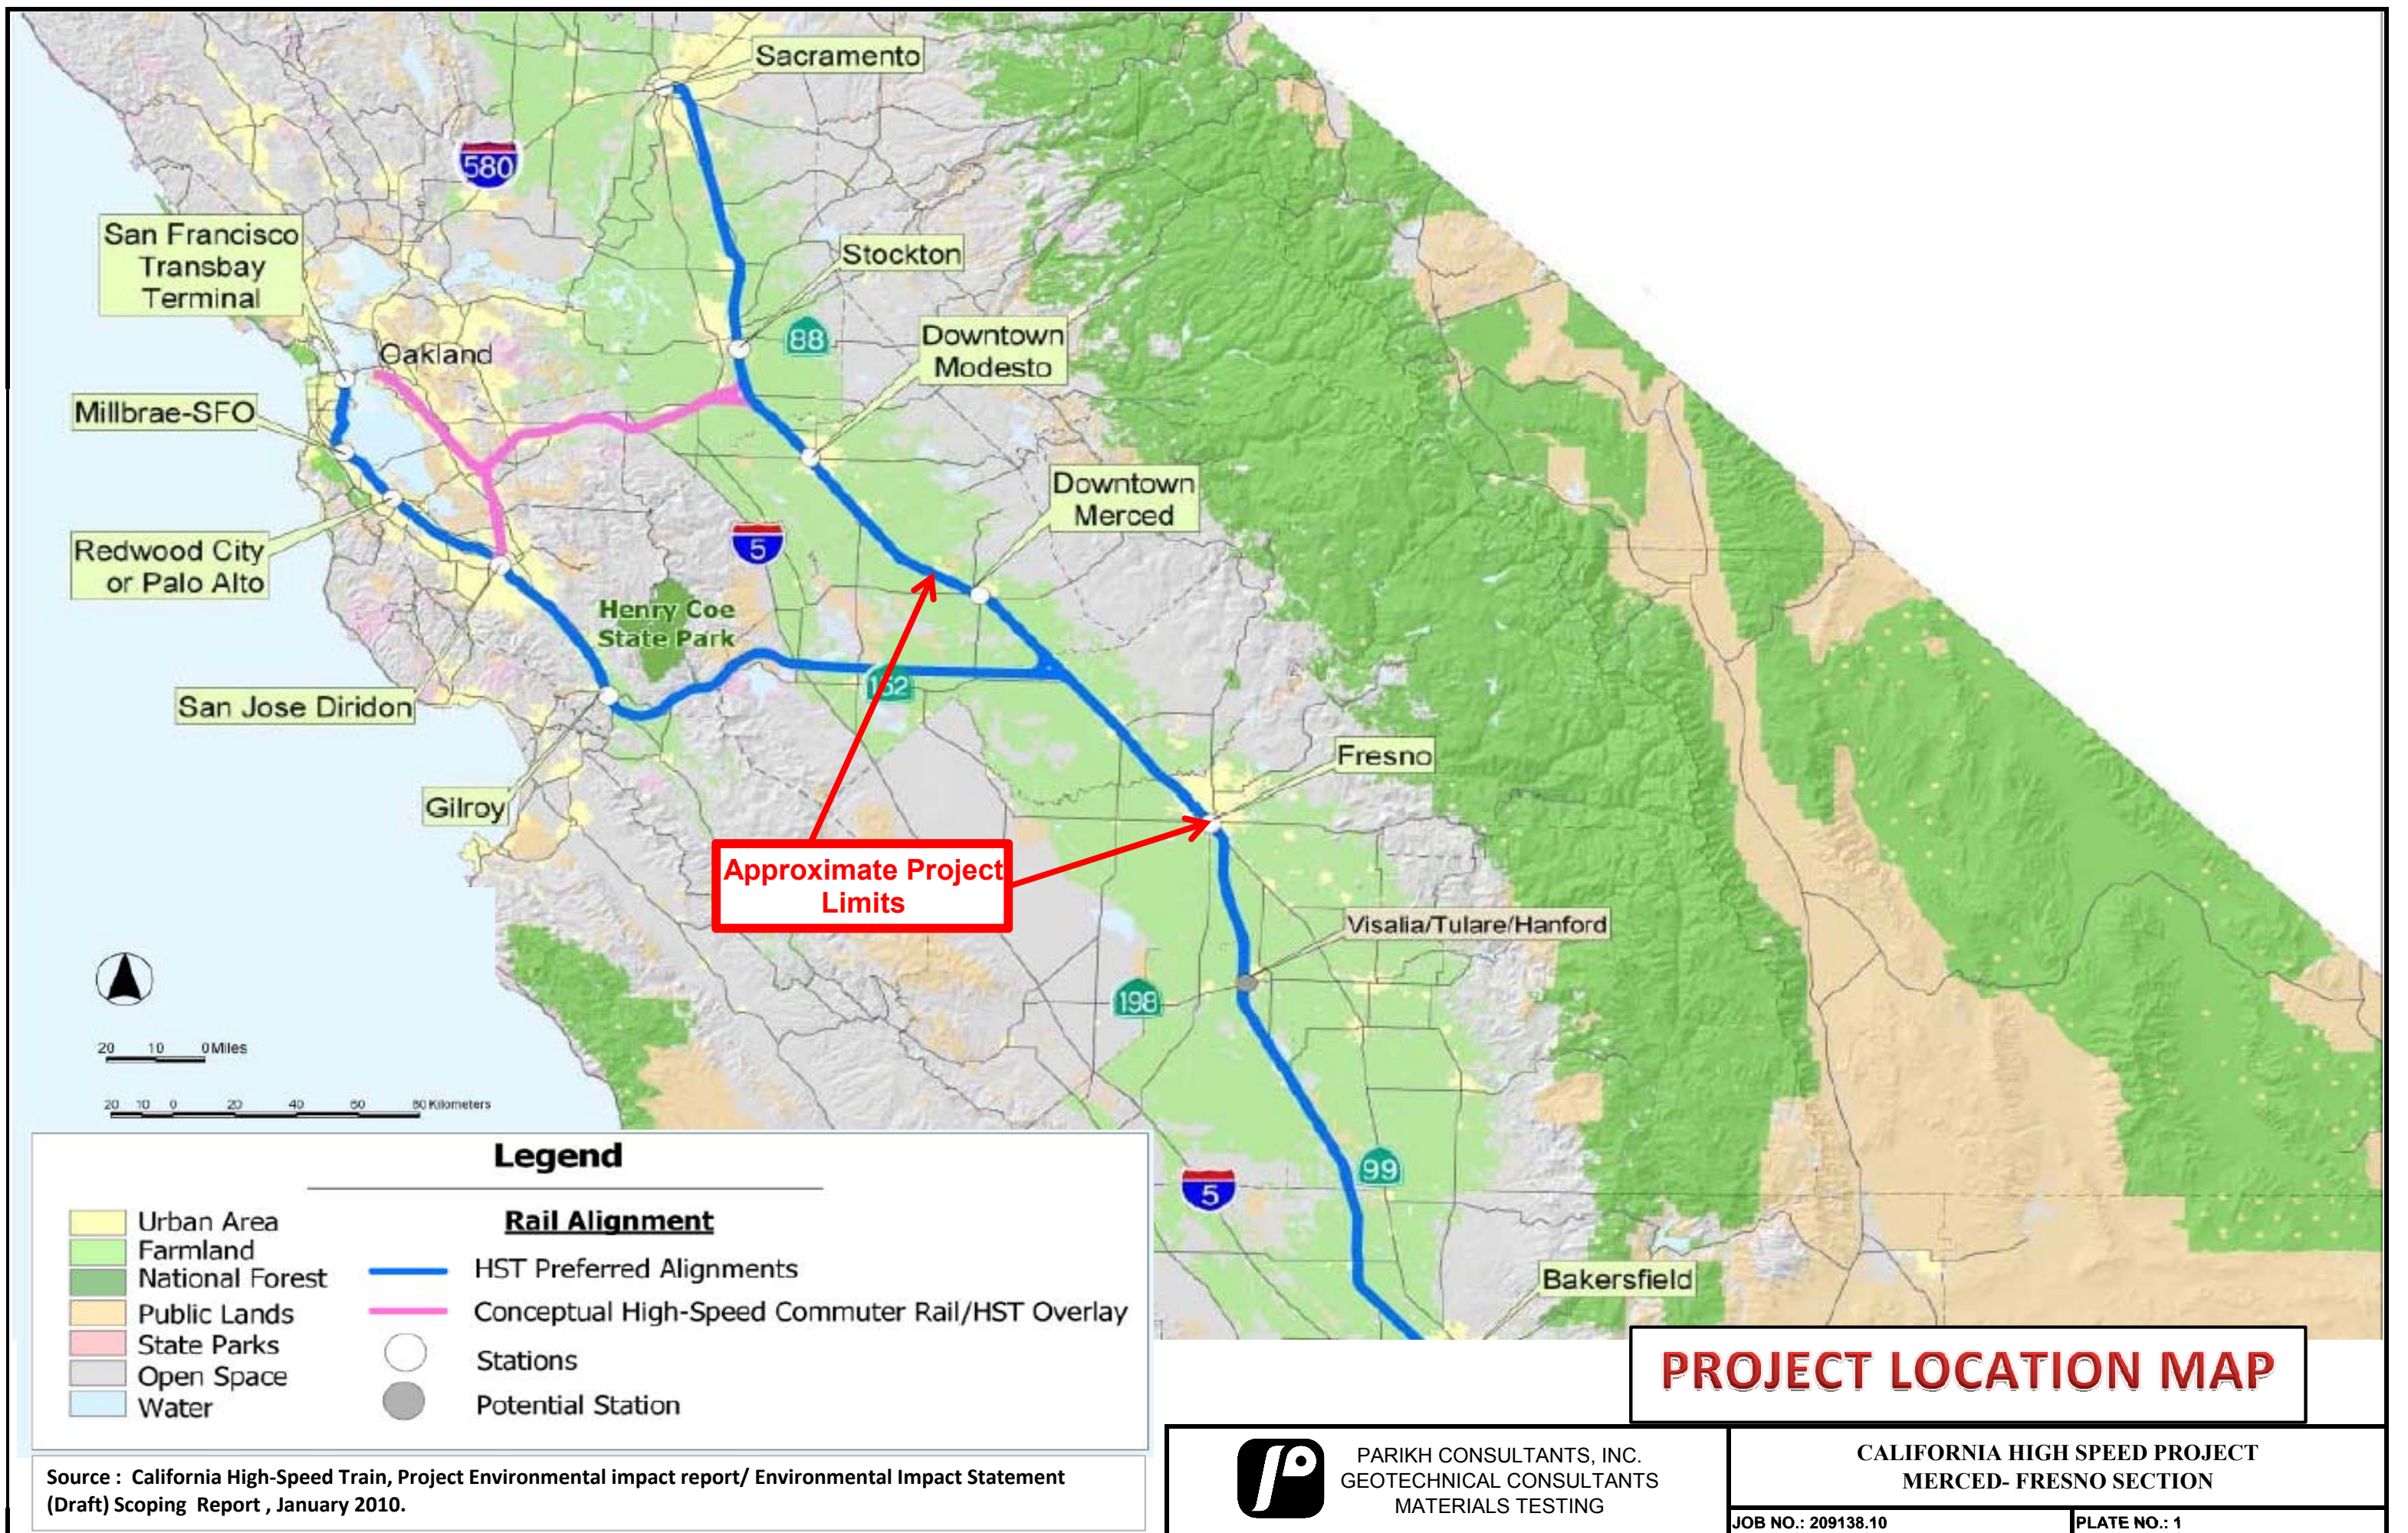




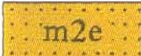
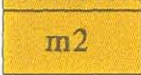
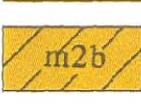
DESCRIPTION OF MAP UNITS

POST-MODESTO DEPOSITS



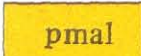
	Undifferentiated alluvium
	Marsh and lacustrine deposits

MODESTO FORMATION

Upper member—Divided into:


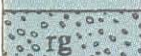

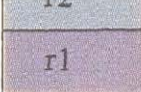
	Eolian sand
	Arkosic alluvium along major westward-flowing rivers—Derived from interior of Sierra Nevada. Upper fans and terraces
	Fine-grained stratified alluvium of flood basins, lower fans, and interdistributary areas

Lower member—Divided into:

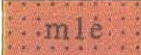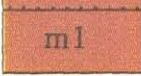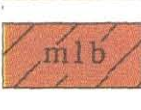	Eolian sand
	Arkosic alluvium along major westward-flowing rivers—Derived from interior of Sierra Nevada. Upper fans and terraces
	Fine-grained, better stratified alluvium of flood basins, lower fans, and interdistributary areas



RIVERBANK FORMATION

Upper unit—Includes:

	Arkosic sandy channel alluvium
	Colluvial lag gravel
	Middle unit—Arkosic sandy channel alluvium and minor eolian sand
	Lower unit—Arkosic sandy alluvium

TURLOCK LAKE FORMATION


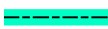


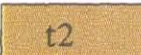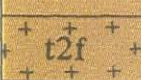


Upper unit—Divisible into:

	Undifferentiated arkosic alluvium
	Friant Pumice Member

SOILS UNITS (NRCS)

DhA - Delhi loamy sand (0 - 3% slopes)  
Es - Exeter sandy loam  
Et - Exeter sandy loam, shallow  
Ex - Exeter loam  
Hc - Hanford sandy loam  
HdA - Hanford fine sandy loam, mod. deep  
Hd - Hanford sandy loam, benches  
HI - Hanford gravelly sandy loam  
Hst - Hesperia fine sandy loam, mod. deep  
Pk - pits  
SaA - San Joaquin sandy loam (0 -3% slopes)  
ScA - San Joaquin sandy loam  
SdA - San Joaquin sandy loam, shallow  
SgA - San Joaquin loam, shallow (0-3% slopes)

Legend

-  map sheet & number
-  limits of project corrior (1 mile wide)
-  Post Mile# PM \*\*. \*\*
-  Bridge# BR\*\*-\*\*\*
-  Caltrans bridges
  - GeoTracker# T\*\*\*\*\*
  - Tank Leak Sites
  -  have boring logs
  -  may have boring logs
  - no boring logs found

See PLATES 2-1 thru 2-27 for map sheets

Geologic and Soils Maps Explanation



PARIKH CONSULTANTS, INC.  
GEOTECHNICAL CONSULTANTS  
MATERIALS TESTING



SOURCES:  
geology from Marchand and Allwardt; 1981; USGS  
soils units from NRCS  
bridges from Caltrans  
tank leak sites from GeoTracker website

California High-Speed Train Project  
(Merced - Fresno Section)

JOB NO.: 209138.10

PLATE NO.: 2-0



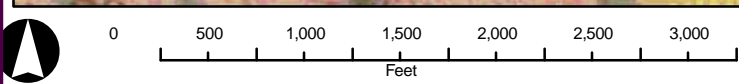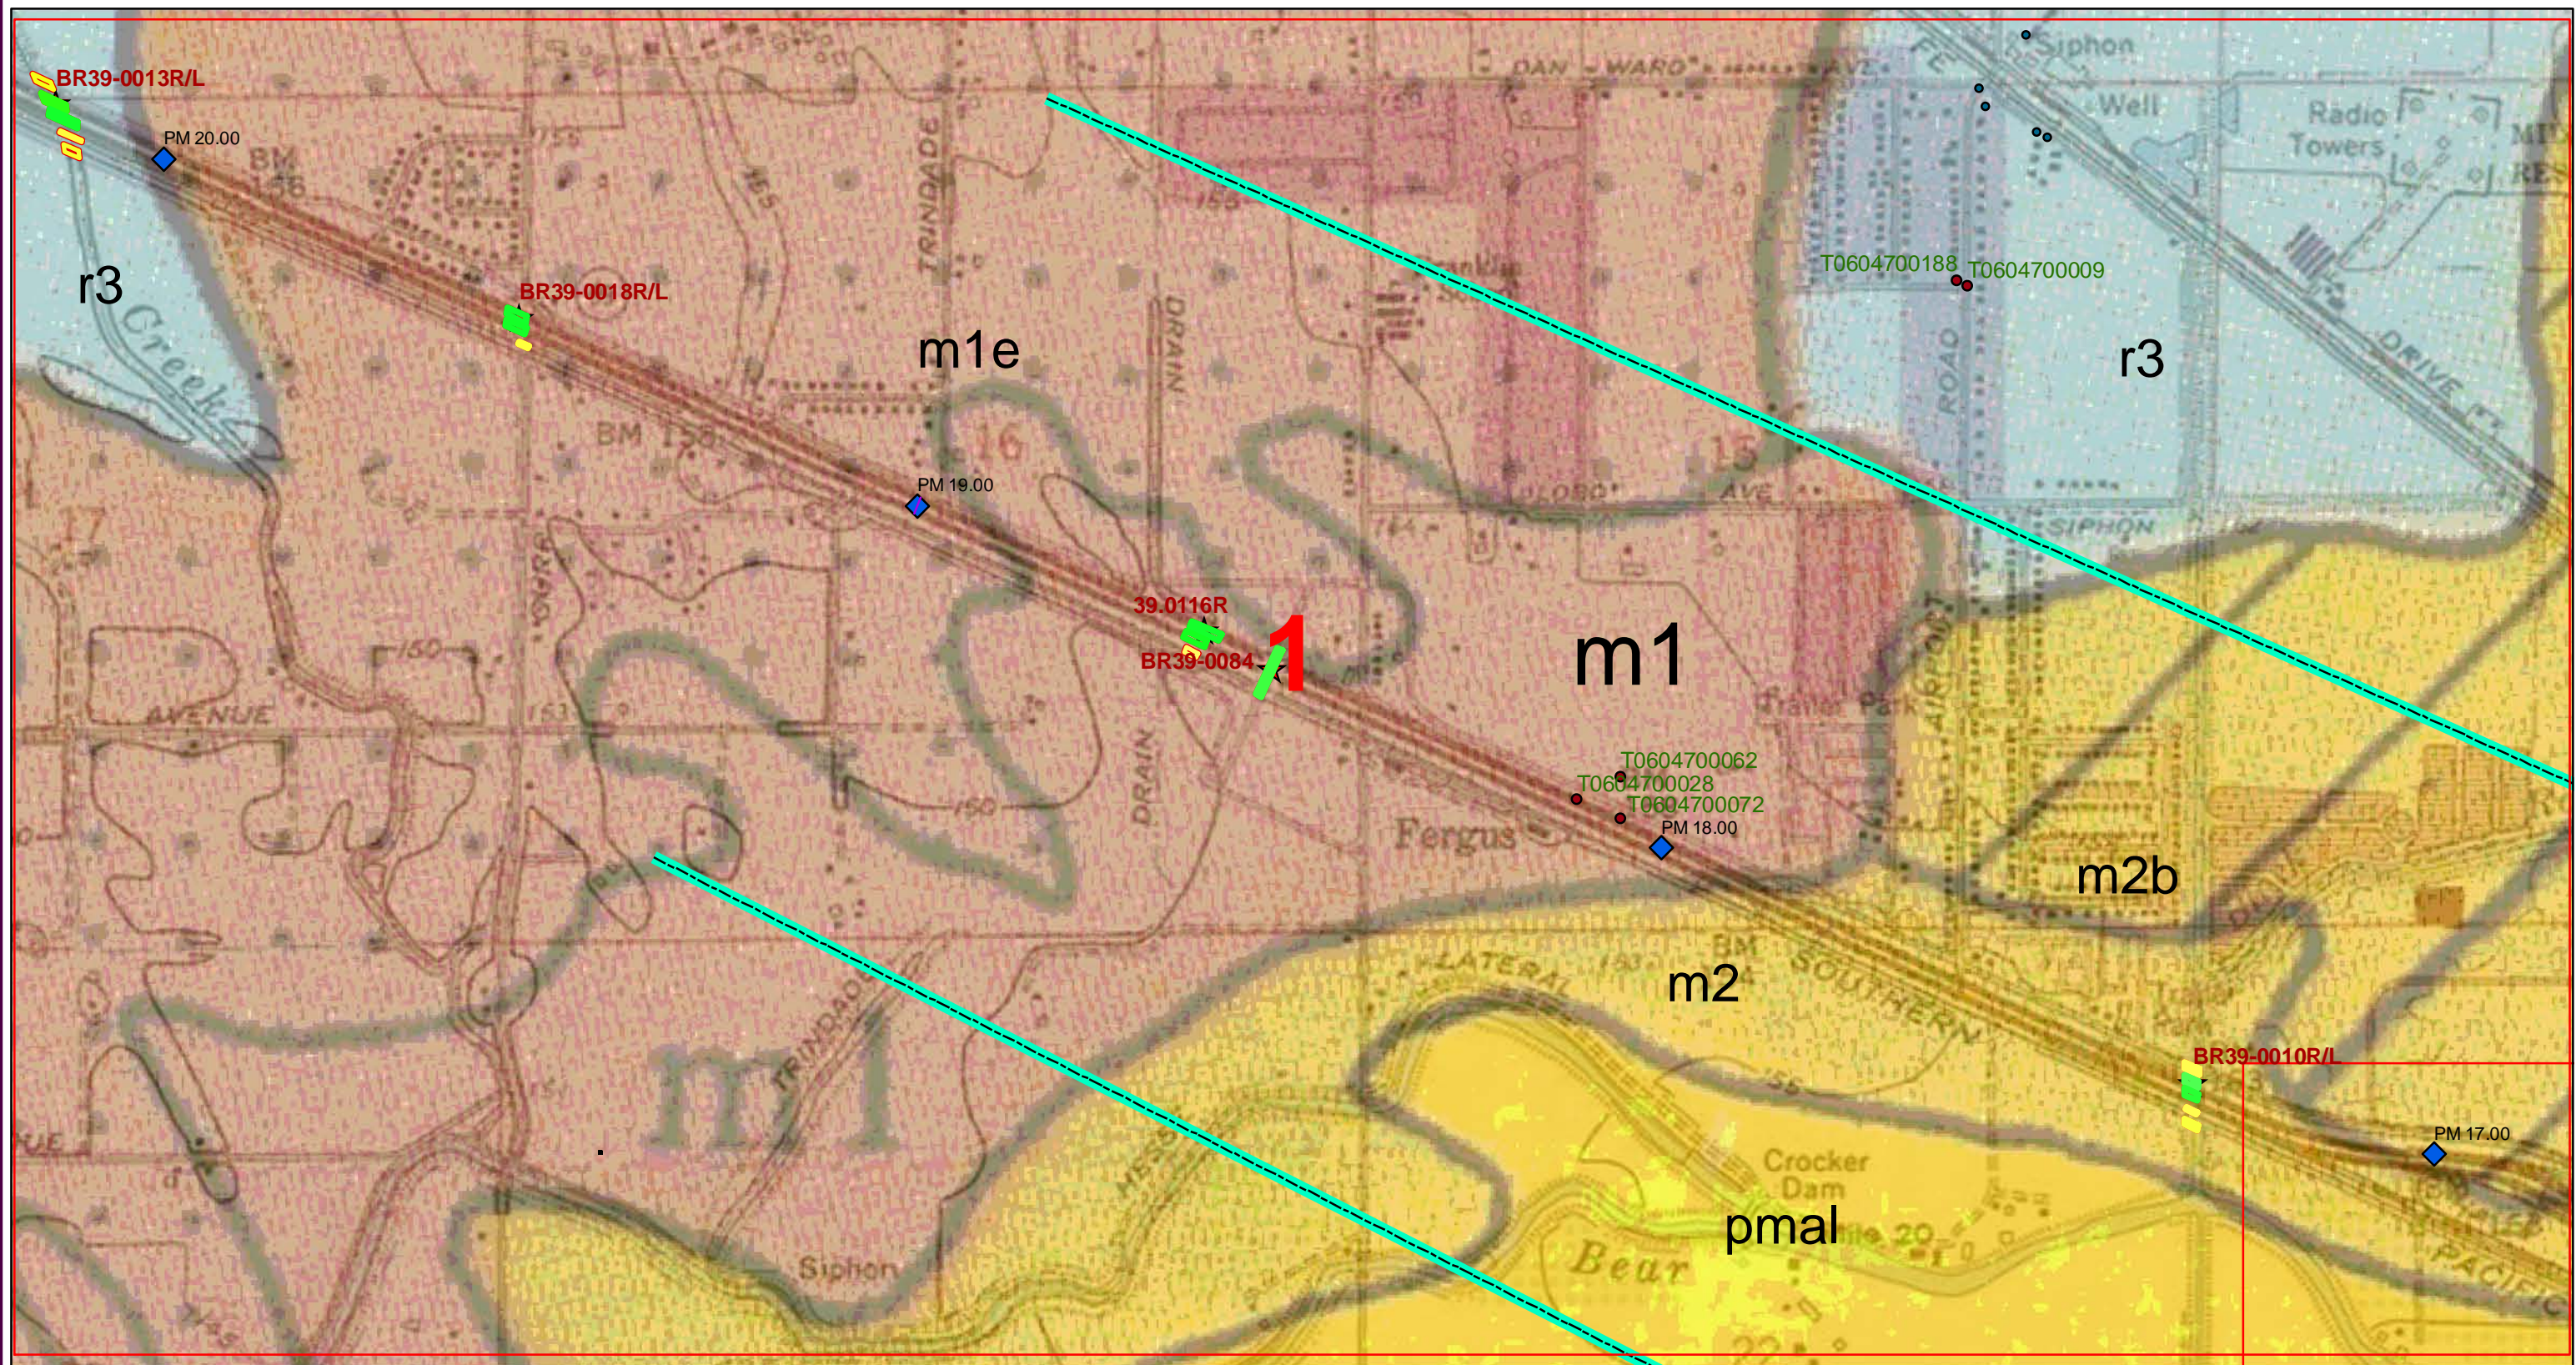

See PLATE 2-0 for Legend

Geologic Map and Site Plan




**PARIKH CONSULTANTS, INC.**  
**GEOTECHNICAL CONSULTANTS**  
**MATERIALS TESTING**

**SOURCES:**  
 Geology from Marchand and Allwardt; 1981; USGS Bulletin 1470.  
 Caltrans bridges.  
 GeoTracker sites.

California High-Speed Train Project  
 (Merced - Fresno Section)

JOB NO.: 209138.10      PLATE NO.: 2-1



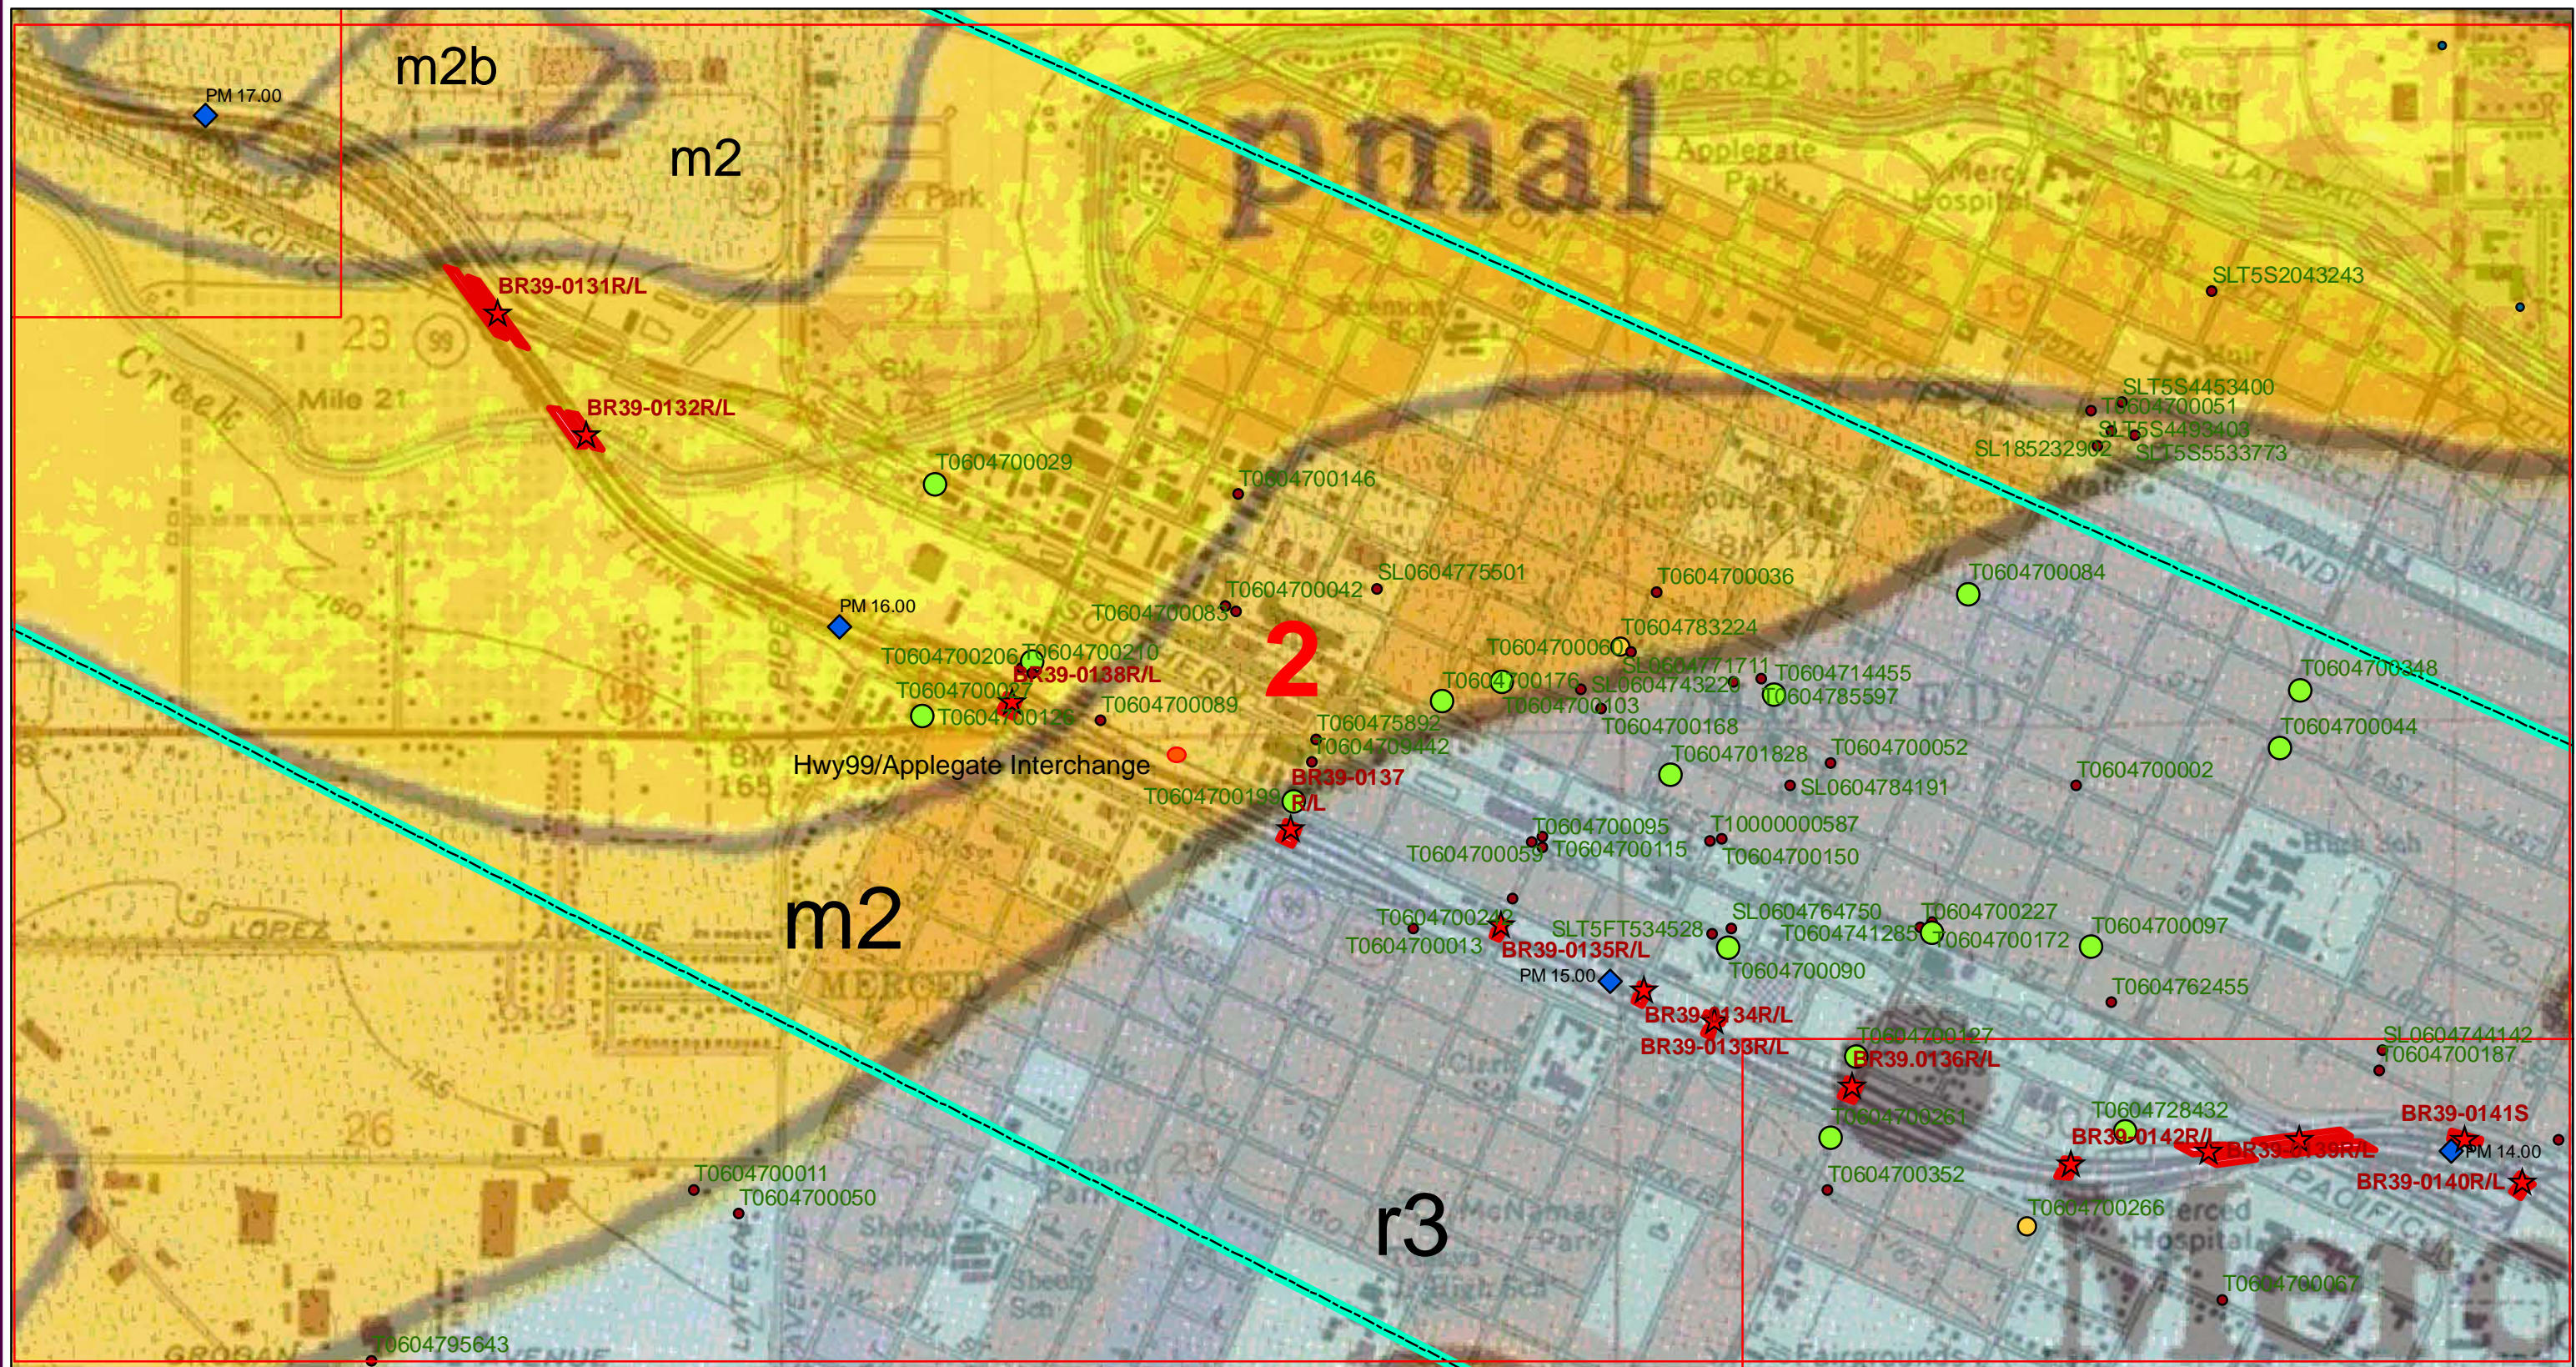

0 500 1,000 1,500 2,000 2,500 3,000  
Feet

See PLATE 2-0 for Legend

Geologic Map and Site Plan



PARIKH CONSULTANTS, INC.  
GEOTECHNICAL CONSULTANTS  
MATERIALS TESTING


SOURCES:  
Geology from Marchand and Allwardt; 1981; USGS Bulletin 1470.  
Caltrans bridges.  
GeoTracker sites.

California High-Speed Train Project  
(Merced - Fresno Section)

JOB NO.: 209138.10

PLATE NO.: 2-2



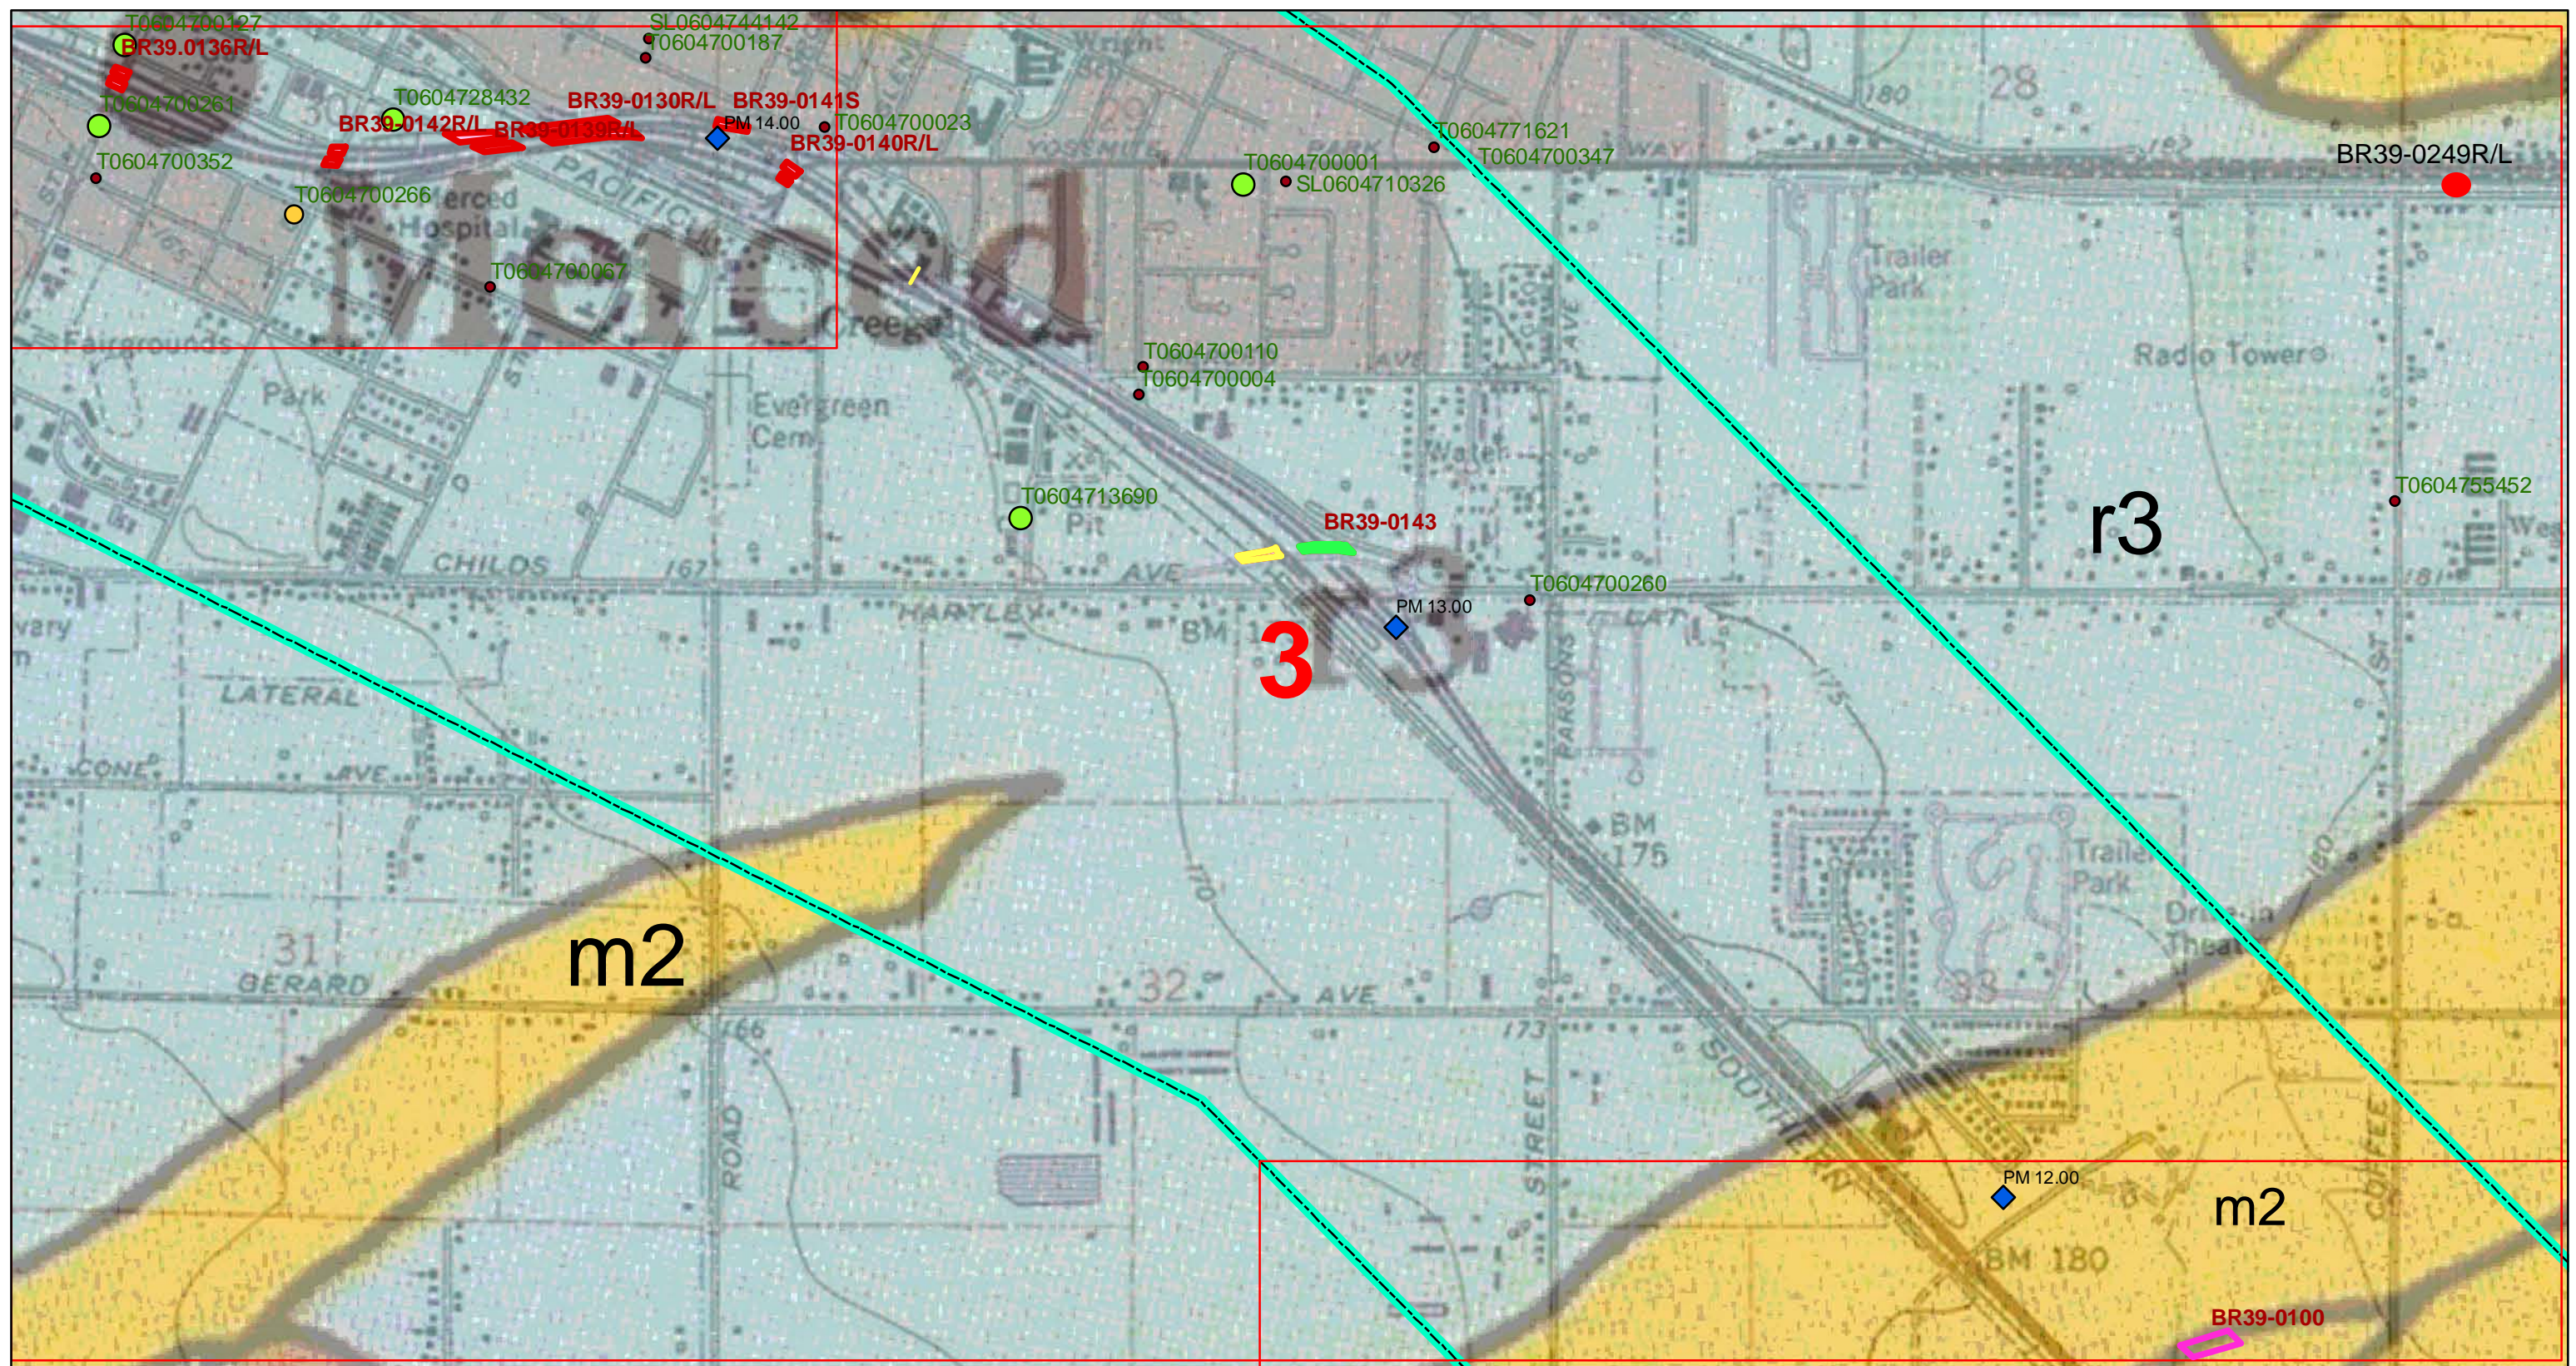

0 500 1,000 1,500 2,000 2,500 3,000  
Feet

See PLATE 2-0 for Legend

Geologic Map and Site Plan



PARIKH CONSULTANTS, INC.  
GEOTECHNICAL CONSULTANTS  
MATERIALS TESTING


SOURCES:  
Geology from Marchand and Allwardt; 1981; USGS Bulletin 1470.  
Caltrans bridges.  
GeoTracker sites.

California High-Speed Train Project  
(Merced - Fresno Section)

JOB NO.: 209138.10

PLATE NO.: 2-3



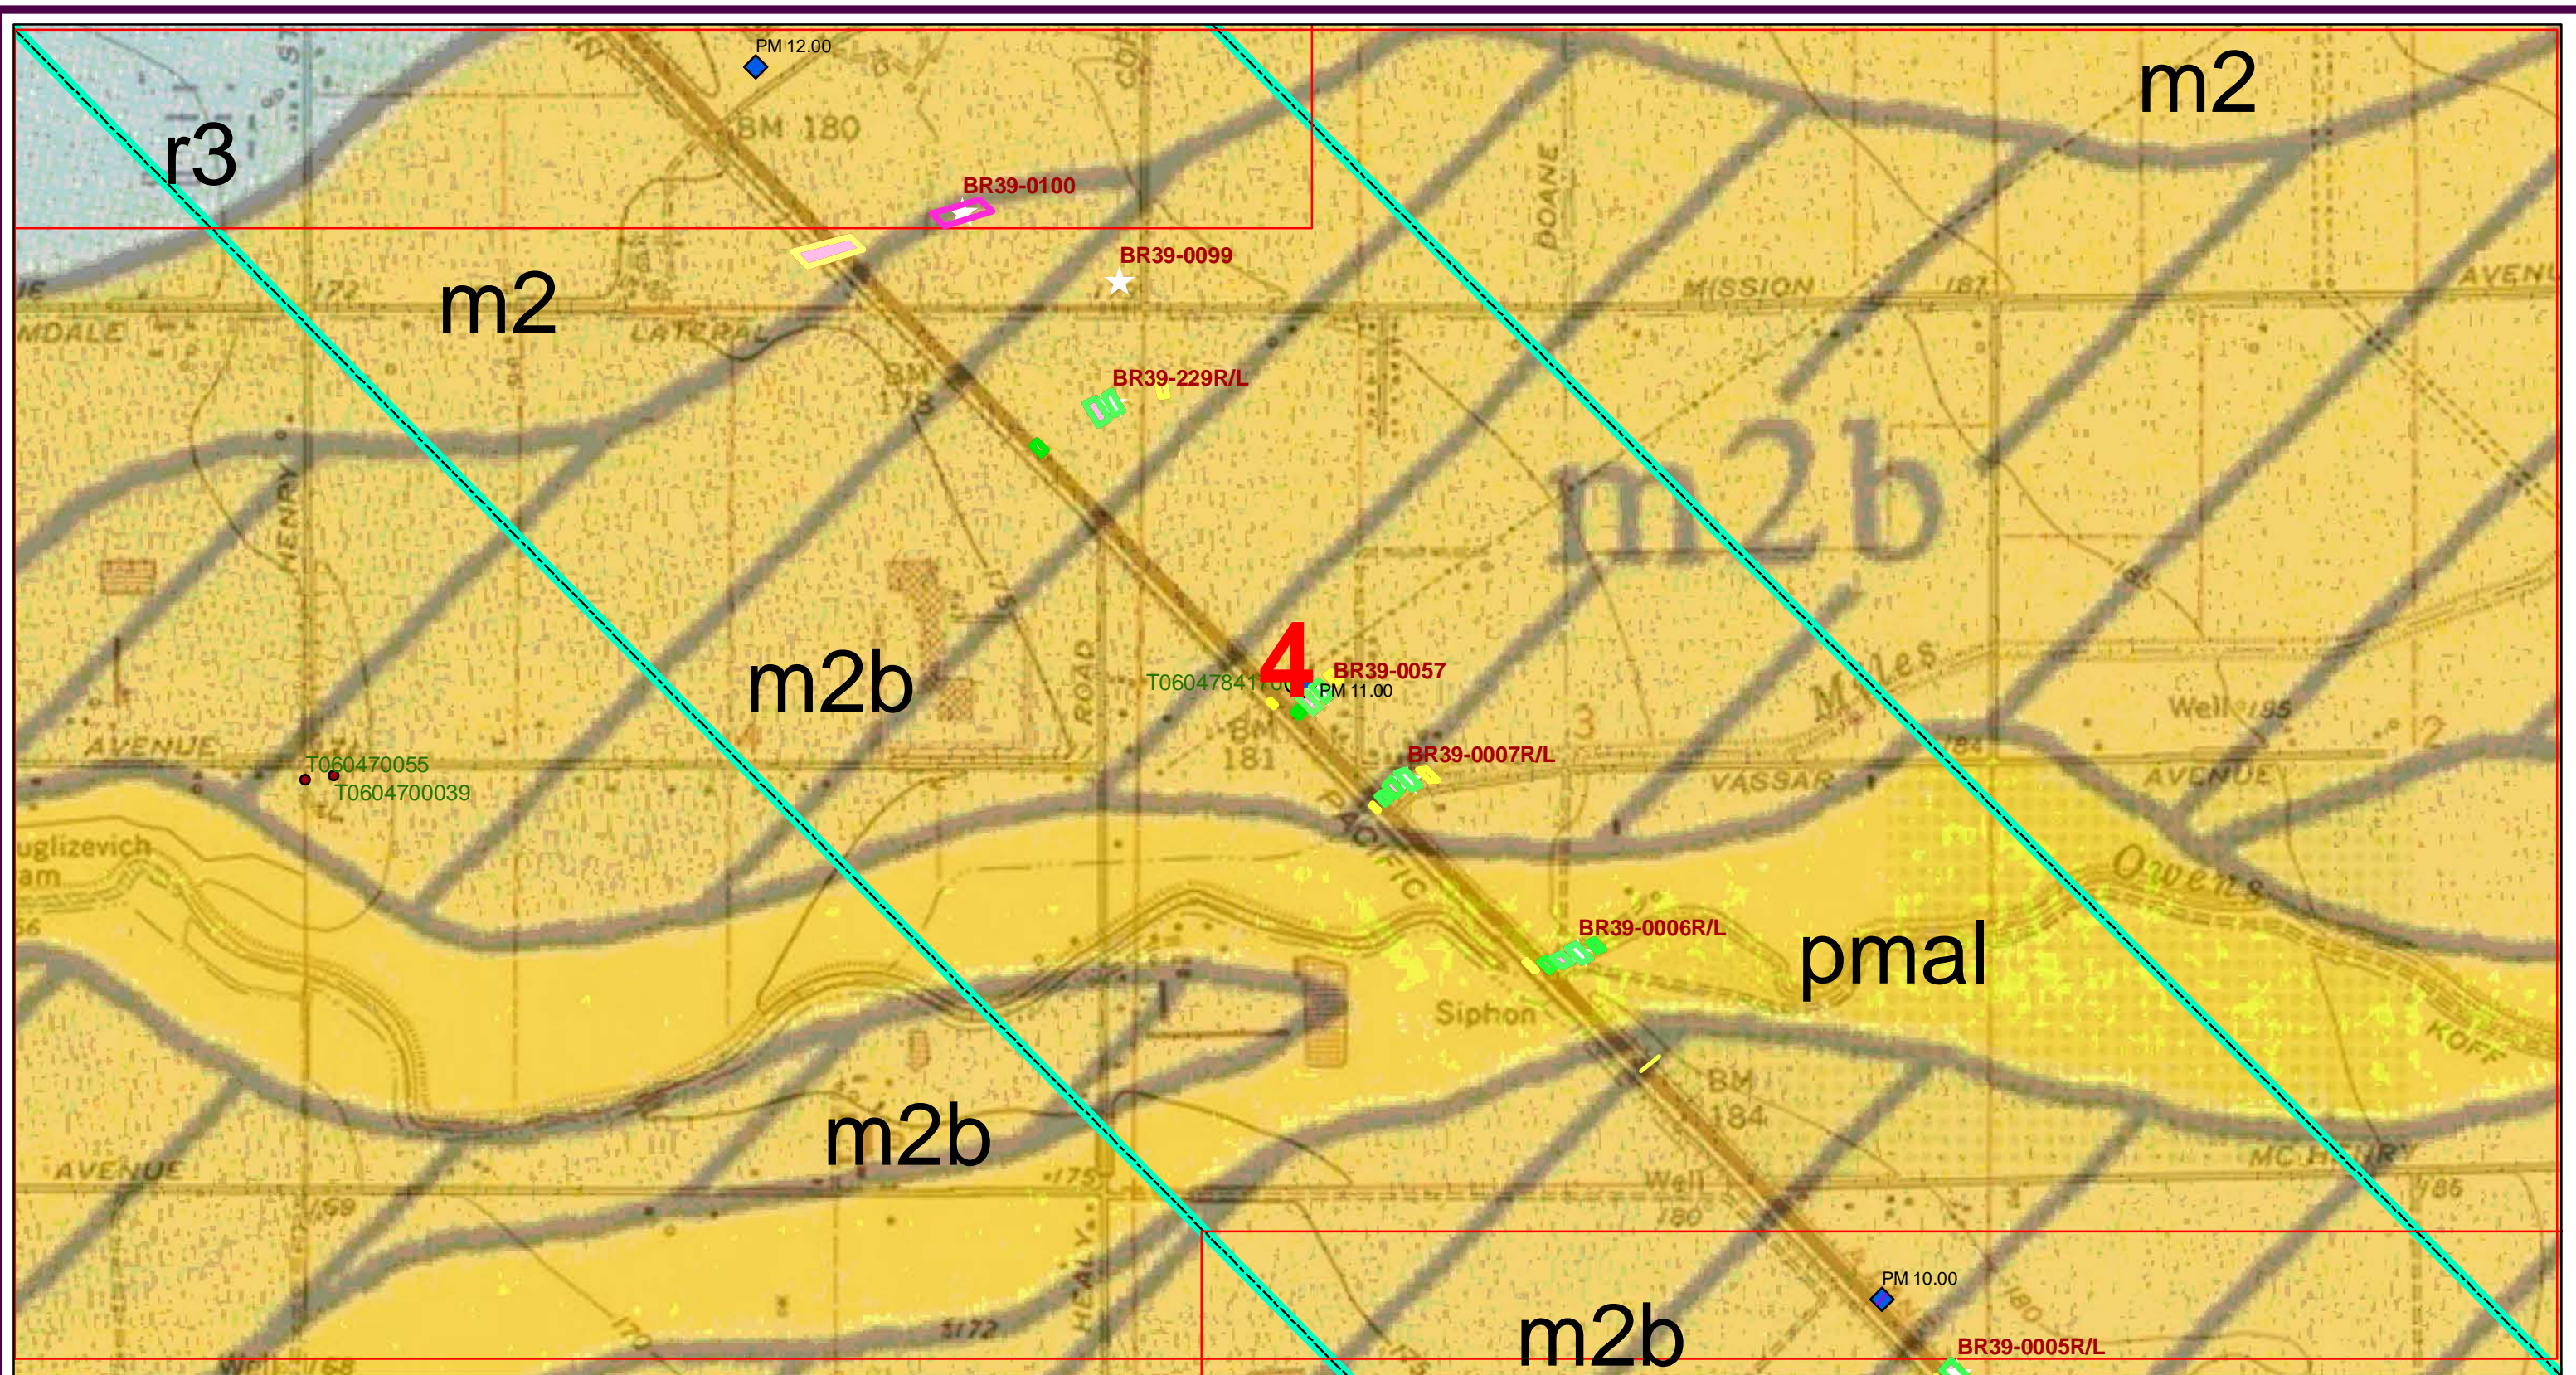

0 500 1,000 1,500 2,000 2,500 3,000  
Feet

See PLATE 2-0 for Legend

Geologic Map and Site Plan



PARIKH CONSULTANTS, INC.  
GEOTECHNICAL CONSULTANTS  
MATERIALS TESTING


SOURCES:  
Geology from Marchand and Allwardt; 1981; USGS Bulletin 1470.  
Caltrans bridges.  
GeoTracker sites.

California High-Speed Train Project  
(Merced - Fresno Section)

JOB NO.: 209138.10

PLATE NO.: 2-4



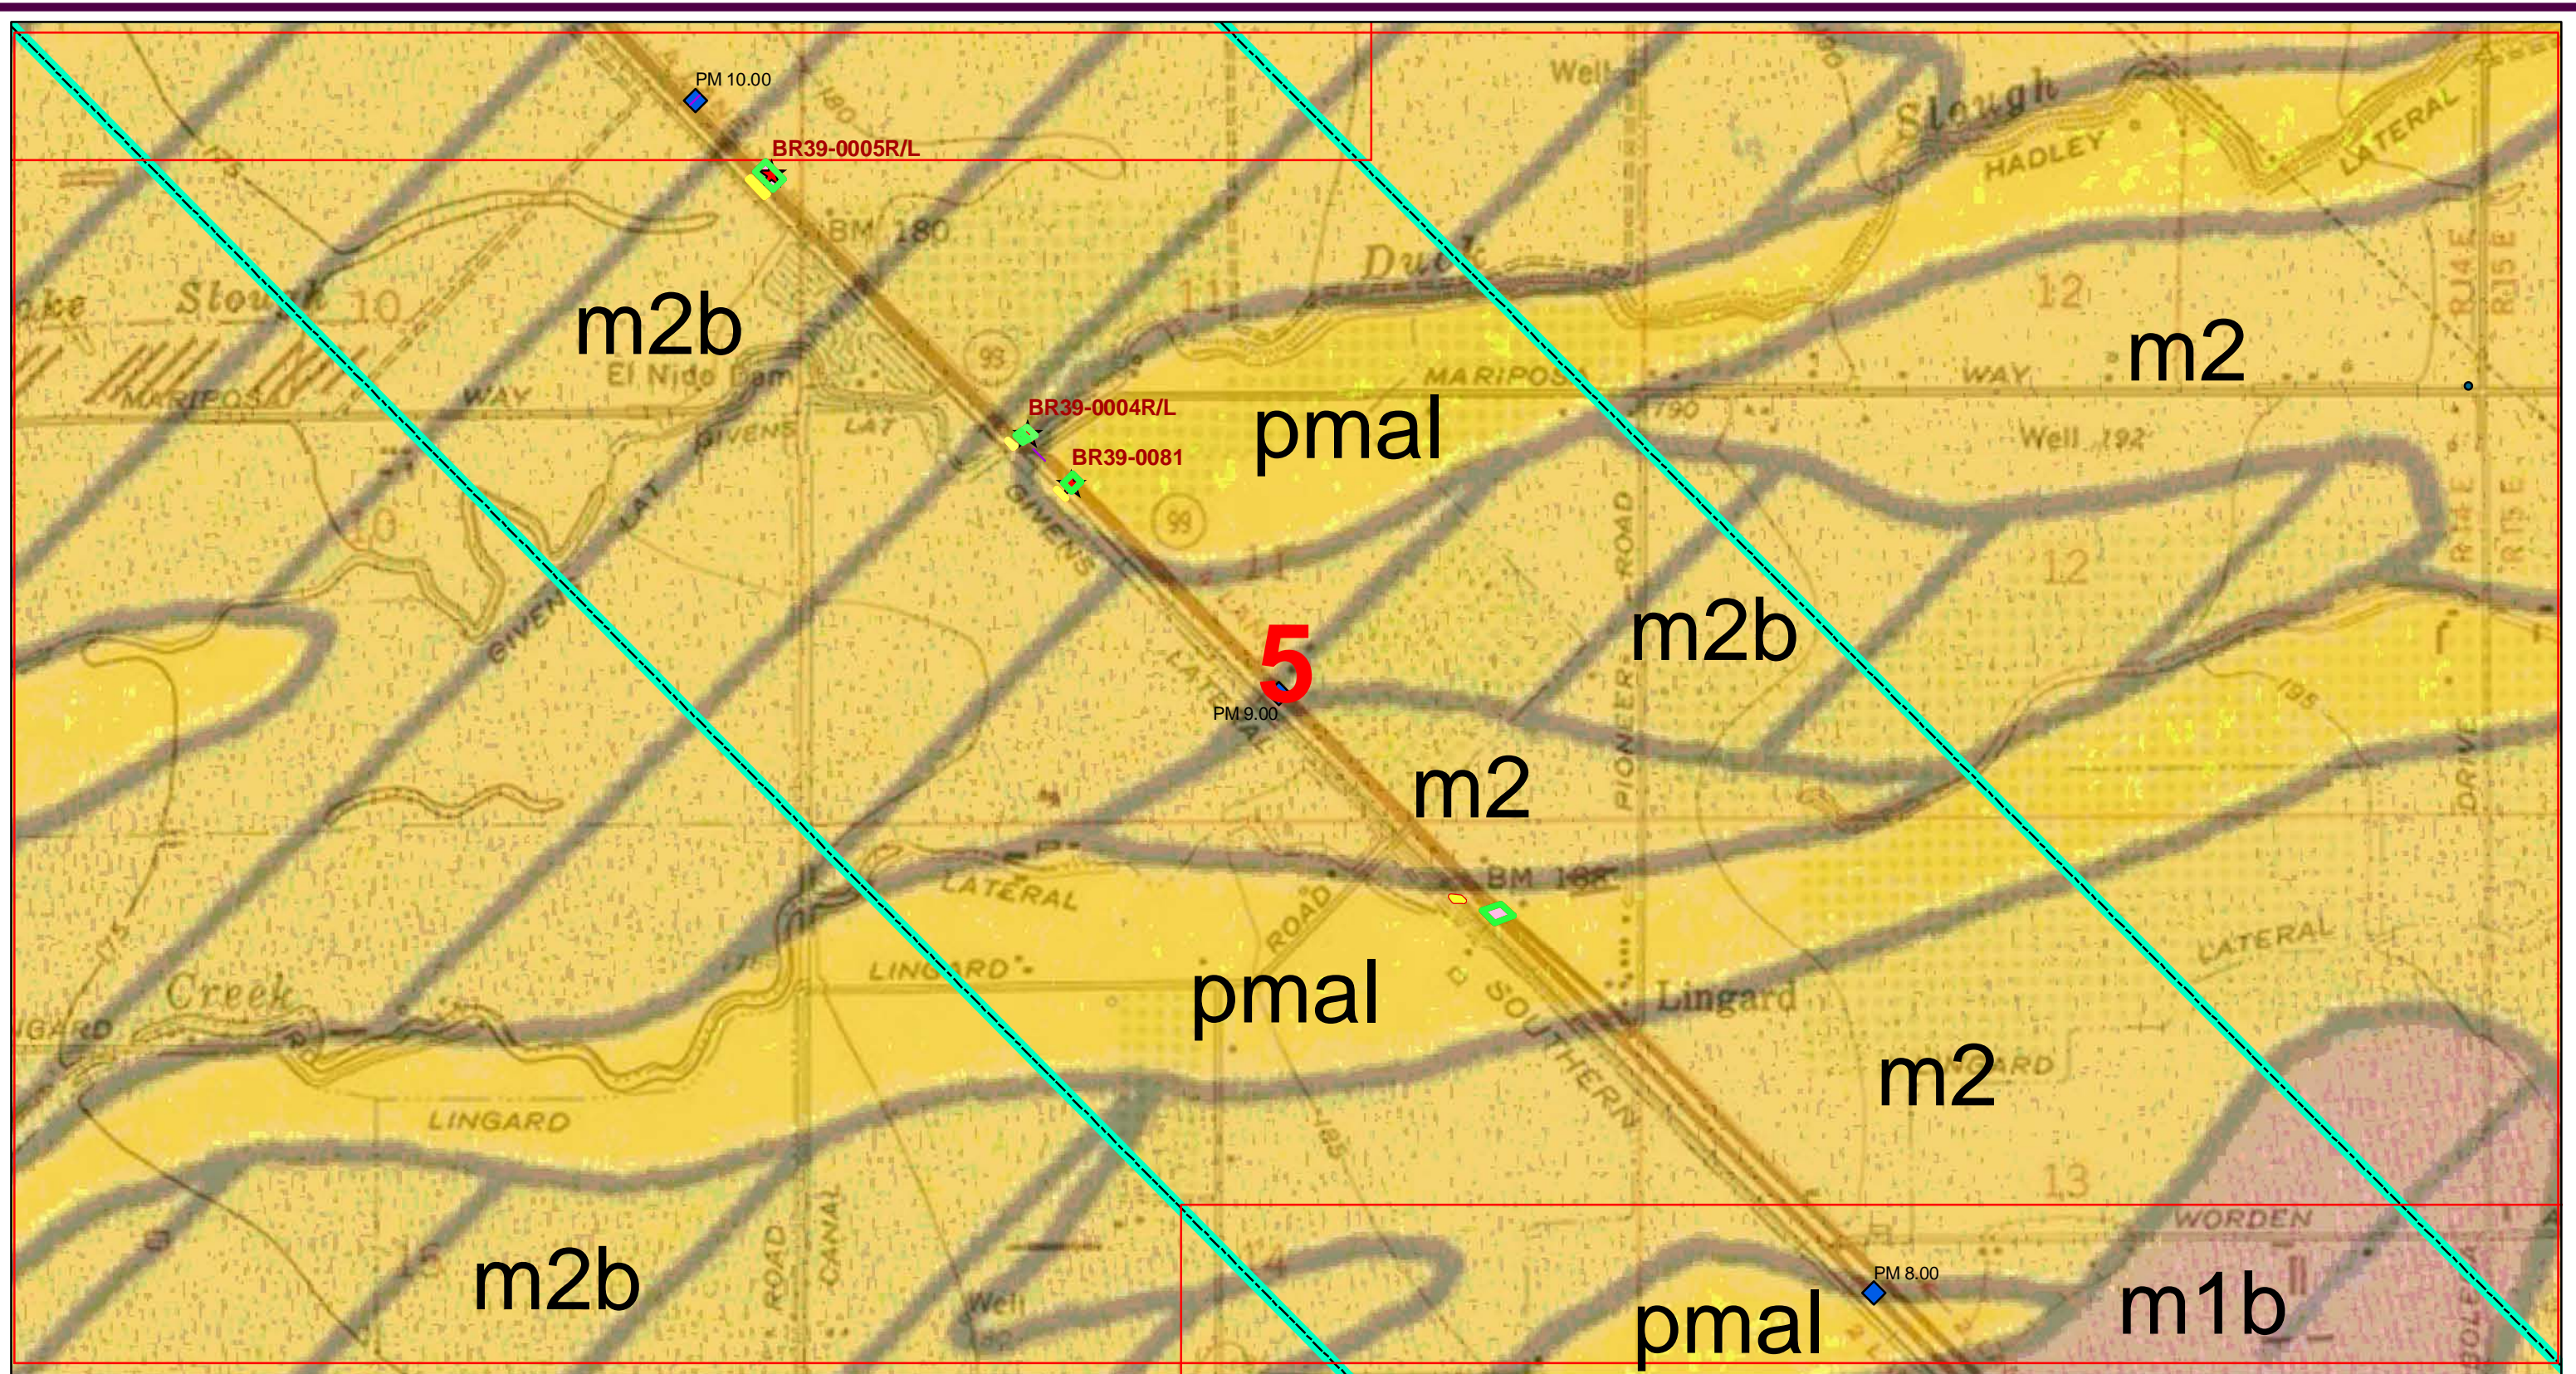

0 500 1,000 1,500 2,000 2,500 3,000  
Feet

See PLATE 2-0 for Legend

Geologic Map and Site Plan



PARIKH CONSULTANTS, INC.  
GEOTECHNICAL CONSULTANTS  
MATERIALS TESTING


SOURCES:  
Geology from Marchand and Allwardt; 1981; USGS Bulletin 1470.  
Caltrans bridges.  
GeoTracker sites.

California High-Speed Train Project  
(Merced - Fresno Section)

JOB NO.: 209138.10

PLATE NO.: 2-5



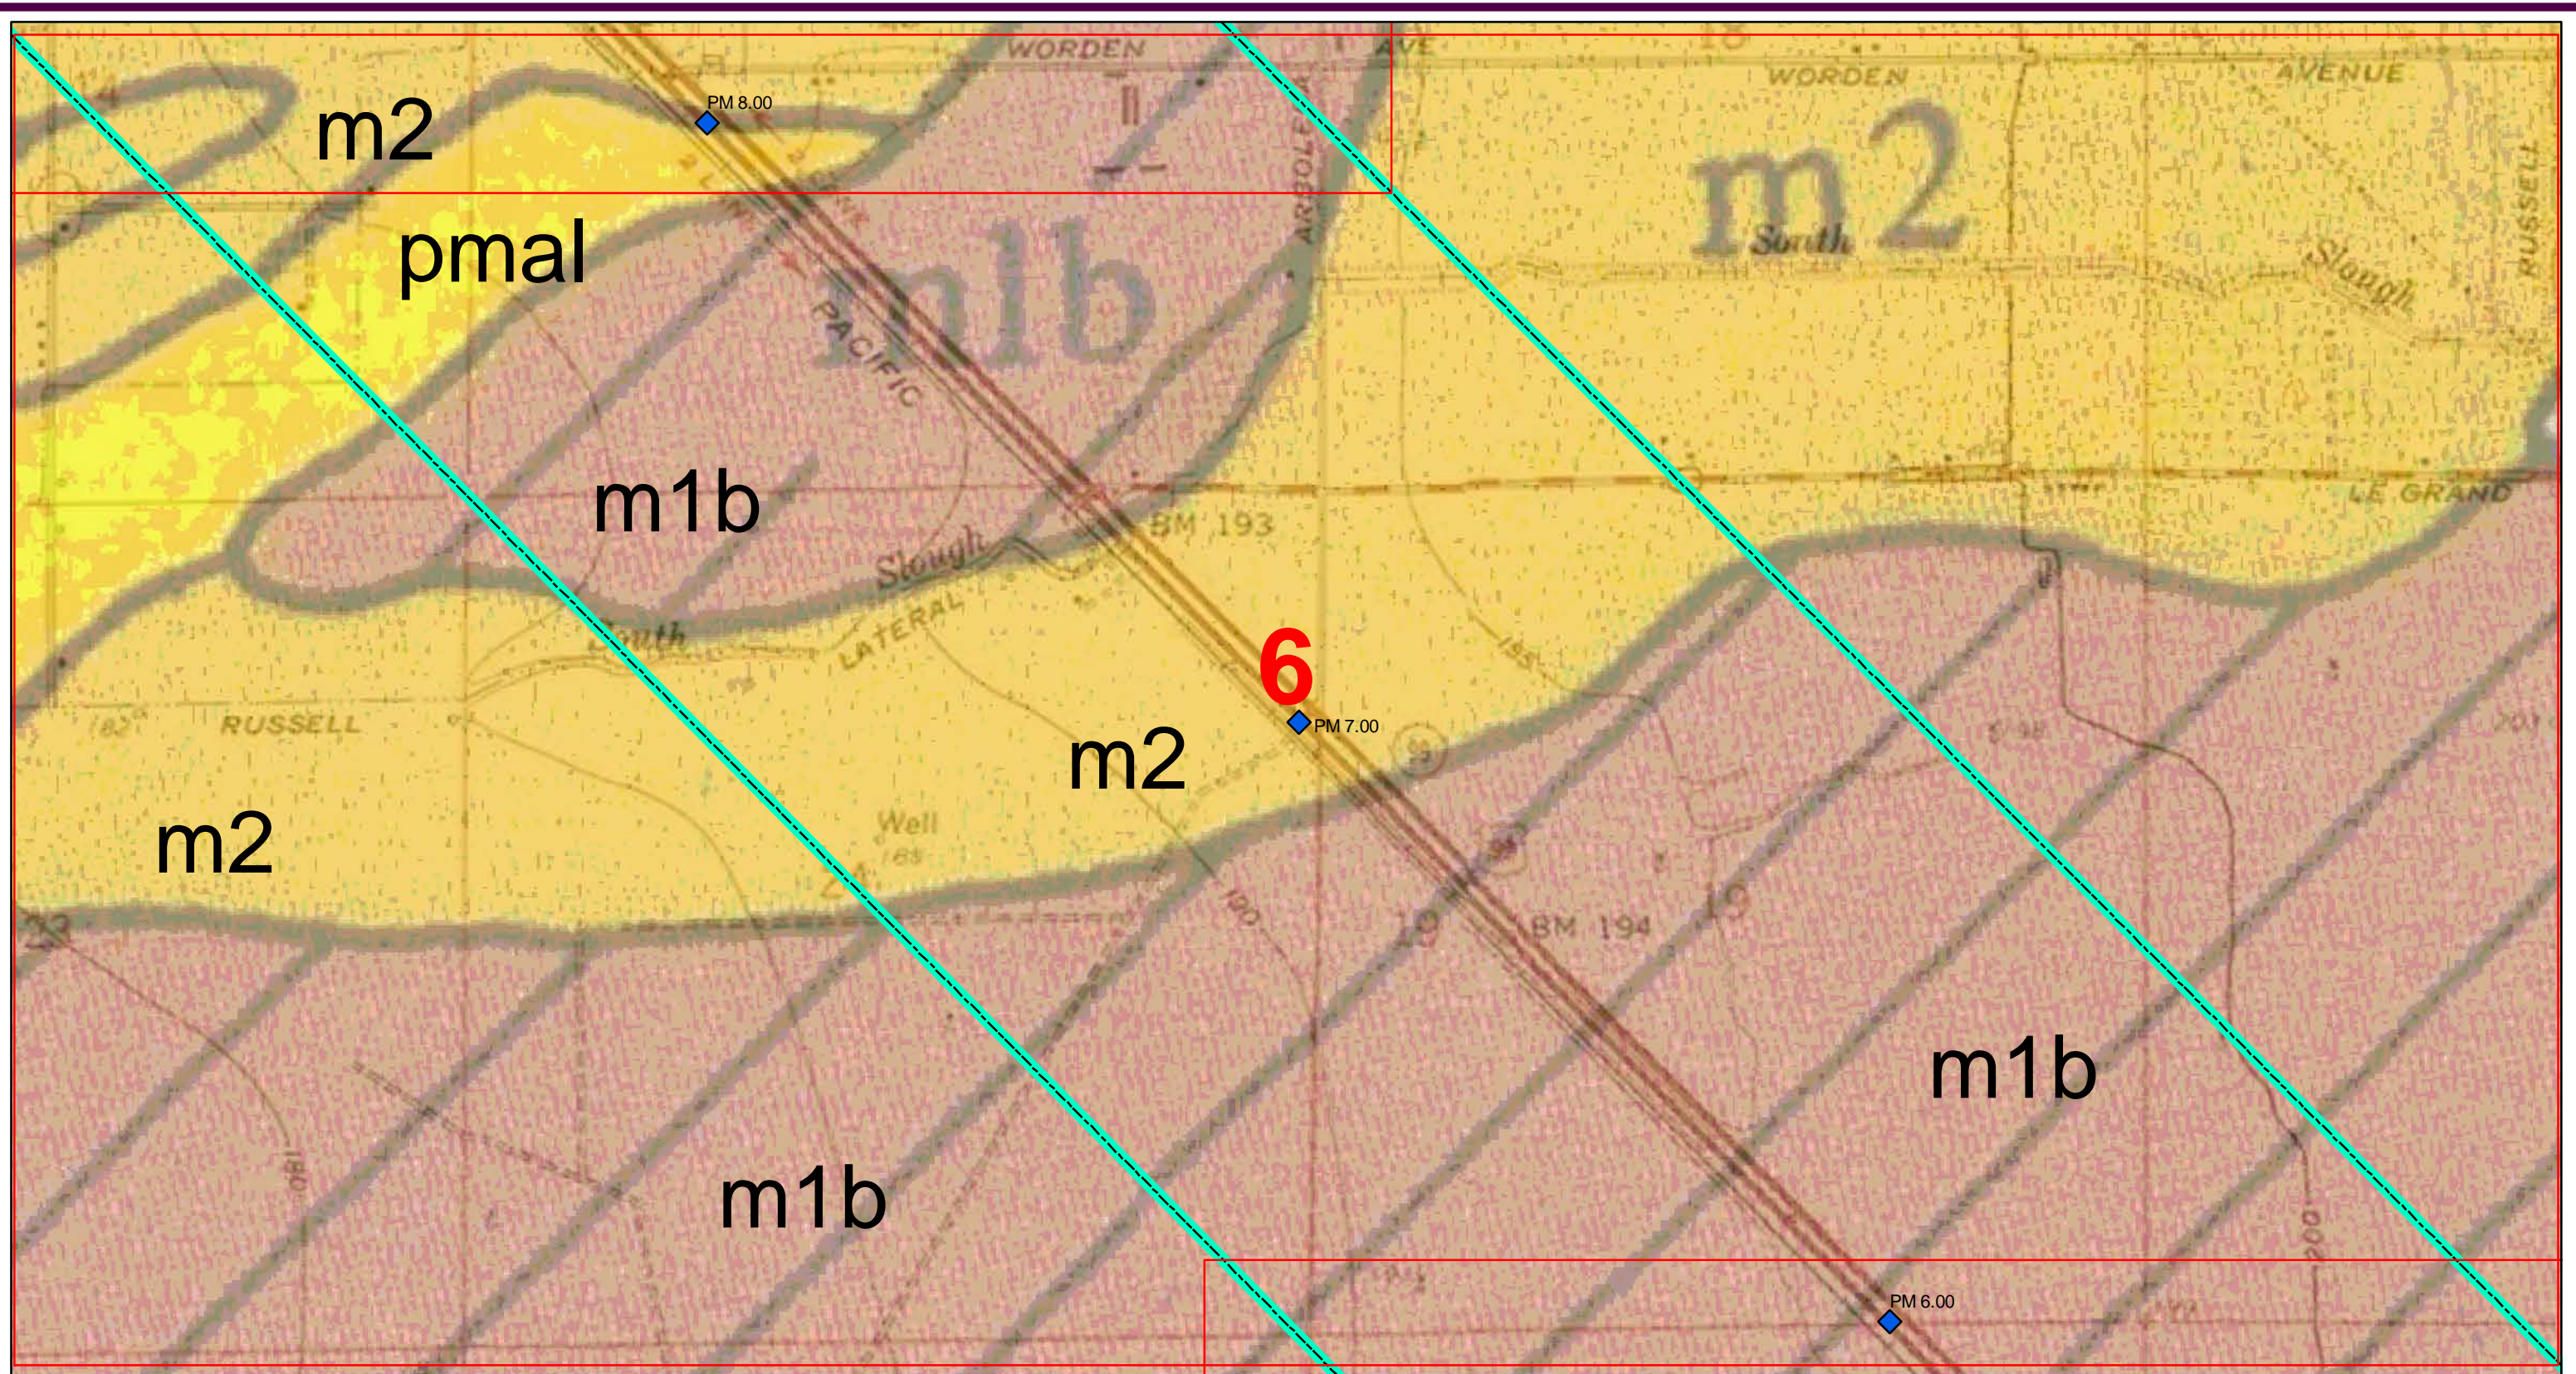

0 500 1,000 1,500 2,000 2,500 3,000  
Feet

See PLATE 2-0 for Legend

Geologic Map and Site Plan



PARIKH CONSULTANTS, INC.  
GEOTECHNICAL CONSULTANTS  
MATERIALS TESTING


SOURCES:  
Geology from Marchand and Allwardt; 1981; USGS Bulletin 1470.  
Caltrans bridges.  
GeoTracker sites.

California High-Speed Train Project  
(Merced - Fresno Section)

JOB NO.: 209138.10

PLATE NO.: 2-6



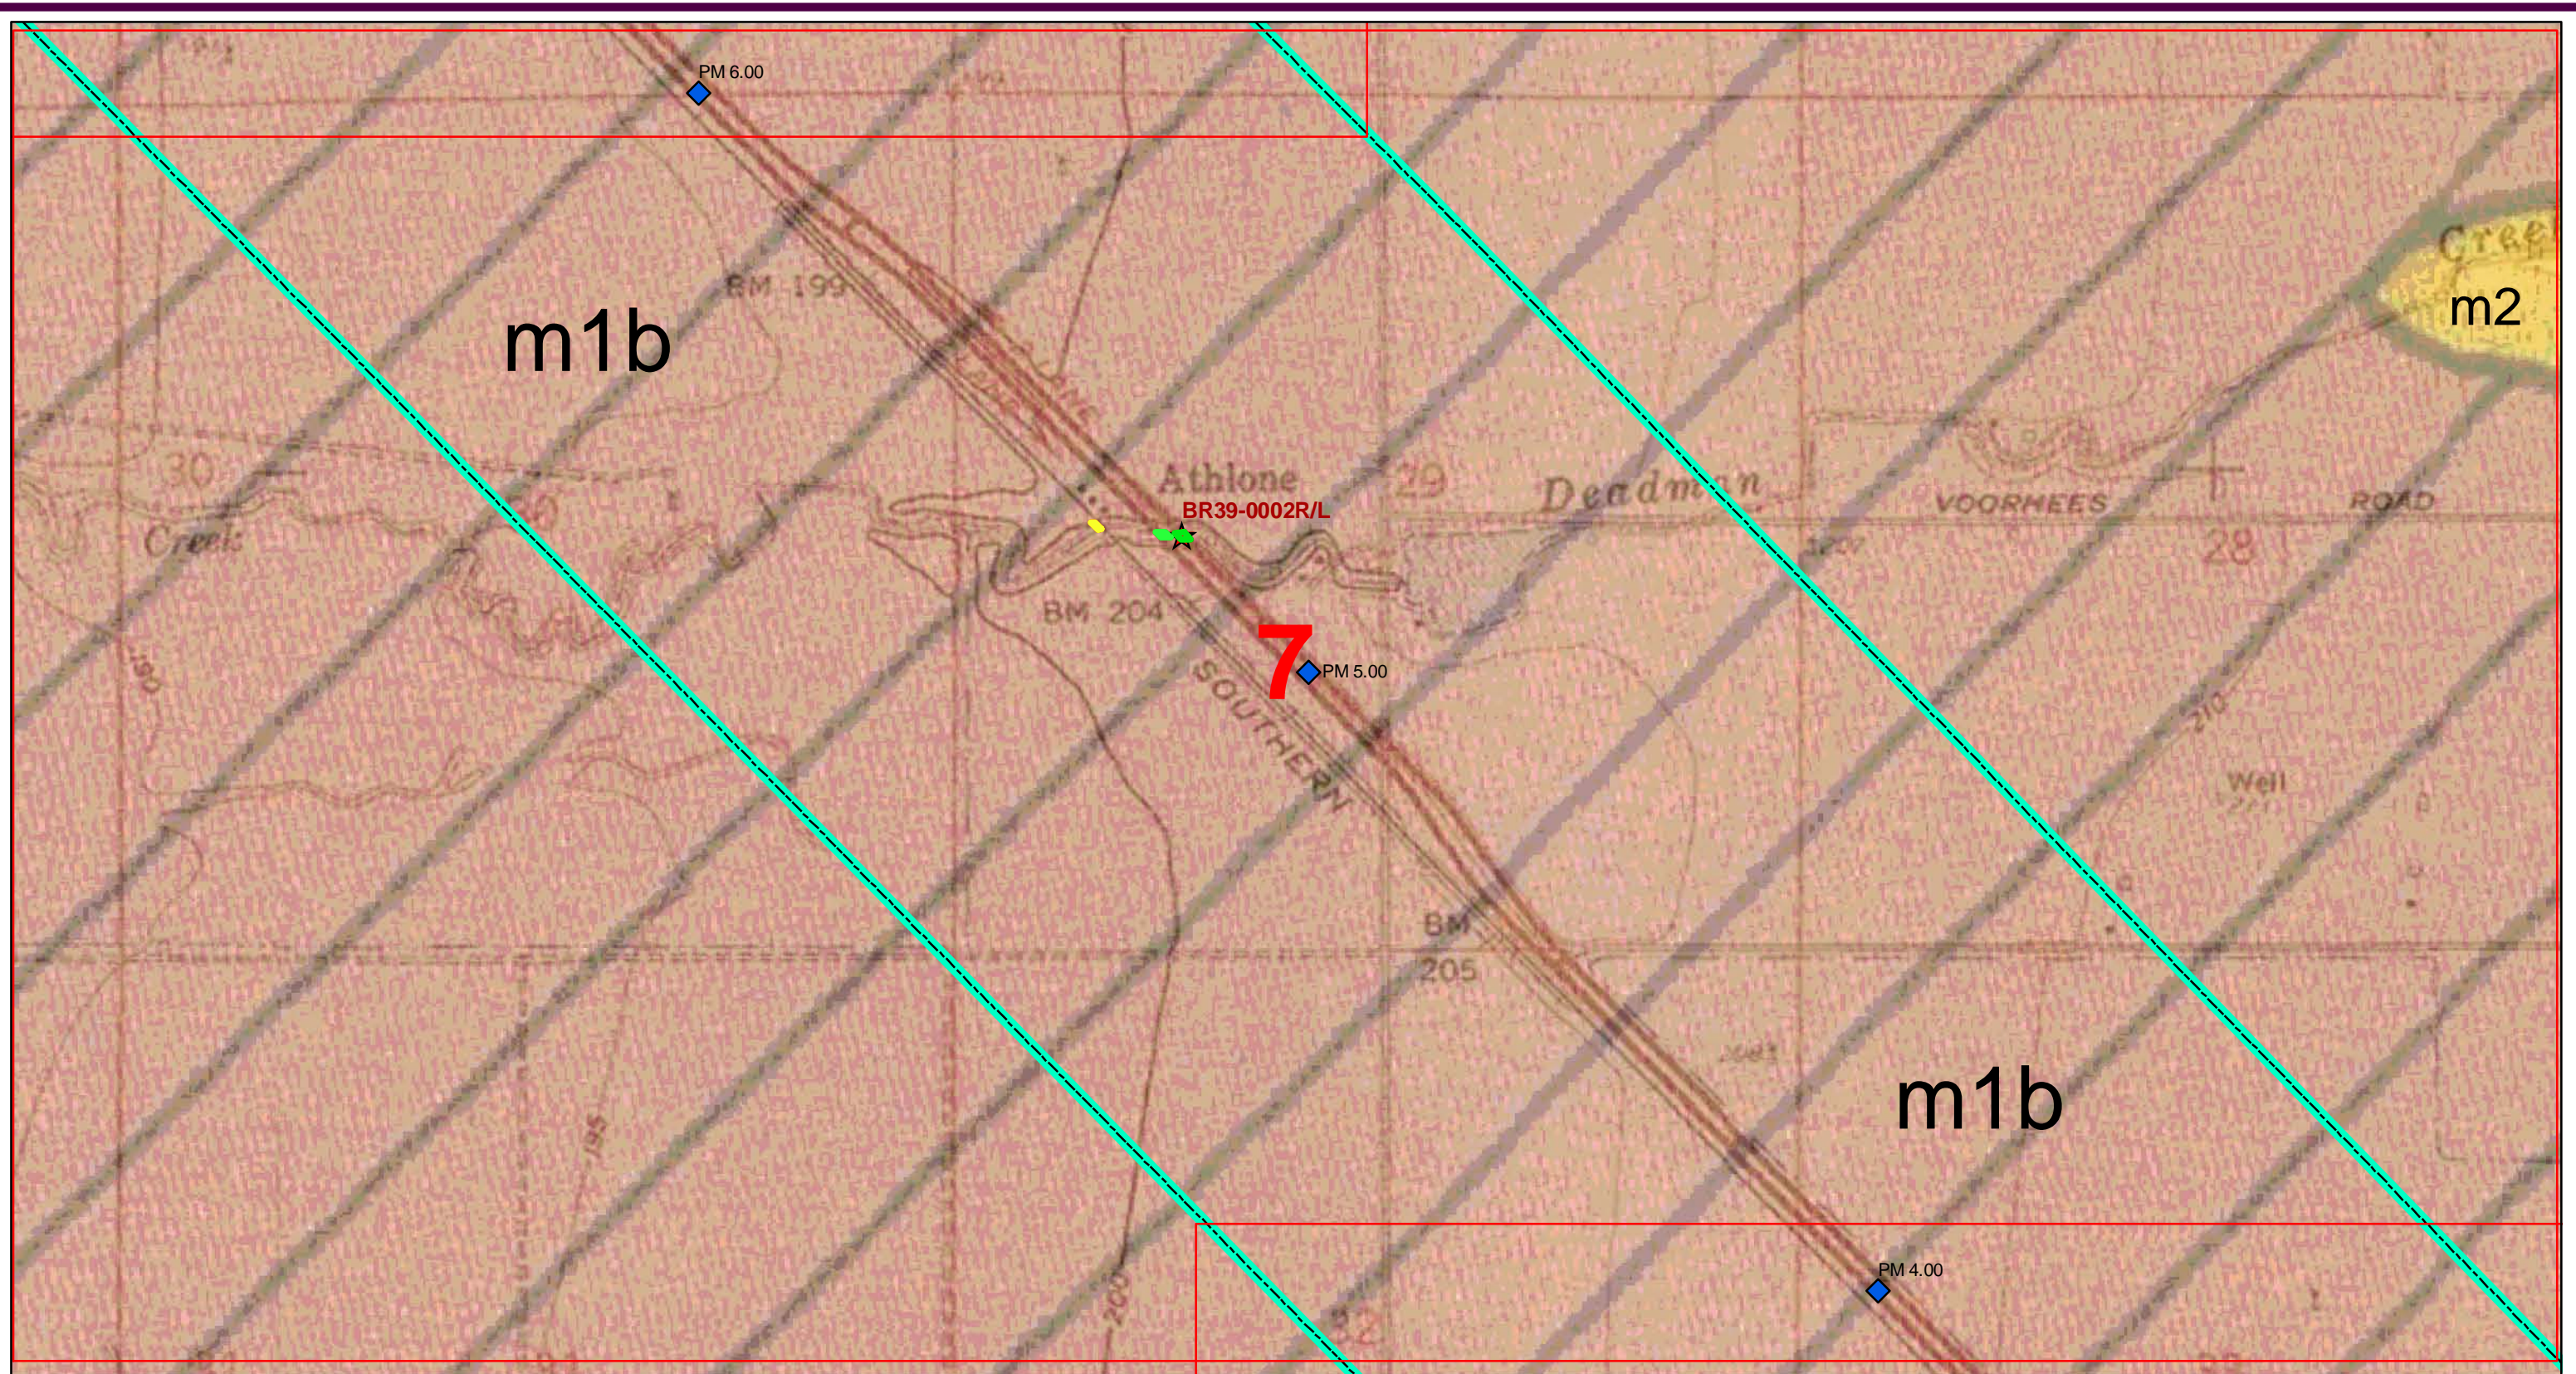

0 500 1,000 1,500 2,000 2,500 3,000  
Feet

See PLATE 2-0 for Legend

Geologic Map and Site Plan



PARIKH CONSULTANTS, INC.  
GEOTECHNICAL CONSULTANTS  
MATERIALS TESTING


SOURCES:  
Geology from Marchand and Allwardt; 1981; USGS Bulletin 1470.  
Caltrans bridges.  
GeoTracker sites.

California High-Speed Train Project  
(Merced - Fresno Section)

JOB NO.: 209138.10

PLATE NO.: 2-7



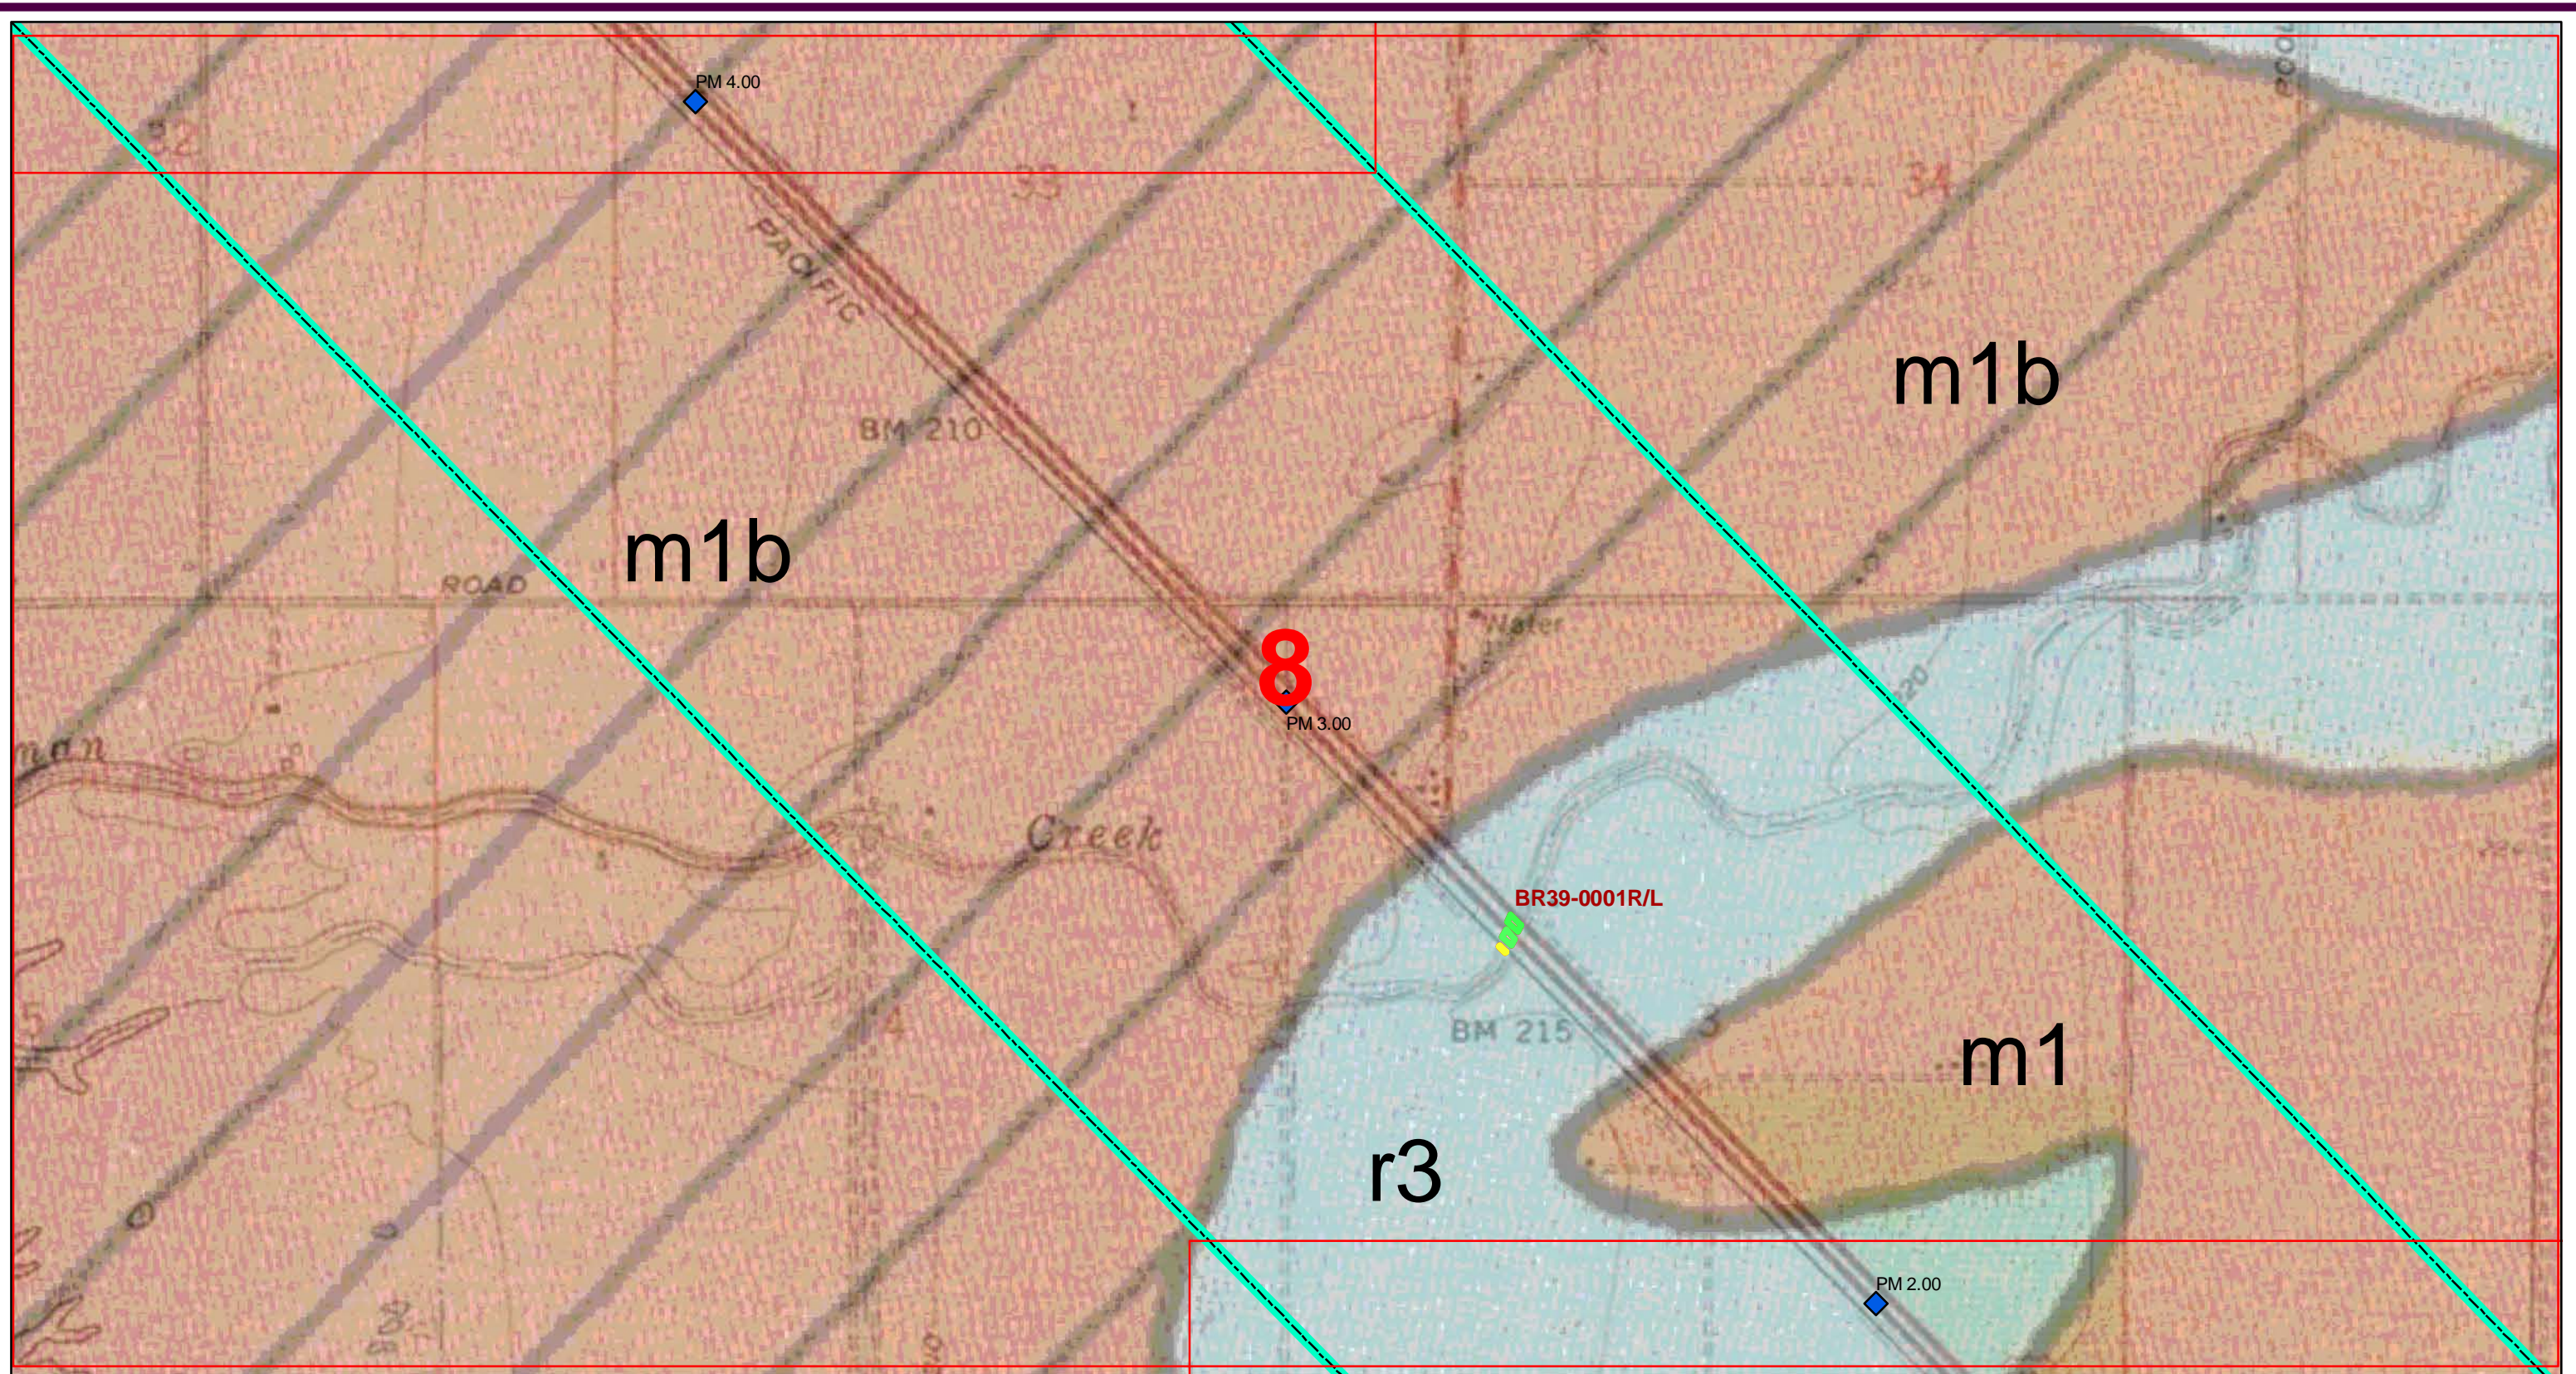

0 500 1,000 1,500 2,000 2,500 3,000  
Feet

See PLATE 2-0 for Legend

Geologic Map and Site Plan



PARIKH CONSULTANTS, INC.  
GEOTECHNICAL CONSULTANTS  
MATERIALS TESTING


SOURCES:  
Geology from Marchand and Allwardt; 1981; USGS Bulletin 1470.  
Caltrans bridges.  
GeoTracker sites.

California High-Speed Train Project  
(Merced - Fresno Section)

JOB NO.: 209138.10

PLATE NO.: 2-8



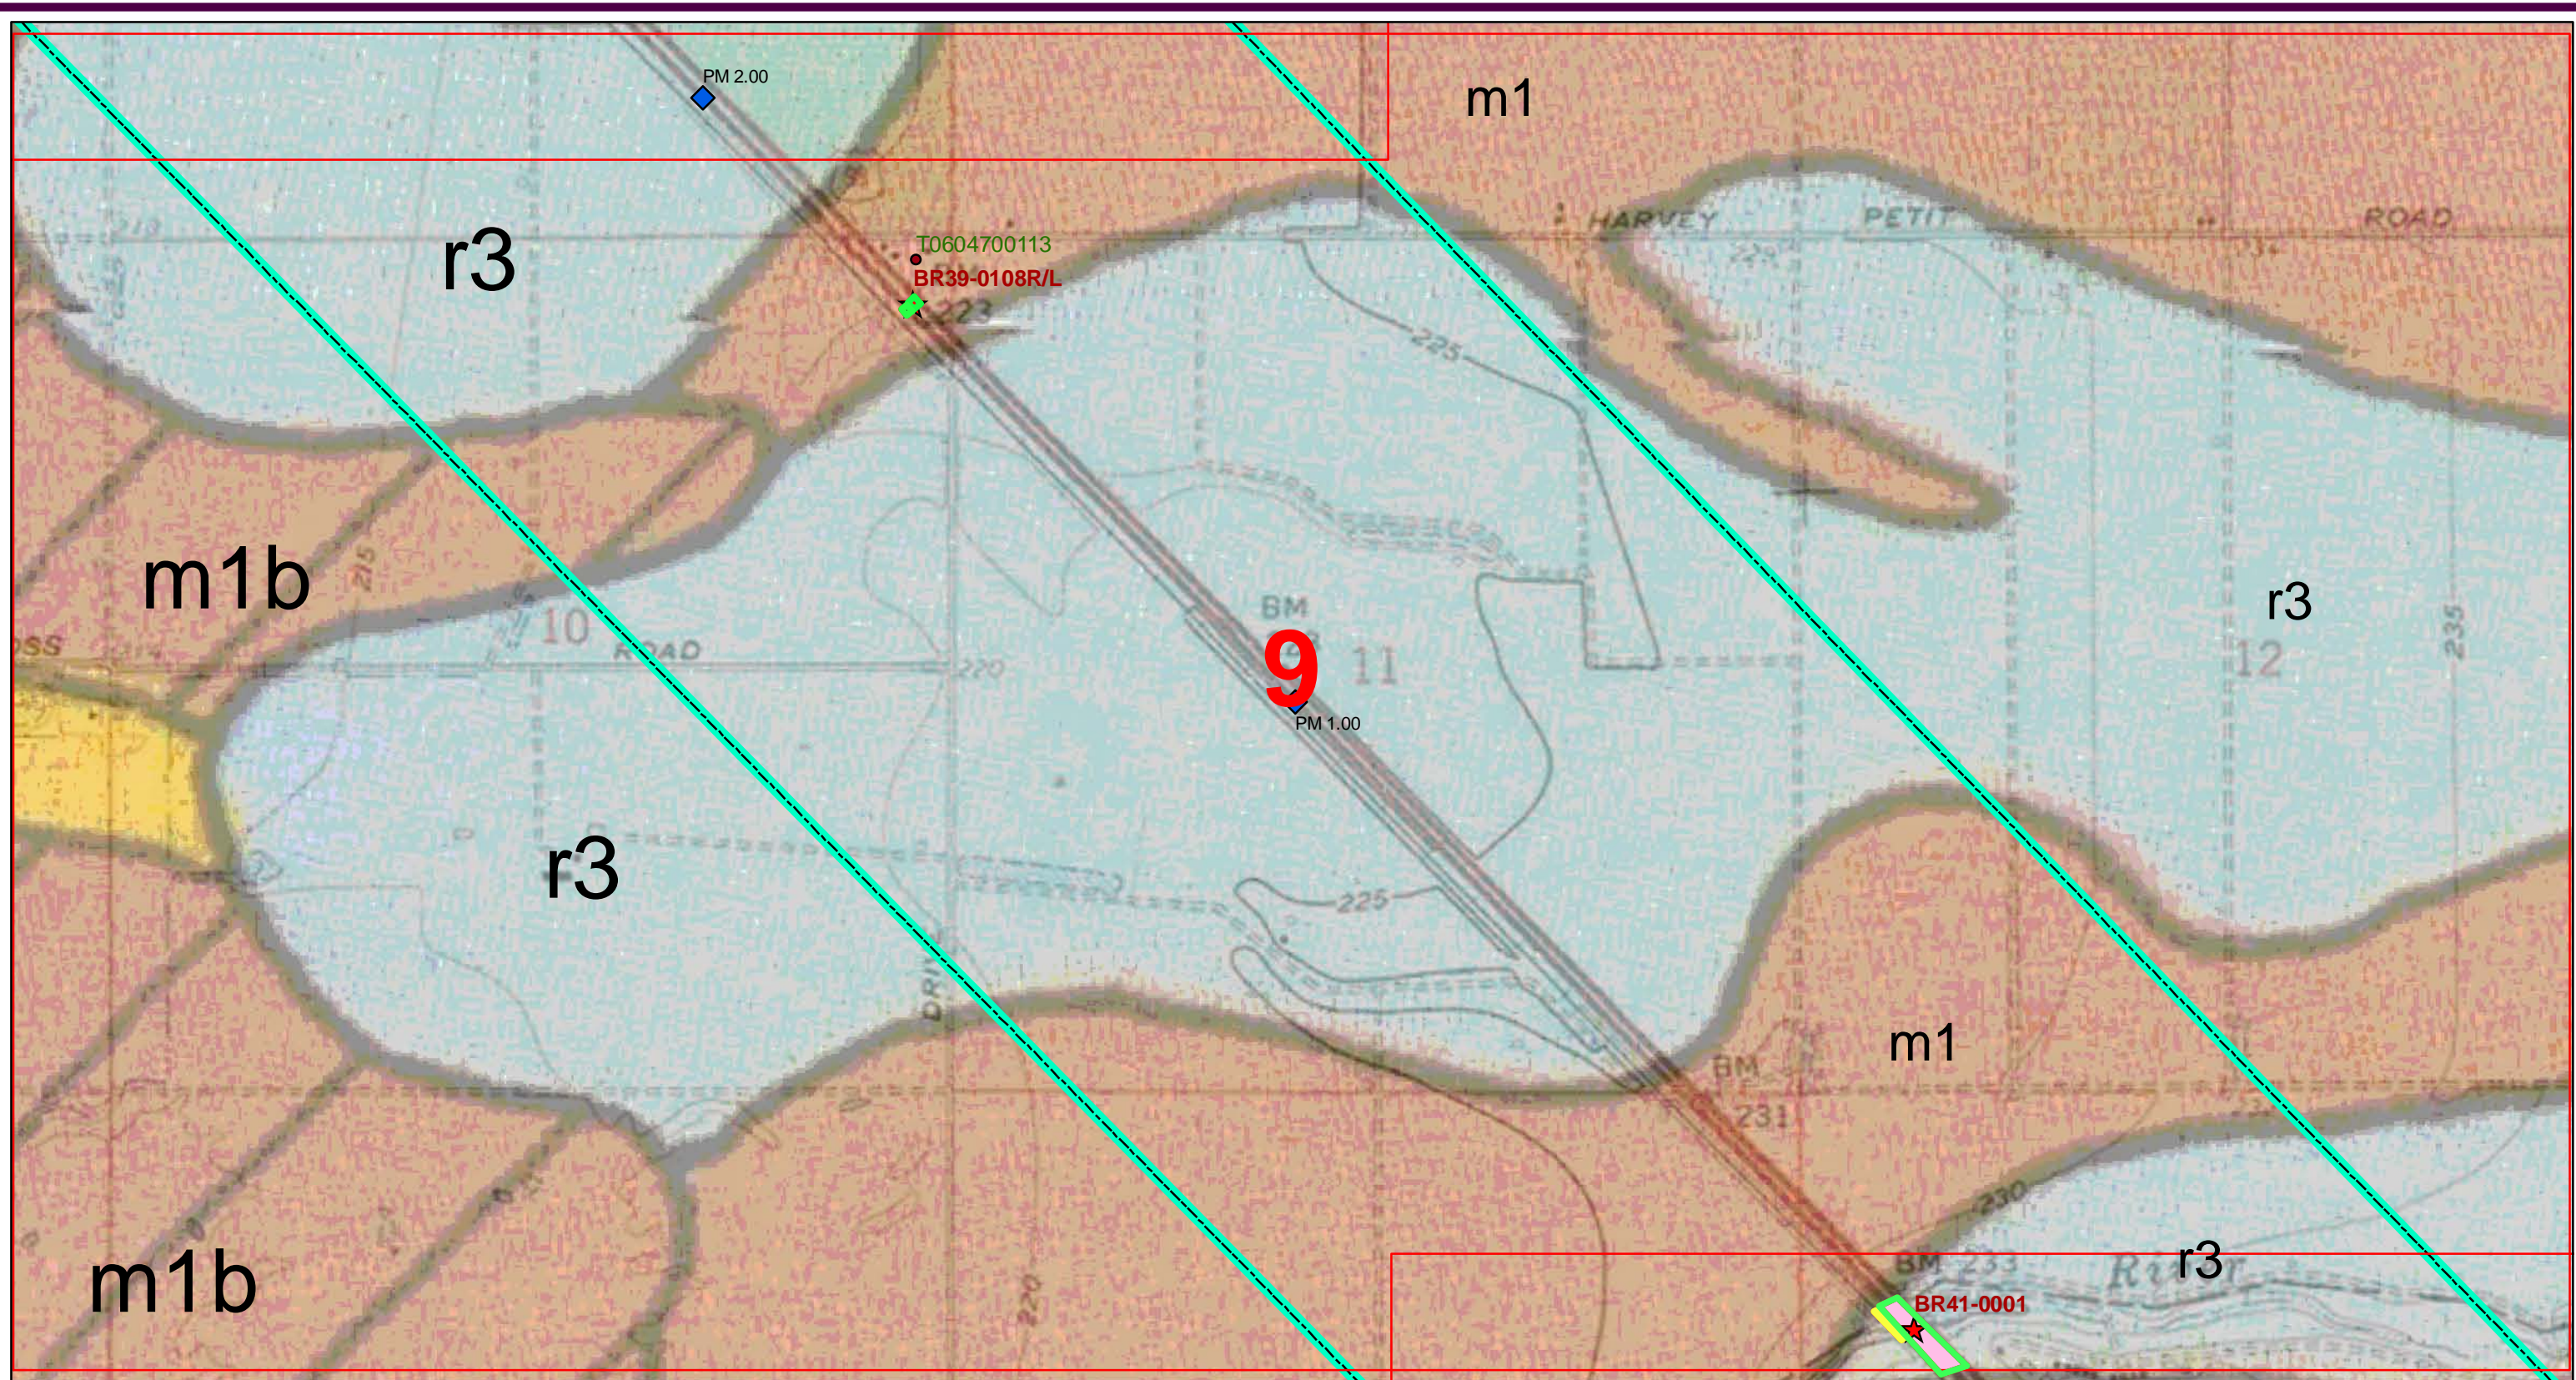

0 500 1,000 1,500 2,000 2,500 3,000  
Feet

See PLATE 2-0 for Legend

Geologic Map and Site Plan



PARIKH CONSULTANTS, INC.  
GEOTECHNICAL CONSULTANTS  
MATERIALS TESTING


SOURCES:  
Geology from Marchand and Allwardt; 1981; USGS Bulletin 1470.  
Caltrans bridges.  
GeoTracker sites.

California High-Speed Train Project  
(Merced - Fresno Section)

JOB NO.: 209138.10

PLATE NO.: 2-9



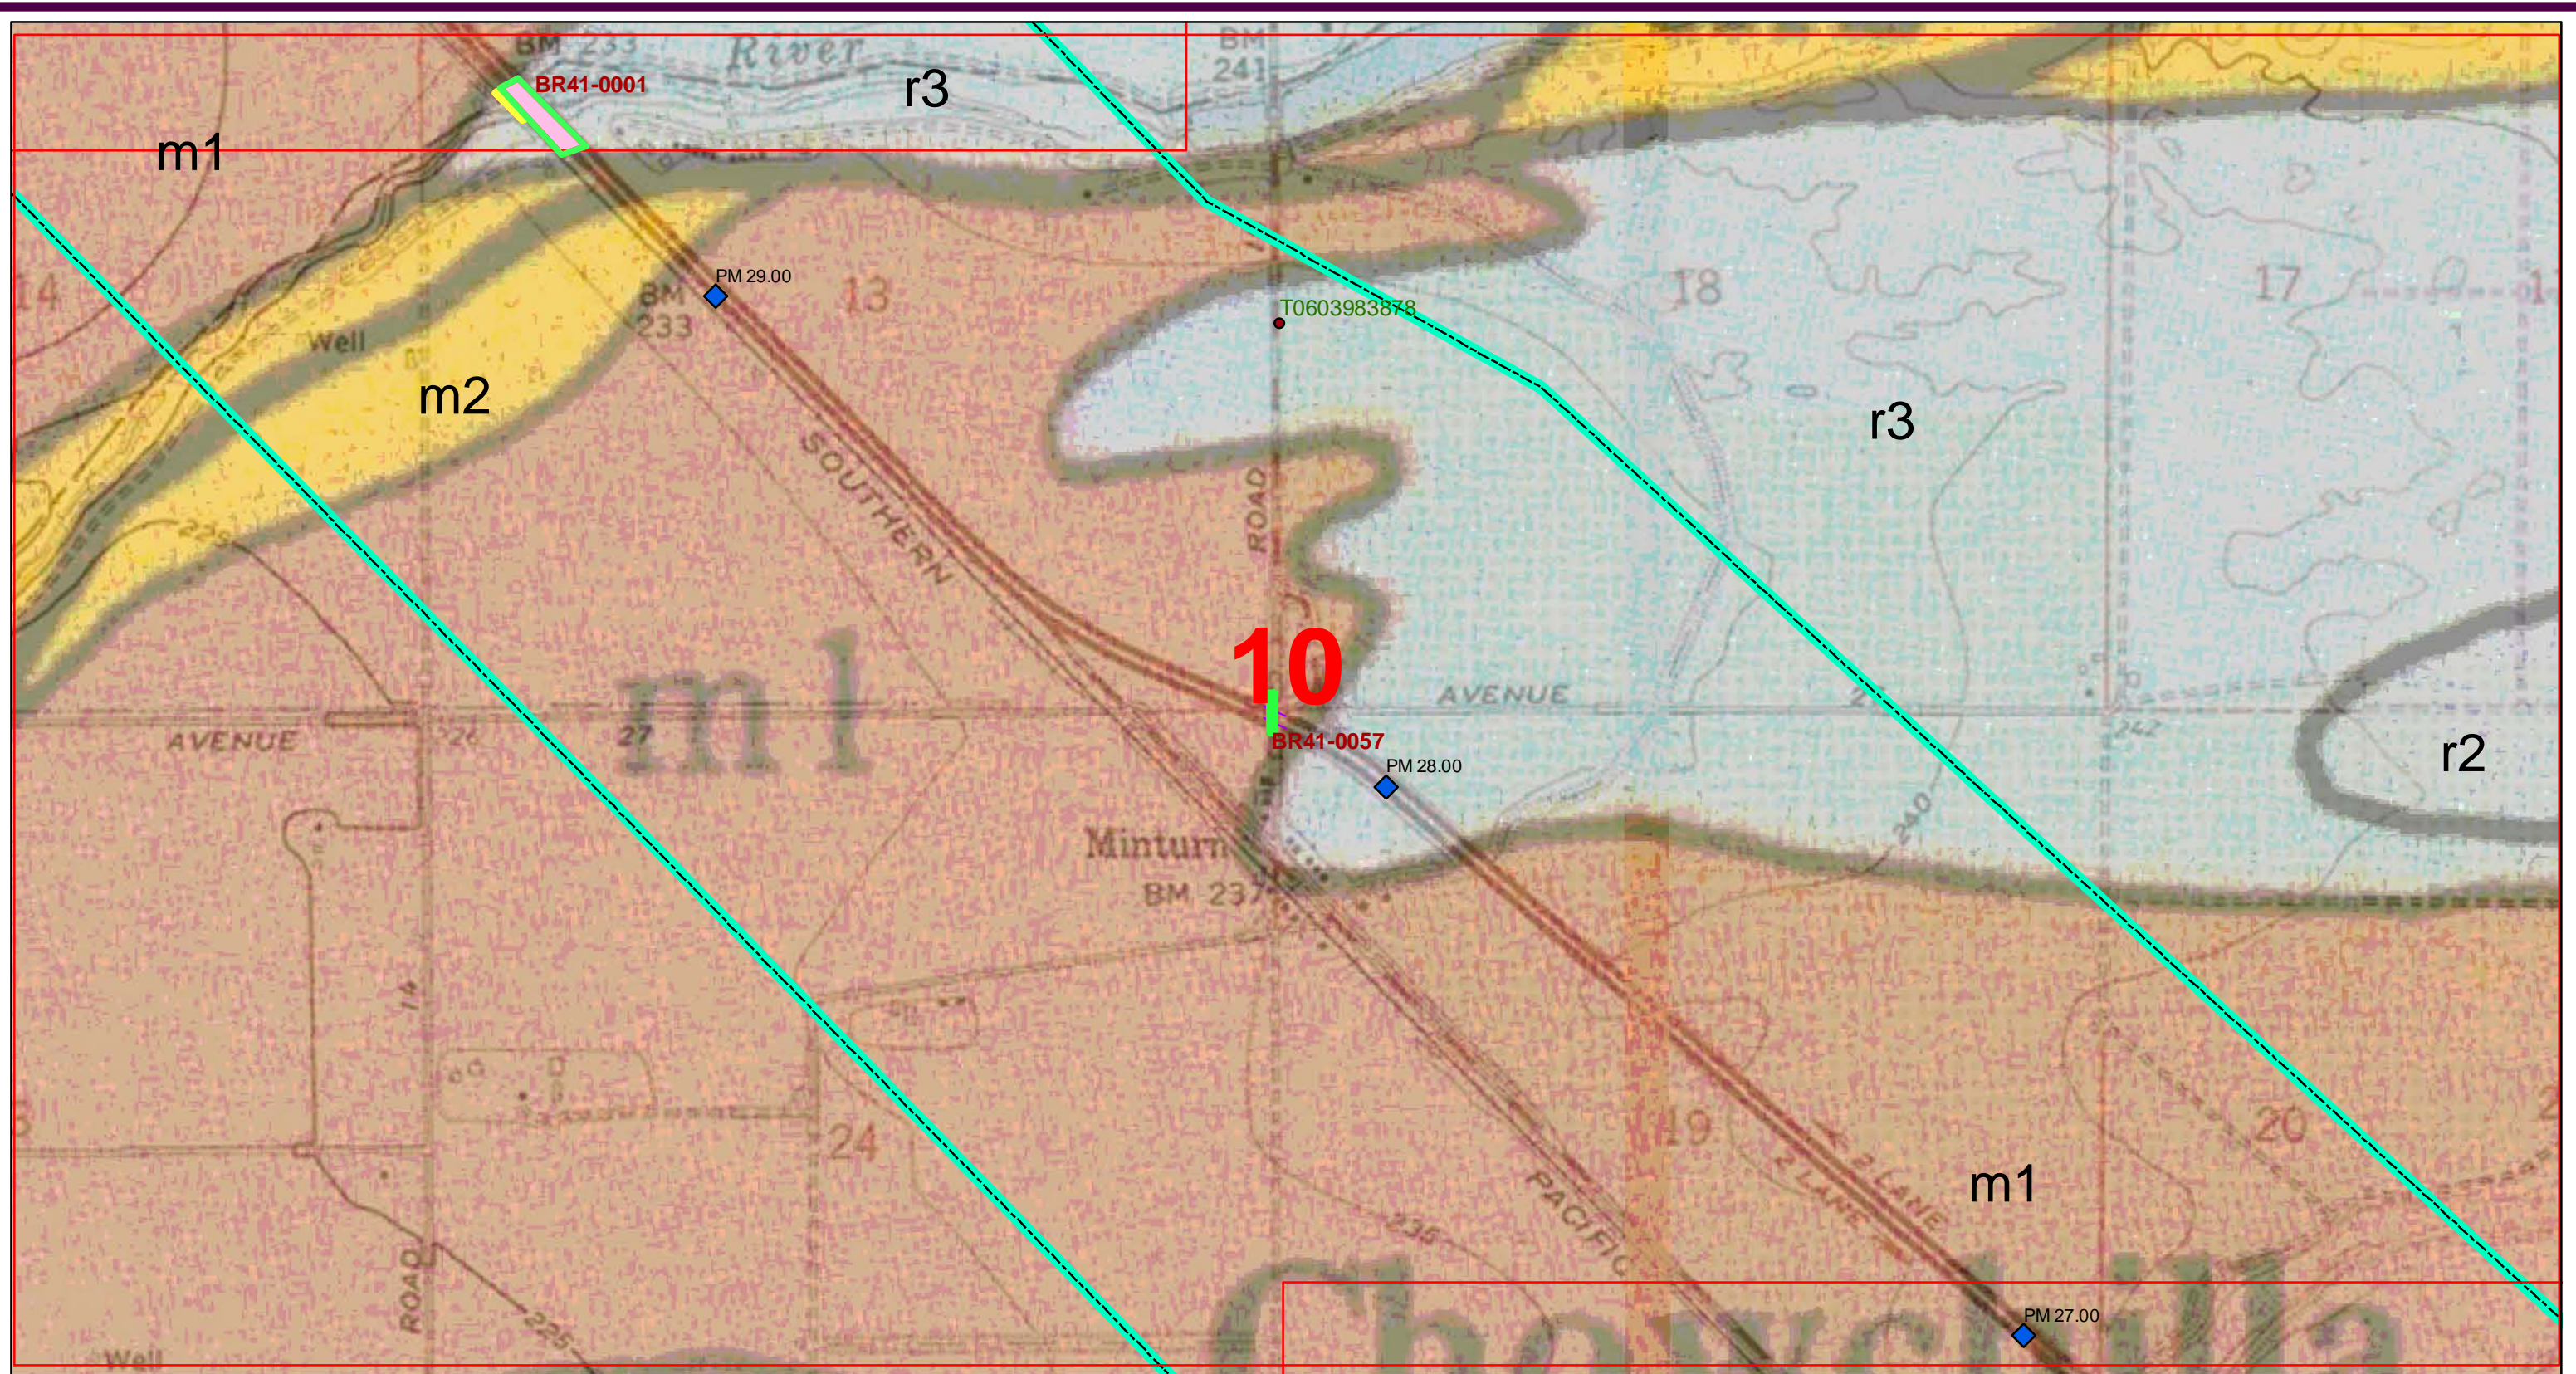

0 500 1,000 1,500 2,000 2,500 3,000  
Feet

See PLATE 2-0 for Legend

Geologic Map and Site Plan



PARIKH CONSULTANTS, INC.  
GEOTECHNICAL CONSULTANTS  
MATERIALS TESTING


SOURCES:  
Geology from Marchand and Allwardt; 1981; USGS Bulletin 1470.  
Caltrans bridges.  
GeoTracker sites

California High-Speed Train Project  
(Merced - Fresno Section)

JOB NO.: 209138.10

PLATE NO.: 2-10



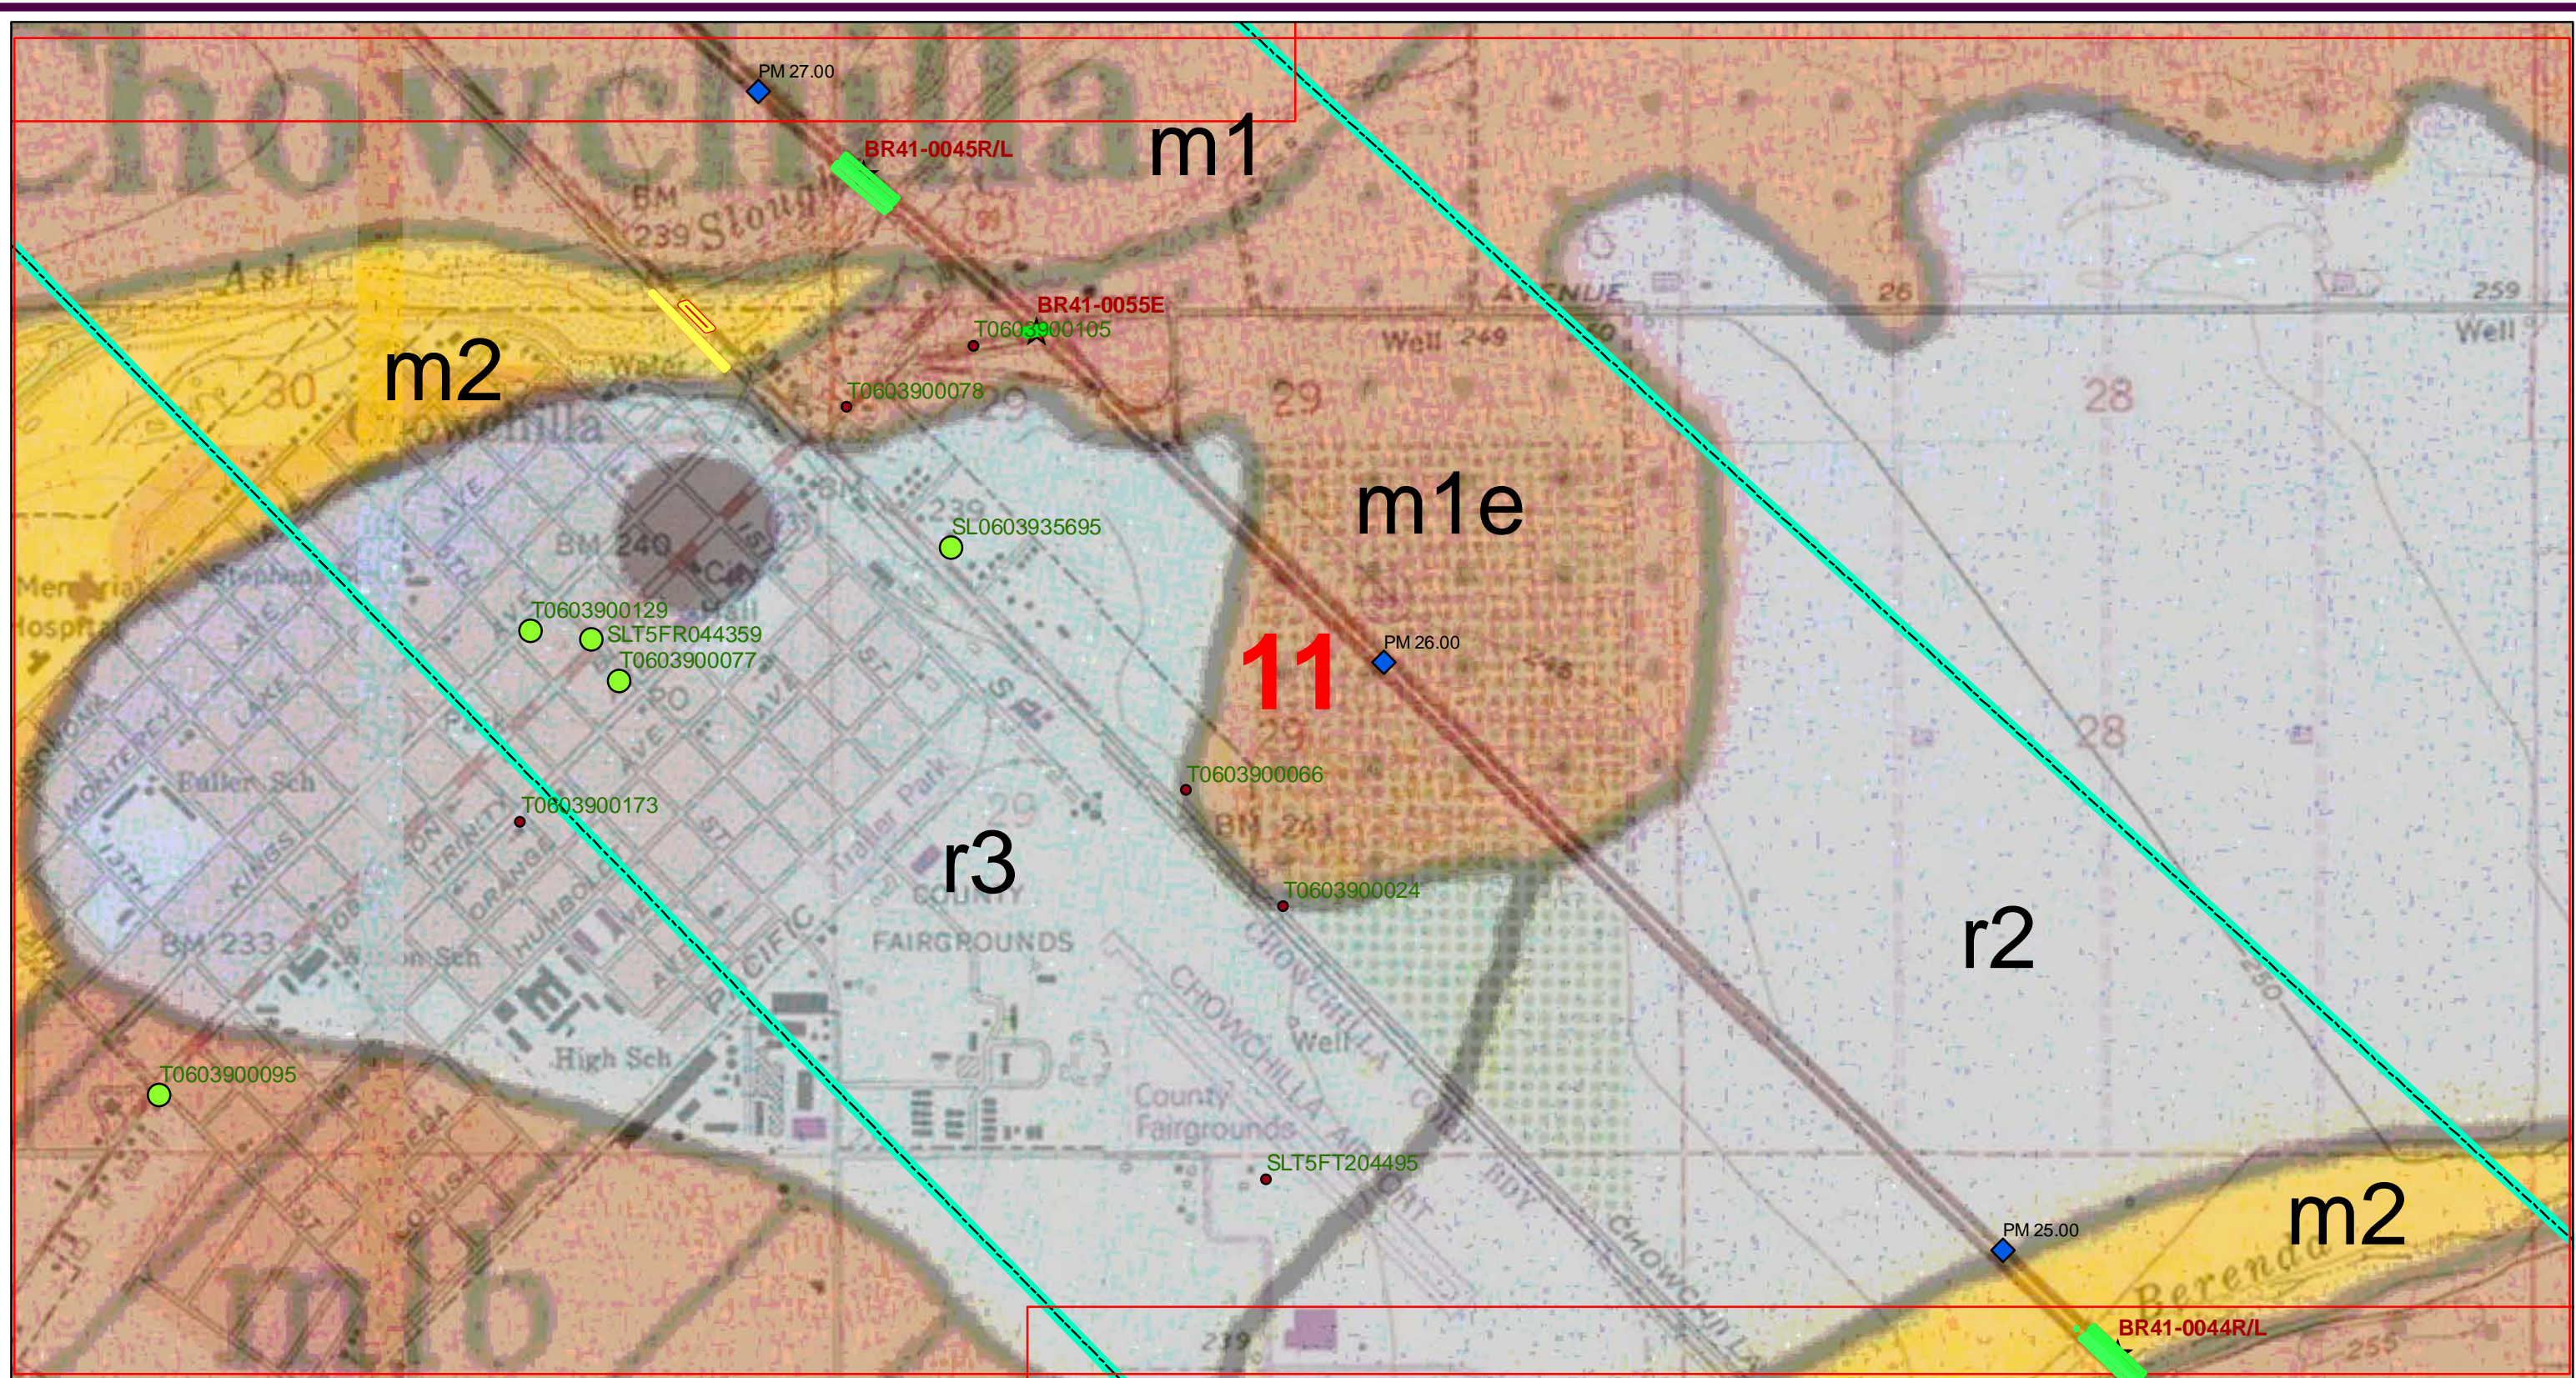

0 500 1,000 1,500 2,000 2,500 3,000  
Feet

See PLATE 2-0 for Legend

Geologic Map and Site Plan



PARIKH CONSULTANTS, INC.  
GEOTECHNICAL CONSULTANTS  
MATERIALS TESTING

SOURCES:  
Geology from Marchand and Allwardt; 1981; USGS Bulletin 1470.  
Caltrans bridges.  
GeoTracker sites.

California High-Speed Train Project  
(Merced - Fresno Section)


JOB NO.: 209138.10

PLATE NO.: 2-11







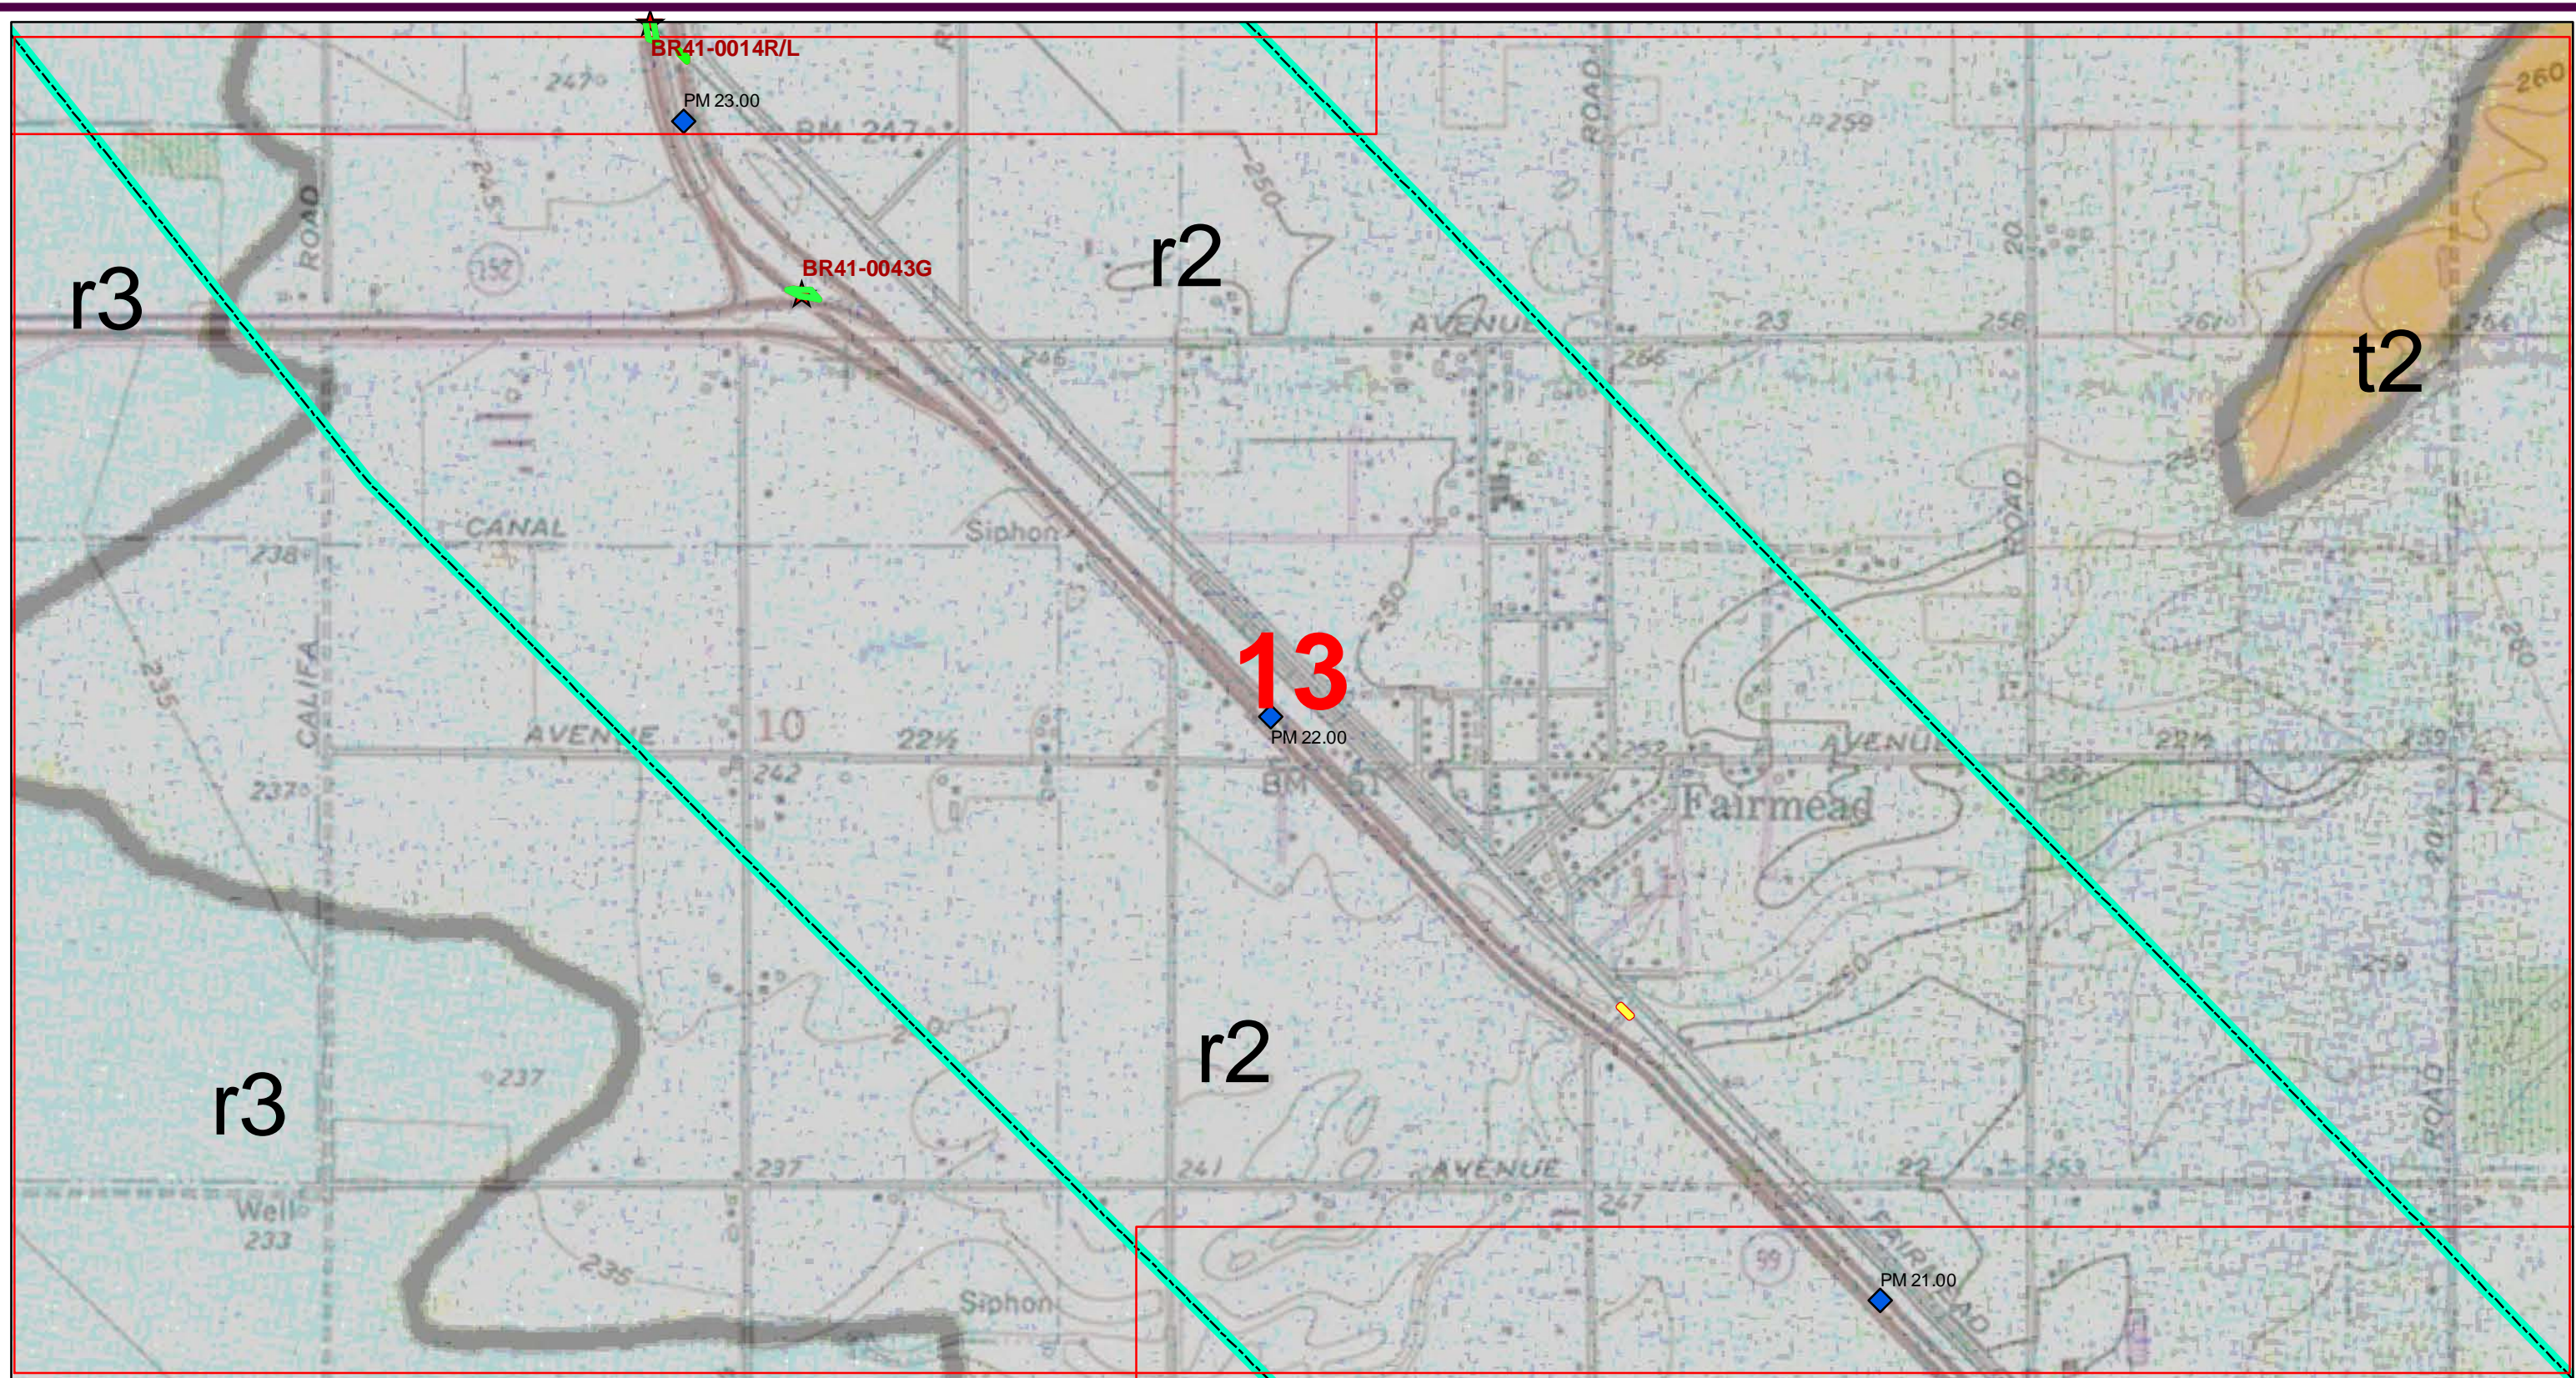

0 500 1,000 1,500 2,000 2,500 3,000  
Feet

See PLATE 2-0 for Legend

Geologic Map and Site Plan



PARIKH CONSULTANTS, INC.  
GEOTECHNICAL CONSULTANTS  
MATERIALS TESTING


SOURCES:  
Geology from Marchand and Allwardt; 1981; USGS Bulletin 1470.  
Caltrans bridges.  
GeoTracker sites.

California High-Speed Train Project  
(Merced - Fresno Section)

JOB NO.: 209138.10

PLATE NO.: 2-13



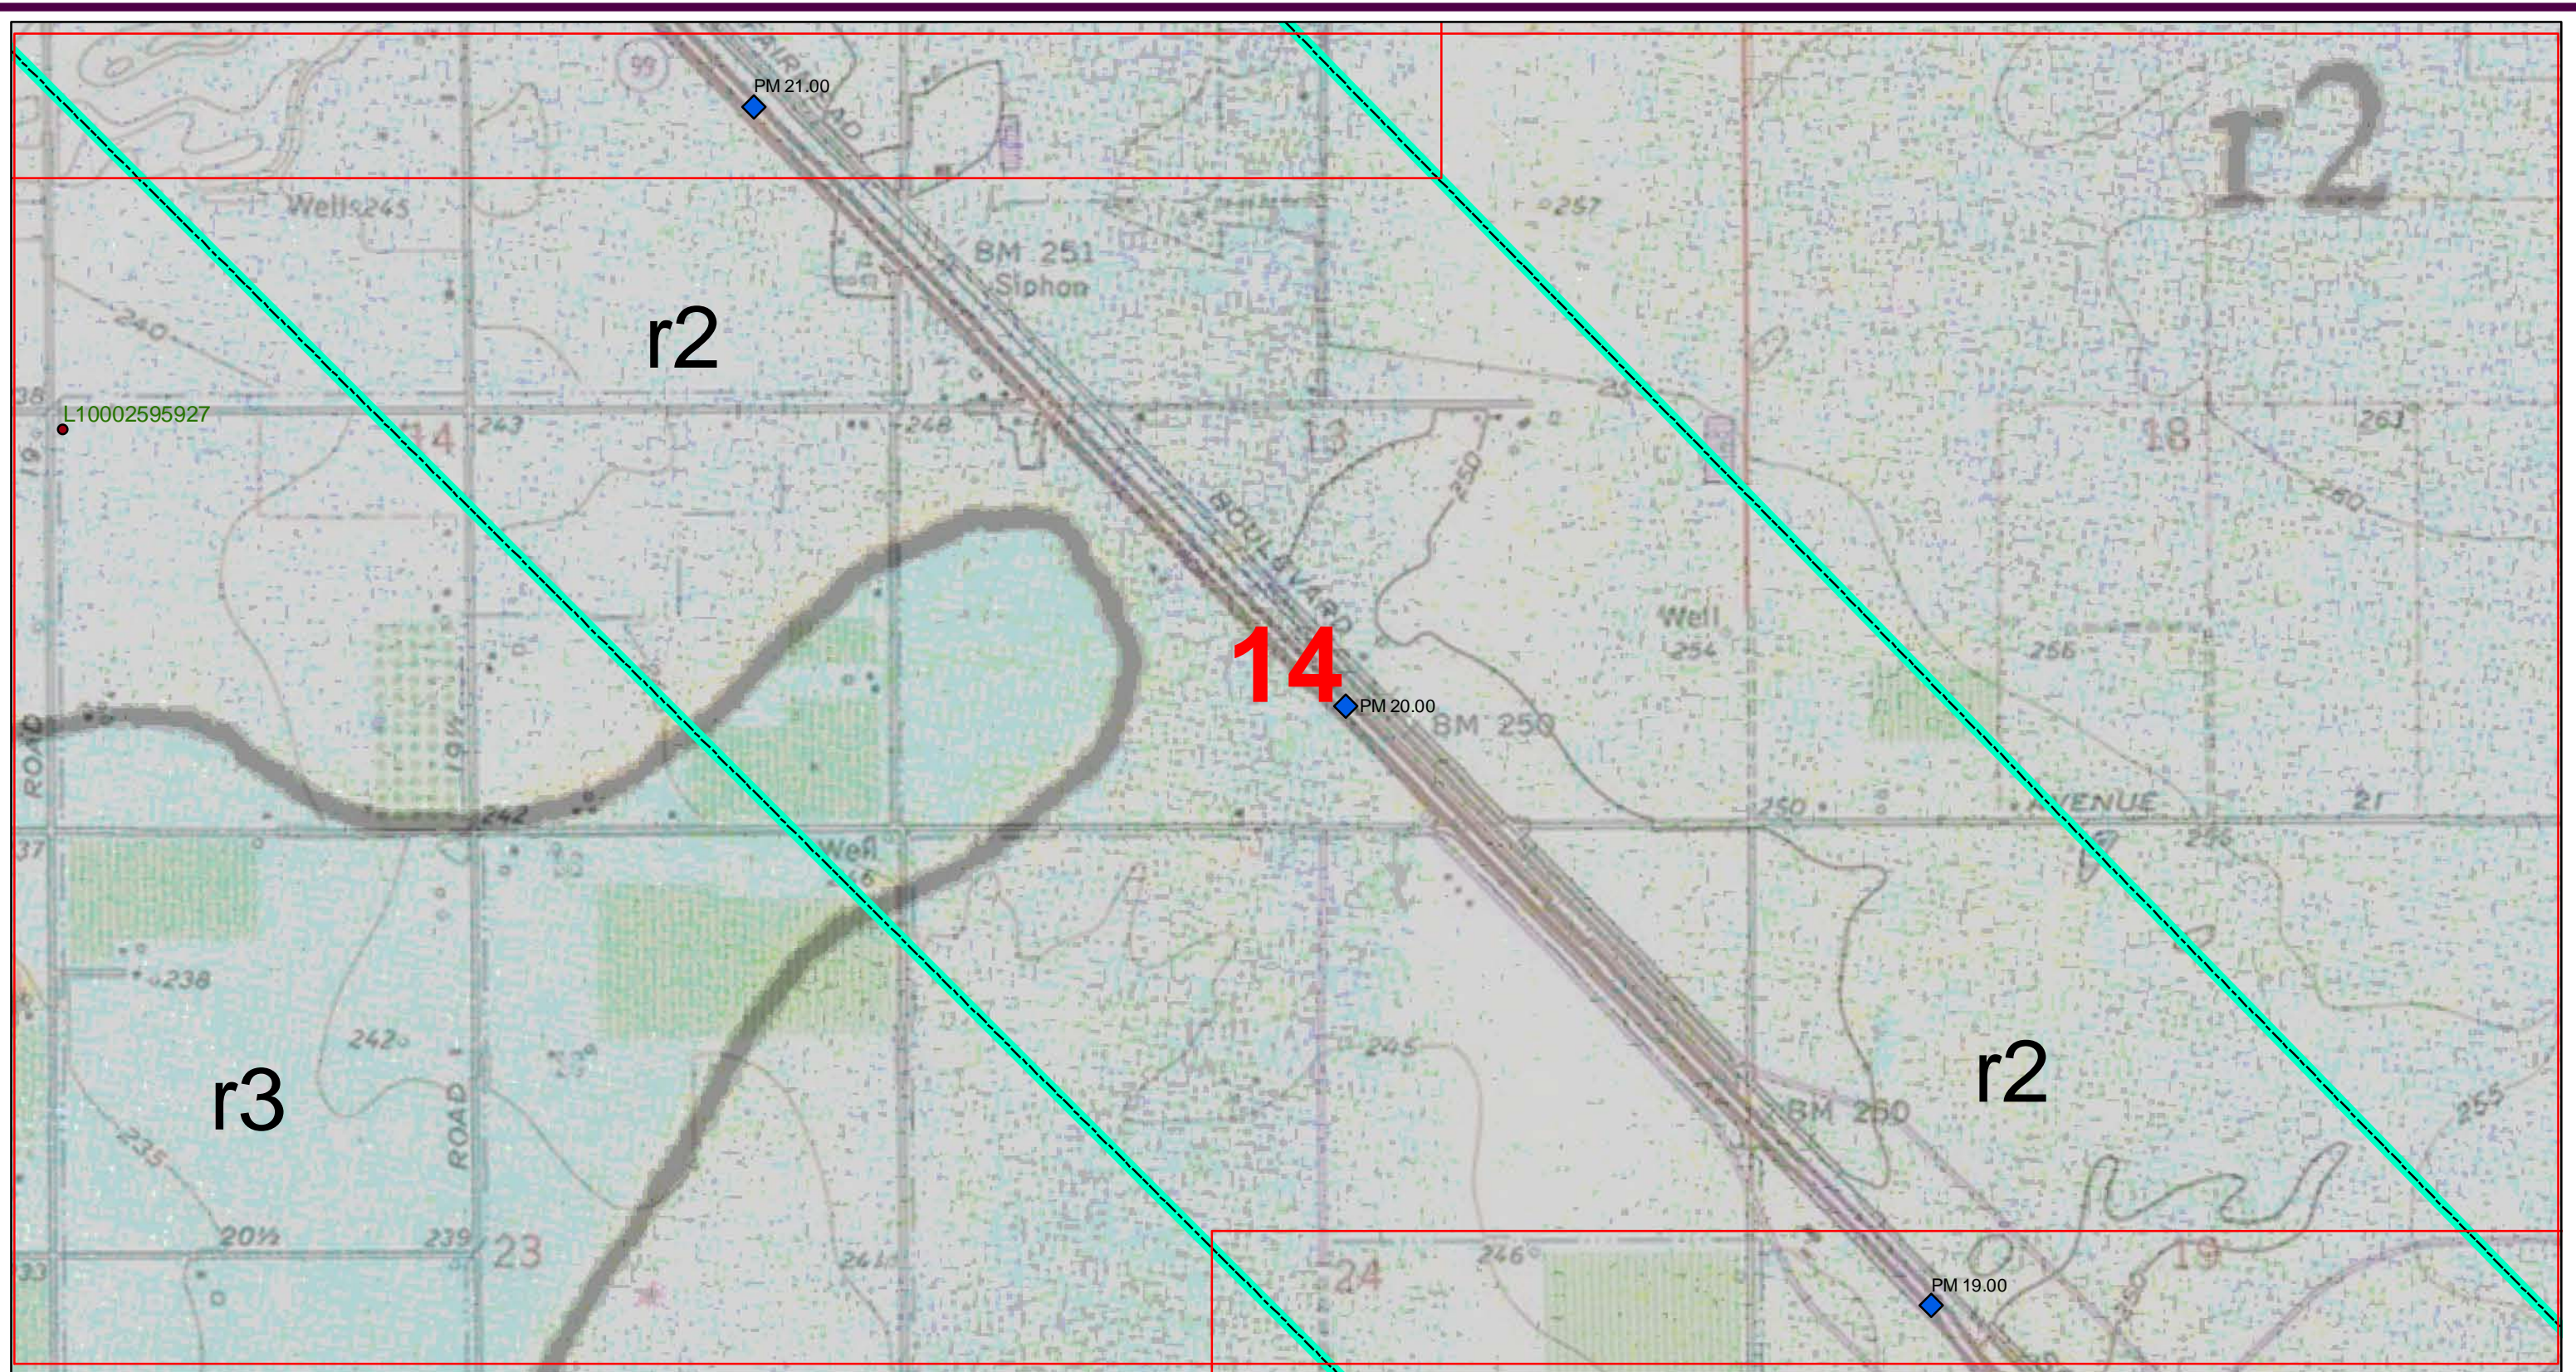

0 500 1,000 1,500 2,000 2,500 3,000  
Feet

See PLATE 2-0 for Legend

Geologic Map and Site Plan



PARIKH CONSULTANTS, INC.  
GEOTECHNICAL CONSULTANTS  
MATERIALS TESTING


SOURCES:  
Geology from Marchand and Allwardt; 1981; USGS Bulletin 1470.  
Caltrans bridges.  
GeoTracker sites.

California High-Speed Train Project  
(Merced - Fresno Section)

JOB NO.: 209138.10

PLATE NO.: 2-14



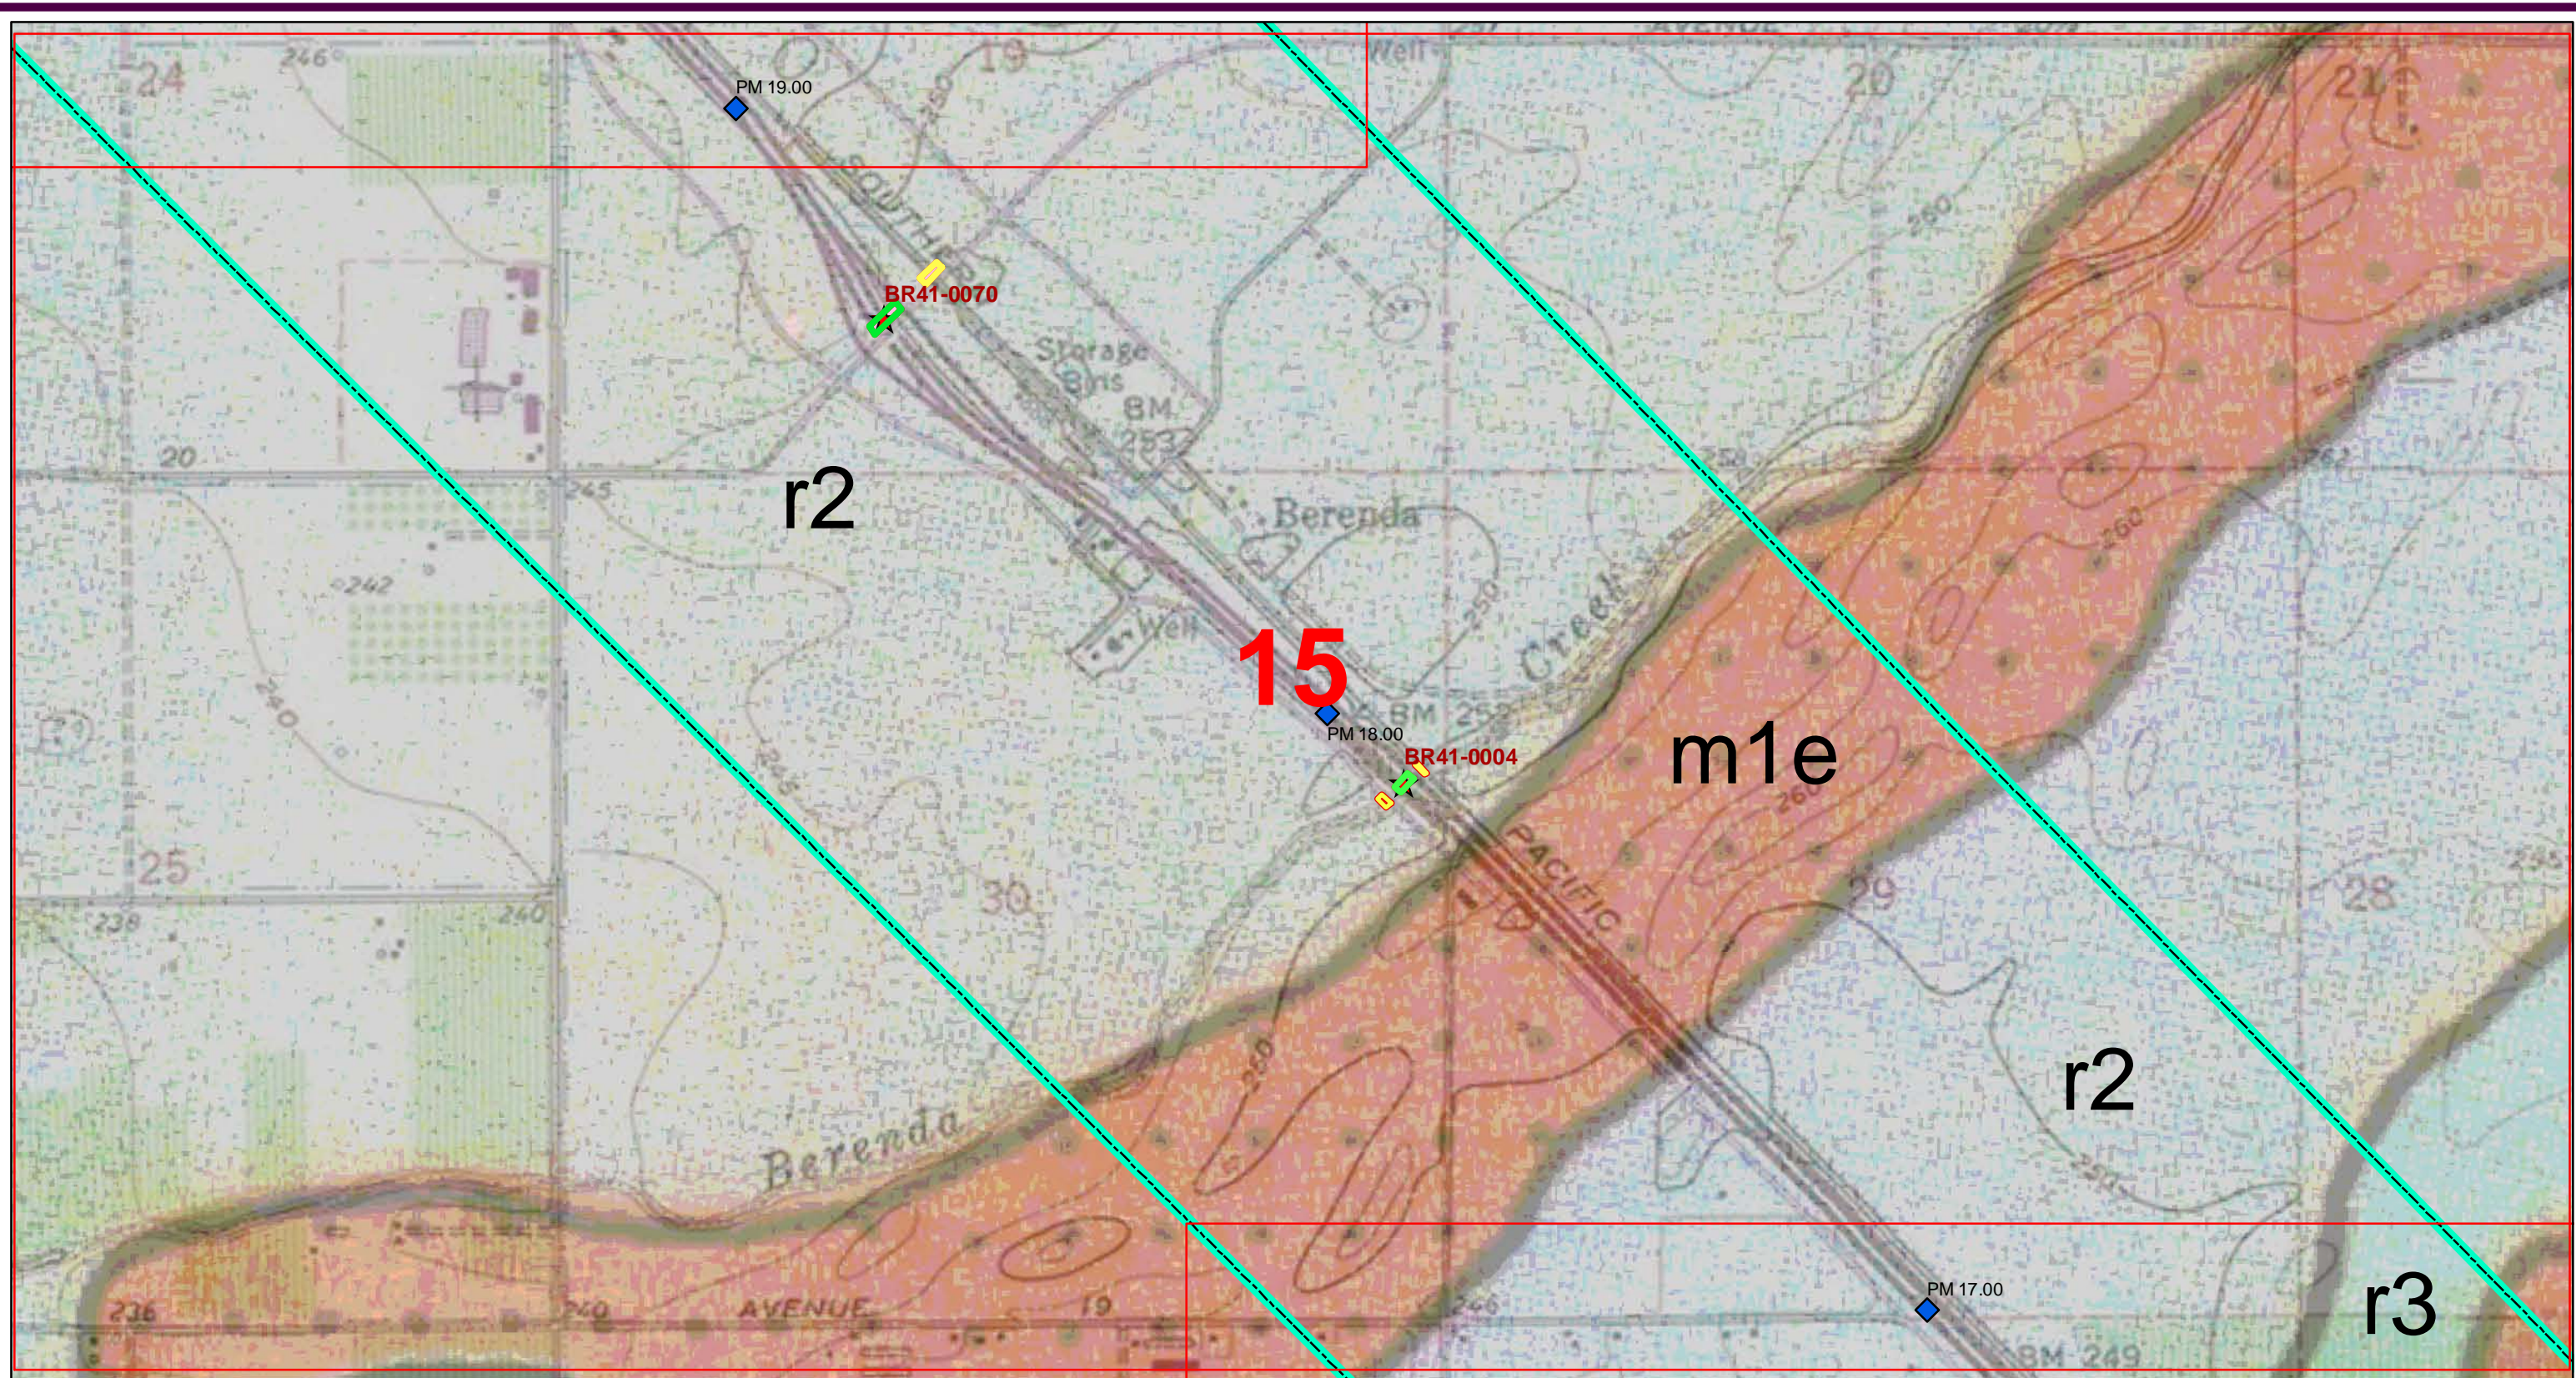

0 500 1,000 1,500 2,000 2,500 3,000  
Feet

See PLATE 2-0 for Legend

Geologic Map and Site Plan



PARIKH CONSULTANTS, INC.  
GEOTECHNICAL CONSULTANTS  
MATERIALS TESTING


SOURCES:  
Geology from Marchand and Allwardt; 1981; USGS Bulletin 1470.  
Caltrans bridges.  
GeoTracker sites.

California High-Speed Train Project  
(Merced - Fresno Section)

JOB NO.: 209138.10

PLATE NO.: 2-15



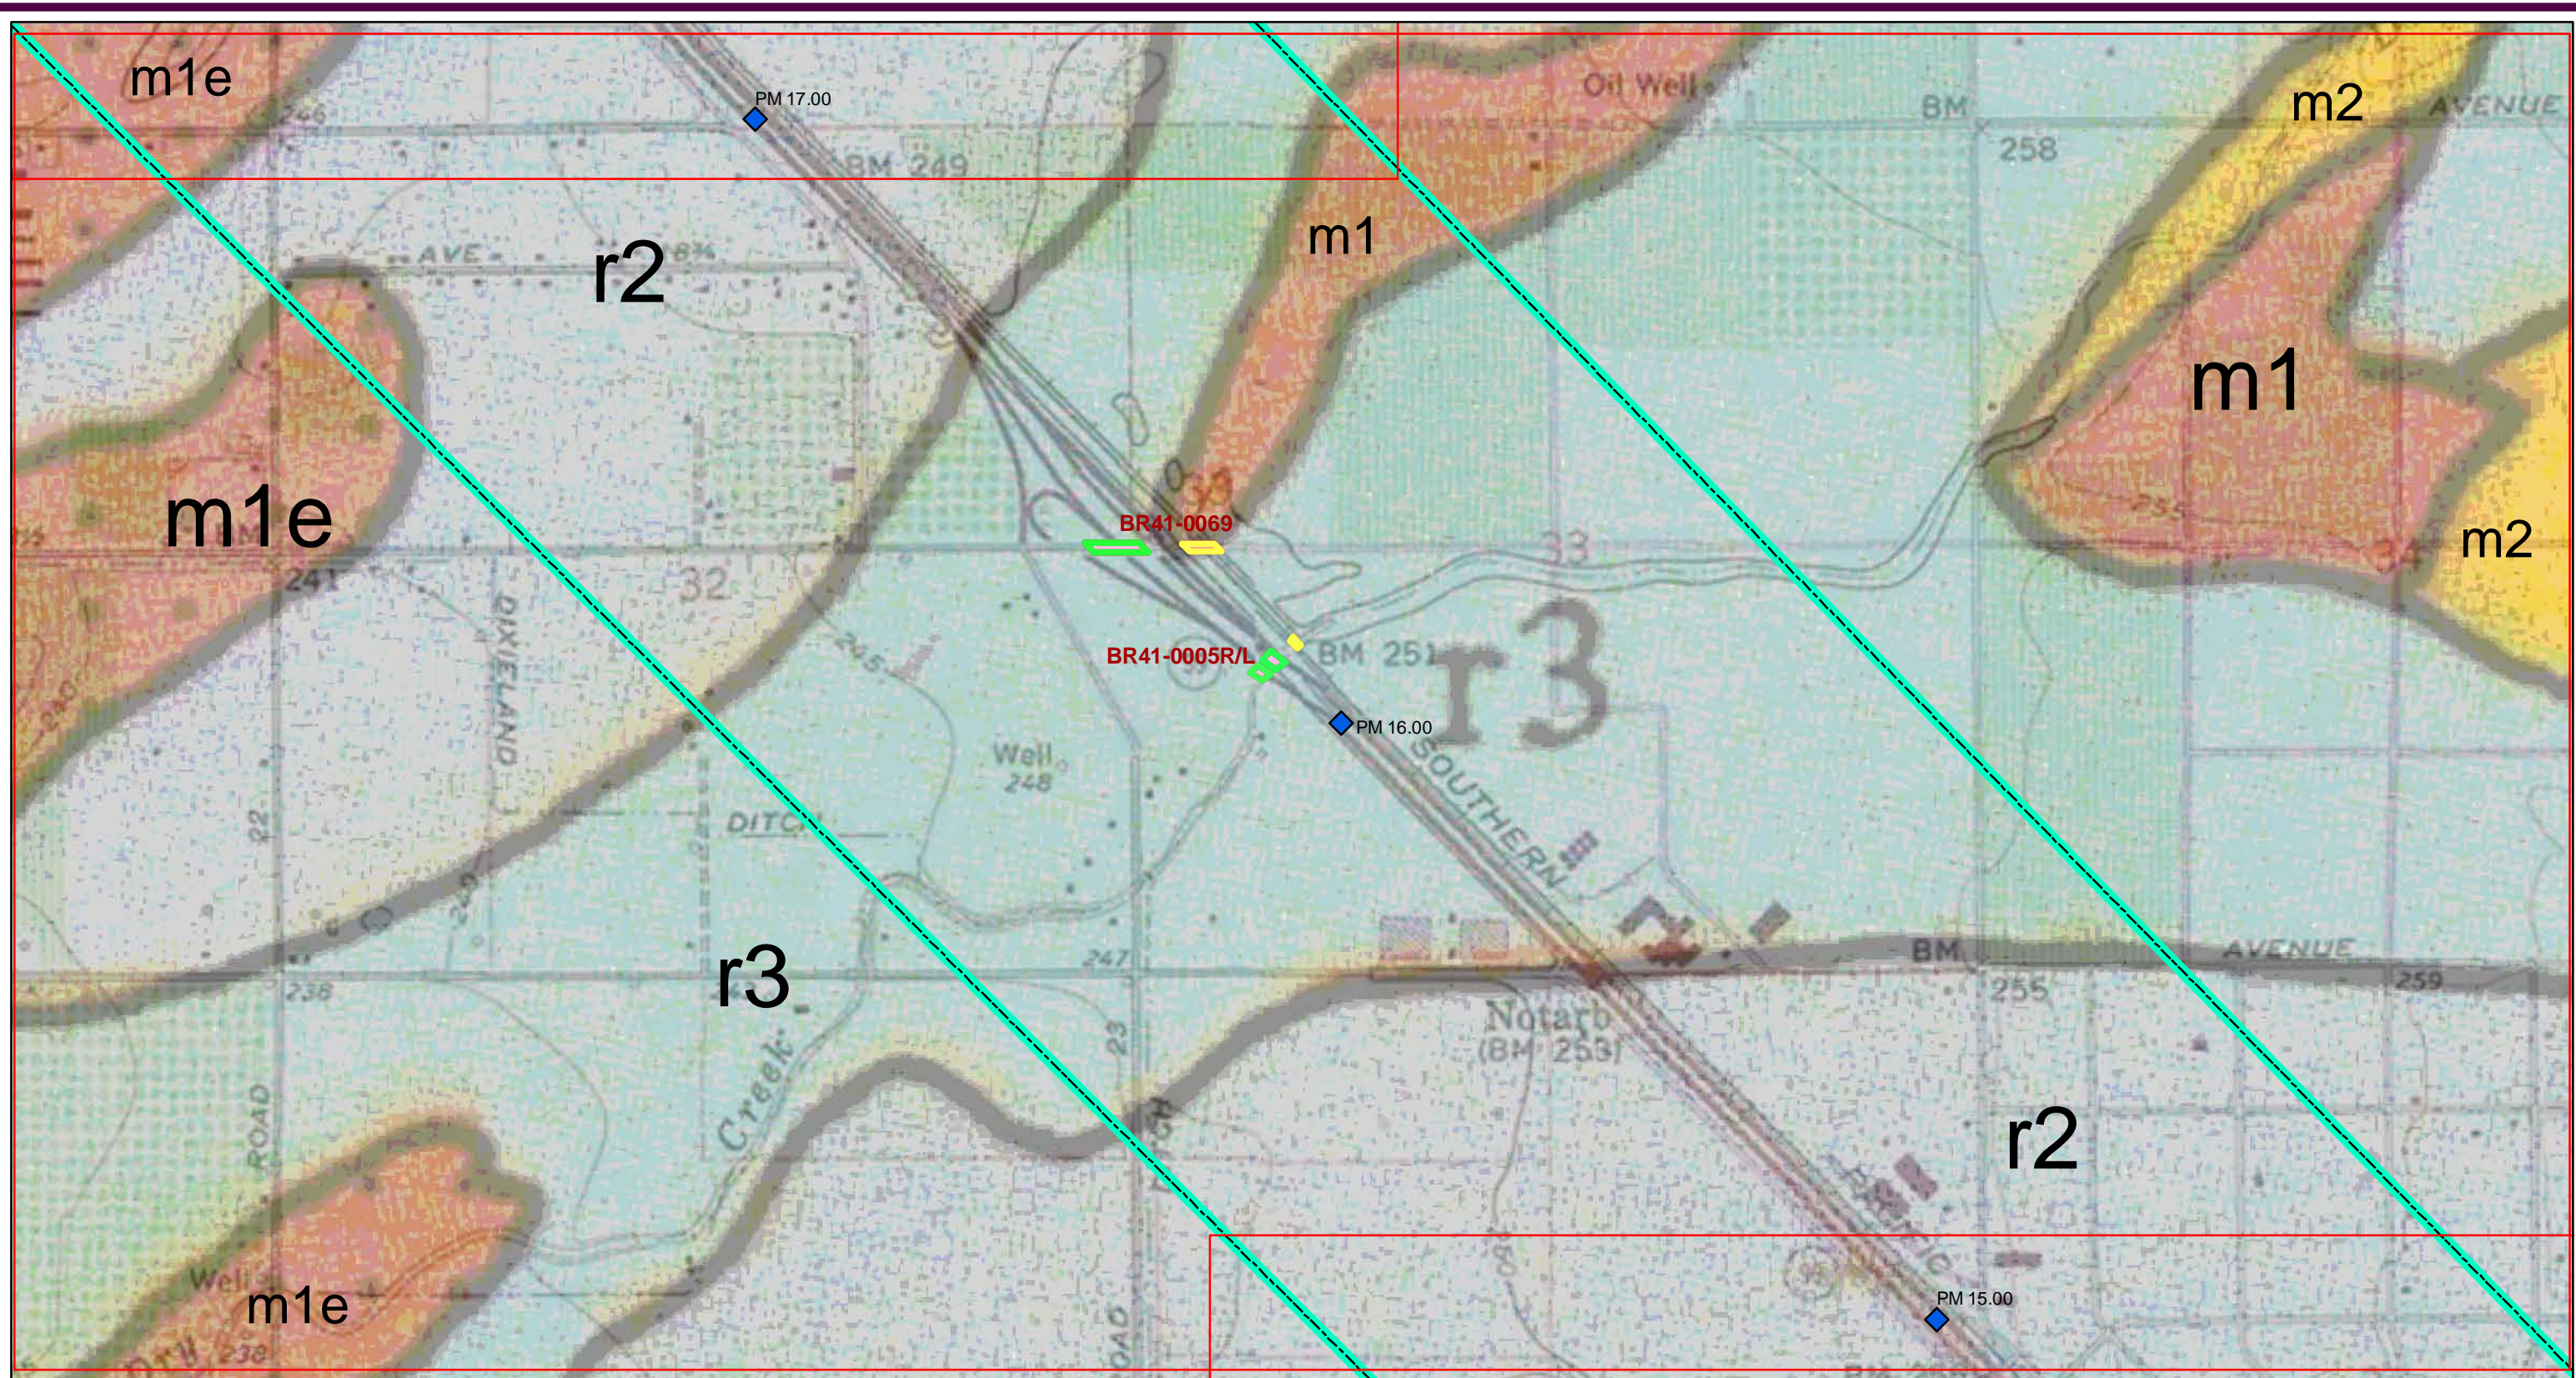

0 500 1,000 1,500 2,000 2,500 3,000  
Feet

See PLATE 2-0 for Legend

Geologic Map and Site Plan



PARIKH CONSULTANTS, INC.  
GEOTECHNICAL CONSULTANTS  
MATERIALS TESTING


SOURCES:  
Geology from Marchand and Allwardt; 1981; USGS Bulletin 1470.  
Caltrans bridges.  
GeoTracker sites.

California High-Speed Train Project  
(Merced - Fresno Section )

JOB NO.: 209138.10

PLATE NO.: 2-16



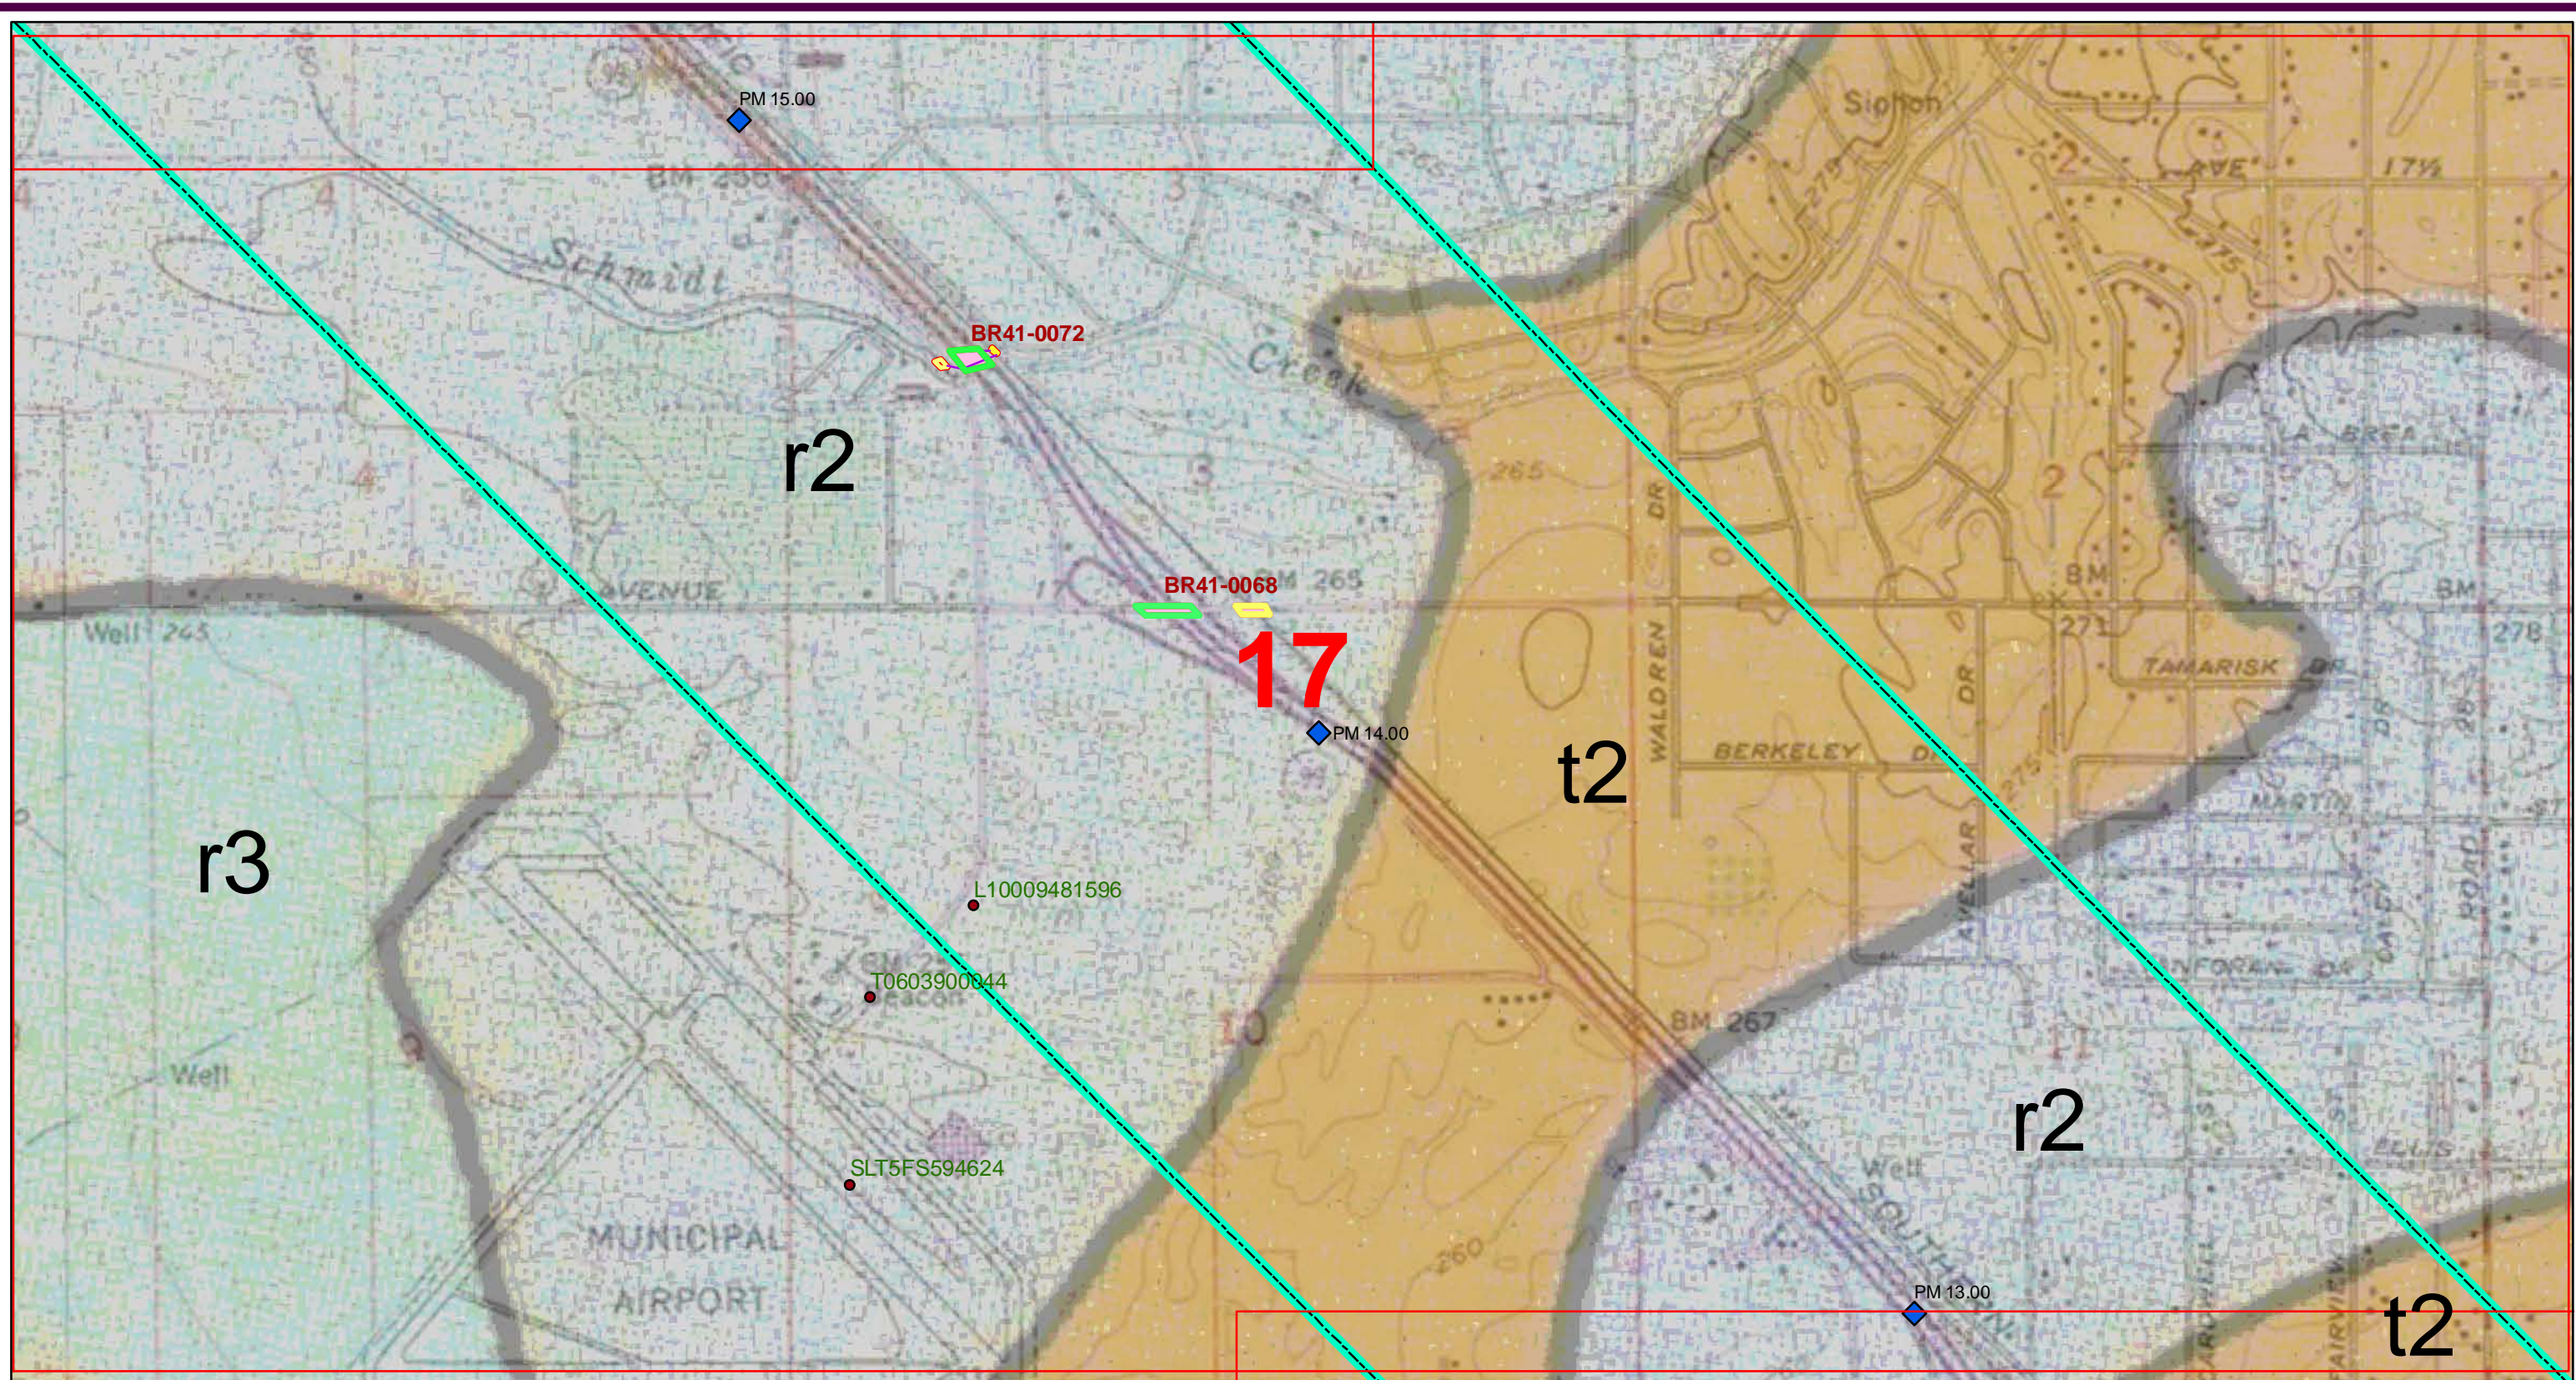

0 500 1,000 1,500 2,000 2,500 3,000  
Feet

See PLATE 2-0 for Legend

Geologic Map and Site Plan



PARIKH CONSULTANTS, INC.  
GEOTECHNICAL CONSULTANTS  
MATERIALS TESTING


SOURCES:  
Geology from Marchand and Allwardt; 1981; USGS Bulletin 1470.  
Caltrans bridges.  
GeoTracker sites.

California High-Speed Train Project  
(Merced - Fresno Section)

JOB NO.: 209138.10

PLATE NO.: 2-17



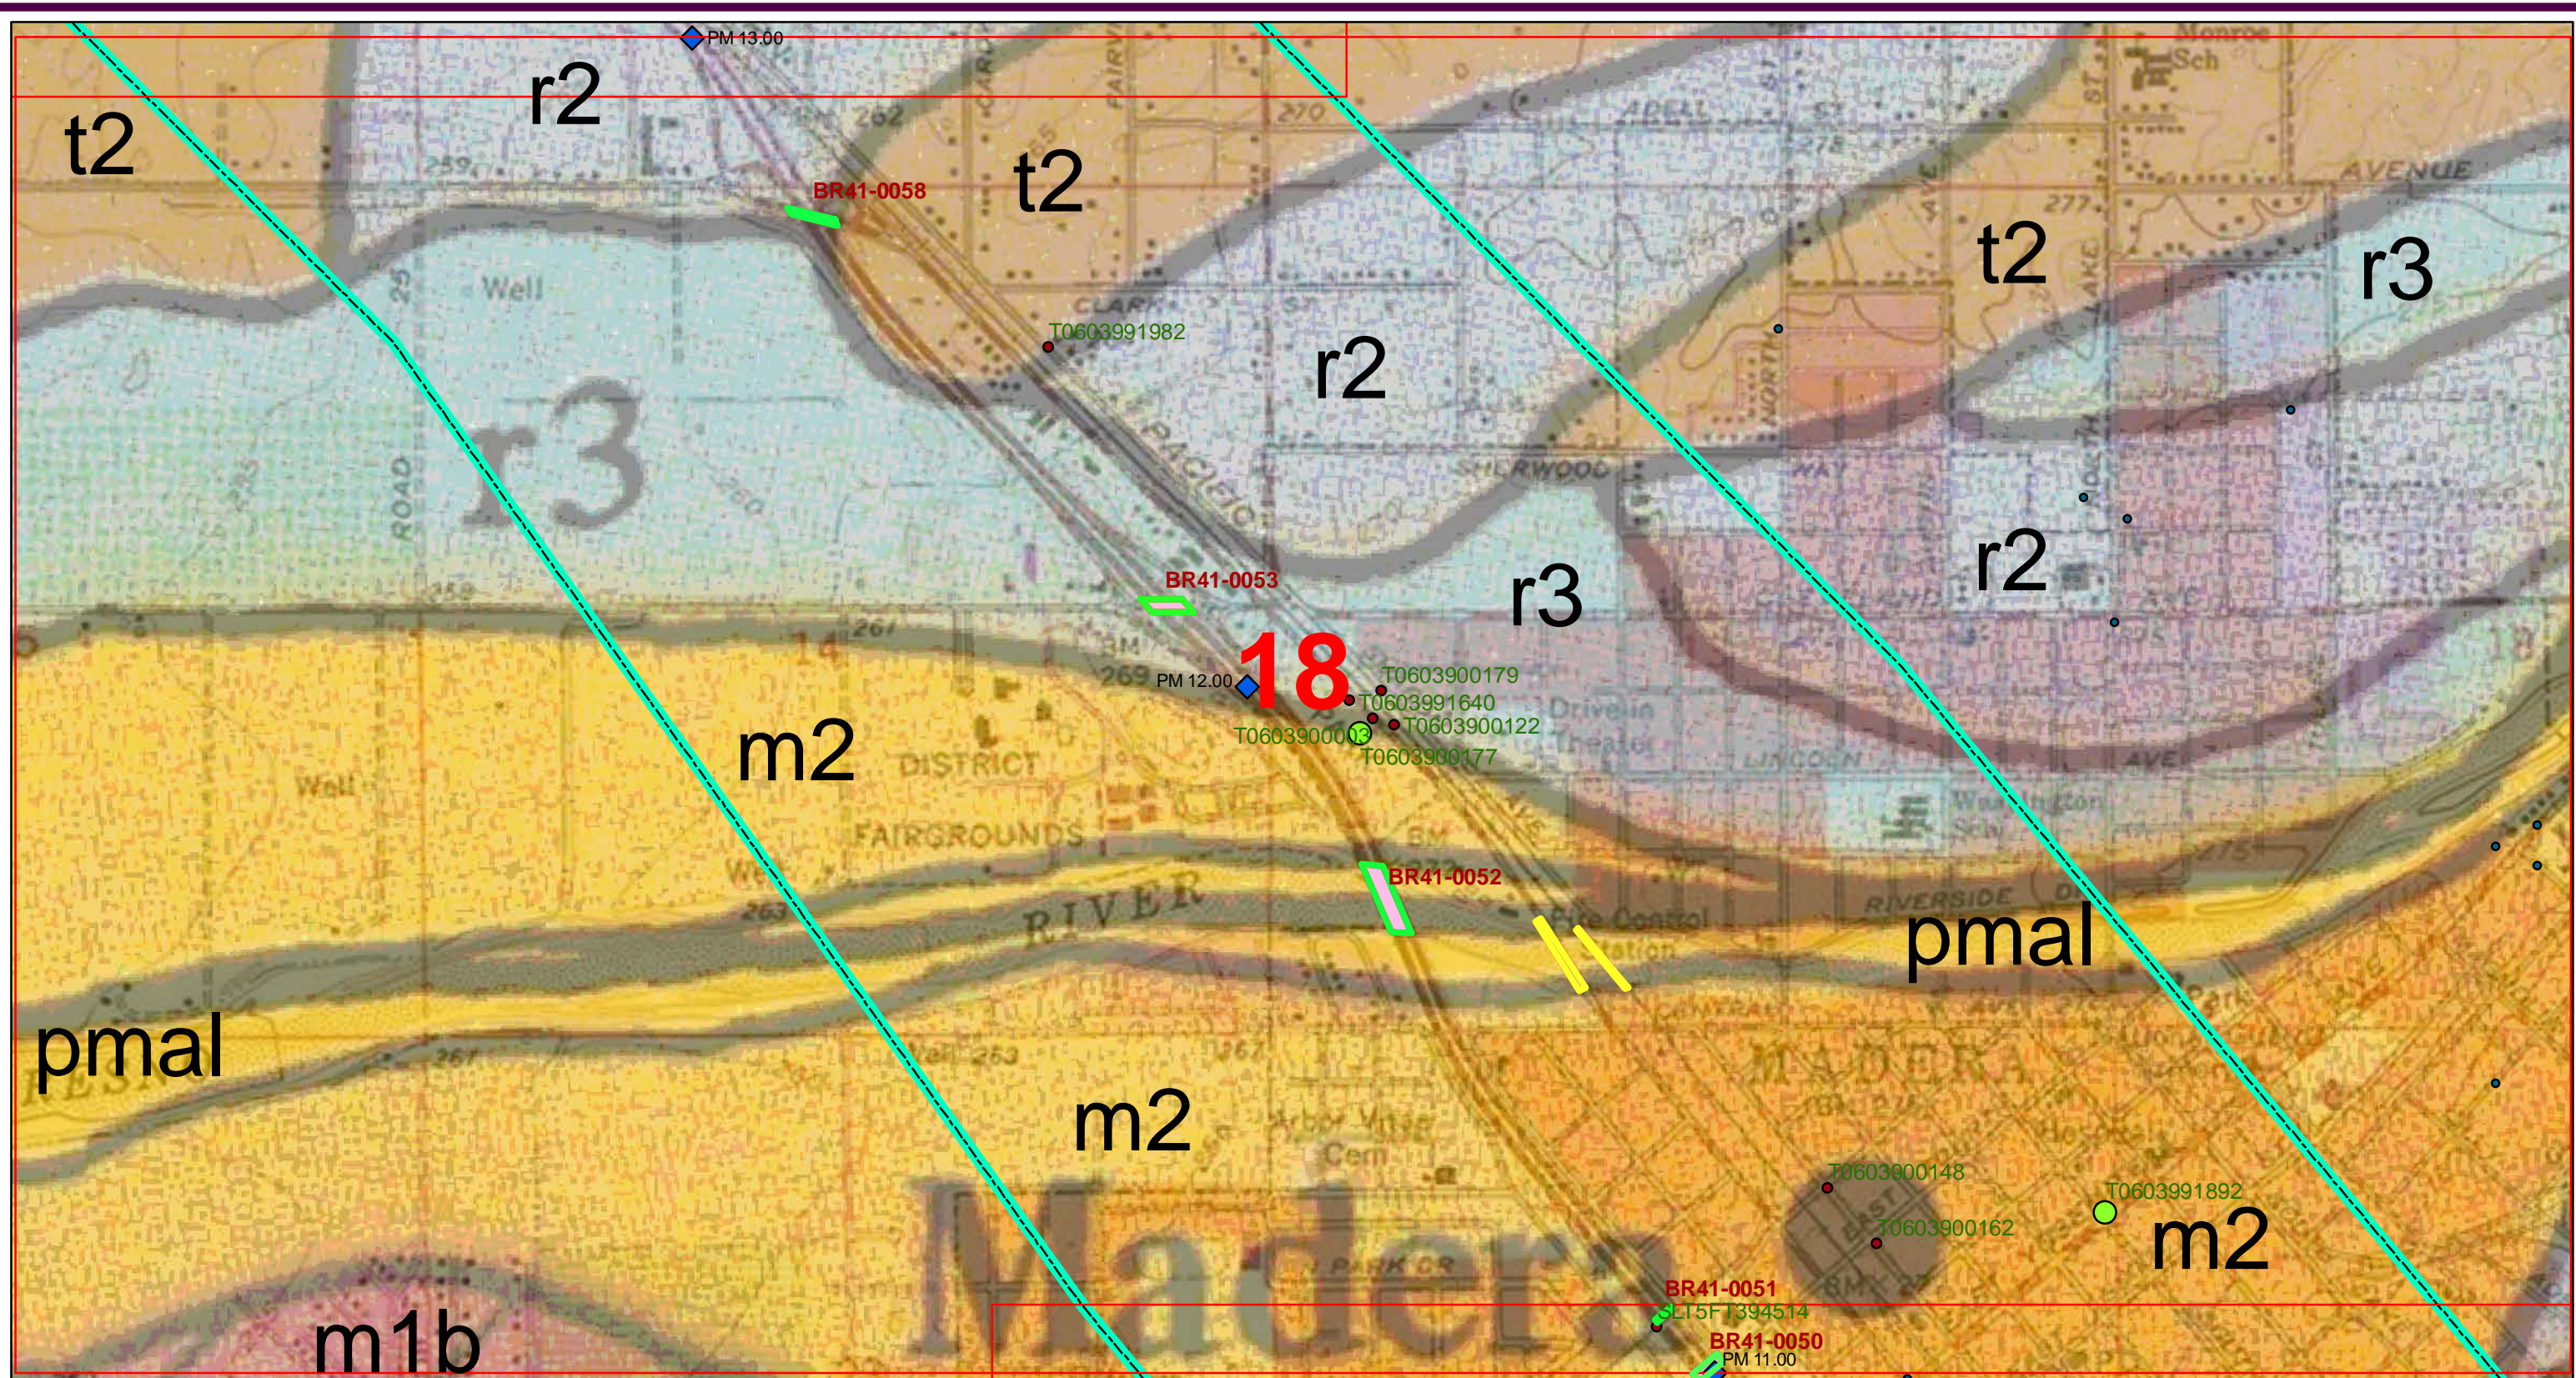

0 500 1,000 1,500 2,000 2,500 3,000  
Feet

See PLATE 2-0 for Legend

Geologic Map and Site Plan



PARIKH CONSULTANTS, INC.  
GEOTECHNICAL CONSULTANTS  
MATERIALS TESTING


SOURCES:  
Geology from Marchand and Allwardt; 1981; USGS Bulletin 1470.  
Caltrans bridges.  
GeoTracker sites.

California High-Speed Train Project  
(Merced - Fresno Section)

JOB NO.: 209138.10

PLATE NO.: 2-18



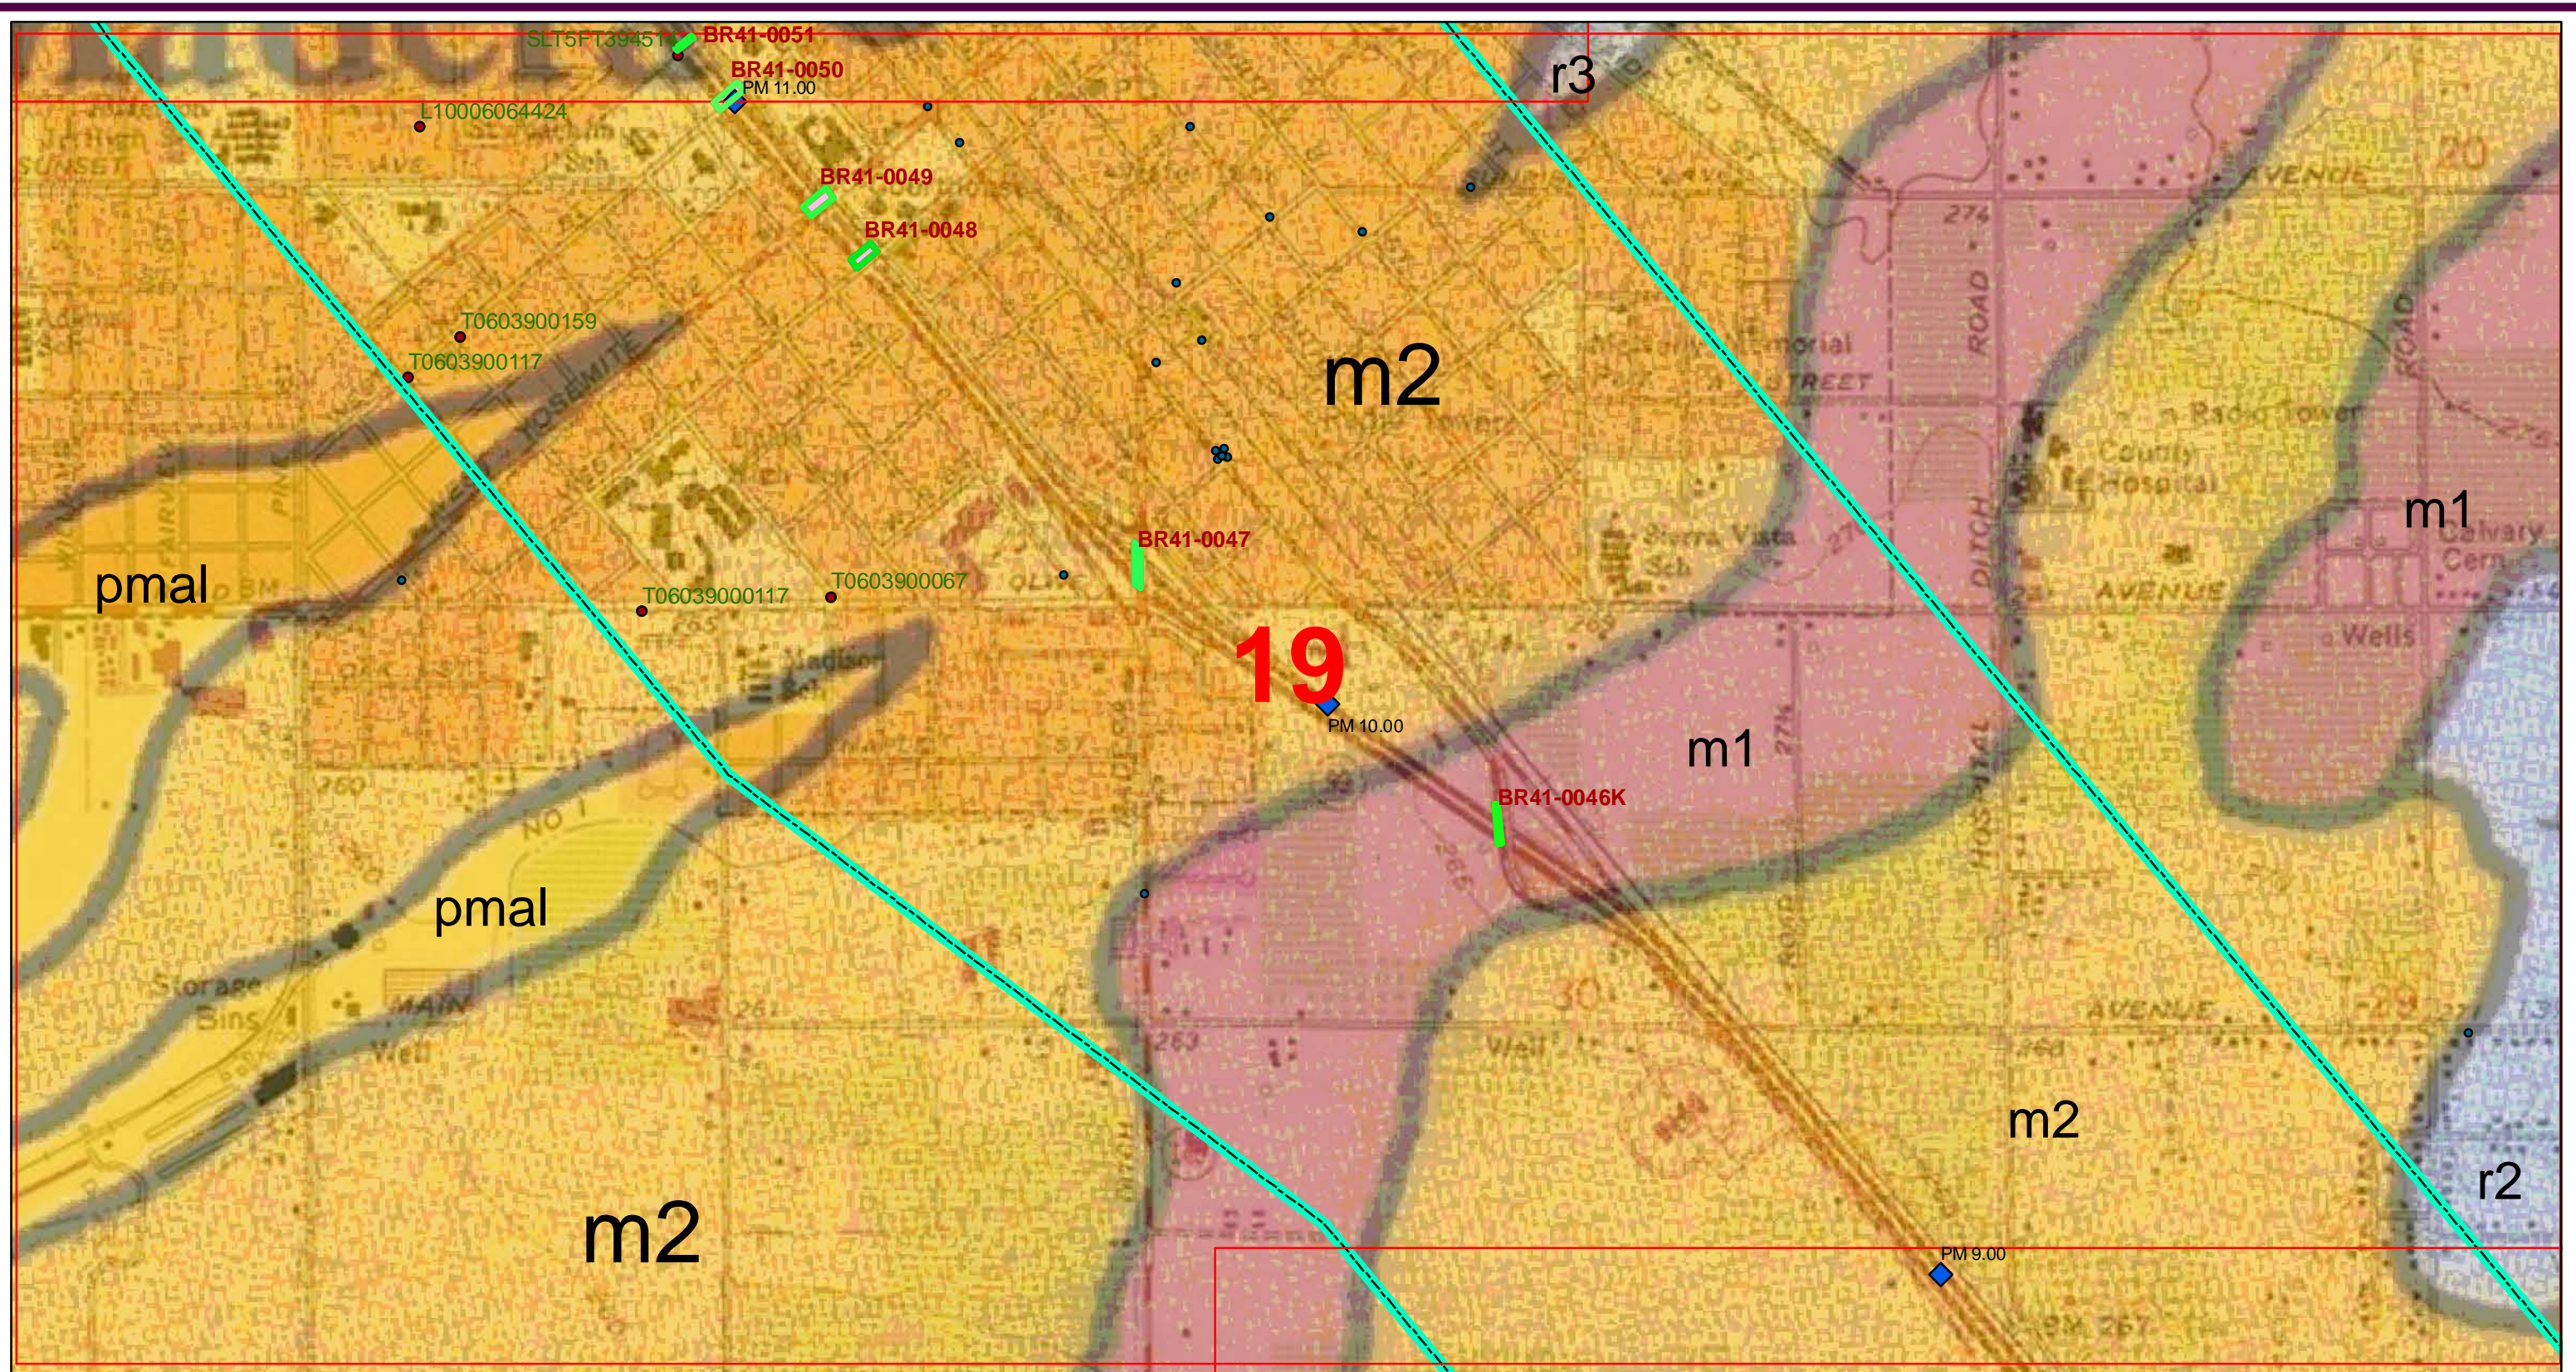

0 500 1,000 1,500 2,000 2,500 3,000  
Feet

See PLATE 2-0 for Legend

Geologic Map and Site Plan



PARIKH CONSULTANTS, INC.  
GEOTECHNICAL CONSULTANTS  
MATERIALS TESTING


SOURCES:  
Geology from Marchand and Allwardt; 1981; USGS Bulletin 1470.  
Caltrans bridges.  
GeoTracker sites.

California High-Speed Train Project  
(Merced - Fresno Section)

JOB NO.: 209138.10

PLATE NO.: 2-19



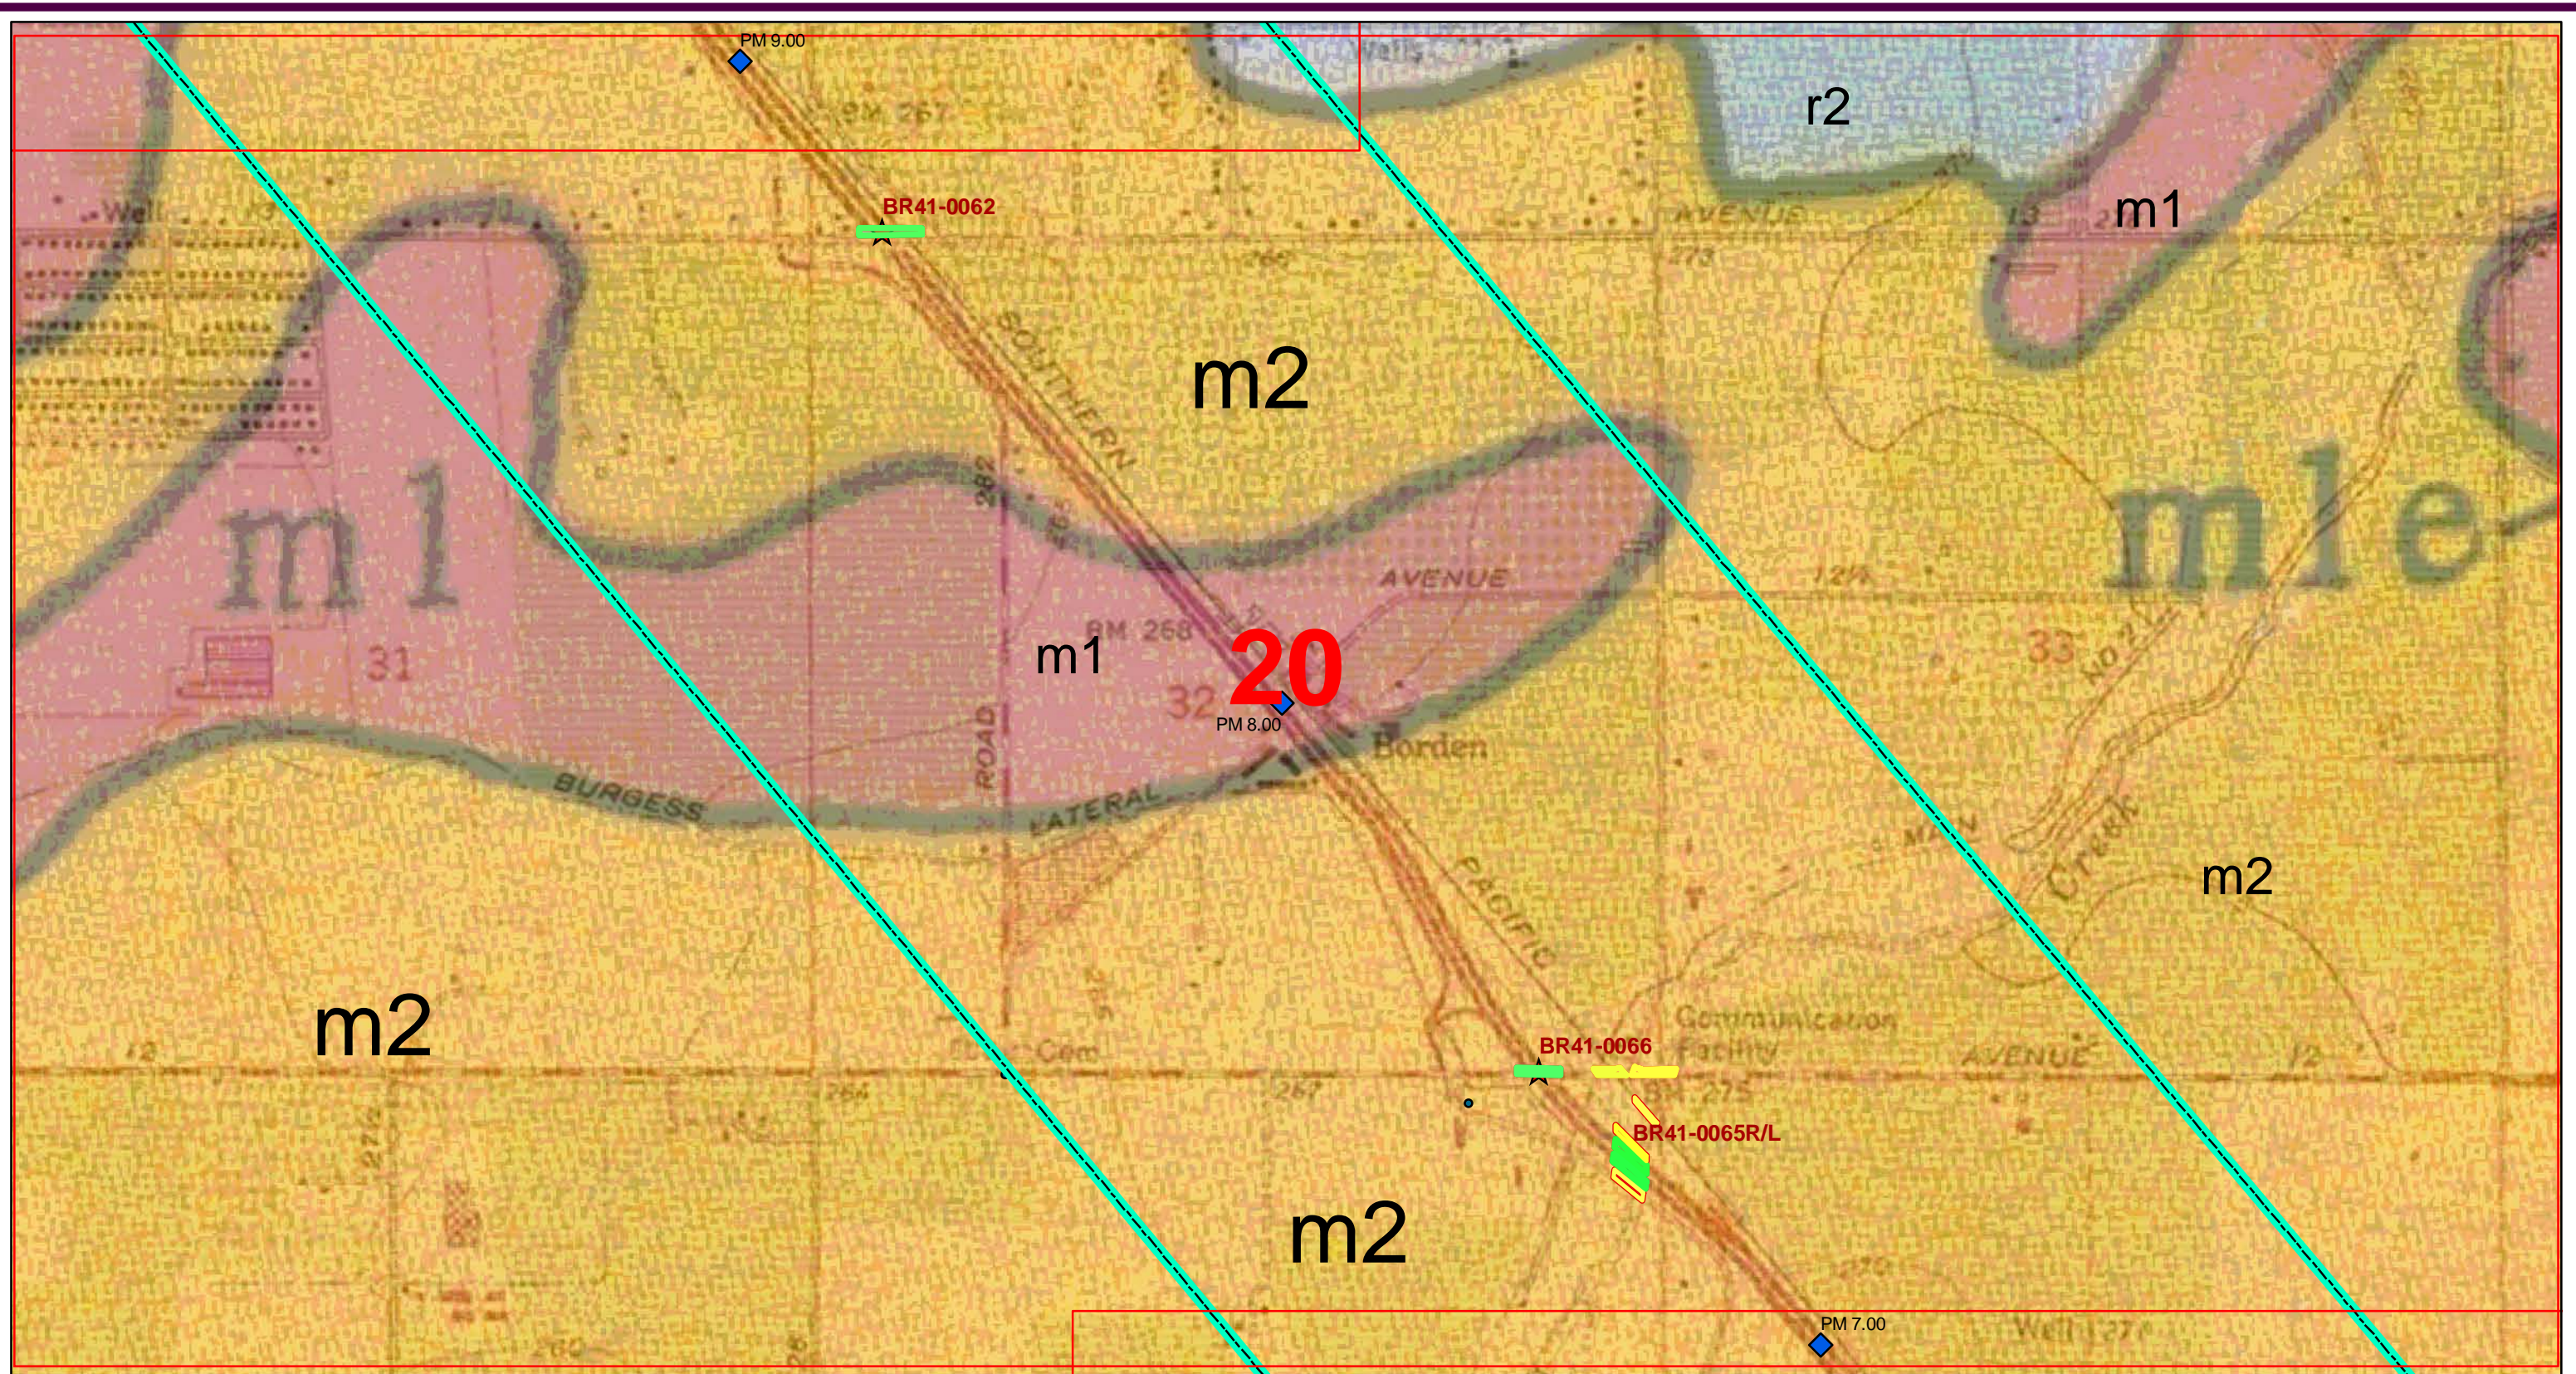

0 500 1,000 1,500 2,000 2,500 3,000  
Feet

See PLATE 2-0 for Legend

Geologic Map and Site Plan



PARIKH CONSULTANTS, INC.  
GEOTECHNICAL CONSULTANTS  
MATERIALS TESTING


SOURCES:  
Geology from Marchand and Allwardt; 1981; USGS Bulletin 1470.  
Caltrans bridges.  
GeoTracker sites.

California High-Speed Train Project  
(Merced - Fresno Section)

JOB NO.: 209138.10

PLATE NO.: 2-20



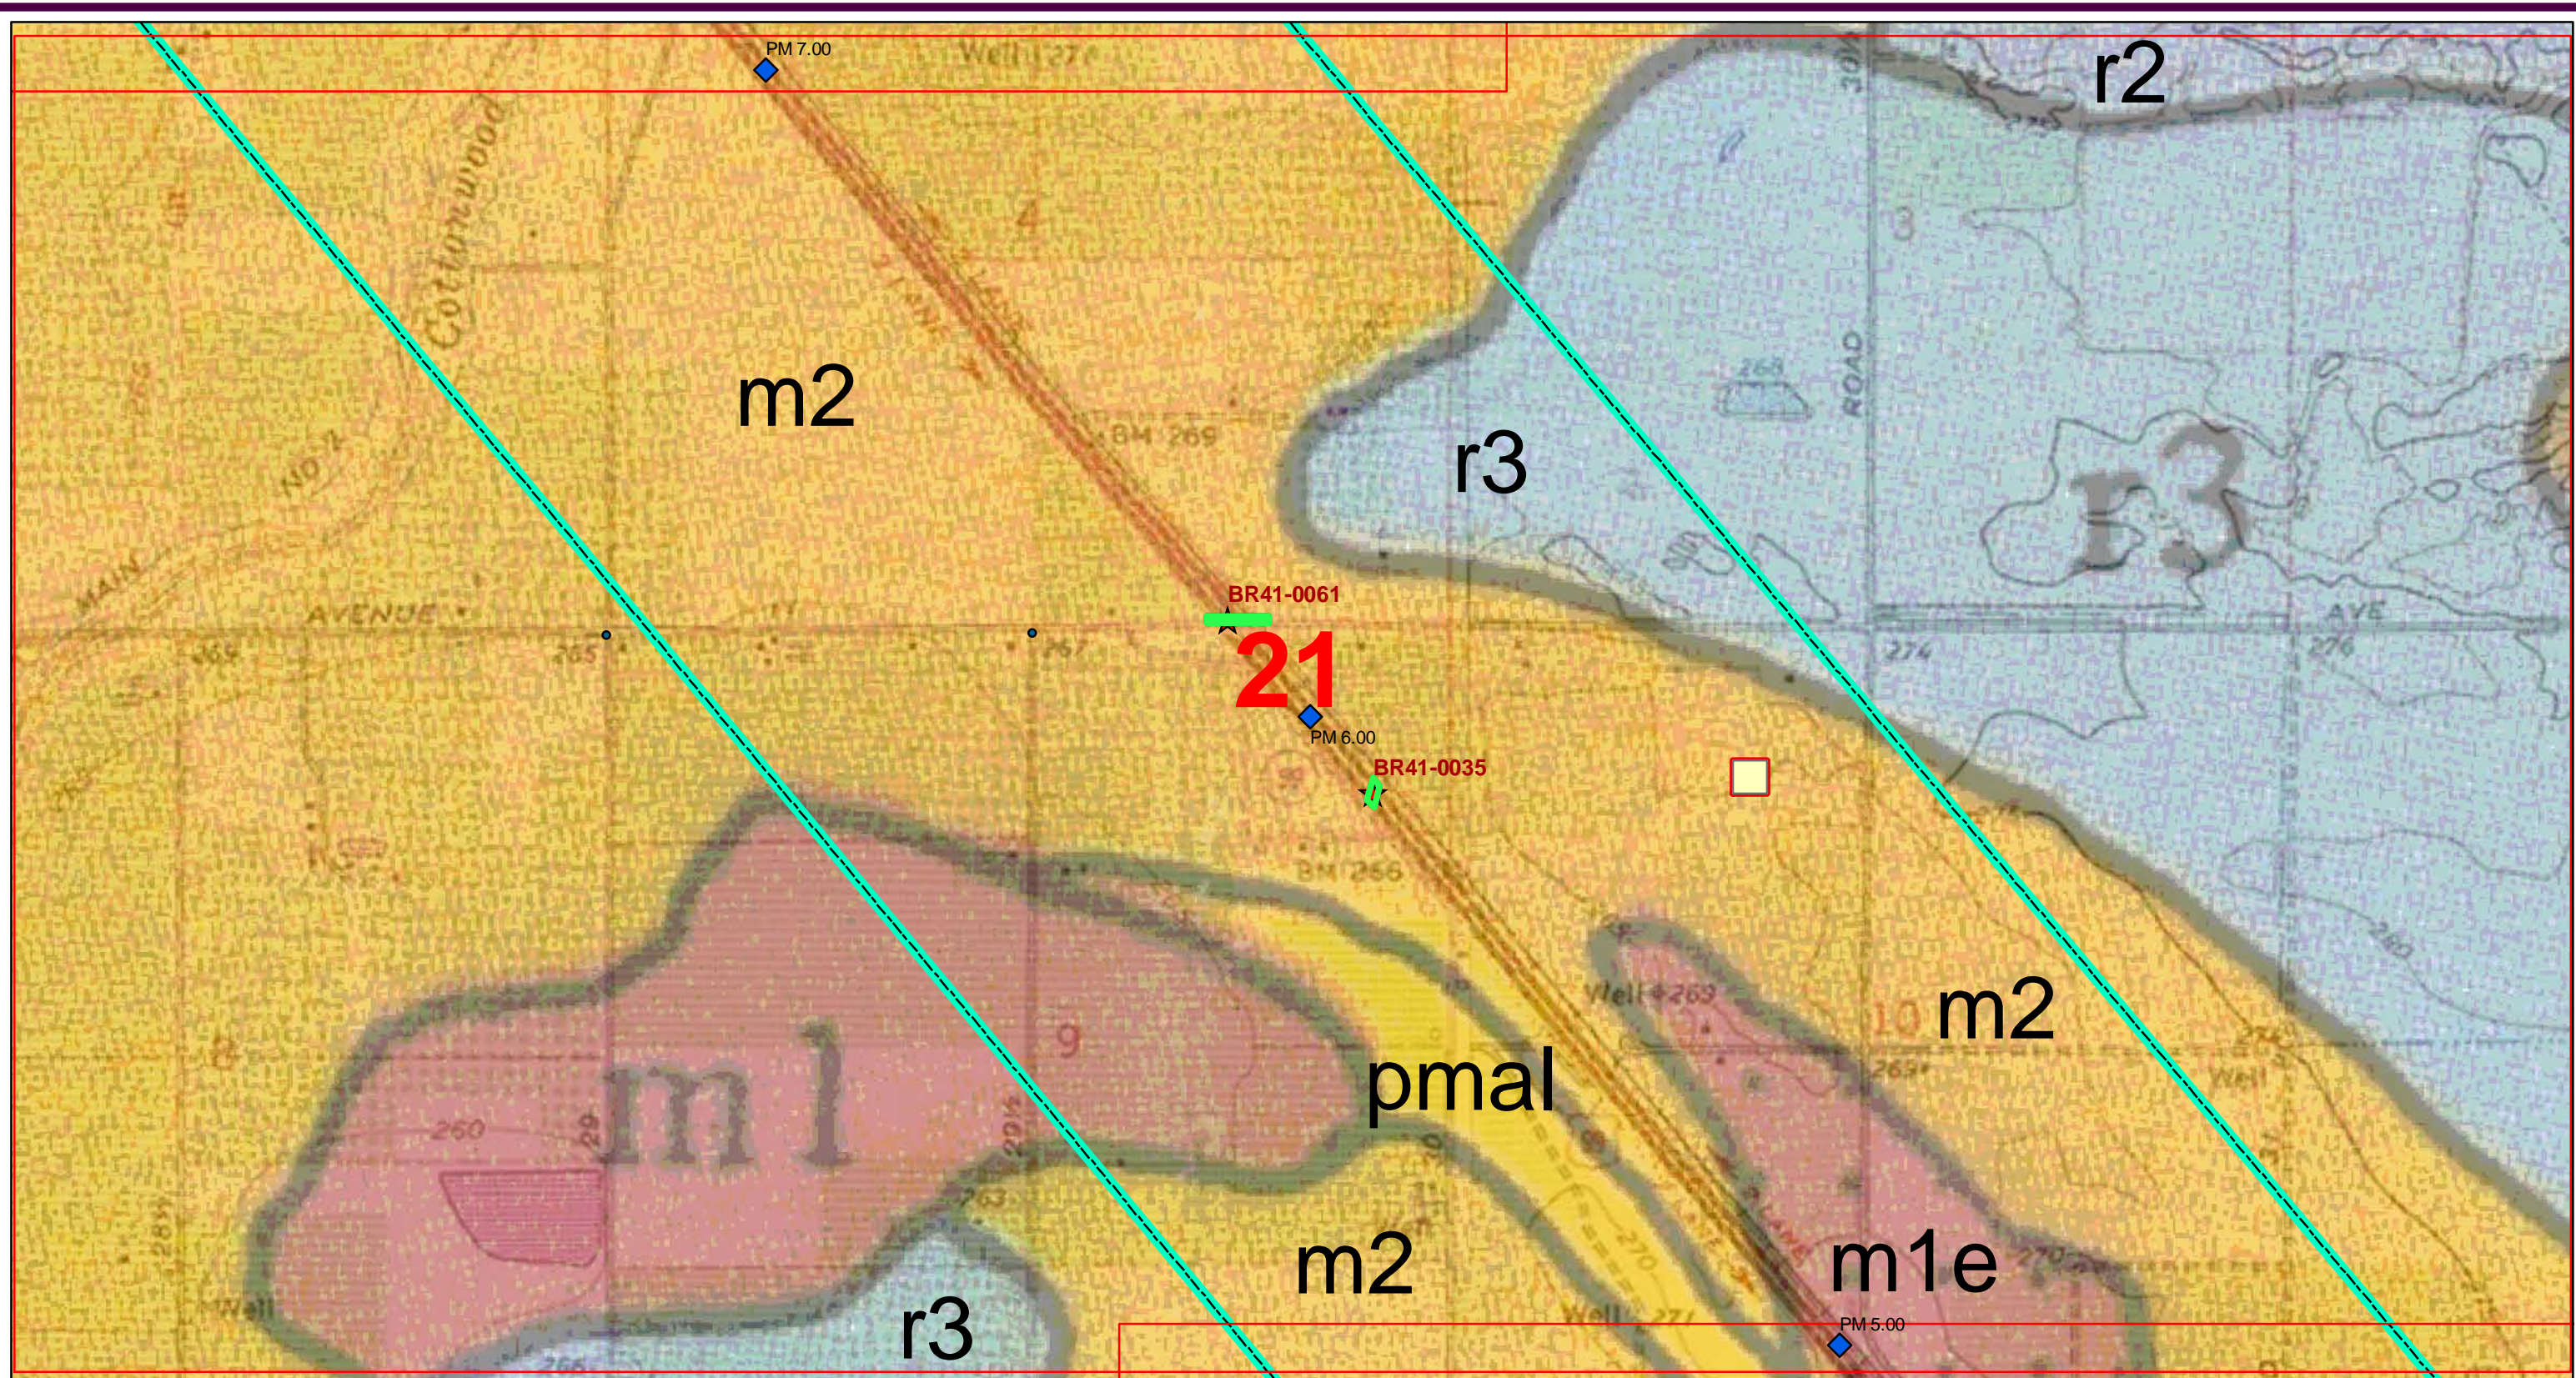

0 500 1,000 1,500 2,000 2,500 3,000  
Feet

See PLATE 2-0 for Legend

Geologic Map and Site Plan



PARIKH CONSULTANTS, INC.  
GEOTECHNICAL CONSULTANTS  
MATERIALS TESTING


SOURCES:  
Geology from Marchand and Allwardt; 1981; USGS Bulletin 1470.  
Caltrans bridges.  
GeoTracker sites.

California High-Speed Train Project  
(Merced - Fresno Section)

JOB NO.: 209138.10

PLATE NO.: 2-21



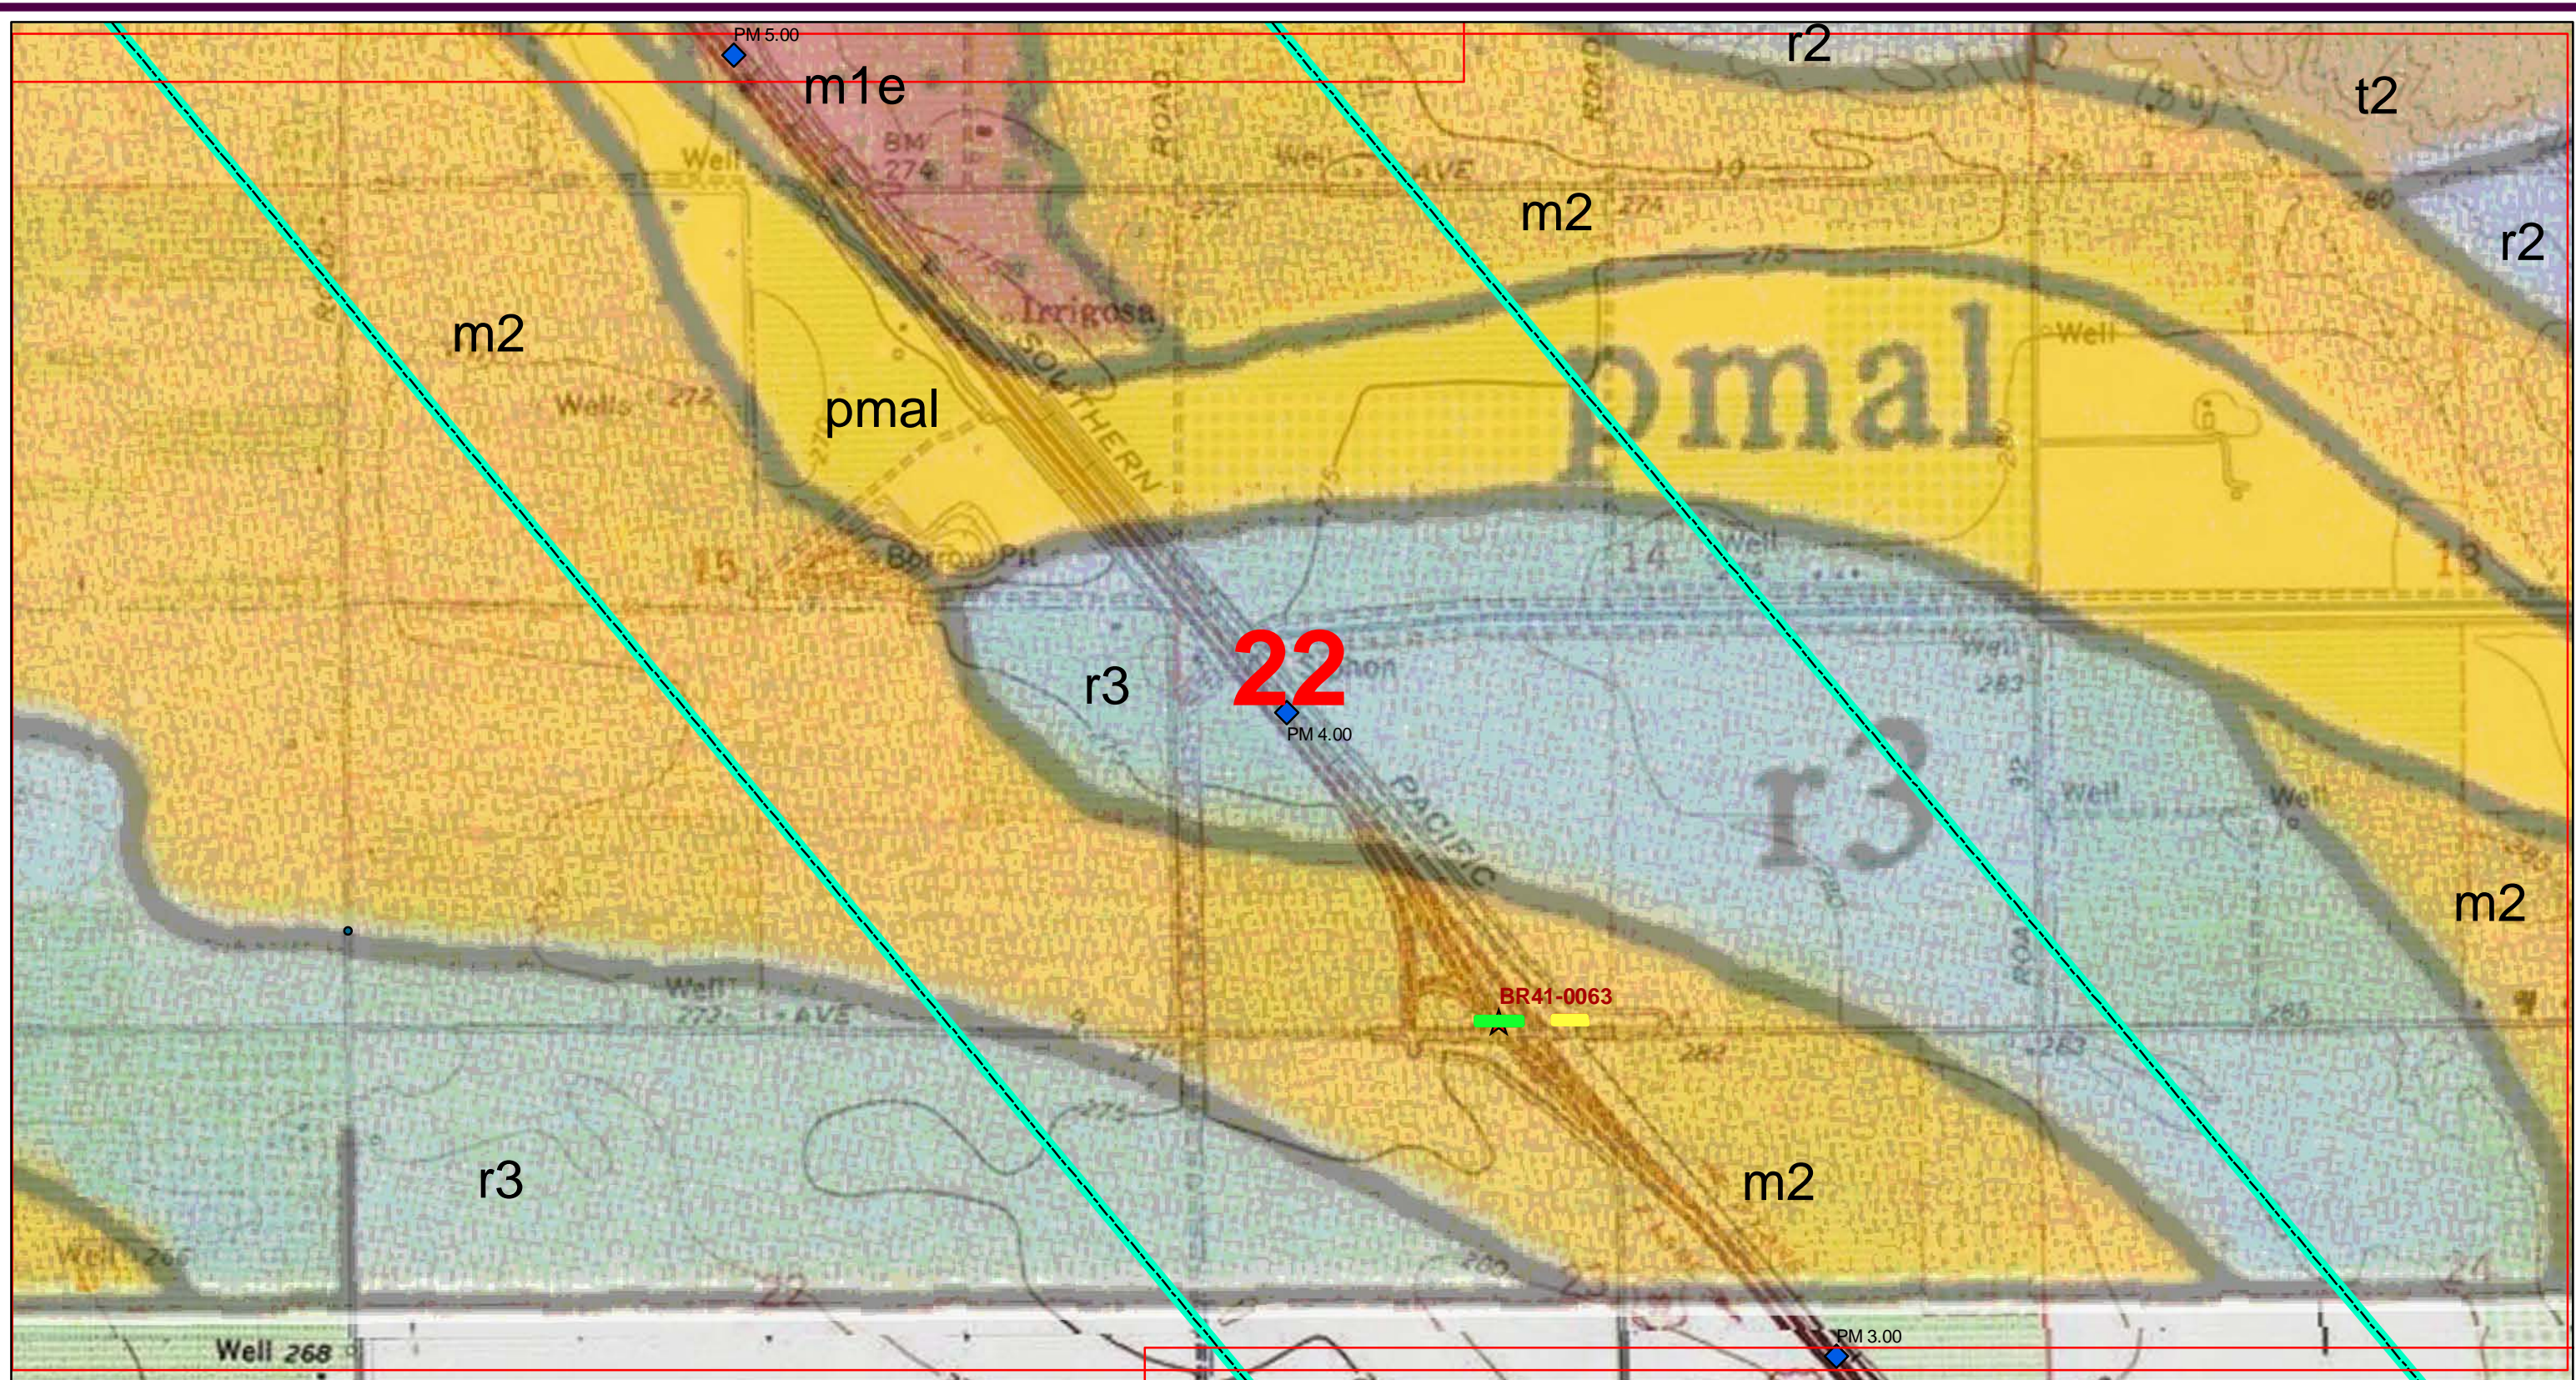

0 500 1,000 1,500 2,000 2,500 3,000  
Feet

See PLATE 2-0 for Legend

Geologic Map and Site Plan



PARIKH CONSULTANTS, INC.  
GEOTECHNICAL CONSULTANTS  
MATERIALS TESTING



SOURCES:  
Geology from Marchand and Allwardt; 1981; USGS Bulletin 1470.  
Caltrans bridges.  
GeoTracker sites

California High-Speed Train Project  
(Merced - Fresno Section)

JOB NO.: 209138.10

PLATE NO.: 2-22



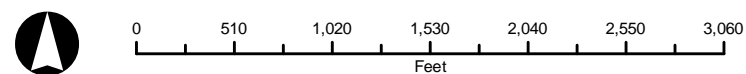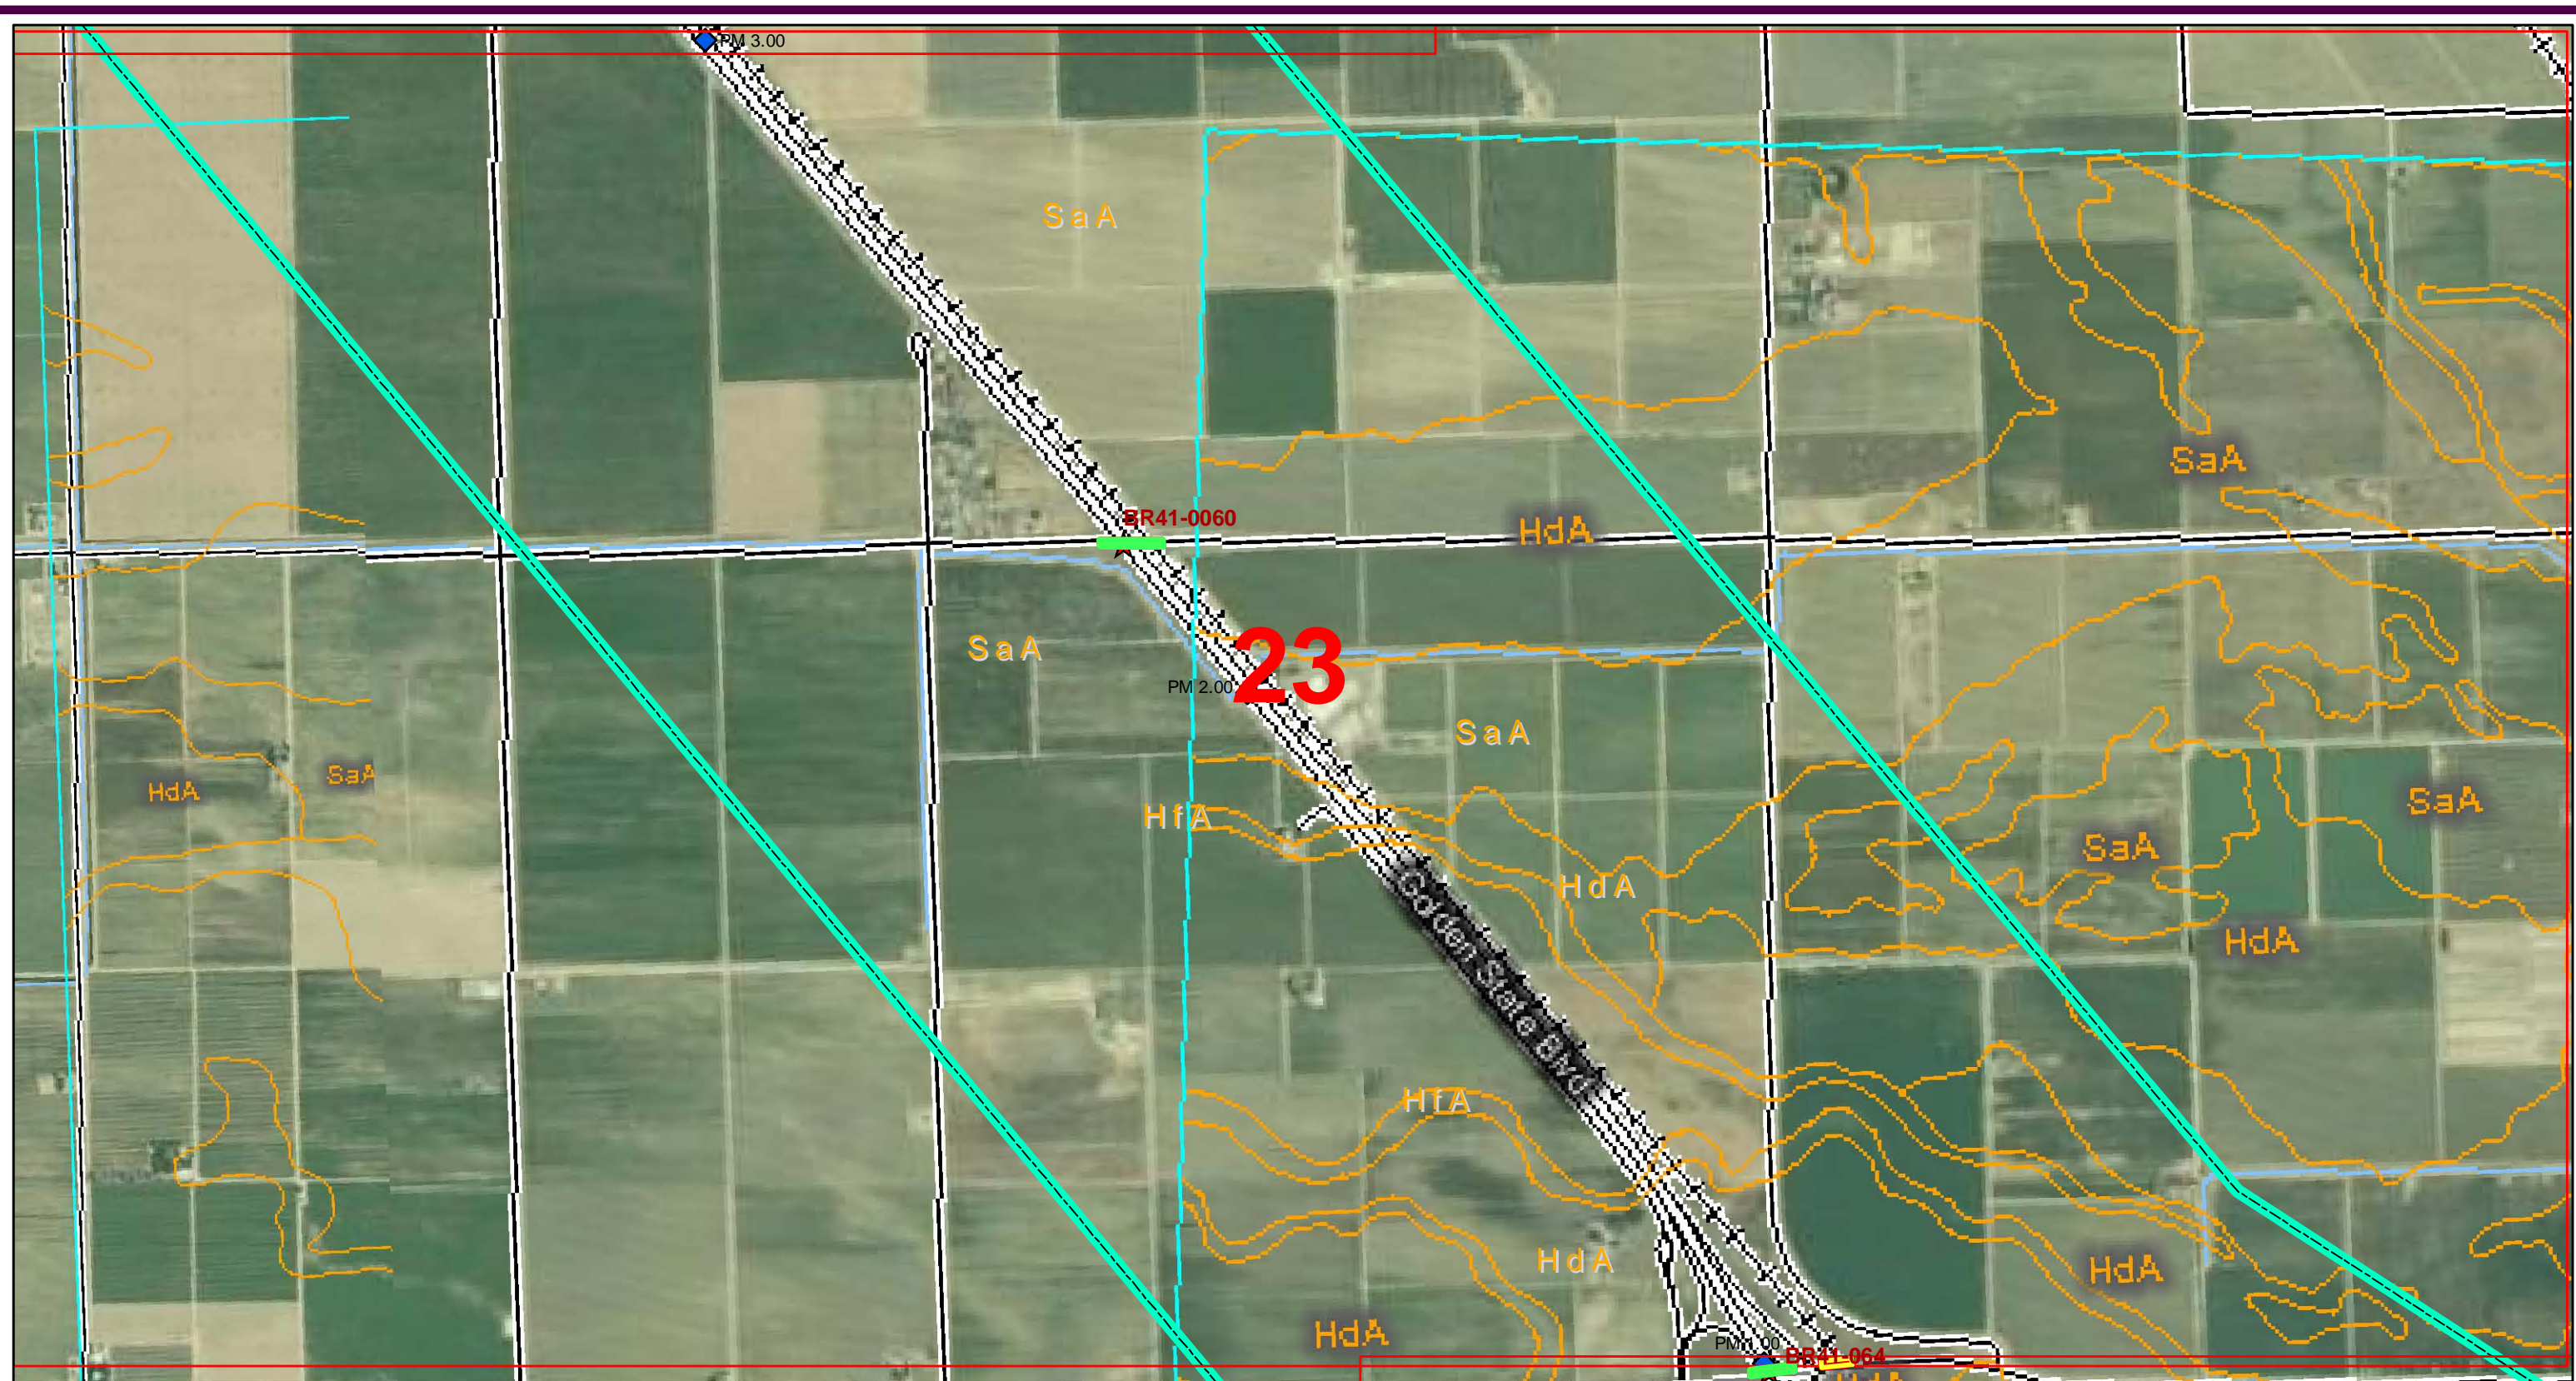

See PLATE 2-0 for Explanation

Soils Map and Site Plan



**PARIKH CONSULTANTS, INC.**  
**GEOTECHNICAL CONSULTANTS**  
**MATERIALS TESTING**

**SOURCES:**  
 geology from Marchand and Allwardt; 1981; USGS  
 soils units from NRCS  
 bridges from Caltrans  
 tank leak sites from GeoTracker website

California High-Speed Train Project  
 (Merced - Fresno Section)


JOB NO.: 209138.10

PLATE NO.: 2-23







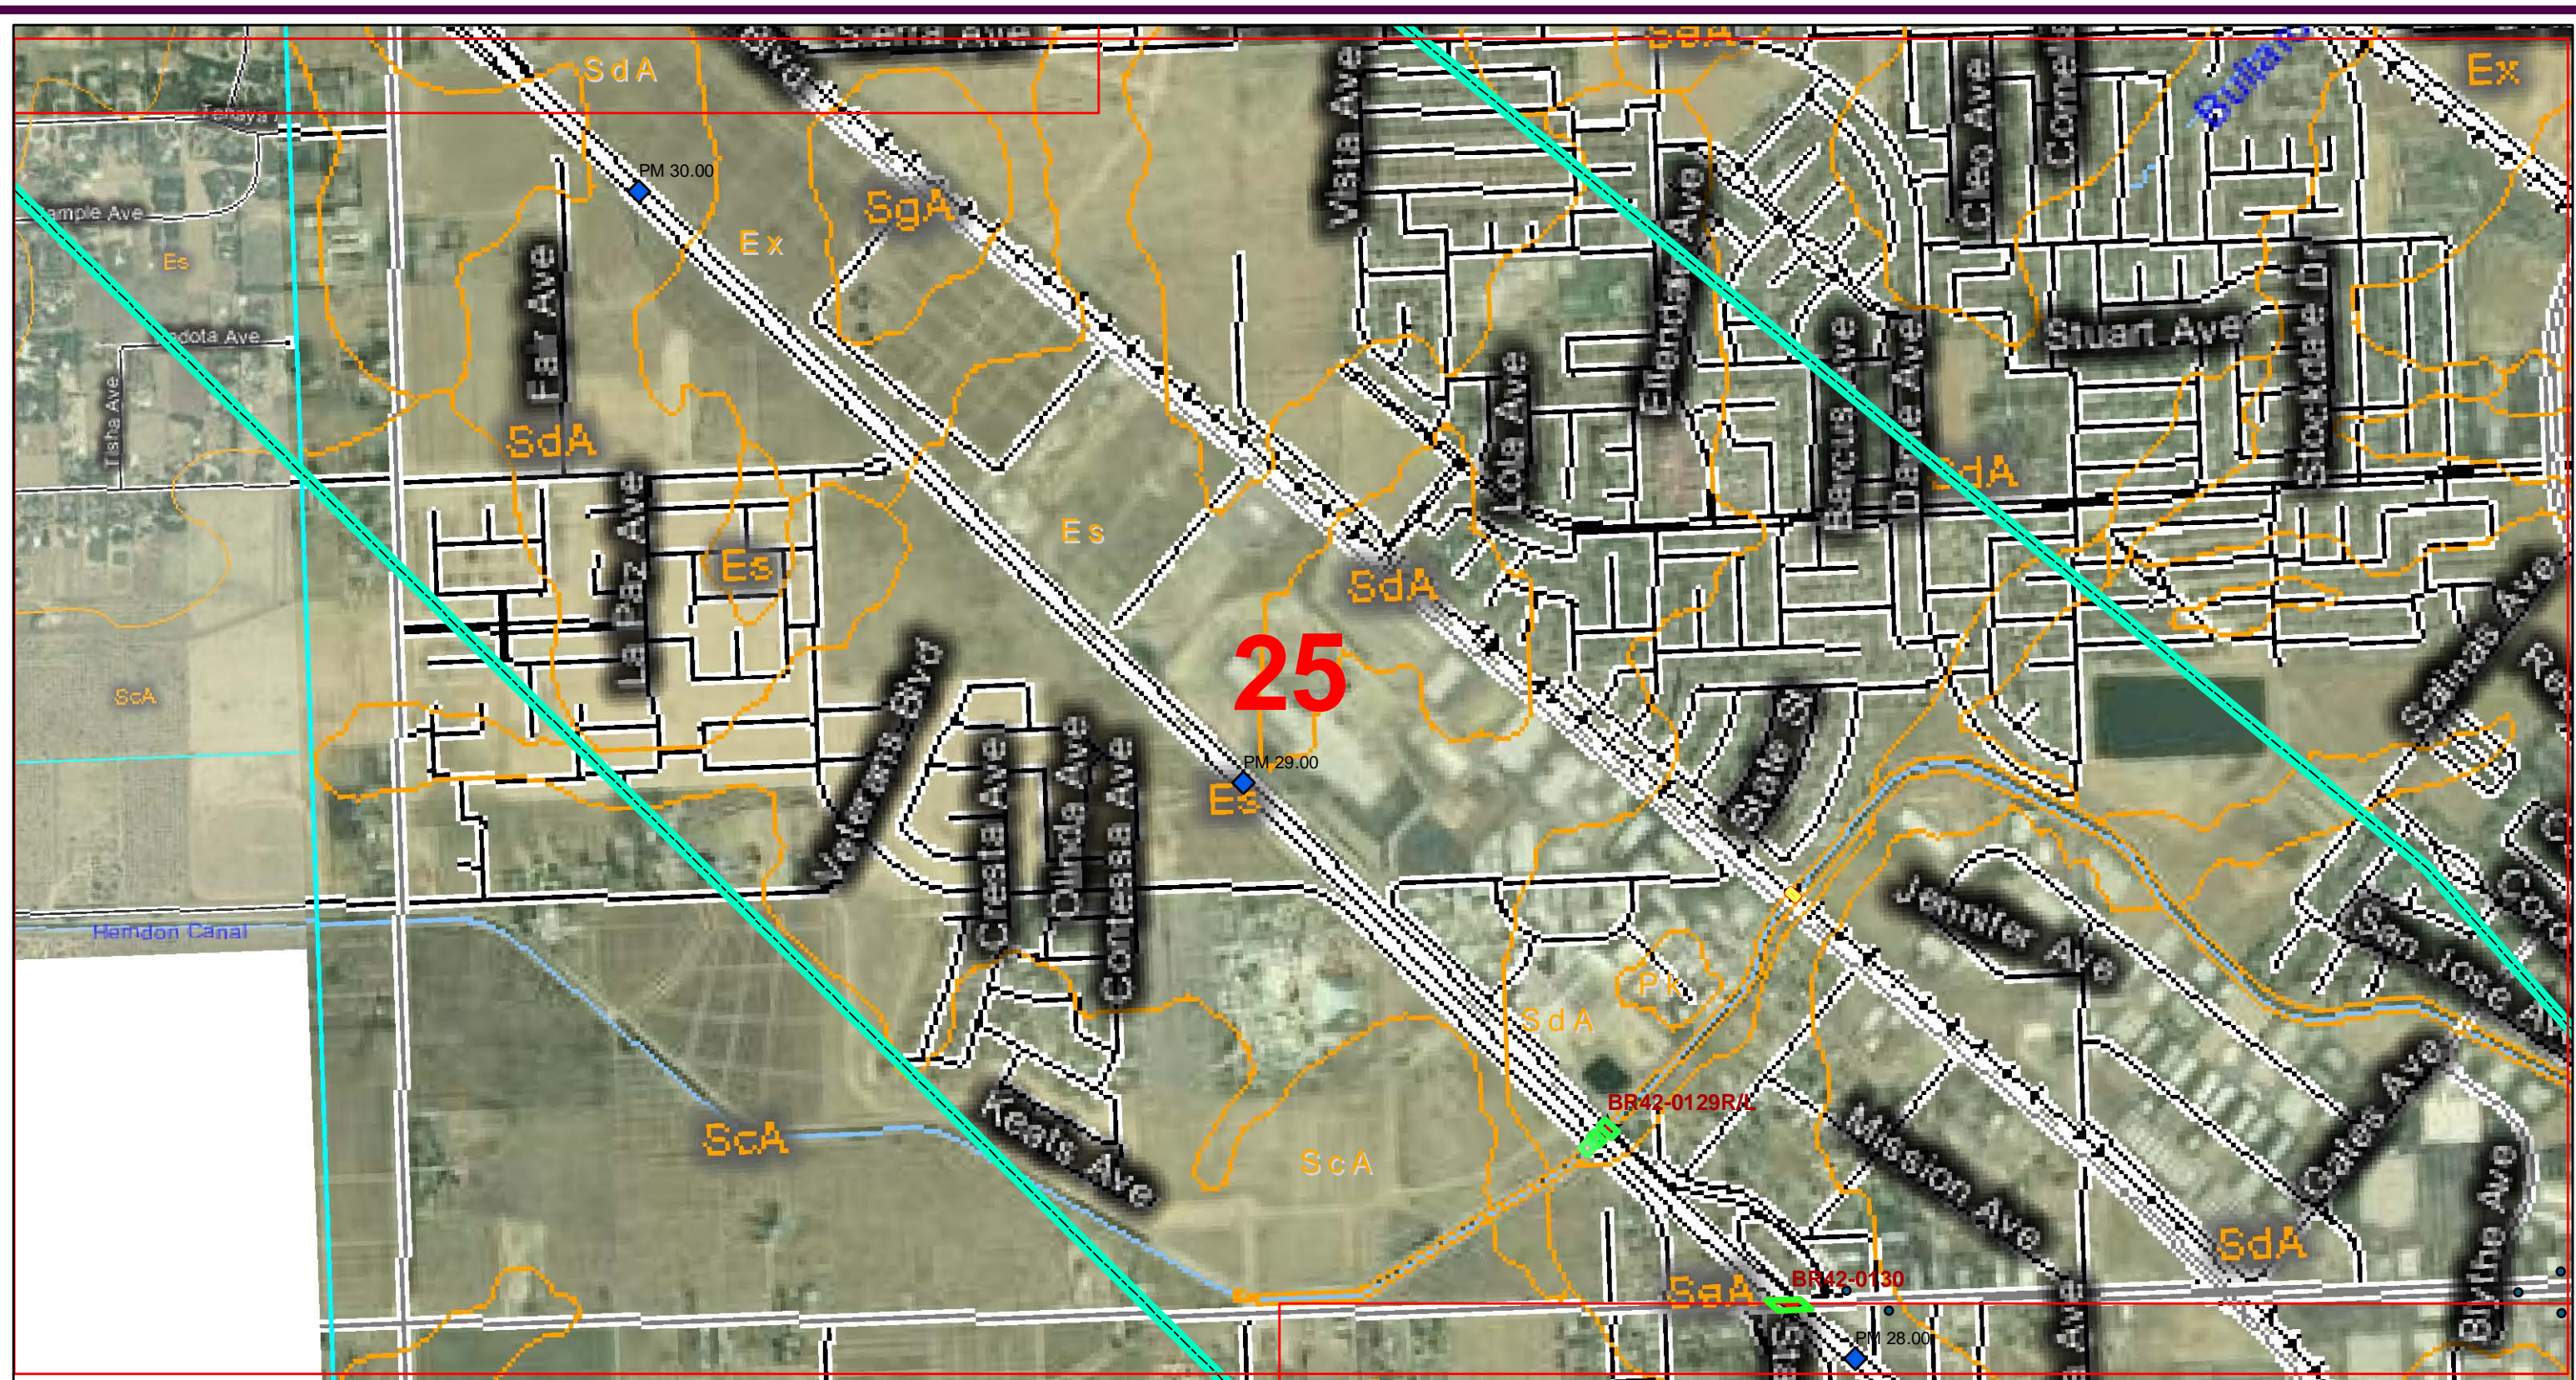

0 510 1,020 1,530 2,040 2,550 3,060  
Feet

See PLATE 2-0 for Explanation

Soils Map and Site Plan



**PARIKH CONSULTANTS, INC.**  
**GEOTECHNICAL CONSULTANTS**  
**MATERIALS TESTING**



SOURCES:  
geology from Marchand and Allwardt; 1981; USGS  
soils units from NRCS  
bridges from Caltrans  
tank leak sites from GeoTracker website

California High-Speed Train Project  
(Merced - Fresno Section)

JOB NO.: 209138.10

PLATE NO.: 2-25



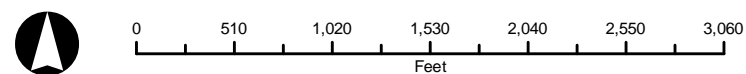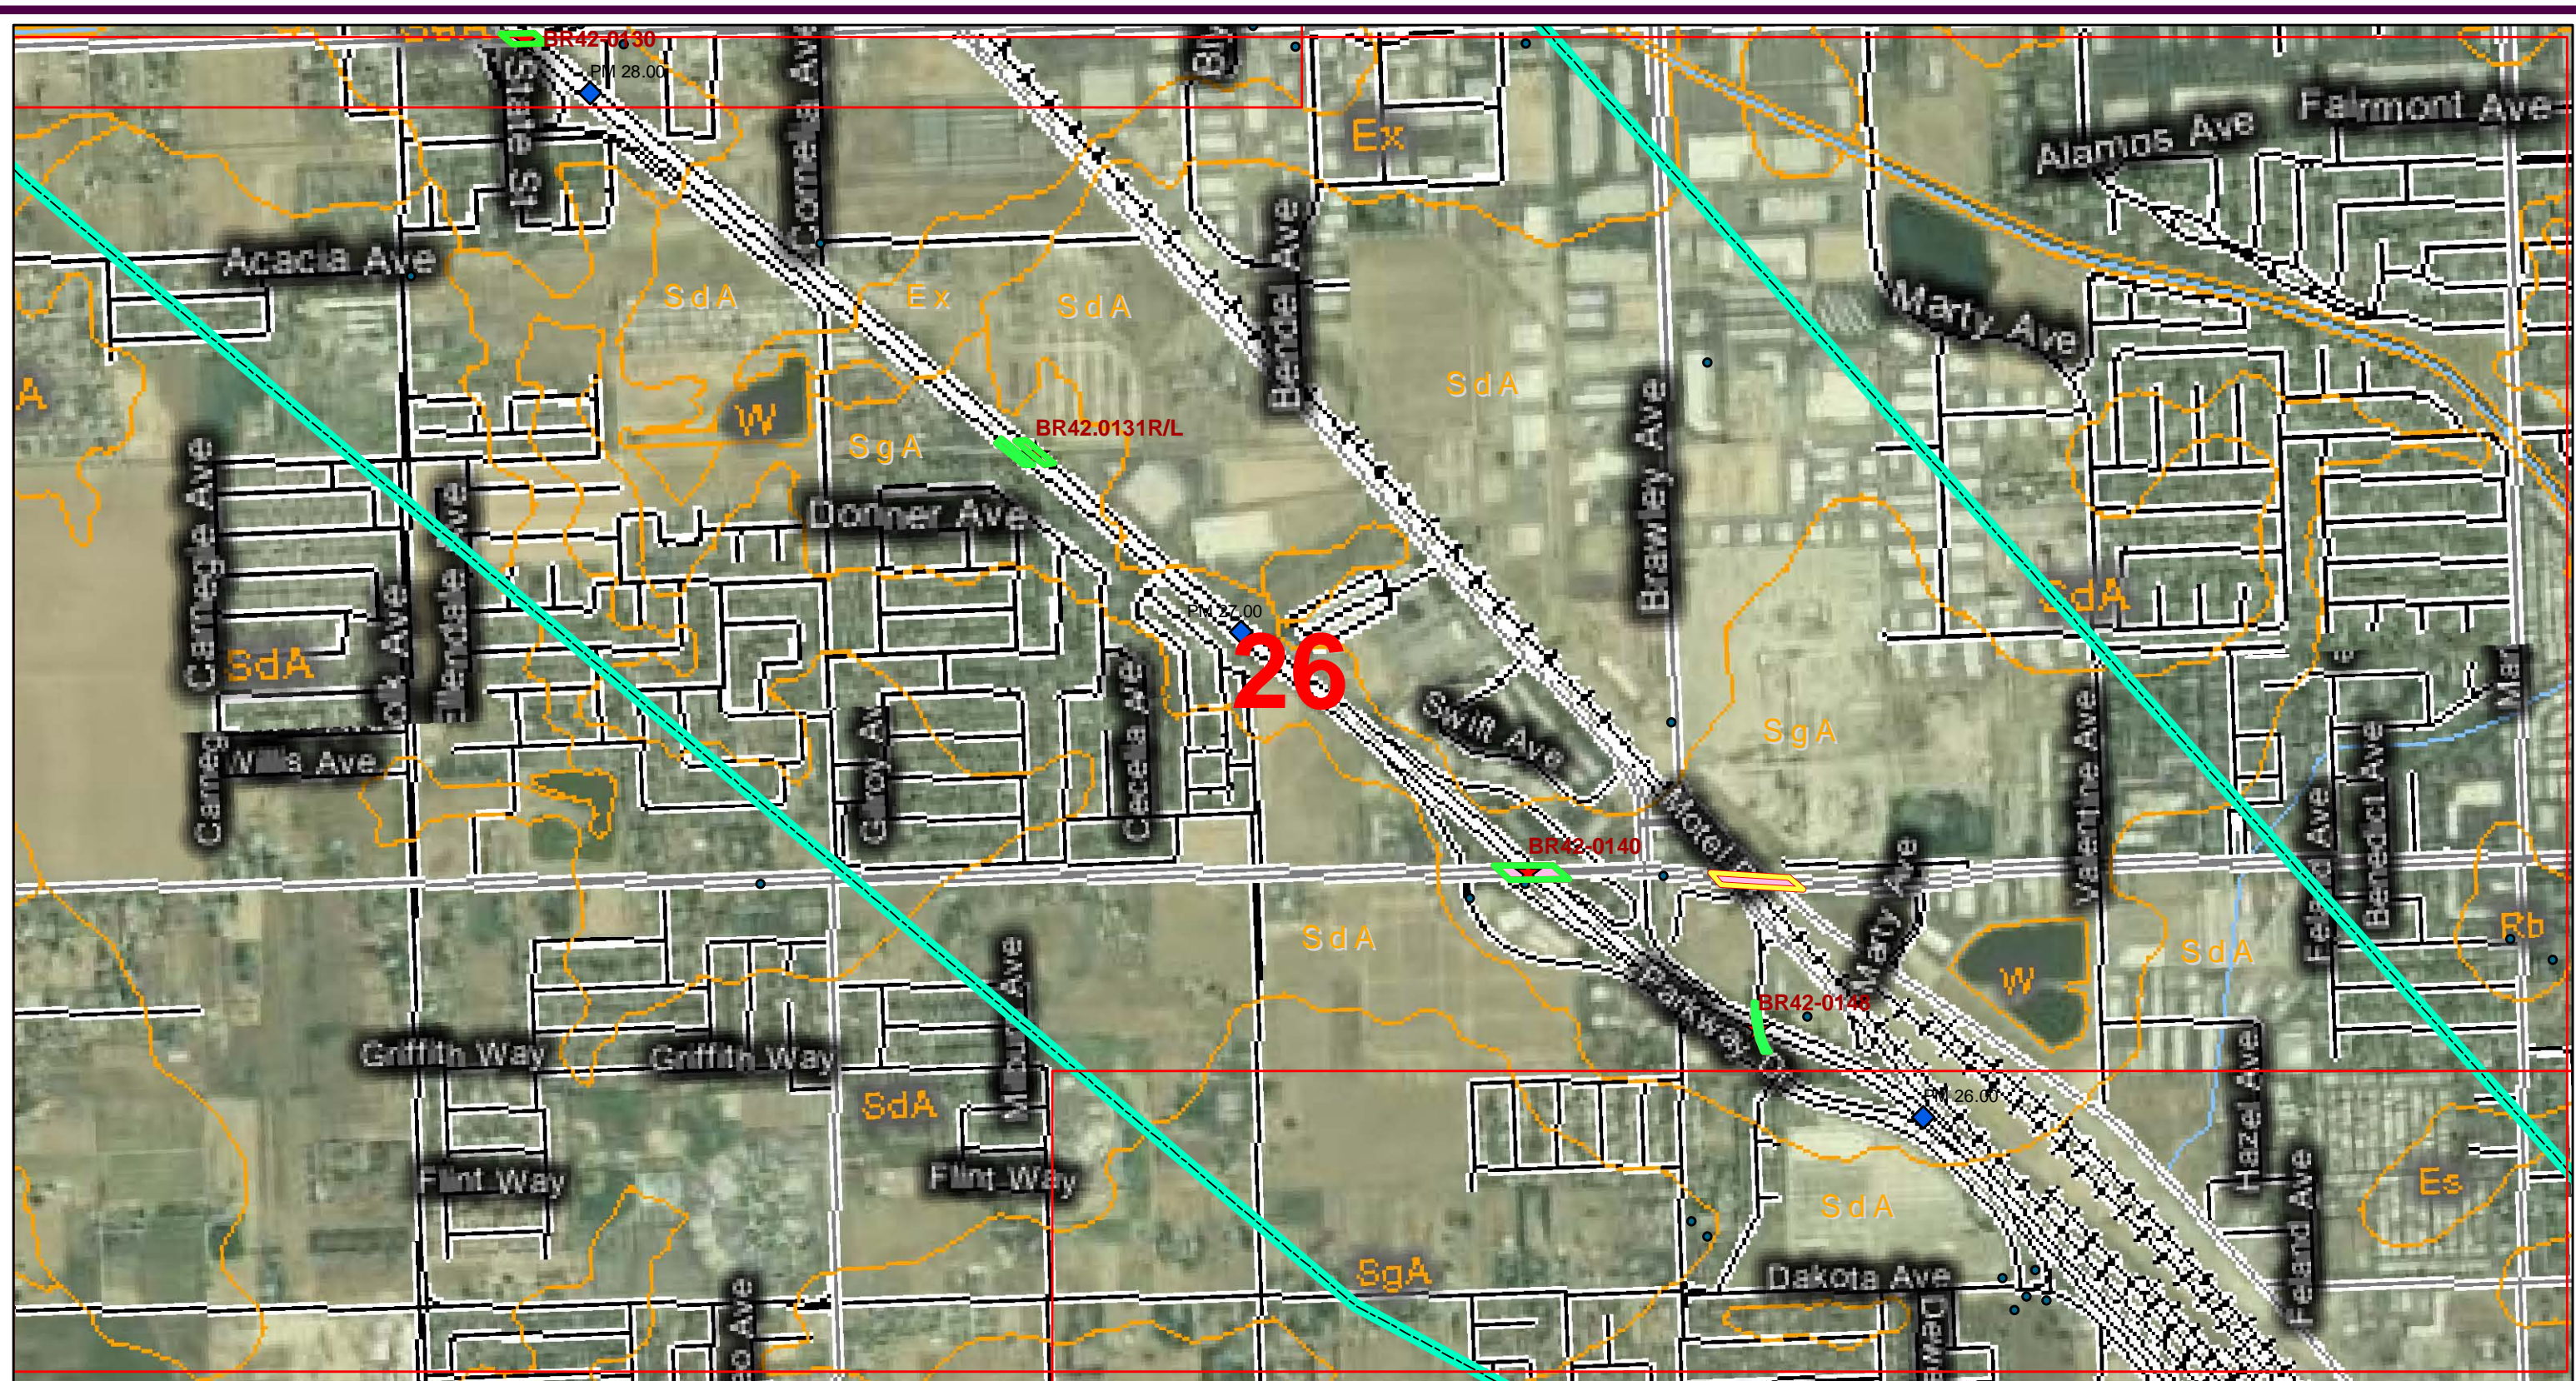

See PLATE 2-0 for Explanation

Soils Map and Site Plan



**PARIKH CONSULTANTS, INC.**  
**GEOTECHNICAL CONSULTANTS**  
**MATERIALS TESTING**



**SOURCES:**  
 geology from Marchand and Allwardt; 1981; USGS  
 soils units from NRCS  
 bridges from Caltrans  
 tank leak sites from GeoTracker website

California High-Speed Train Project  
 (Merced - Fresno Section)

JOB NO.: 209138.10

PLATE NO.: 2-26



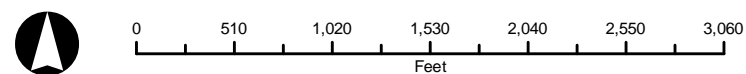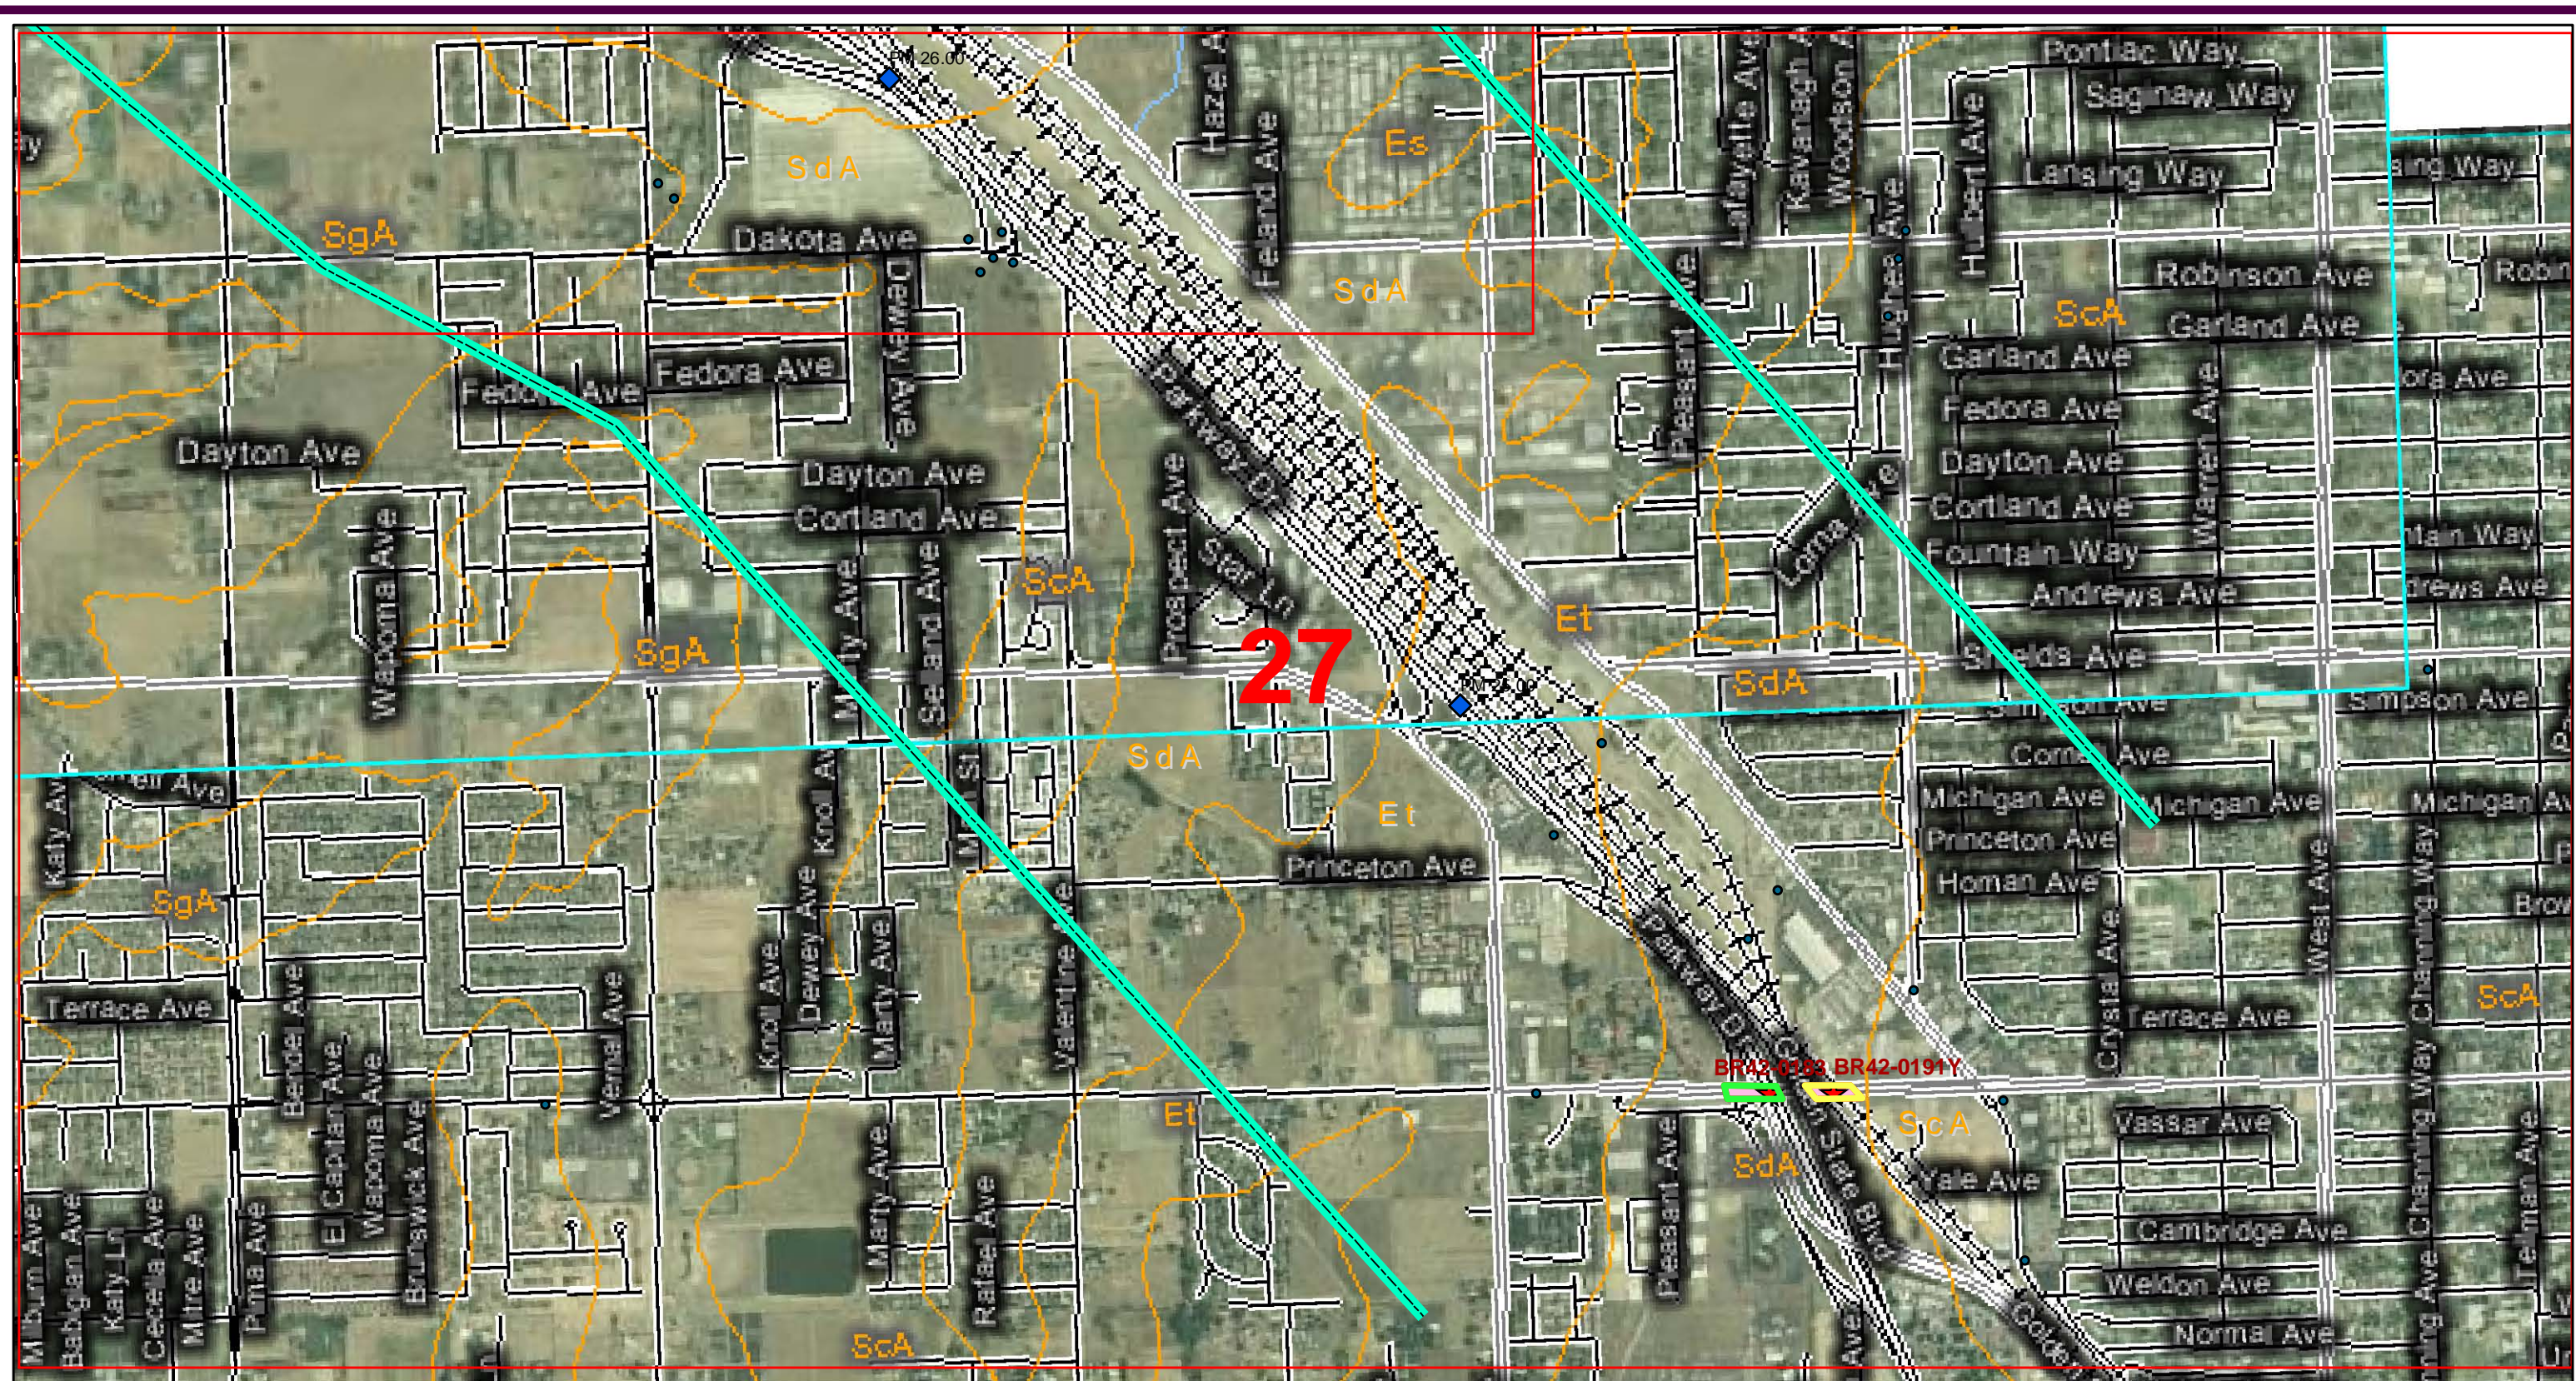

See PLATE 2-0 for Explanation

Soils Map and Site Plan

**PARIKH CONSULTANTS, INC.**  
**GEOTECHNICAL CONSULTANTS**  
**MATERIALS TESTING**


SOURCES:  
 geology from Marchand and Allwardt; 1981; USGS  
 soils units from NRCS  
 bridges from Caltrans  
 tank leak sites from GeoTracker website

California High-Speed Train Project  
 (Merced - Fresno Section)


JOB NO.: 209138.10

PLATE NO.: 2-27



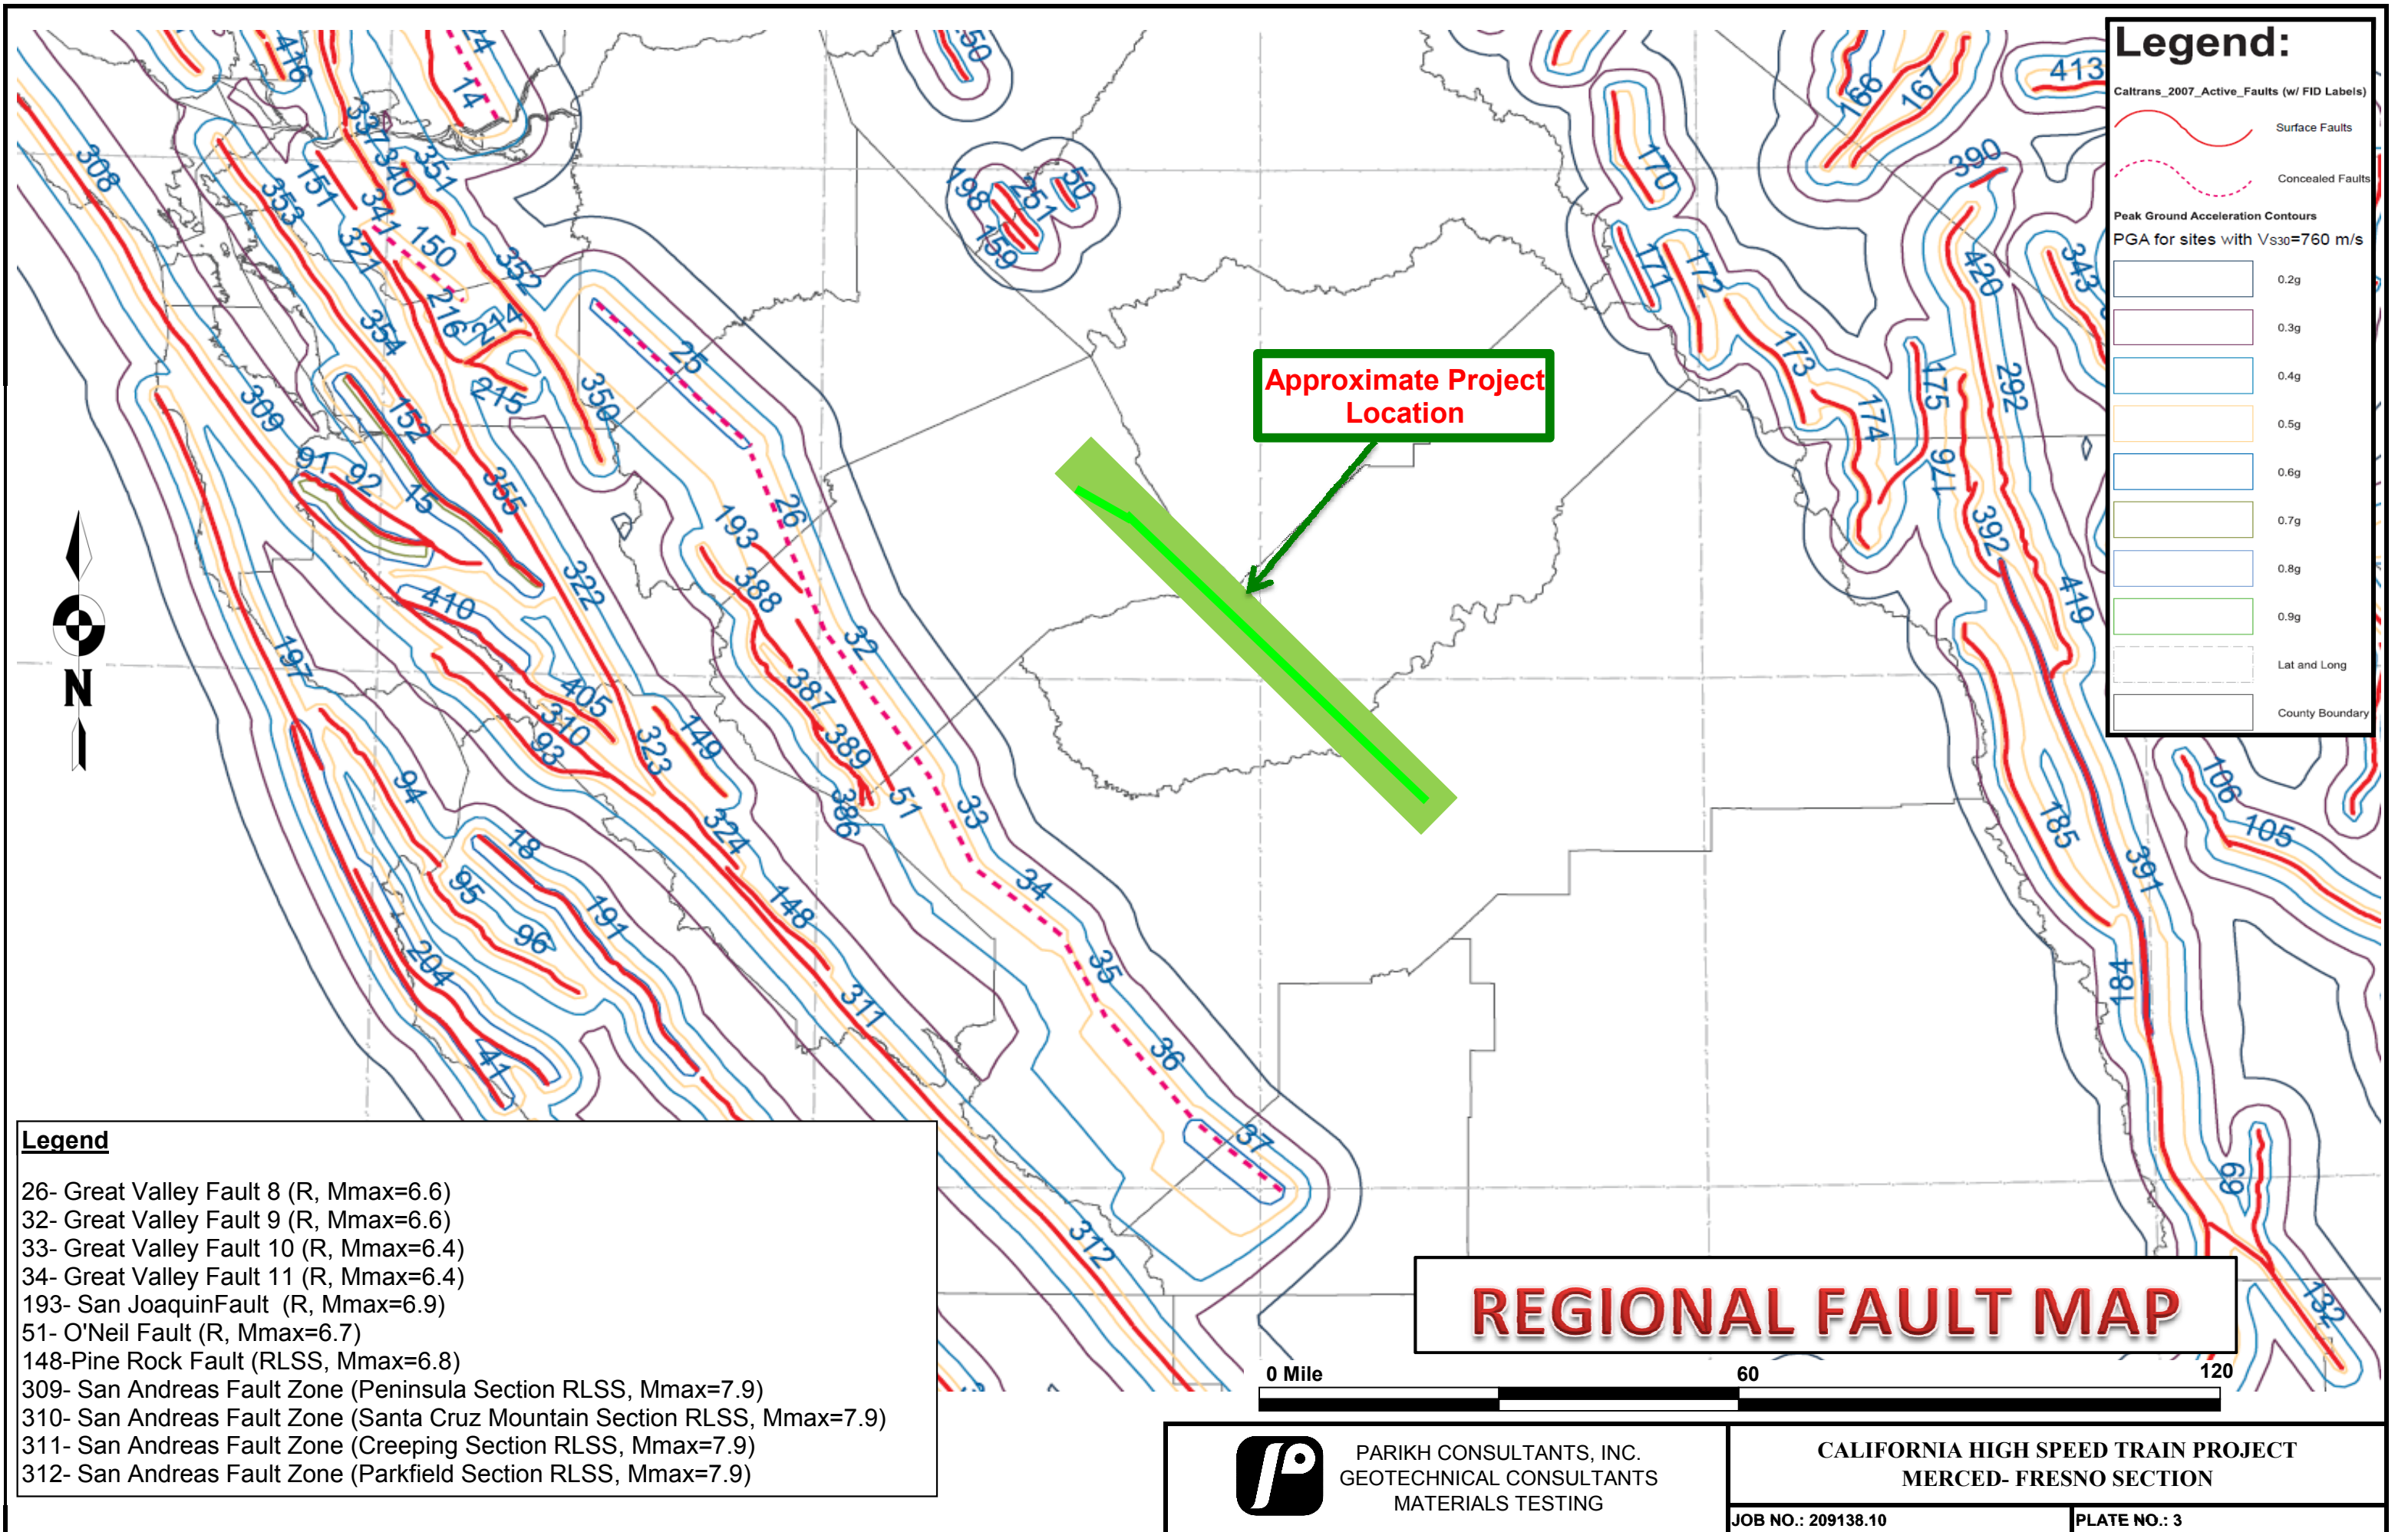



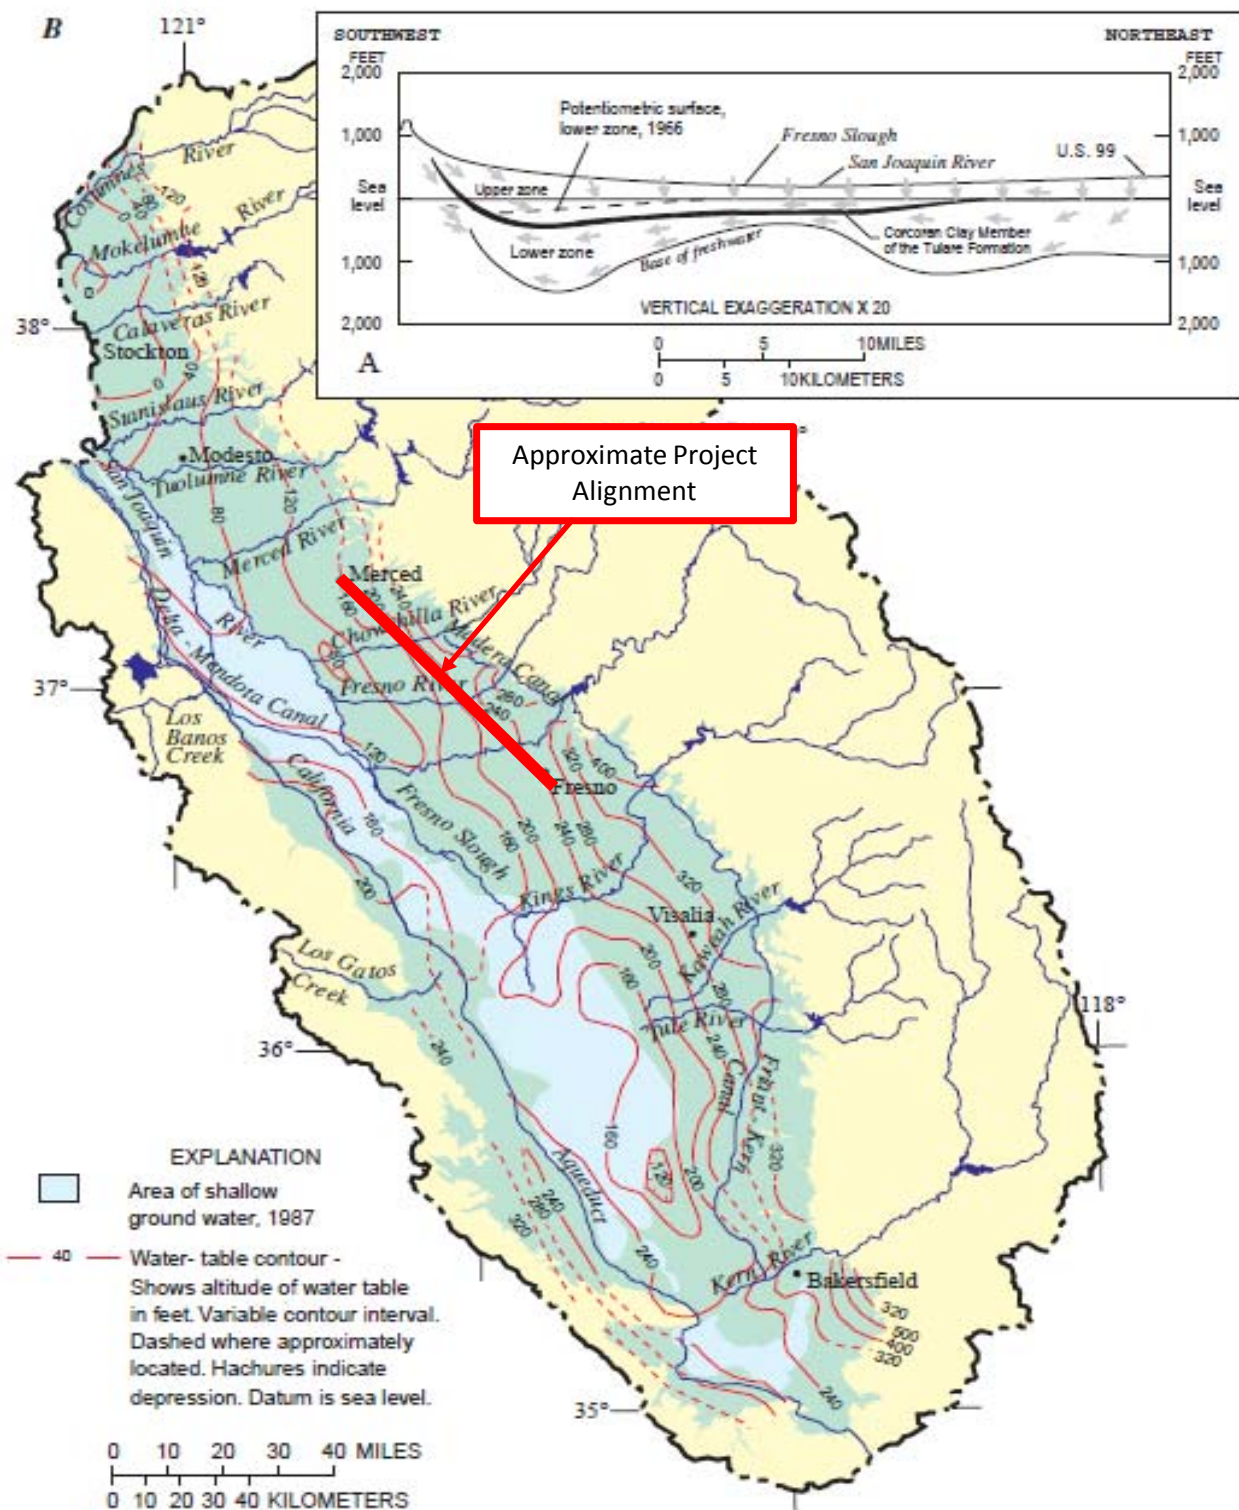

**Source:** Ground-water flow conditions in the San Joaquin Valley, California, 1966 (Bertoldi and others, 1991).  
(B) Water table in 1976 (modified from Williamson and others, 1989) and area of shallow ground water in 1987, San Joaquin Valley, California (San Joaquin Valley Drainage Program, 1990b).



PARIKH CONSULTANTS, INC.  
GEOTECHNICAL CONSULTANTS  
MATERIALS TESTING

## CALIFORNIA HIGH-SPEED TRAIN PROJECT MERCED-FRESNO SECTION

JOB NO.:209138.10

PLATE NO.: 4



Conterminous 48 States

**2005 ASCE 7 STANDARD**

Latitude = 36.71768

Longitude = -119.78458


Design Response Spectra for Site Class Site Class D

SDs =  $2/3 \times$  SMs and SD1 =  $2/3 \times$  SM1

Site Class D -  $F_a = 1.375$ ,  $F_v = 1.943$

Importance Factor,  $I = 1.25$

Period (sec)	$S_a$ (g)
0.000	0.244
0.122	0.609
0.200	0.609
0.608	0.609
0.700	0.529
0.800	0.463
0.900	0.411
1.000	0.370
1.100	0.336
1.200	0.309
1.300	0.285
1.400	0.264
1.500	0.246
1.600	0.231
1.700	0.218
1.800	0.205
1.900	0.195
2.000	0.185

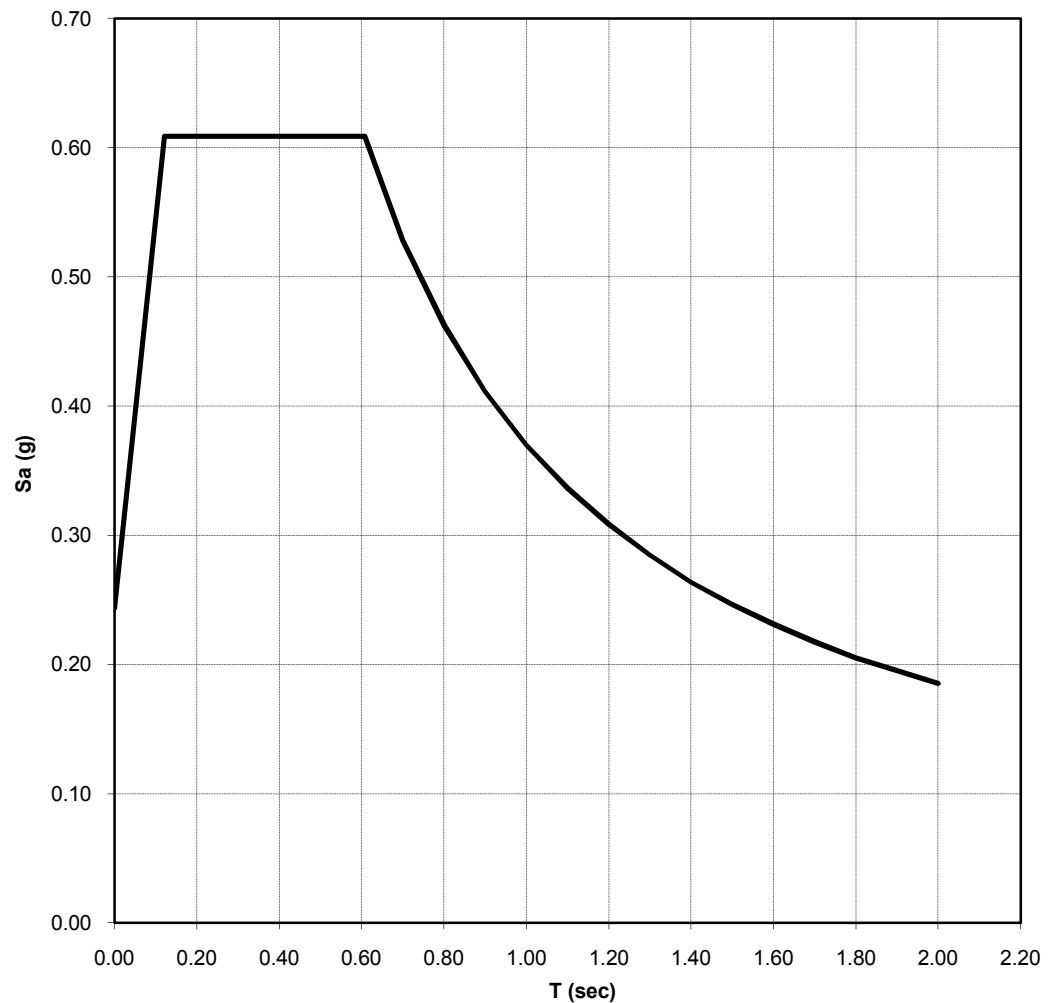

**MCE DESIGN SPECTRUM (FRESNO)**



**PARIKH CONSULTANTS, INC.**  
GEOTECHNICAL CONSULTANTS  
MATERIALS TESTING

**CALIFORNIA HIGH-SPEED TRAIN PROJECT**  
**(MERCED-FRESNO SECTION)**  
**MERCED-MADERA-FRESNO, CALIFORNIA**

**JOB NO.: 209138.10**

**PLATE NO.: 5A**



Conterminous 48 States

**2005 ASCE 7 STANDARD**

Latitude = 36.96151

Longitude = -120.06479


Design Response Spectra for Site Class Site Class D

SDs =  $2/3 \times$  SMs and SD1 =  $2/3 \times$  SM1

Site Class D -  $F_a = 1.361$ ,  $F_v = 1.943$

Importance Factor,  $I = 1.25$

Period (sec)	S <sub>a</sub> (g)
0.000	0.249
0.119	0.623
0.200	0.623
0.595	0.623
0.600	0.616
0.700	0.529
0.800	0.463
0.900	0.411
1.000	0.370
1.100	0.336
1.200	0.309
1.300	0.285
1.400	0.264
1.500	0.246
1.600	0.231
1.700	0.218
1.800	0.205
1.900	0.195

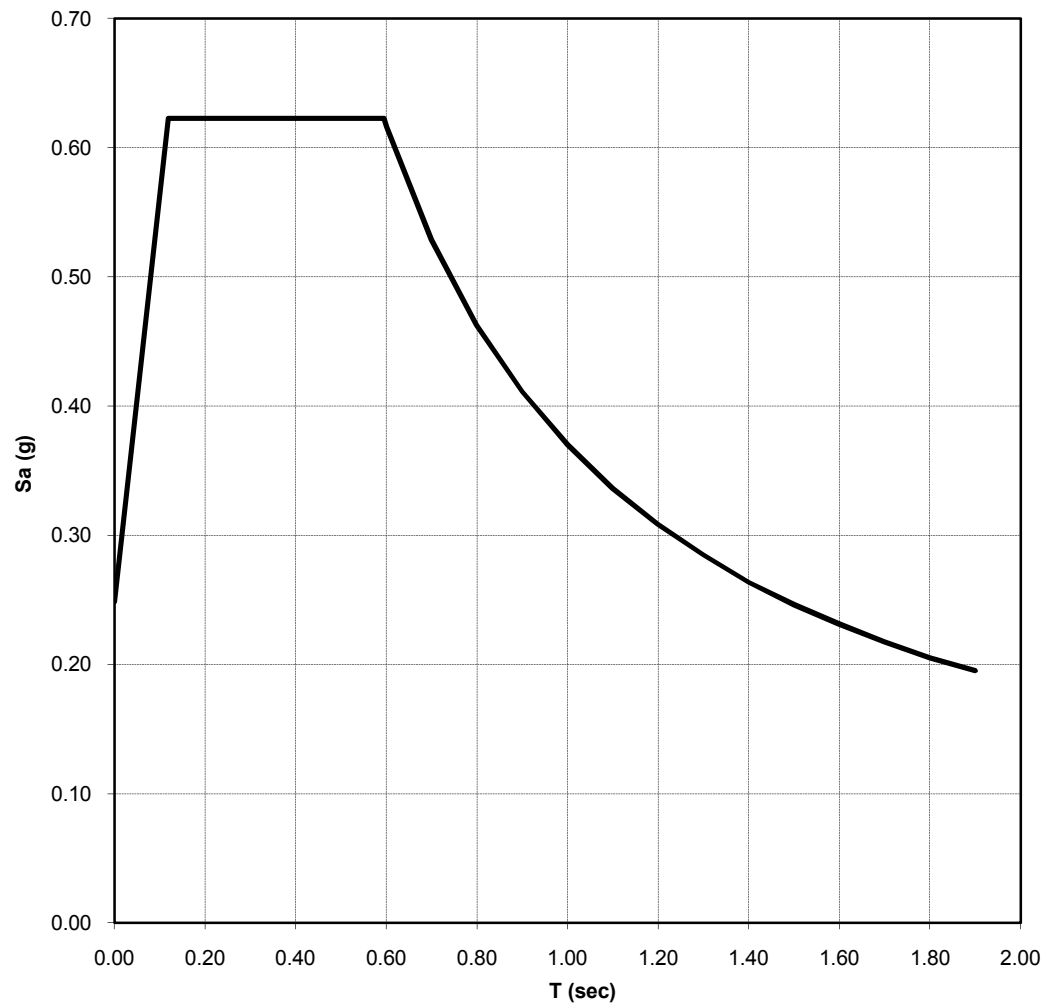

**MCE DESIGN SPECTRUM (MADERA)**



**PARIKH CONSULTANTS, INC.**  
GEOTECHNICAL CONSULTANTS  
MATERIALS TESTING

**CALIFORNIA HIGH-SPEED TRAIN PROJECT**  
**(MERCED-FRESNO SECTION)**  
**MERCED-MADERA-FRESNO, CALIFORNIA**

**JOB NO.: 209138.10**

**PLATE NO.: 5B**



Conterminous 48 States

**2005 ASCE 7 STANDARD**

Latitude = 37.12691

Longitude = -120.2523


Design Response Spectra for Site Class Site Class D

SDs =  $2/3 \times$  SMs and SD1 =  $2/3 \times$  SM1

Site Class D -  $F_a = 1.364$ ,  $F_v = 1.942$

Importance Factor,  $I = 1.25$

Period (sec)	S <sub>a</sub> (g)
0.000	0.248
0.120	0.619
0.200	0.619
0.598	0.619
0.600	0.618
0.700	0.529
0.800	0.463
0.900	0.411
1.000	0.370
1.100	0.336
1.200	0.309
1.300	0.285
1.400	0.265
1.500	0.248
1.600	0.231
1.700	0.218
1.800	0.206
1.900	0.195

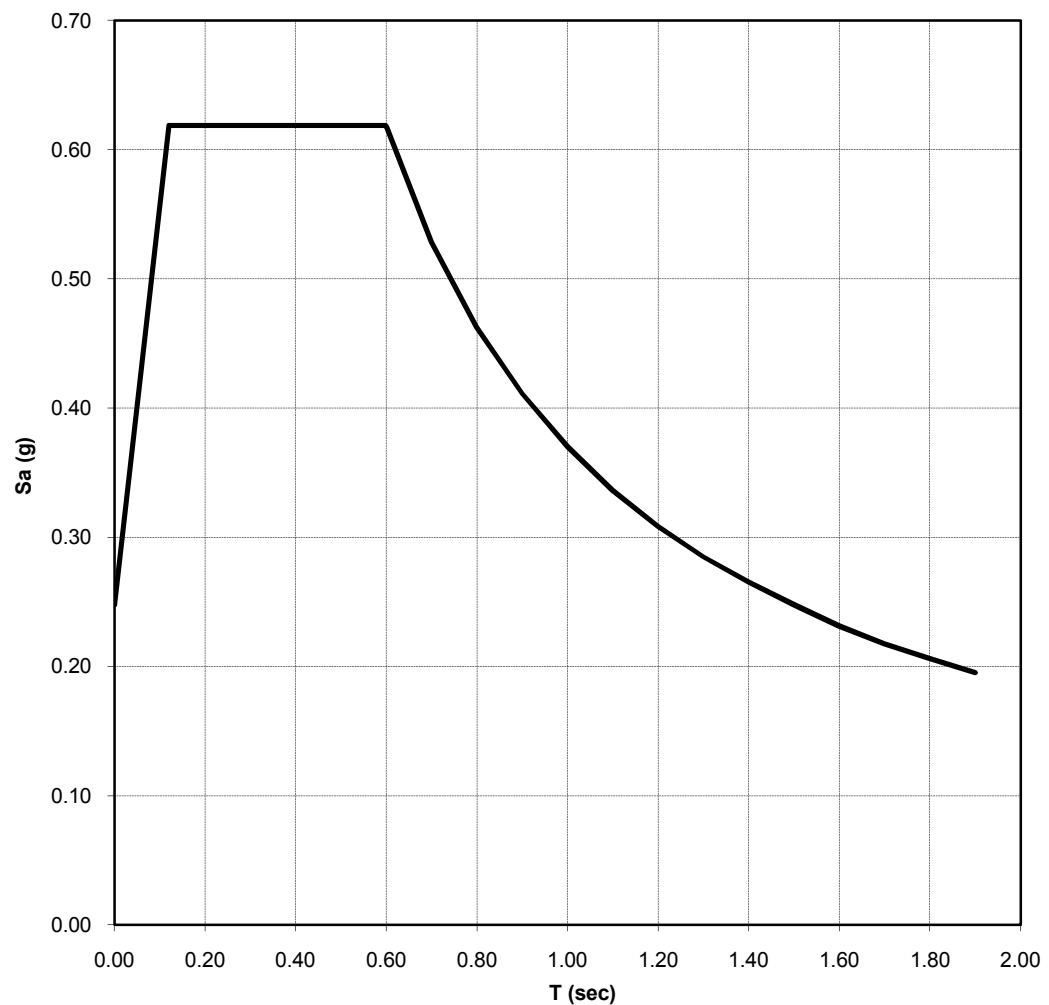

**MCE DESIGN SPECTRUM (CHOWCHILLA)**



**PARIKH CONSULTANTS, INC.**  
GEOTECHNICAL CONSULTANTS  
MATERIALS TESTING

**CALIFORNIA HIGH-SPEED TRAIN PROJECT**  
**(MERCED-FRESNO SECTION)**  
**MERCED-MADERA-FRESNO, CALIFORNIA**

**JOB NO.: 209138.10**

**PLATE NO.: 5C**



Conterminous 48 States

**2005 ASCE 7 STANDARD**

Latitude = 37.29573

Longitude = -120.47280


Design Response Spectra for Site Class Site Class D

SDs =  $2/3 \times$  SMs and SD1 =  $2/3 \times$  SM1

Site Class D -  $F_a = 1.358$ ,  $F_v = 1.931$

Importance Factor,  $I = 1.25$

Period (sec)	$S_a$ (g)
0.000	0.250
0.121	0.625
0.200	0.625
0.603	0.625
0.700	0.539
0.800	0.471
0.900	0.419
1.000	0.378
1.100	0.343
1.200	0.315
1.300	0.290
1.400	0.270
1.500	0.251
1.600	0.236
1.700	0.223
1.800	0.210
1.900	0.199
2.000	0.189

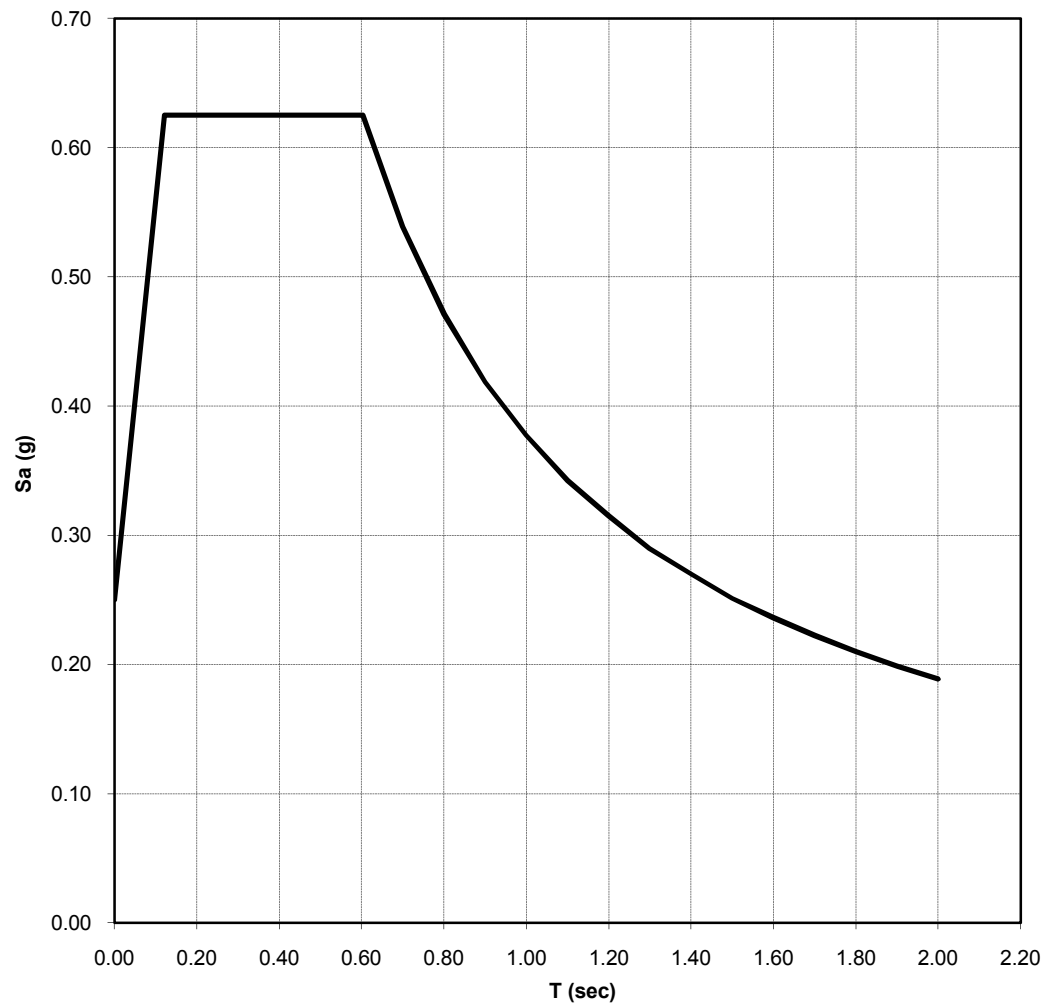

**MCE DESIGN SPECTRUM (MERCED)**



**PARIKH CONSULTANTS, INC.**  
GEOTECHNICAL CONSULTANTS  
MATERIALS TESTING

**CALIFORNIA HIGH-SPEED TRAIN PROJECT**  
**(MERCED-FRESNO SECTION)**  
**MERCED-MADERA-FRESNO, CALIFORNIA**

**JOB NO.: 209138.10**

**PLATE NO.: 5D**



## **APPENDIX A**



## Bridge and Reference Project List

No	Bridge No	Structure Name	P.M	County	LOTB	Type of Foundation
1	42 0183	Clinton Avenue OC	_024.42	Fresno	Yes	
2	42 0191Y	Fresno Yard OC	_024.42	Fresno	Yes	
3	42 0148	SB 99 On-Ramp By Dakota	_026.22	Fresno	Yes	
4	42 0140	Ashlan Avenue OC	_026.55	Fresno	Yes	
5	42 0131L	Biola Junction	_027.31	Fresno	Yes	
6	42 0131R	Biola Junction	_027.31	Fresno	Yes	
7	42 0130	Shaw Avenue OC	_028.10	Fresno	Yes	
8	42 0129L	Herndon Canal	_028.40	Fresno	Yes	
9	42 0129R	Herndon Canal	_028.40	Fresno	Yes	
10	42 0127L	Grantland Avenue UC	_030.48	Fresno	Yes	
11	42 0127R	Grantland Avenue UC	_030.48	Fresno	Yes	
12	42 0126K	Herndon Canal	_030.99	Fresno	Yes	
13	42 0126K	Herndon Canal	_030.99	Fresno	Yes	
14	41 0008	San Joaquin River	_000.08	Madera	Yes	
15	41 0064	Avenue 7 OC	R000.99	Madera	Yes	
16	41 0060	Avenue 8 OC	_002.23	Madera	Yes	
17	41 0063	Avenue 9 OC	R003.56	Madera	Yes	
18	41 0035	Little Dry Creek	_005.88	Madera	No	
19	41 0061	Avenue 11 OC	_006.15	Madera	Yes	
20	41 0065L	Cottonwood Creek	R007.28	Madera	Yes	
21	41 0065R	Cottonwood Creek	R007.28	Madera	Yes	
22	41 0065S	Cottonwood Creek	R007.28	Madera	No	
23	41 0066	Avenue 12 OC	R007.46	Madera	Yes	
24	41 0062	Avenue 13 OC	_008.72	Madera	No	
25	41 0046K	South Madera OC	_009.74	Madera	Yes	
26	41 0046K	South Madera OC	_009.74	Madera	Yes	
27	41 0047	Route 145/99 Separation	_010.27	Madera	Yes	
28	41 0048	West sixth Street OC	_010.76	Madera	No	
29	41 0049	West Yosemite Avenue	_010.84	Madera	Yes	
30	41 0050	West Fourth Street OC	_011.01	Madera	Yes	
31	41 0051	Madera UP	_011.09	Madera	Yes	
32	41 0052	Fresno River	_011.65	Madera	Yes	
33	T0603900177	GEO TRACKER ID	_11.80	Madera	Yes	
34	41 0053	Cleveland Avenue OC	_012.13	Madera	Yes	
35	41 0058	Avenue 16 OC	_012.75	Madera	Yes	
36	41 0068	Avenue 17 OC	R014.22	Madera	Yes	
37	41 0072	Schmidt Creek	R014.60	Madera	No	
38	41 0005L	Dry Creek	R016.10	Madera	Yes	
39	41 0005R	Dry Creek	R016.10	Madera	Yes	
40	41 0069	Avenue 18 1/2 OC	R016.33	Madera	Yes	
41	41 0004	Beranda Creek	_017.85	Madera	Yes	
42	41 0043G	N99-W152 Connector Sep	_022.73	Madera	Yes	
43	41 0043G	N99-W152 Connector Sep	_022.73	Madera	Yes	
44	41 0014L	California OH	_023.09	Madera	Yes	
45	41 0014R	California UP	_023.09	Madera	Yes	



## Bridge and Reference Project List

No	Bridge No	Structure Name	P.M	County	LOTB	Type of Foundation
46	41 0054	Avenue 24 OC	_023.77	Madera	Yes	
47	41 0044L	Beranda Slough	_024.78	Madera	Yes	
48	41 0044R	Beranda Slough	_024.78	Madera	Yes	
49	SL0603935695	GEO TRACKER ID	_26.40	Madera	Yes	
50	41 0055E	N99 & 233 Connector	_026.58	Madera	Yes	
51	41 0045L	Ash Slough	_026.80	Madera	Yes	
52	41 0045R	Ash Slough	_026.80	Madera	Yes	
53	41 0057	Le Grand Avenue OC	_028.17	Madera	Yes	
54	41 0001	Chowchilla River	_029.33	Madera	Yes	
55	39 0108L	South Dutchman Creek	_001.65	Merced	Yes	
56	39 0108R	South Dutchman Creek	_001.65	Merced	Yes	
57	39 0001L	Dutchman Creek	_002.62	Merced	Yes	
58	39 0001R	Dutchman Creek	_002.62	Merced	Yes	
59	39 0002L	Deadmans Creek	_005.22	Merced	Yes	
60	39 0002R	Deadmans Creek	_005.22	Merced	Yes	
61	39 0081	Mariposa Creek	_009.35	Merced	Yes	
62	39 0004	Duck Slough	_009.43	Merced	Yes	
63	39 0005	Duck Slough Overflow	_009.86	Merced	Yes	
64	39 0006	Owens Creek	_010.55	Merced	Yes	
65	39 0006L	Owens Creek	_010.55	Merced	Yes	
66	39 0006R	Owens Creek	_010.55	Merced	Yes	
67	39 0007	Miles Creek	_010.83	Merced	Yes	
68	39 0007L	Miles Creek	_010.83	Merced	Yes	
69	39 0057	Miles Creek Overflow	_010.98	Merced	Yes	
70	39 0057L	Miles Creek Overflow	_010.98	Merced	Yes	
71	39 0229L	Miles Creek Overflow	_011.41	Merced	Yes	
72	39 0229R	Miles Creek Overflow	_011.41	Merced	Yes	
73	39 0249R/L	CAMPUS PARKWAY OH	_012.50	Merced	Yes	
74	39 0143	Childs Avenue OC	_013.09	Merced	Yes	
75	T0604713690	GEO TRACKER ID	_13.20	Merced	Yes	
76	39 0140L	Route 99/140 Separation	_013.86	Merced	Yes	
77	39 0140R	Route 99/140 Separation	_013.86	Merced	Yes	
78	39 0141S	Yosemite Parkway ON-RA	_013.90	Merced	Yes	
79	39 0130L	East Merced OH	_014.08	Merced	Yes	
80	39 0130R	East Merced OH	_014.08	Merced	Yes	
81	39 0139L	15th Street UC	_014.22	Merced	Yes	
82	39 0139R	15th Street UC	_014.22	Merced	Yes	
83	39 0142L	G Street UC	_014.42	Merced	Yes	
84	39 0142R	G Street UC	_014.42	Merced	Yes	
85	39 0136L	Route 99/59 Separation	_014.67	Merced	Yes	
86	39 0136R	Route 99/59 Separation	_014.77	Merced	Yes	
87	39 0133L	L Street UC	_014.87	Merced	Yes	
88	39 0133R	L Street UC	_014.87	Merced	Yes	
89	39 0134L	M Street UC	_014.96	Merced	Yes	
90	39 0134R	M Street UC	_014.96	Merced	Yes	



## Bridge and Reference Project List

No	Bridge No	Structure Name	P.M	County	LOTB	Type of Foundation
91	39 0135L	O Street UC	_015.15	Merced	Yes	
92	39 0135R	O Street UC	_015.15	Merced	Yes	
93	39 0137L	R Street UC	_015.42	Merced	Yes	
94	39 0137R	R Street UC	_015.42	Merced	Yes	
95		HWY99/APPLEGATE INTERCHANGE	_15.60	Merced	Yes	
96	39 0138L	Route 99/140 Separation	_015.78	Merced	Yes	
97	39 0138R	Route 99/140 Separation	_015.78	Merced	Yes	
98	39 0132R	Bear Creek	_016.38	Merced	Yes	
99	39 132R/L	Bear Creek	_016.38	Merced	Yes	
100	39 0131L	West Merced Overhead	_016.54	Merced	Yes	
101	39 0131R	West Merced Overhead	_016.54	Merced	Yes	
102	39 0010L	Black Rascal Canal	_017.30	Merced	Yes	
103	39 0010R	Black Rascal Canal	_017.30	Merced	Yes	
104	39 0084	Franklin Road OC	_018.51	Merced	Yes	
105	39 0116L	Ashe Drain	_018.59	Merced	No	
106	39 0116R	Ashe Drain	_018.59	Merced	No	
107	39 0018L	Webber Canal	_019.49	Merced	No	
108	39 0018R	Webber Canal	_019.49	Merced	No	
109	39 0013L	Canal Creek	_020.07	Merced	No	
110	39 0013R	Canal Creek	_020.07	Merced	No	




U-0194(1)


DATE	STATE	PROJECT NO.	SHEET NO.	TOTAL SHEETS
2	CAL.		164	167

DATE: April 26, 1958  
BY: [Signature]  
CHECKED BY: [Signature]

BRIDGE DEPARTMENT

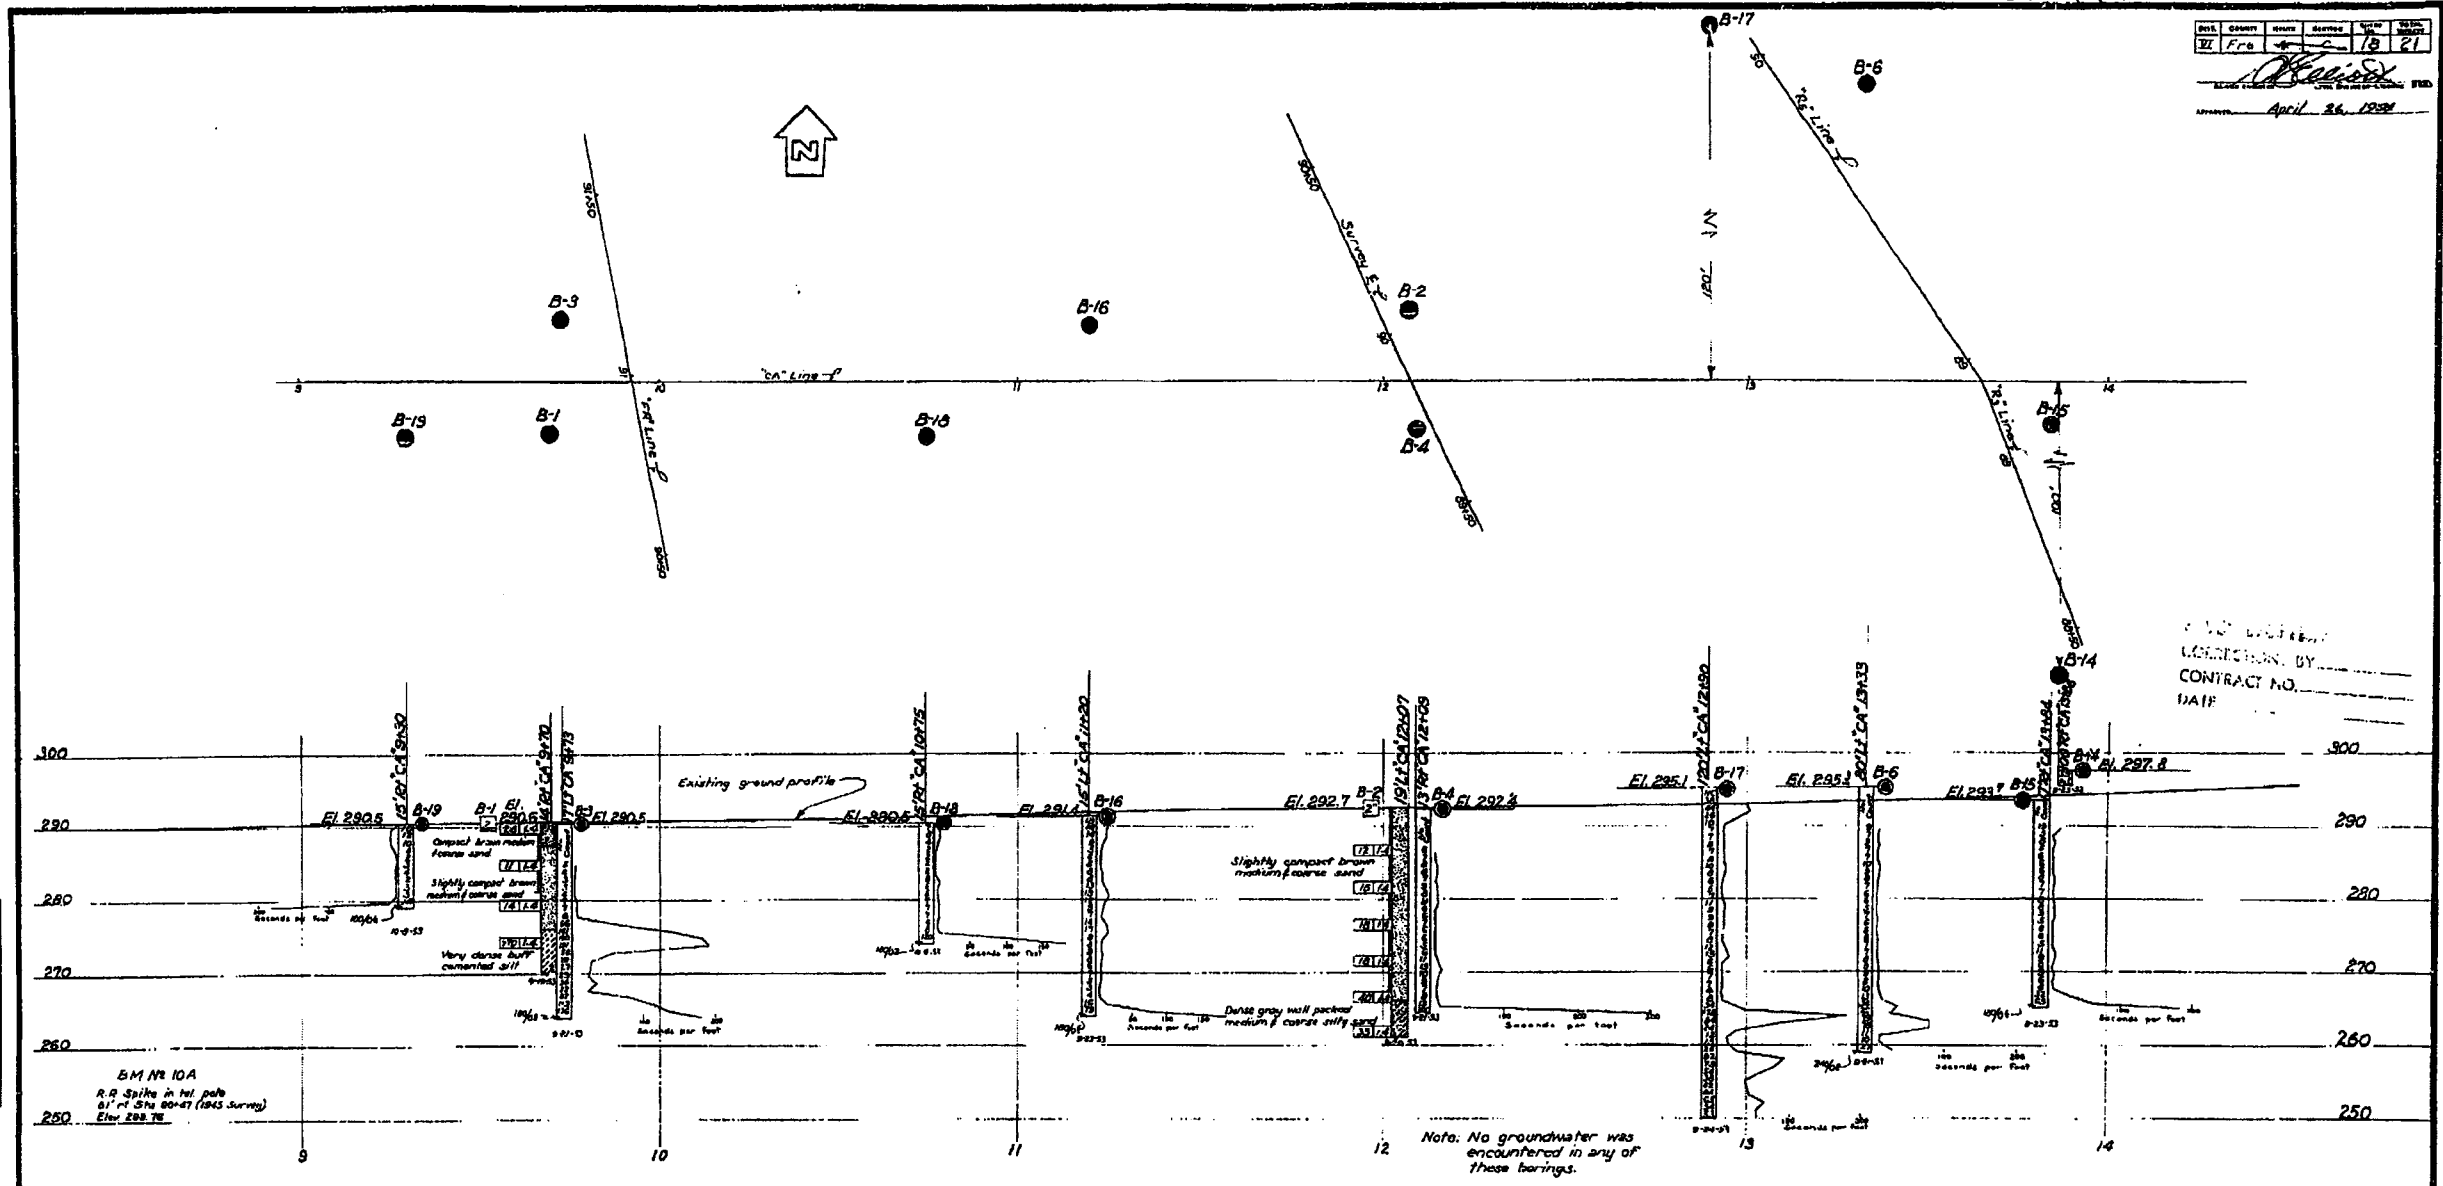


FIELD BY: [Signature]	DATE: 4/26/58
DRAWN BY: [Signature]	DATE: 4/26/58
CHECKED BY: [Signature]	DATE: 4/26/58

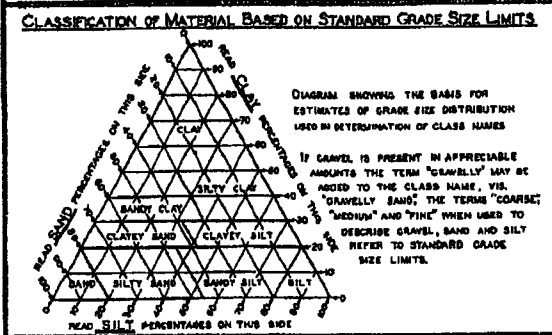

LEGEND OF EARTH MATERIALS	
[Symbol]	GRAVEL
[Symbol]	SAND
[Symbol]	SILT
[Symbol]	CLAY
[Symbol]	SANDY CLAY OR CLAYEY SAND
[Symbol]	SANDY SILT OR SILTY SAND
[Symbol]	SILTY CLAY OR CLAYEY SILT
[Symbol]	PEAT AND/OR ORGANIC CLAY
[Symbol]	FILLED MATERIAL
[Symbol]	IGNEOUS ROCK
[Symbol]	SEDIMENTARY ROCK
[Symbol]	METAMORPHIC ROCK

- LEGEND OF BORING OPERATIONS
- [Symbol] PLAN OF ANY BORING
  - [Symbol] PENETROMETER
  - [Symbol] 2 1/2" CONE PENETROMETER
  - [Symbol] SAMPLER BORING (DRY)
  - [Symbol] ROTARY BORING (WET)
  - [Symbol] AUGER BORING (DRY)
  - [Symbol] JET BORING
  - [Symbol] CORE BORING
  - [Symbol] TEST PIT

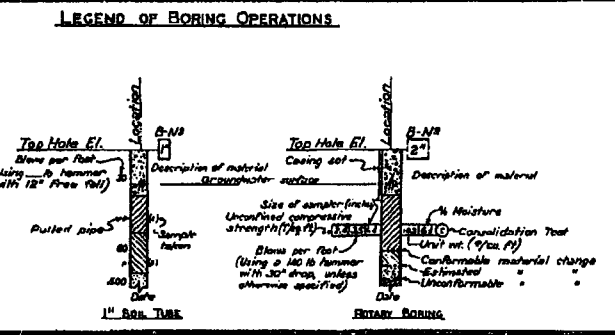

**NOTES**

THE CONTRACTOR'S ATTENTION IS DIRECTED TO SECTION 2, ARTICLE (C) OF THE STANDARD SPECIFICATIONS AND TO THE SPECIAL PROVISIONS ACCOMPANYING THIS SET OF PLANS. CLASSIFICATION OF EARTH MATERIAL AS SHOWN ON THIS SHEET IS BASED UPON FIELD INSPECTION AND IS NOT TO BE CONSTRUED TO IMPLY MECHANICAL ANALYSIS. PENETROMETER BORINGS HAVING A RATE OF PENETRATION MEASURED IN SECONDS PER FOOT ARE DRIVEN WITH A 140 LB. WHEATON-TERRY AIR HAMMER AT 110 PSI.

STATE OF CALIFORNIA  
DEPARTMENT OF PUBLIC WORKS  
DIVISION OF HIGHWAYS

**CLINTON AVENUE OVERCROSSING**  
**FRESNO VALLEY OVERCROSSING**  
**LOG OF TEST BORINGS (1 of 2)**

SCALE: HORIZ. 1" = 20' VERT. 1" = 10'  
BRIDGE 42-183 FILE E-42 DRAWING E-3413  
PREL. DRAWING NO. P-3413


**AS BUILT PLANS**  
Contract No. 55-6TC4  
Date Completed \_\_\_\_\_  
Document No. 60000992

I HEREBY CERTIFY THAT THIS IS A TRUE AND ACCURATE COPY OF THE ABOVE DOCUMENT TAKEN UNDER MY DIRECTION AND CONTROL, ON THIS DATE IN SACRAMENTO, CALIFORNIA PURSUANT TO AUTHORIZATION BY THE DIRECTOR OF TRANSPORTATION.

1-30-50 [Signature] SUPERVISOR OF HIGHWAY CONSTRUCTION



DIST.	COUNTY	ROUTE	POST MILES - TOTAL PROJECT	Sheet	NO.
06	Fres	99	24.4, 26.6	143	199
ENGINEERING GEOLOGY BRANCH - TRANSPORTATION MATERIALS & RESEARCH					
P.C. Williams					
CLINTON AVE. O.C. (WIDEN)					
LOG OF TEST BORINGS 4 OF 4					
NOTE: THIS LOG OF TEST BORINGS IS AVAILABLE ON MICROFILM AT OFFICE OF STRUCTURES DESIGN SACRAMENTO, CALIFORNIA					
CU: 06	EA: 342931	BRIDGE No.	42-183		

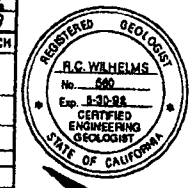


AS BUILT PLANS  
Contract No. 55-147C24  
Date Completed  
Document No. 60000991

NO AS-BUILT CORRECTIONS  
"NO AS-BUILT CORRECTIONS"  
AS BUILT


CORRECTIONS BY DAVID VALLEJOS  
CONTRACT NO. 06-342934  
DATE 4-16-95  
VHM 6/6/94

AS BUILT  
NO CORRECTIONS BY  
DATE

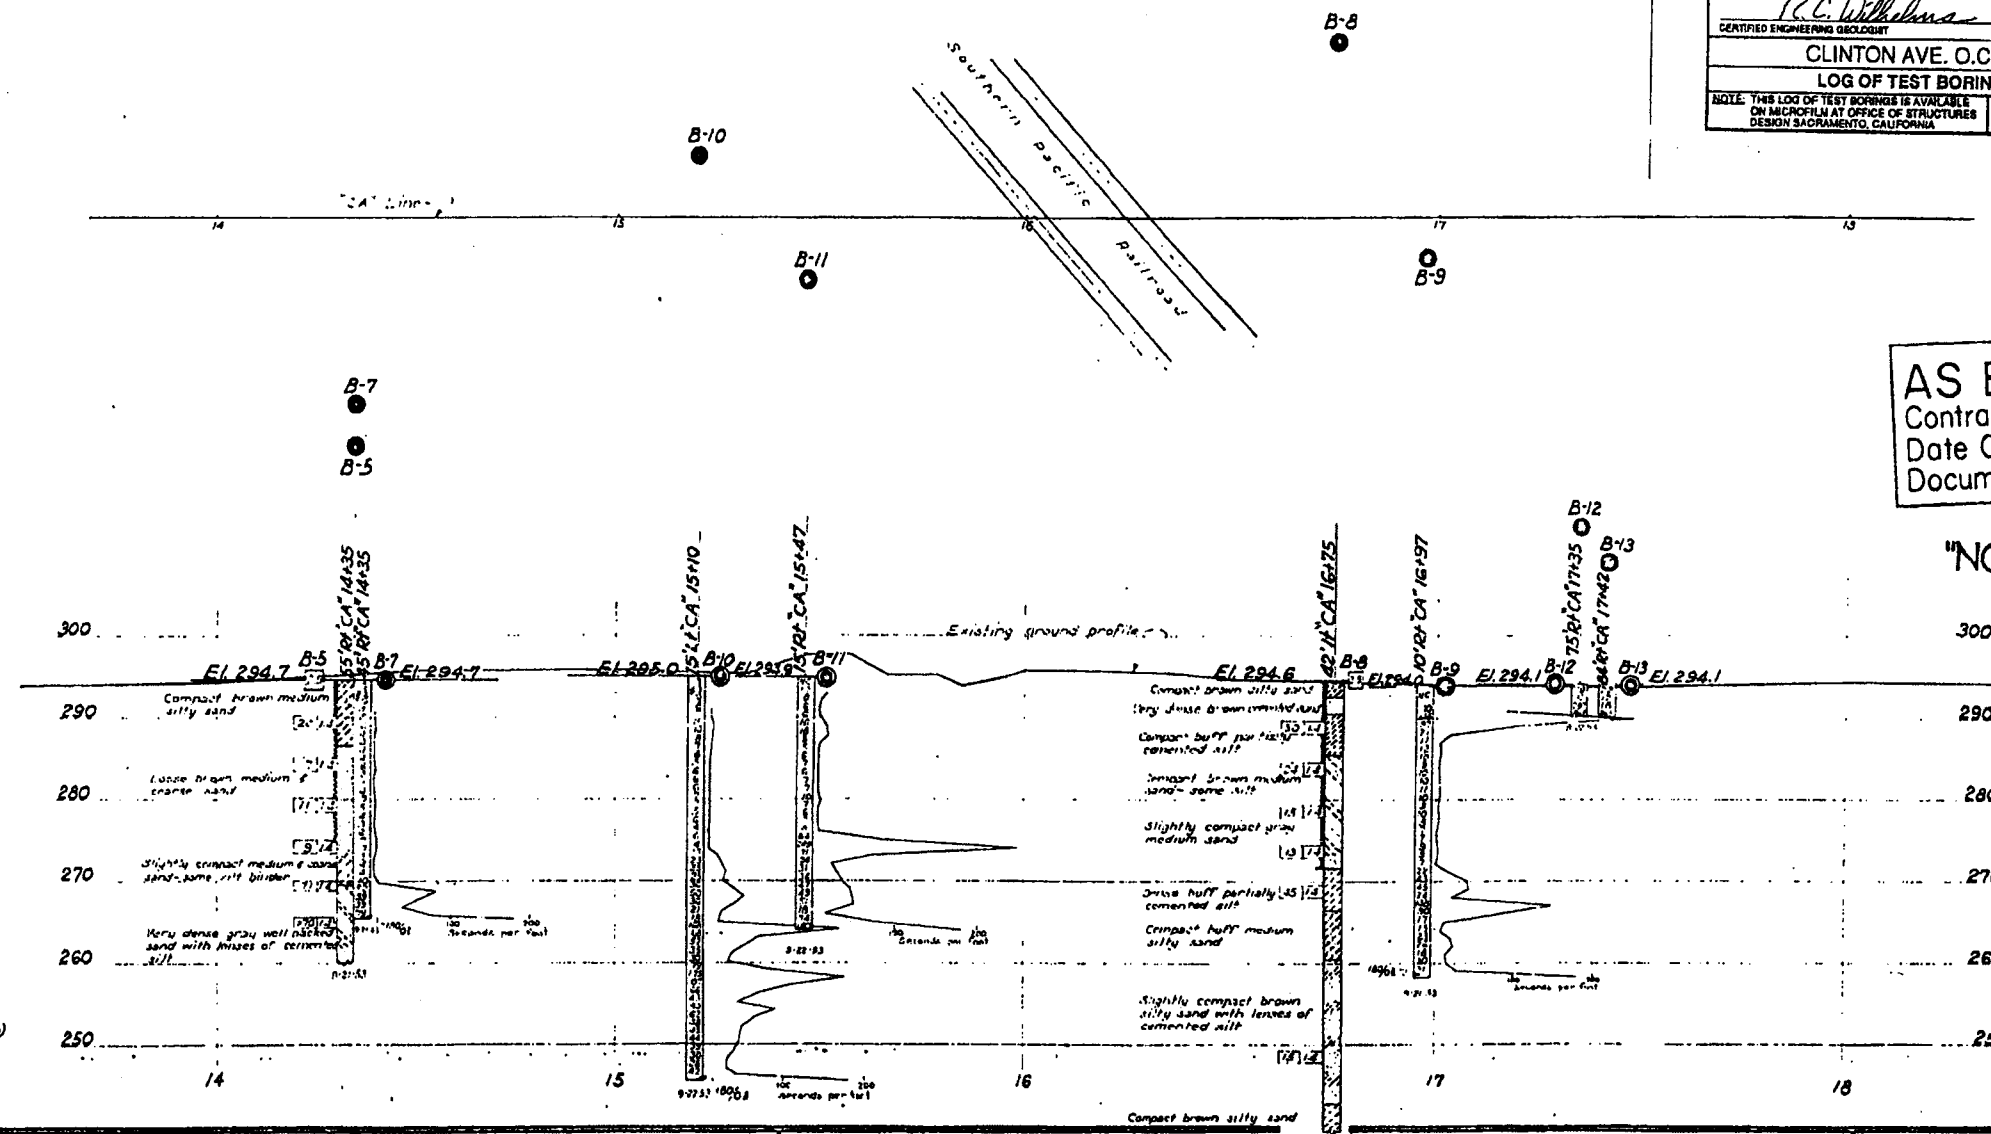

BM# 10A  
R.R. Spike in left hole  
81' 11" Sta 90+37.7 (1955 Survey)  
Elev 289.78

CLASSIFICATION OF MATERIAL BASED ON STANDARD GRADE SIZE LIMITS

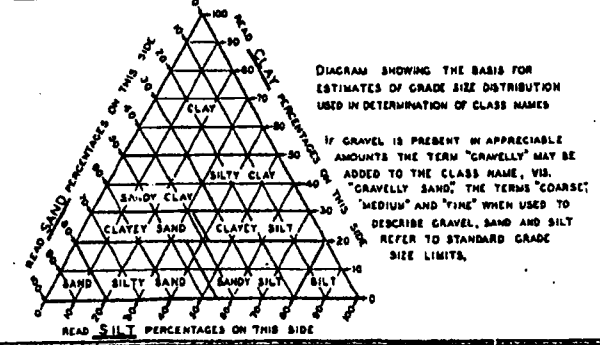


LEGEND OF EARTH MATERIALS

- |                           |                           |
|---------------------------|---------------------------|
| GRAVEL                    | SILTY CLAY OR CLAYEY SILT |
| SAND                      | PEAT AND/OR ORGANIC CLAY  |
| SILT                      | FILLED MATERIAL           |
| CLAY                      | IGNEOUS ROCK              |
| SANDY CLAY OR CLAYEY SAND | SEDIMENTARY ROCK          |
| SANDY SILT OR SILTY SAND  | METAMORPHIC ROCK          |

LEGEND OF BORING OPERATIONS

- PLAN OF ANY BORING
- PENETROMETER
- 2 1/2" CONE PENETROMETER
- SAMPLER BORING (DRY)
- ROTARY BORING (WET)
- AUGER BORING (DRY)
- JET BORING
- CORE BORING
- TEST PIT

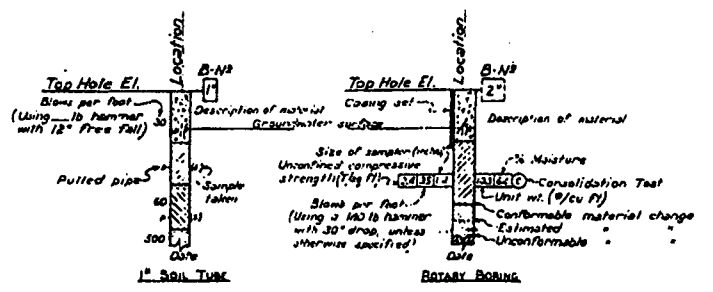

NOTES

THE CONTRACTOR'S ATTENTION IS DIRECTED TO SECTION 2, ARTICLE (C) OF THE STANDARD SPECIFICATIONS AND TO THE SPECIAL PROVISIONS ACCORDING TO THIS SET OF PLANS. CLASSIFICATION OF EARTH MATERIAL AS SHOWN ON THIS SHEET IS BASED UPON FIELD INSPECTION AND IS NOT TO BE CONSTRUED TO IMPLY MECHANICAL ANALYSIS. PENETROMETER BORINGS HAVING A RATE OF PENETRATION MEASURED IN SECONDS PER FOOT ARE DRIVEN WITH A NO. 2 MARIEMAN-TERRY AIR HAMMER AT 315 PSI.

CLINTON AVENUE OVERCROSSING  
FRESNO YARD OVERCROSSING  
LOG OF TEST BORINGS (2 of 2)

SCALE	HORIZ 1"=20'	VERT 1"=10'	BRIDGE 42-183	FILL	DATE	DRAWING
-------	--------------	-------------	---------------	------	------	---------



U-0194(1)

DIST.	COUNTY	ROUTE	POST MILES TOTAL PROJECT	SHEET NO.	TOTAL SHEETS
06	Fresno	99	244.266	142	199

PLAN APPROVAL 3-11-91



DIST.	COUNTY	ROUTE	POST MILES - TOTAL PROJECT	Sheet No.	Scale
06	Fresno	99			
ENGINEERING GEOLOGY BRANCH - TRANSPORTATION MATERIALS & RESEARCH					
CLINTON AVE. O.C. (WIDEN)					
LOG OF TEST BORINGS 3 OF 4					
NOTE: THIS LOG OF TEST BORINGS IS AVAILABLE ON MICROFILM AT OFFICE OF STRUCTURES DESIGN SACRAMENTO, CALIFORNIA					
CU: 08			BRIDGE No.		
EA: 342931			42-183		



AS BUILT

CORRECTIONS BY DAVID VALLEJOS  
CONTRACT NO. 06-342934  
DATE 4-16-93

NO AS-BUILT CHANGES  
NO AS-BUILT CORRECTIONS

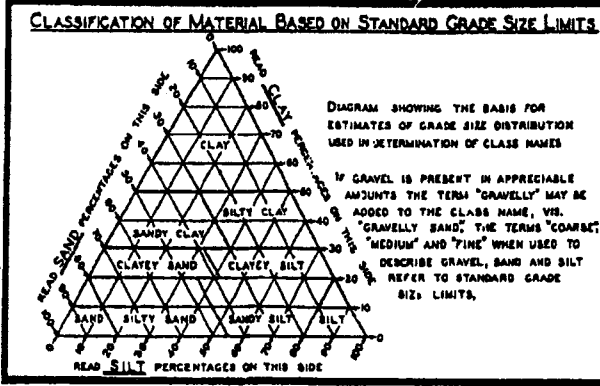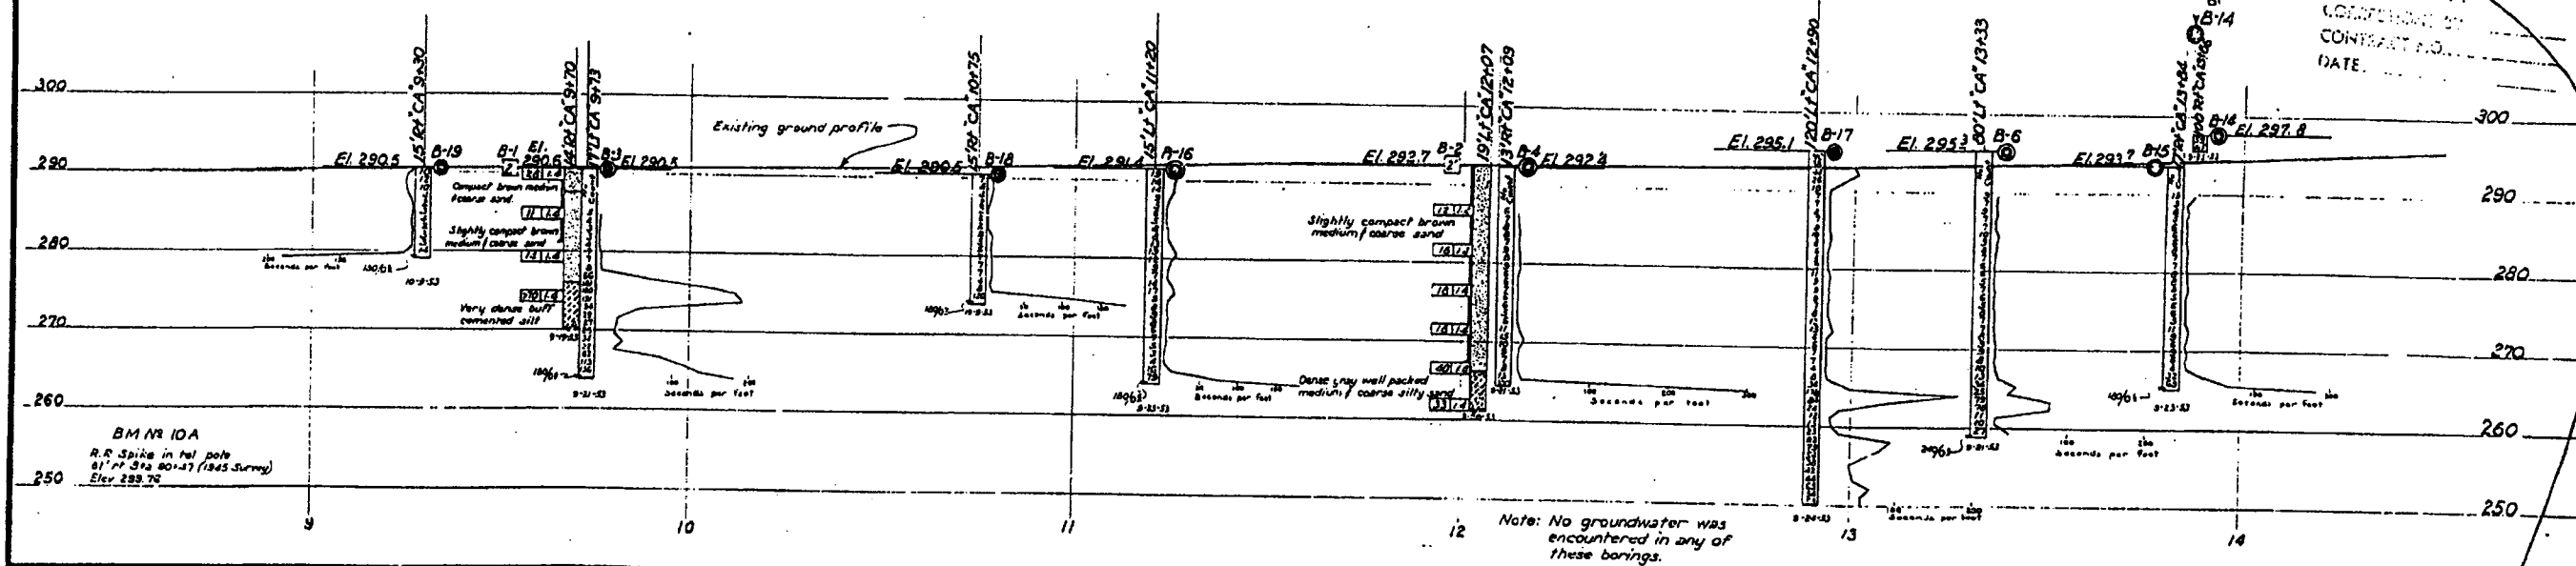

**LEGEND OF EARTH MATERIALS**

GRAVEL	SILTY CLAY OR CLAYEY SILT
SAND	PEAT and/or ORGANIC CLAY
SILT	FILLED MATERIAL
CLAY	IGNEOUS ROCK
SANDY CLAY OR CLAYEY SAND	SEDIMENTARY ROCK
SANDY SILT OR SILTY SAND	MET. & MET. C. ROCK

**LEGEND OF BORING OPERATIONS**

- PLAN OF ANY BORING
- PENETROMETER
- 2 1/2" CONE PENETROMETER
- SAMPLER BORING (DRY)
- ROTARY BORING (WET)
- AUGER BORING (DRY)
- JET BORING
- CORE BORING
- TEST PIT

**NOTES**

THE CONTRACTOR'S ATTENTION IS DIRECTED TO SECTION 2, ARTICLE 10 OF THE STANDARD SPECIFICATIONS AND TO THE SPECIAL PROVISIONS ACCOMPANYING THIS SET OF PLANS. CLASSIFICATION OF EARTH MATERIALS AS SHOWN ON THIS SHEET IS BASED UPON FIELD INSPECTION AND IS NOT TO BE CONSTRUED TO IMPLY MECHANICAL ANALYSIS. PENETROMETER BORINGS HAVING A RATE OF PENETRATION MEASURED IN SECONDS PER FOOT ARE DRIVEN WITH A NO. 2 WHIRLWIND-TERRY AIR HAMMER AT 115 PSI.

STATE OF CALIFORNIA  
DEPARTMENT OF PUBLIC WORKS  
DIVISION OF HIGHWAYS

**CLINTON AVENUE OVERCROSSING**  
**FRESNO YARD OVERCROSSING**  
**LOG OF TEST BORINGS**

SCALE: HORIZ. 1"=20' VERT. 1"=10' BRIDGE 42-183 FILE E-42 DRAWING C-5413-1


PREL. DRAWING NO. P. 3413

SHEET 28 OF 29

AS BUILT PLANS




DIST.	COUNTY	ROUTE	POST MILES	SHEET NO.	TOTAL SHEETS
06	Fra	99	TOTAL PROJECT 24.4, 26.6	141	199
P.C. Williams CERTIFIED ENGINEERING GEOLOGIST			REGISTERED GEOLOGIST Exp. 6-30-92 R.C. WILHELMUS No. 560 CERTIFIED ENGINEERING GEOLOGIST STATE OF CALIFORNIA		
3-11-91 PLANS APPROVAL DATE					

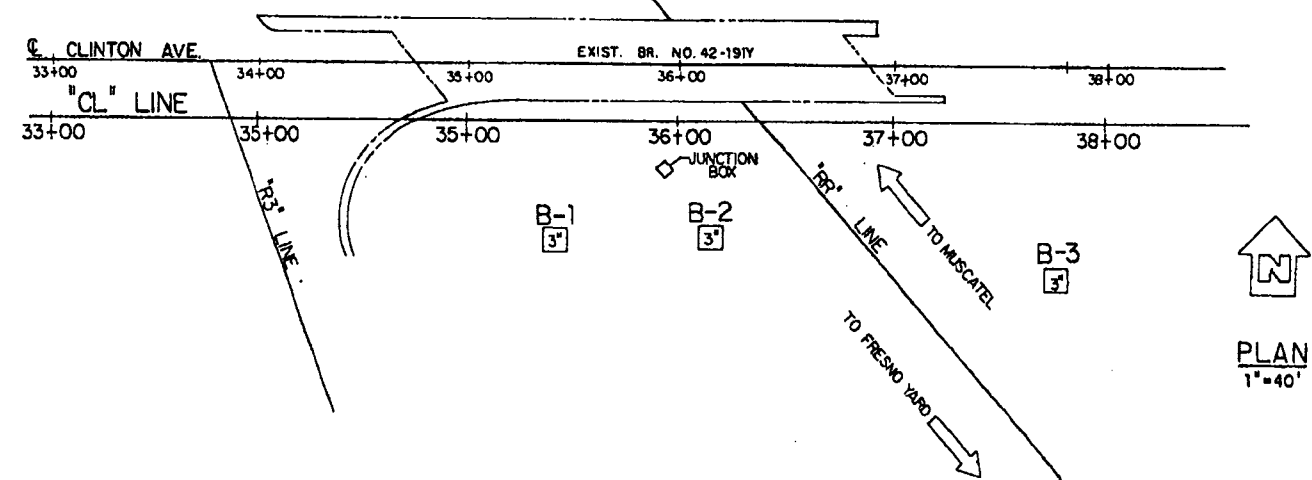

**BENCH MARK**  
FD. USC & GS BM C-368, 1953 SE CORNER  
CONCRETE JCT. BOX. ELEVATION 298.98

NO AS-BUILT CHANGES  
"NO AS-BUILT CORRECTIONS"  
**AS BUILT**  
CORRECTIONS BY DAVID VALLEJOS  
CONTRACT NO. 06-342934  
DATE 9-16-93  
WH 6/6/94

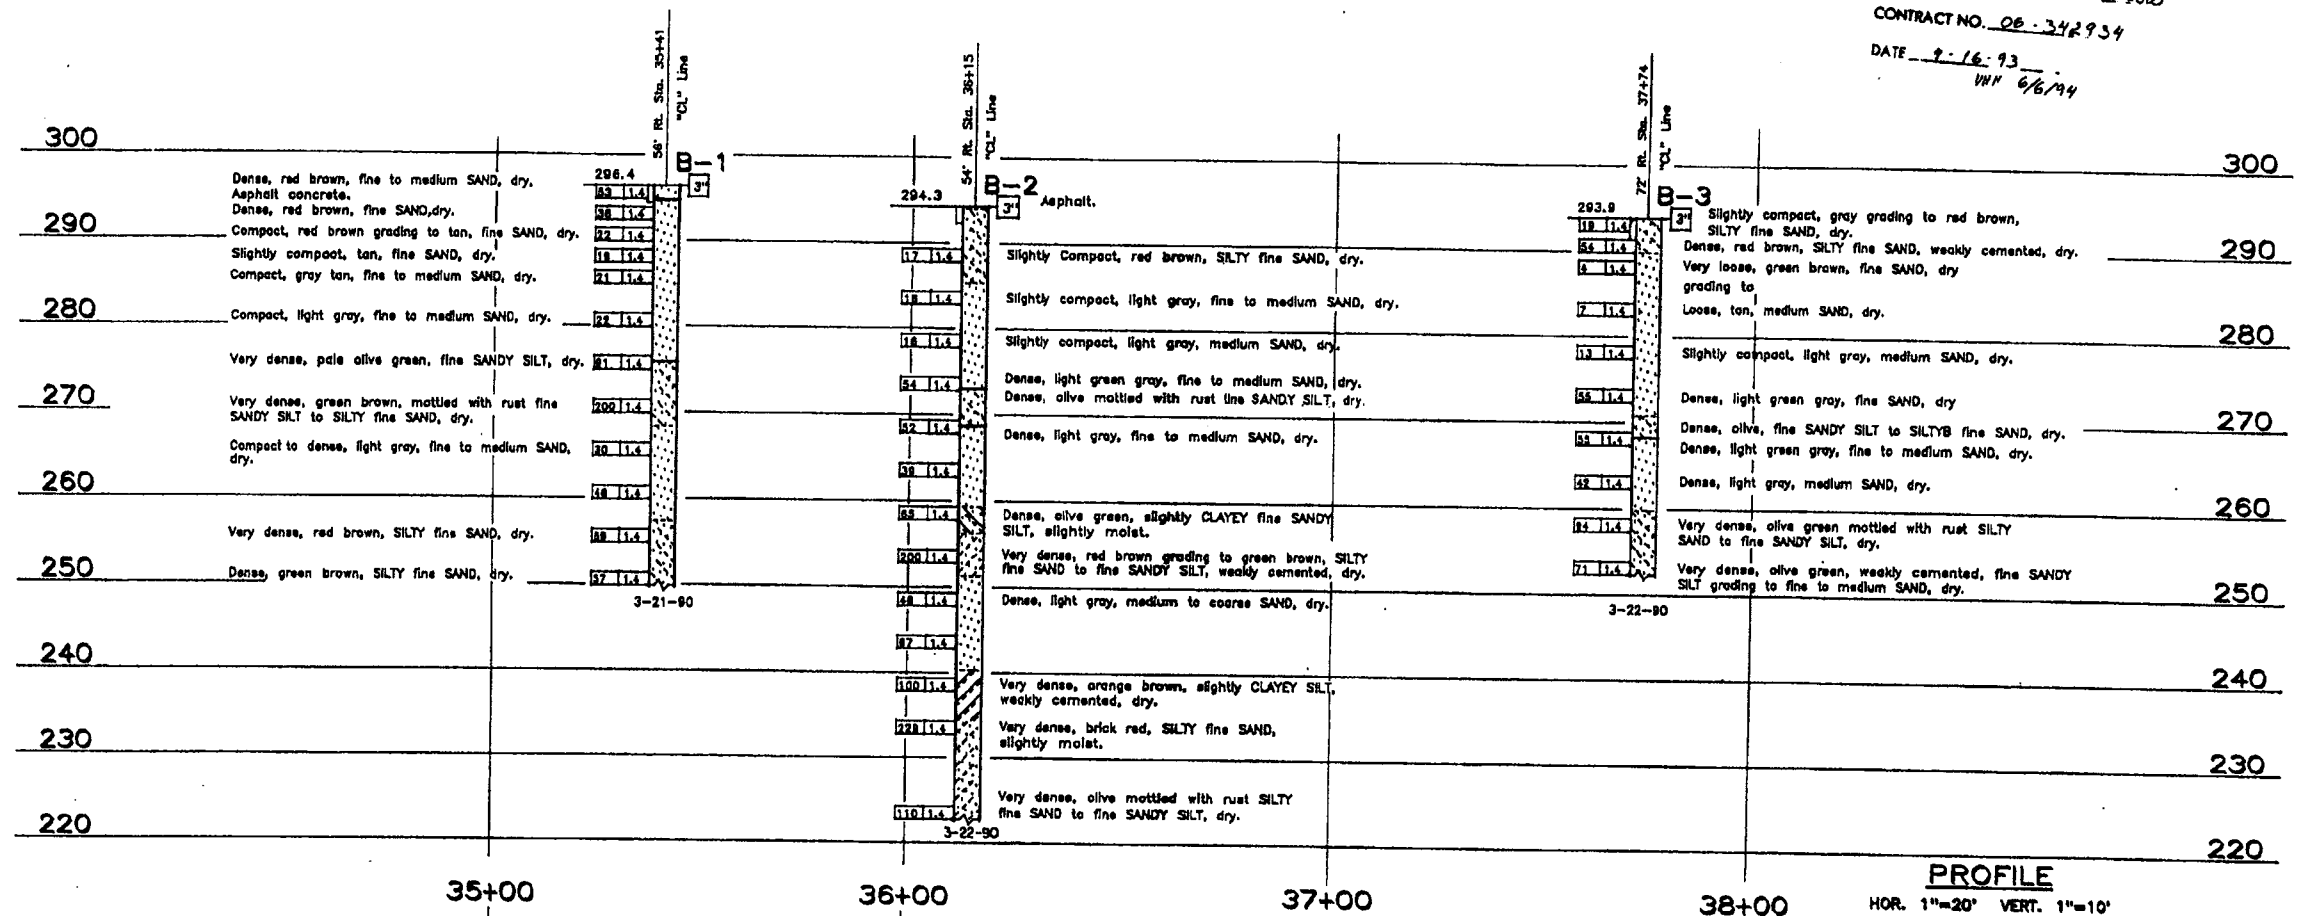

ENGINEERING GEOLOGY BRANCH - TRANSPORTATION LABORATORY		State of CALIFORNIA DEPARTMENT OF TRANSPORTATION		DIVISION OF STRUCTURES STRUCTURE DESIGN 2		BRIDGE NO. 42-183 POST MILE 24.4		CLINTON AVE. O.C. (WIDEN) LOG OF TEST BORINGS 2 OF 4	
DRAWN BY	LEONY L. LOPEZ	4/90	PROJECT ENGINEER	CU 06	EA 342931	REVISION DATES (PRELIMINARY STAGE ONLY)		SHEET 27	OF 29

**LEGEND OF BORING OPERATIONS**

**LEGEND OF EARTH MATERIALS**

**CONSISTENCY CLASSIFICATION FOR SOILS**

**NOTE:** Classification of earth material as shown on this sheet is based upon field inspection and is not to be construed as a laboratory analysis.




DIST.	COUNTY	ROUTE	POST MILES TOTAL PROJECT	SHEET NO.	TOTAL SHEETS
06	Fre	99	24.4, 26.6	140	199

*R.C. Williams*  
CERTIFIED ENGINEERING GEOLOGIST

REGISTERED GEOLOGIST  
Exp. 6-30-92  
R.C. WILHELMS  
No. 360  
CERTIFIED ENGINEERING GEOLOGIST  
STATE OF CALIFORNIA


3-11-91  
PLANS APPROVAL DATE

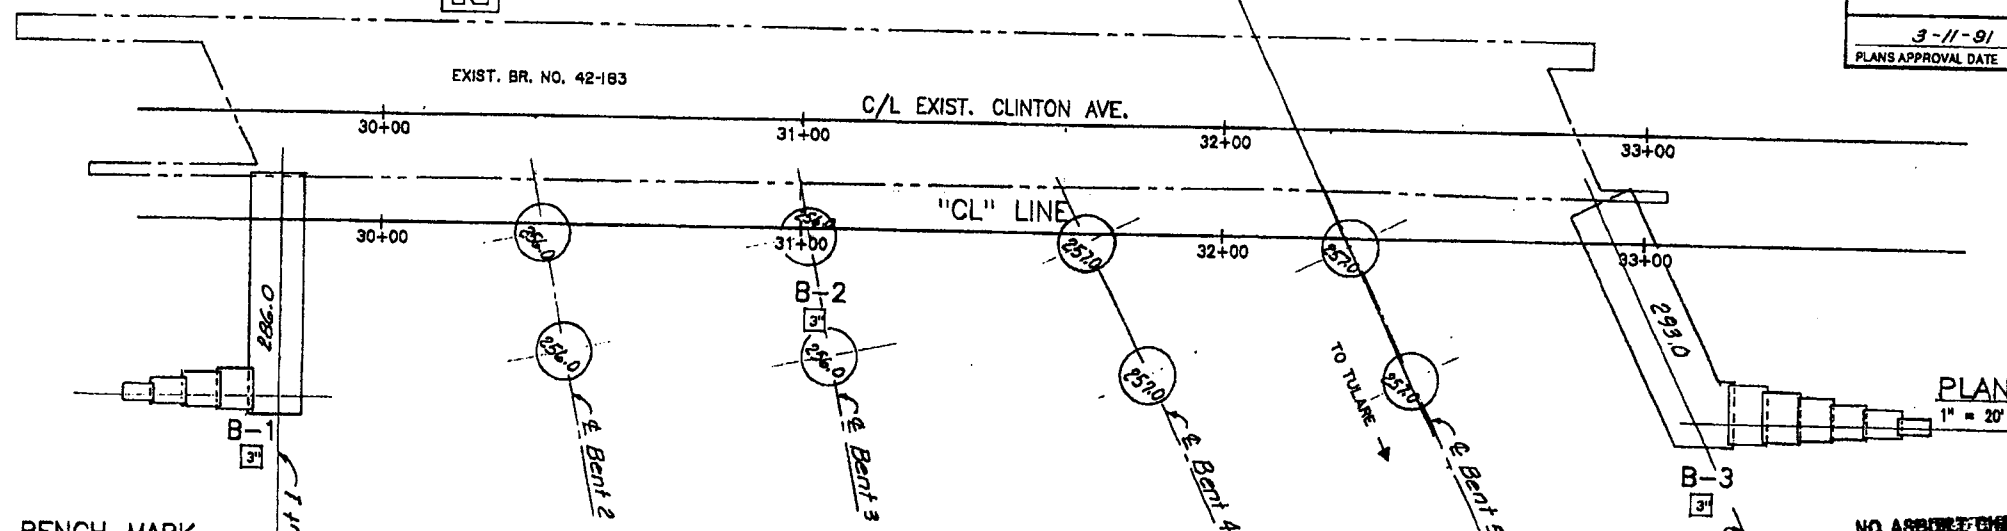

**BENCH MARK**  
Fd. Brass disk set in shoulder, labelled  
"Calif. Dept. of Transportation 50.00' Rt.  
89+47.89 BC Elev. 296.89

NO. AS-BUILT CORRECTIONS  
**AS BUILT**  
CORRECTIONS BY DAVID VALLEJOS  
CONTRACT NO. 06-342934  
DATE 4-16-92  
10/6/94

NOTE:  
NO GROUND WATER ENCOUNTERED  
DURING FIELD INVESTIGATION

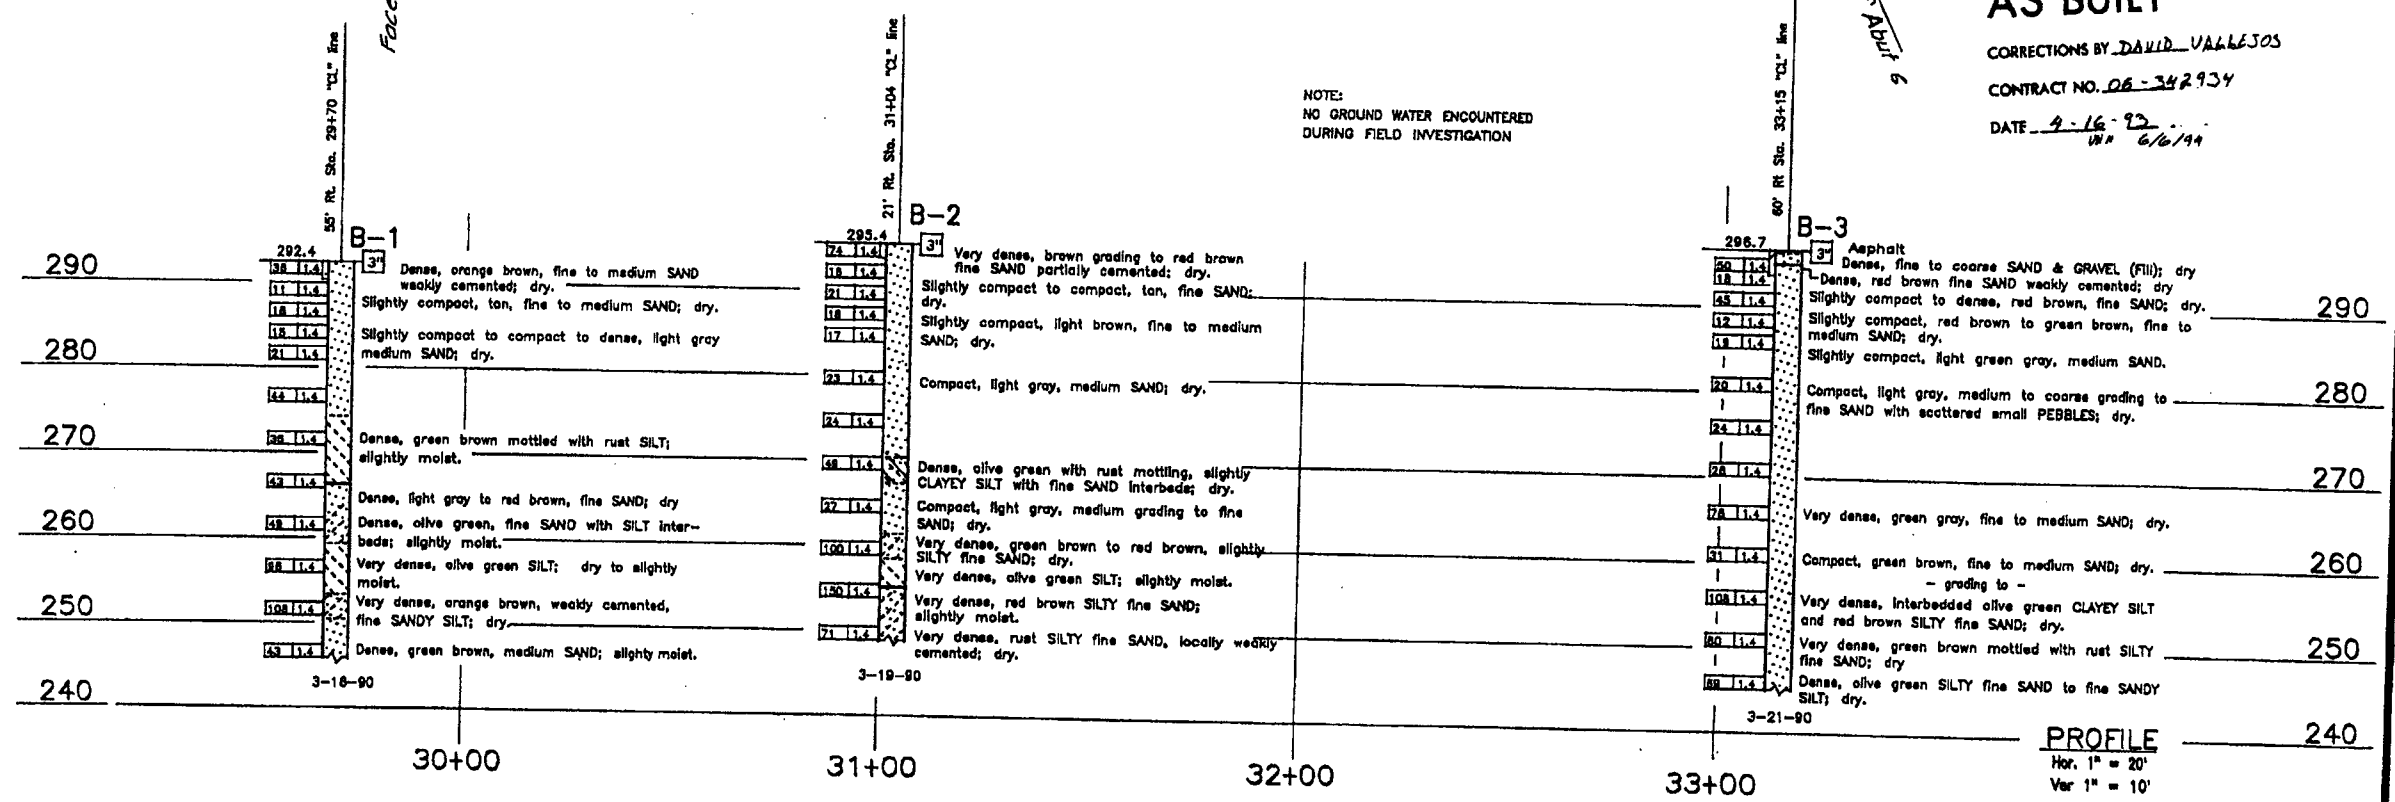

ENGINEERING GEOLOGY BRANCH - TRANSPORTATION LABORATORY		<i>John Lujano</i> PROJECT ENGINEER	State of <b>CALIFORNIA</b> DEPARTMENT OF TRANSPORTATION	DIVISION OF STRUCTURES <b>STRUCTURE DESIGN 2</b>	BRIDGE NO. 42-183	CLINTON AVE. O.C. (WIDEN) <b>LOG OF TEST BORINGS 1 OF 4</b>
DRAWN BY IRMA GAMARRA	5/90				POST MILE 24.4	
CHECKED BY						

ORIGINAL SCALE IN INCHES  
FOR REDUCED PLANS 0 1 2 3

GU 06 EA 342931	DISREGARD PRINTS BEARING EARLIER REVISION DATES	REVISION DATES (PRELIMINARY STAGE ONLY)	SHEET 26	OF 29
--------------------	--	---	-------------	----------

**LEGEND OF SYMBOLS**

**LEGEND OF EARTH MATERIALS**

GRAVEL	CLAY	CLAYEY SILT	CLAYEY SAND	CLAYEY SILT	CLAYEY SAND	CLAYEY SILT	CLAYEY SAND	CLAYEY SILT	CLAYEY SAND
SAND	SILT	SANDY SILT	SANDY CLAY	SANDY SILT	SANDY CLAY	SANDY SILT	SANDY CLAY	SANDY SILT	SANDY CLAY
SAND	SILT	SANDY SILT	SANDY CLAY	SANDY SILT	SANDY CLAY	SANDY SILT	SANDY CLAY	SANDY SILT	SANDY CLAY

**CONSISTENCY CLASSIFICATION FOR SOILS**

Consistency	Very loose	Loose	Medium	Dense	Very dense
Penetration (mm)	0-2	2-5	5-10	10-25	25-50
Penetration (mm)	0-2	2-5	5-10	10-25	25-50

**NOTE:** Classification of earth materials as shown on this sheet is based upon field inspection and is not to be construed as a laboratory analysis.




F-0194(4)


STATE	PROJECT NO.	SECTION	SHEET NO.	TOTAL SHEETS
CAL.			125	210

DATE	BY	CHKD.	APP'D.
AUGUST 1 1958			

BRIDGE DEPARTMENT  
AUGUST 1 1958

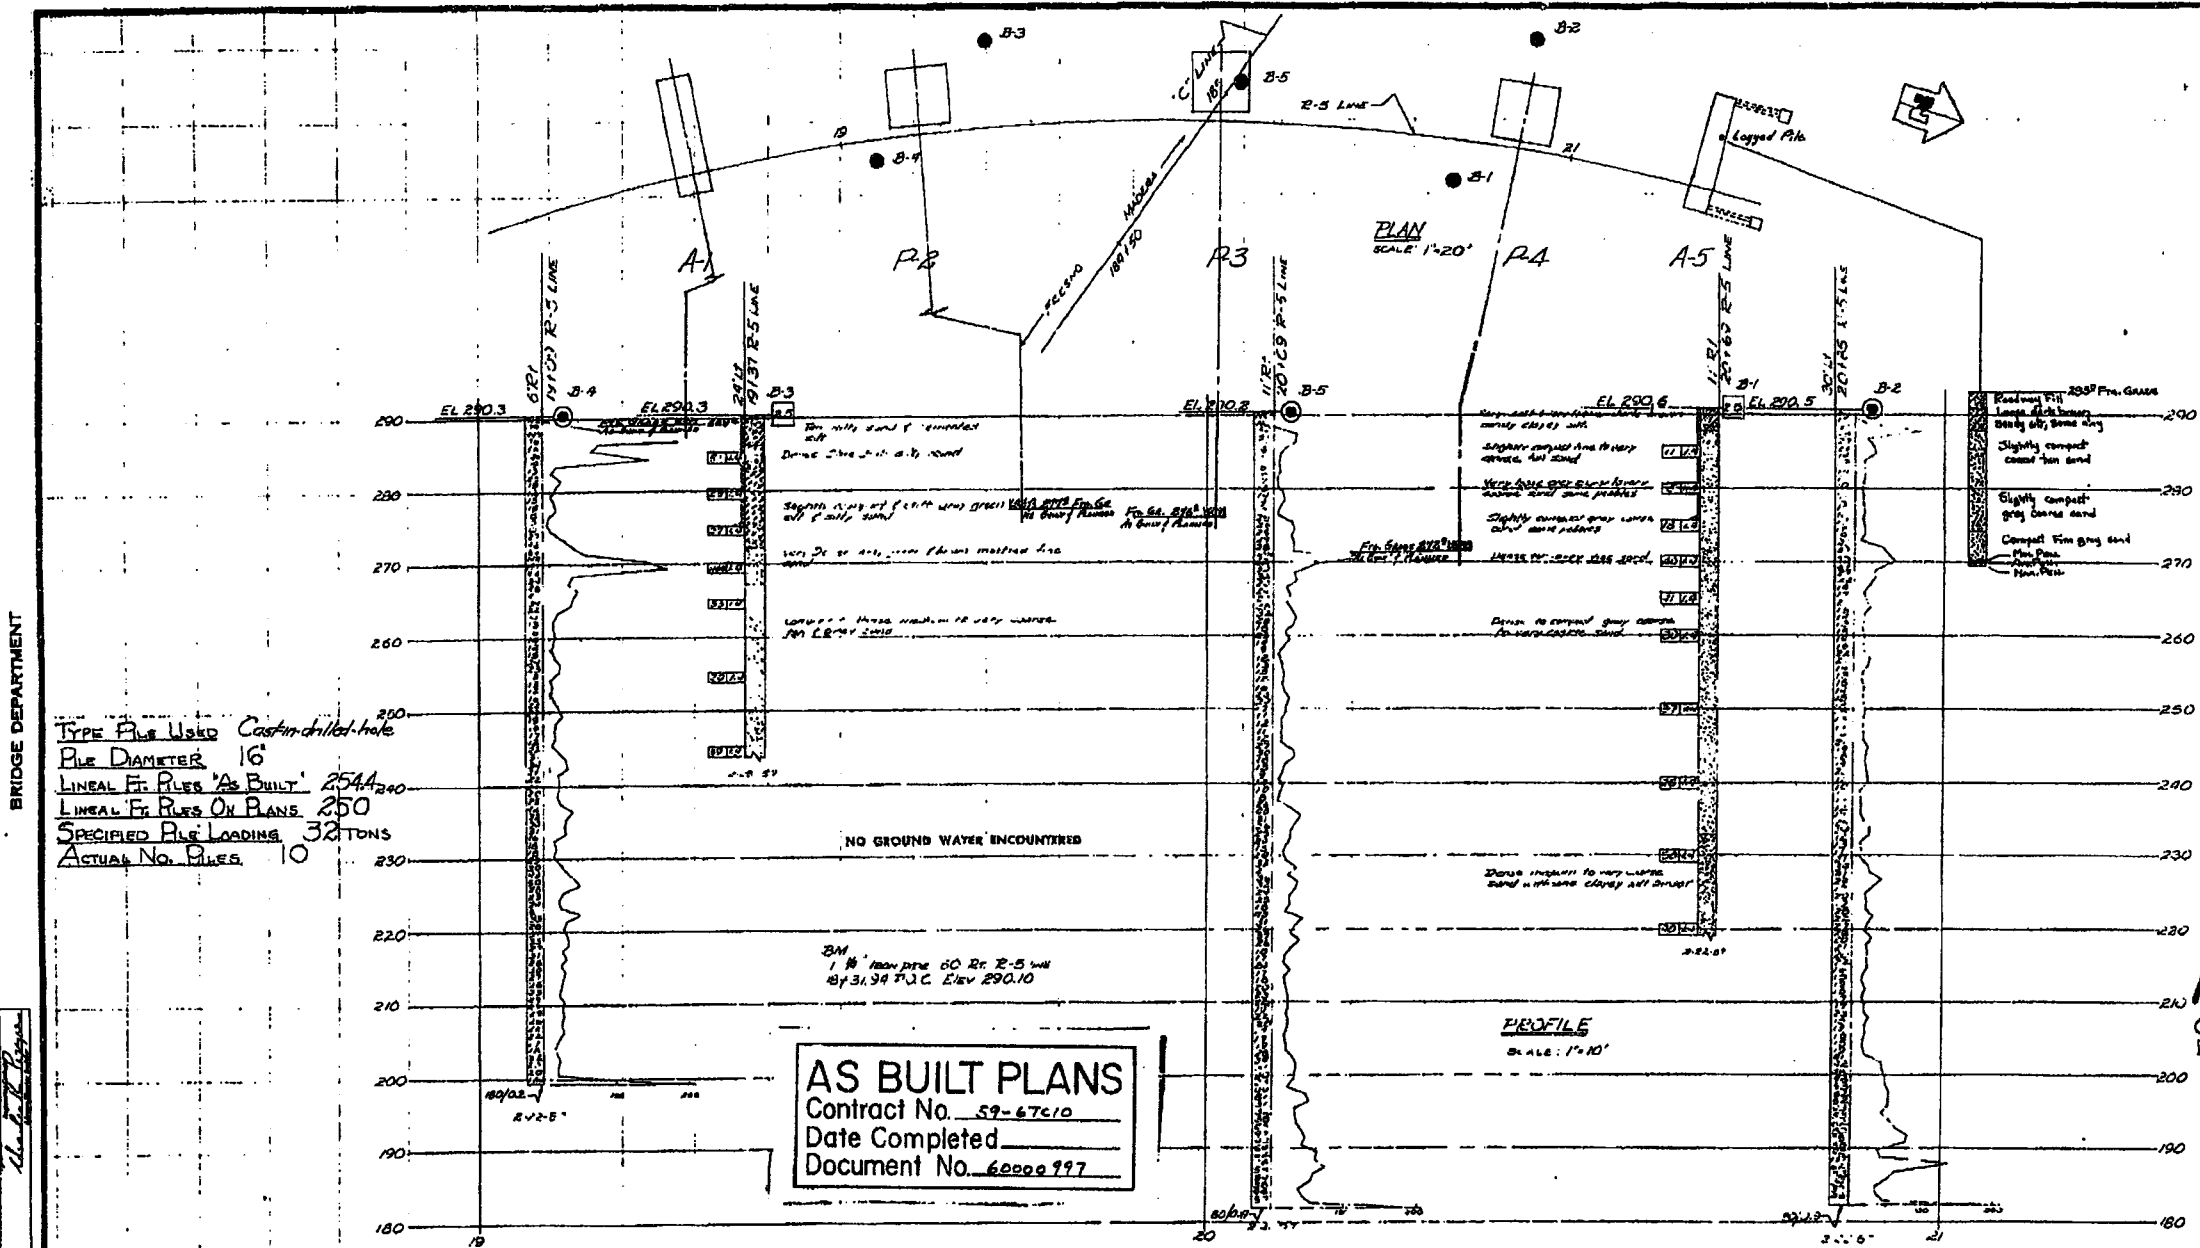


TYPE PILE USED Cast-in-drilled-hole  
PILE DIAMETER 16  
LINEAL FT. PILES 'AS BUILT' 254.1  
LINEAL FT. PILES ON PLANS 250  
SPECIFIED PILE LOADING 32 TONS  
ACTUAL NO. PILES 10

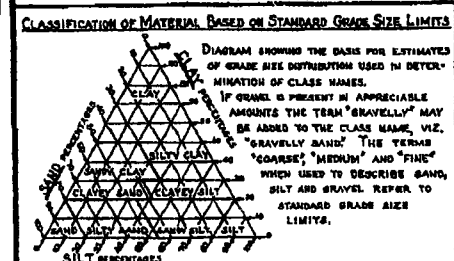

**LEGEND OF EARTH MATERIALS**

GRAVEL	SILTY CLAY OR CLAYEY SILT
SAND	PEAT AND/OR ORGANIC MATTER
SILT	FILL MATERIAL
CLAY	IGNEOUS ROCK
SANDY CLAY OR CLAYEY SAND	SEDIMENTARY ROCK
SANDY SILT OR SILTY SAND	METAMORPHIC ROCK

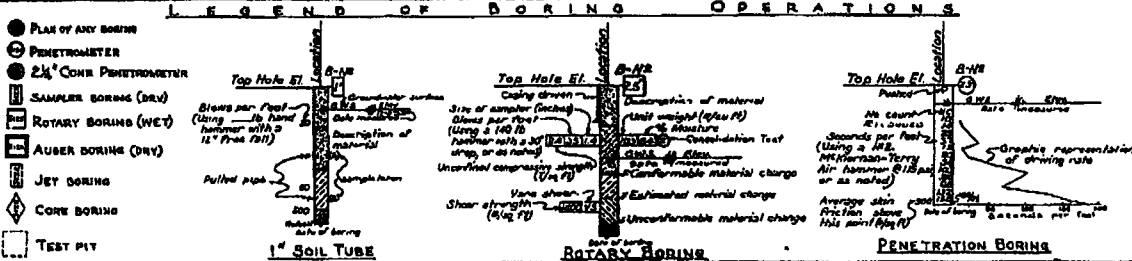

**NOTES**

The contractor's attention is directed to Section 2, Article (c) of the Standard Specifications and to the Special Provisions accompanying this set of plans. Classification of earth material as shown on this sheet is based upon field inspection and is not to be construed as a final mechanical analysis.

STATE OF CALIFORNIA  
DEPARTMENT OF PUBLIC WORKS  
DIVISION OF HIGHWAYS

**DAKOTA OVERCROSSING**

**LOG OF TEST BORINGS**

SCALE AS SHOWN BRIDGE 92-178 FILE DRAWING C5382-9

PREL. DRAWING NO. P-5382-17

I HEREBY CERTIFY THAT THIS IS A TRUE AND ACCURATE COPY OF THE ABOVE DOCUMENT TAKEN UNDER MY DIRECTION AND CONTROL ON THIS DATE IN SACRAMENTO, CALIFORNIA PURSUANT TO AUTHORIZATION BY THE DIRECTOR OF PUBLIC WORKS.


DATE 7/16/61 SIGNATURE *J. R. H.* TITLE *H.A.C.I.I.*




F-0194(A)

FED. ROAD DIST. NO.	STATE	FPM. NO.	SECTION	SHEET NO.	TOTAL SHEETS
7	CAL.			183	210

DATE	BY	CHECKED	APPROVED	DATE	BY	CHECKED	APPROVED
VI	PT	PT	PT	10	2		
AUGUST 1 1958							

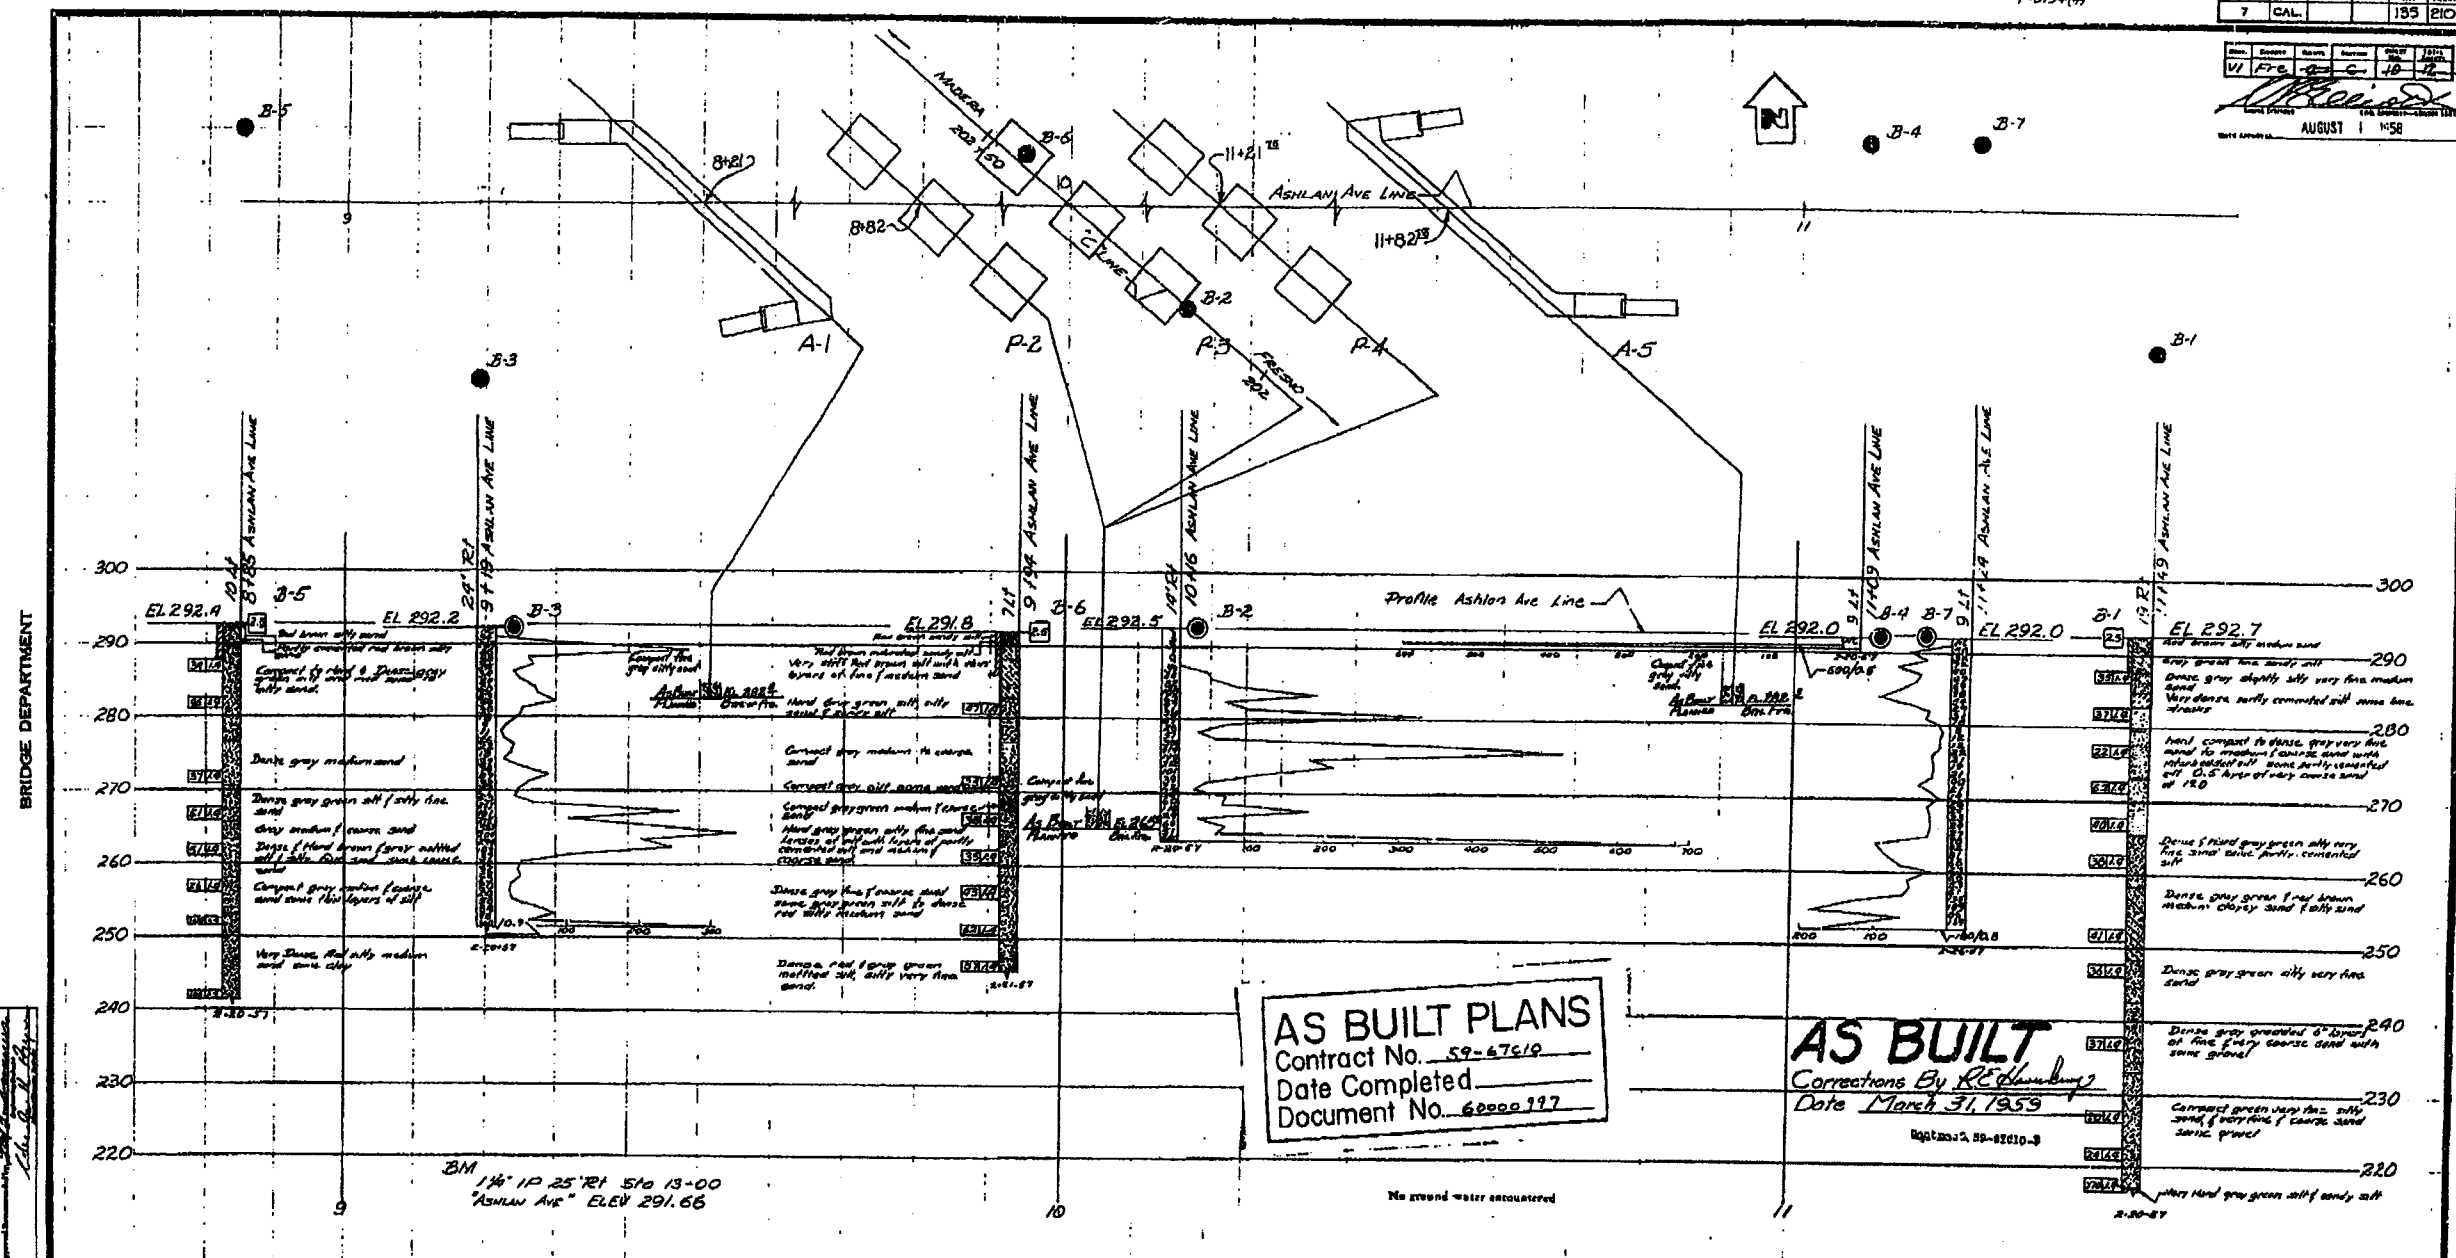

## CLASSIFICATION OF MATERIAL BASED ON STANDARD GRADE SIZE LIMITS

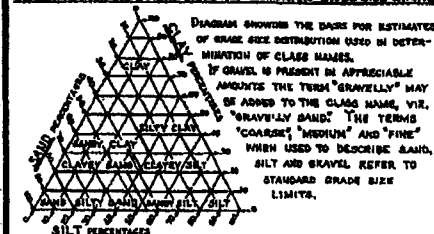

## LEGEND OF EARTH MATERIALS

GRAVEL	SILTY CLAY OR CLAYEY SILT
SAND	PEAT AND/OR ORGANIC MATTER
SILT	FILL MATERIAL
CLAY	IGNEOUS ROCK
SANDY CLAY OR CLAYEY SAND	SEDIMENTARY ROCK
SANDY SILT OR SILTY SAND	METAMORPHIC ROCK

## LEGEND OF BORING OPERATIONS

PLAN OF ANY BORING	Top Hole EL.
PENETROMETER	Bottom Hole EL.
2 1/2" CONE PENETROMETER	Blows per Foot
SAMPLER BORING (DRY)	Blows per Foot
ROTARY BORING (WET)	Blows per Foot
AUGER BORING (DRY)	Blows per Foot
JET BORING	Blows per Foot
TEST PIT	Blows per Foot

## NOTES

The contractor's attention is directed to Section 2, Article (d) of the Standard Specifications and to the Special Provisions accompanying this set of plans.

Classification of earth materials as shown on this sheet is based upon field inspection and is not to be construed to imply mechanical analysis.

STATE OF CALIFORNIA  
DEPARTMENT OF PUBLIC WORKS  
DIVISION OF HIGHWAYS

**ASHLAN AVE OVERCROSSING**

**LOG OF TEST BORINGS**

SCALE 1" = 10' BRIDGE 92-140 FILE-A-2 DRAWING C-5383-10  
PR 5383-4

I HEREBY CERTIFY THAT THIS IS A TRUE AND ACCURATE COPY OF THE ABOVE DOCUMENT TAKEN UNDER MY DIRECTION AND CONTROL ON THIS DATE IN SACRAMENTO, CALIFORNIA PURSUANT TO AUTHORIZATION BY THE DIRECTOR OF PUBLIC WORKS.

DATE 7/16/71 SIGNATURE *20: S. H. H.* TITLE H.A.C. II



BRIDGE DEPARTMENT

Chart 1-1

DIST	COUNTY	ROUTE	POST MILES	TOTAL PROJECT	SHEET NO.	TOTAL SHEETS
06	Fre	99	24.4, 26.6	199	199	199

APPROVED 3-11-91  
B-4 B-7

ENGINEERING GEOLOGY BRANCH, TRANSPORTATION LABORATORY  
Ronald E. Reichen  
REGISTERED ENGINEER - CIVIL


ASHLAN AVE. OVERCROSSING  
LOG OF TEST BORINGS

CJ: 06  
EA: 342931

BRIDGE NO. 42-140


STATE OF CALIFORNIA

AUGUST 1 1958

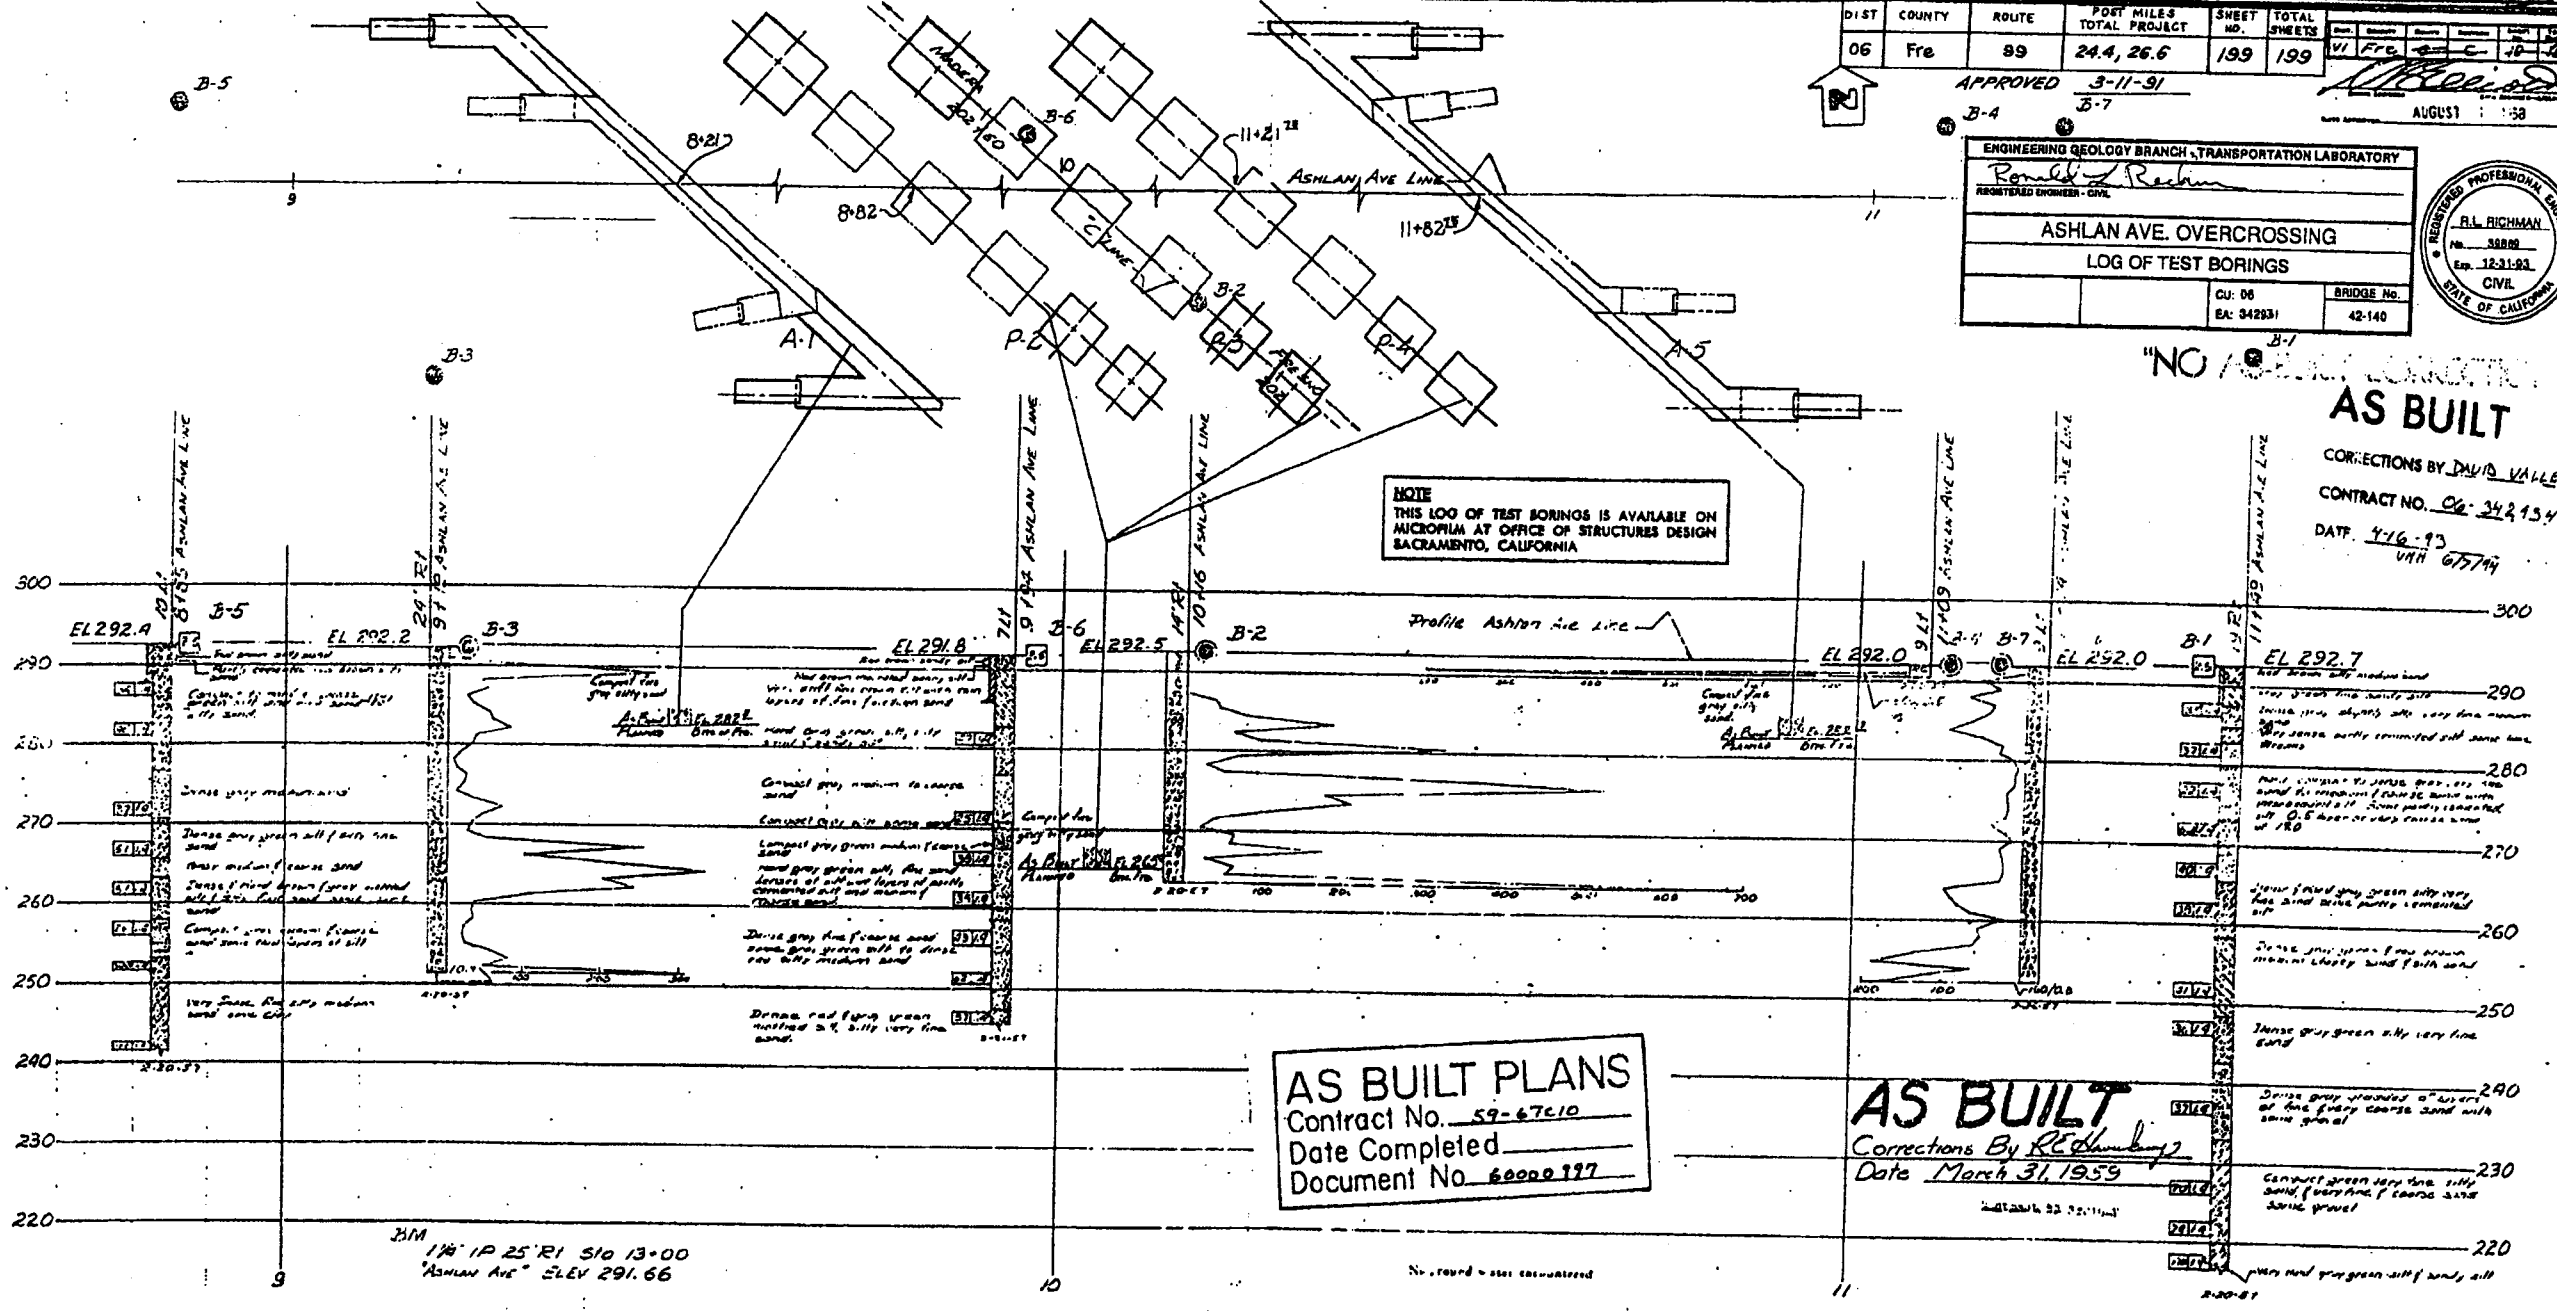


AS BUILT PLANS  
Contract No. 59-67C10  
Date Completed  
Document No. 60000 197

AS BUILT  
Corrections By R. E. Reichen  
Date March 31, 1959

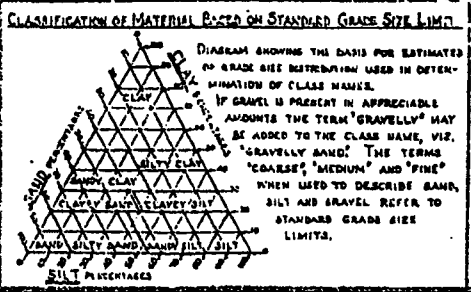

LEGEND OF EARTH MATERIALS

GRAVEL	SILTY CLAY OR CLAYEY SILT
SAND	PEAT AND/OR ORGANIC MATTER
SILT	FILL MATERIAL
CLAY	IGNEOUS ROCK
SANDY CLAY OR CLAYEY SAND	SEDIMENTARY ROCK
SANDY SILT OR SILTY SAND	METAMORPHIC ROCK

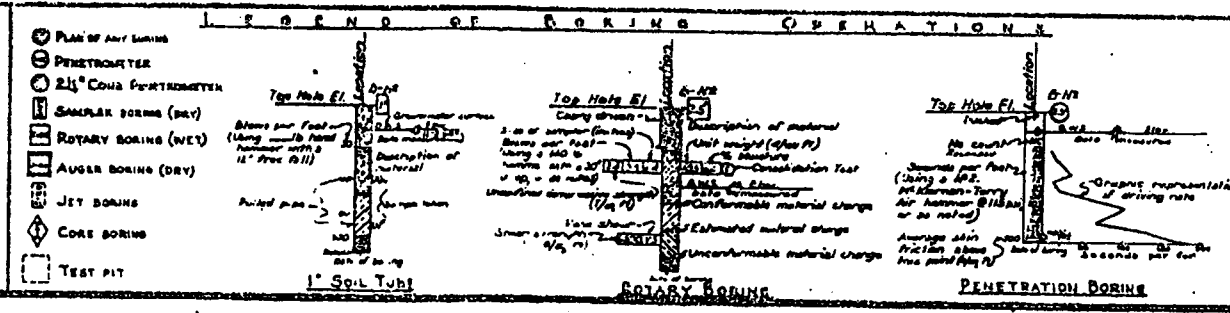

NOTES

The contractor's attention is directed to Section 2, Article (1) of the Standard Specifications and to the Special Provisions accompanying this set of plans.

Classification of earth material on these plans is based upon field inspection and is not to be construed to imply mechanical analysis.

STATE OF CALIFORNIA  
DEPARTMENT OF PUBLIC WORKS  
DIVISION OF HIGHWAYS

ASHLAN AVE OVERCROSSING

LOG OF TEST BORINGS

SCALE 1" = 10' BRIDGE 42-140 PAGE 42 DRAWING C5383-10

PR 5383-9

F-0194(4)

NO.	DATE	BY	CHKD.	APP'D.	TOTAL
7	CAL.				156


NO.	DATE	BY	CHKD.	APP'D.	TOTAL
VI	PRE				7

DATE AUGUST 1, 1959

DESIGN PILE LOADING 45 T.  
TYPE PILE CONCRETE, C.I.DH.  
DIAMETER 16 IN.  
TOTAL NUMBER OF PILES 36  
LINEAL FT. PILES, AS BUILT 1677.8  
LINEAL FT. PILES, ON PLANS 1610


NOTE: PILE REINFORCEMENT EXTENDED  
12' INTO ORIGINAL GROUND.

AS BUILT PLANS  
Contract No. 59-67410  
Date Completed  
Document No. 60000197

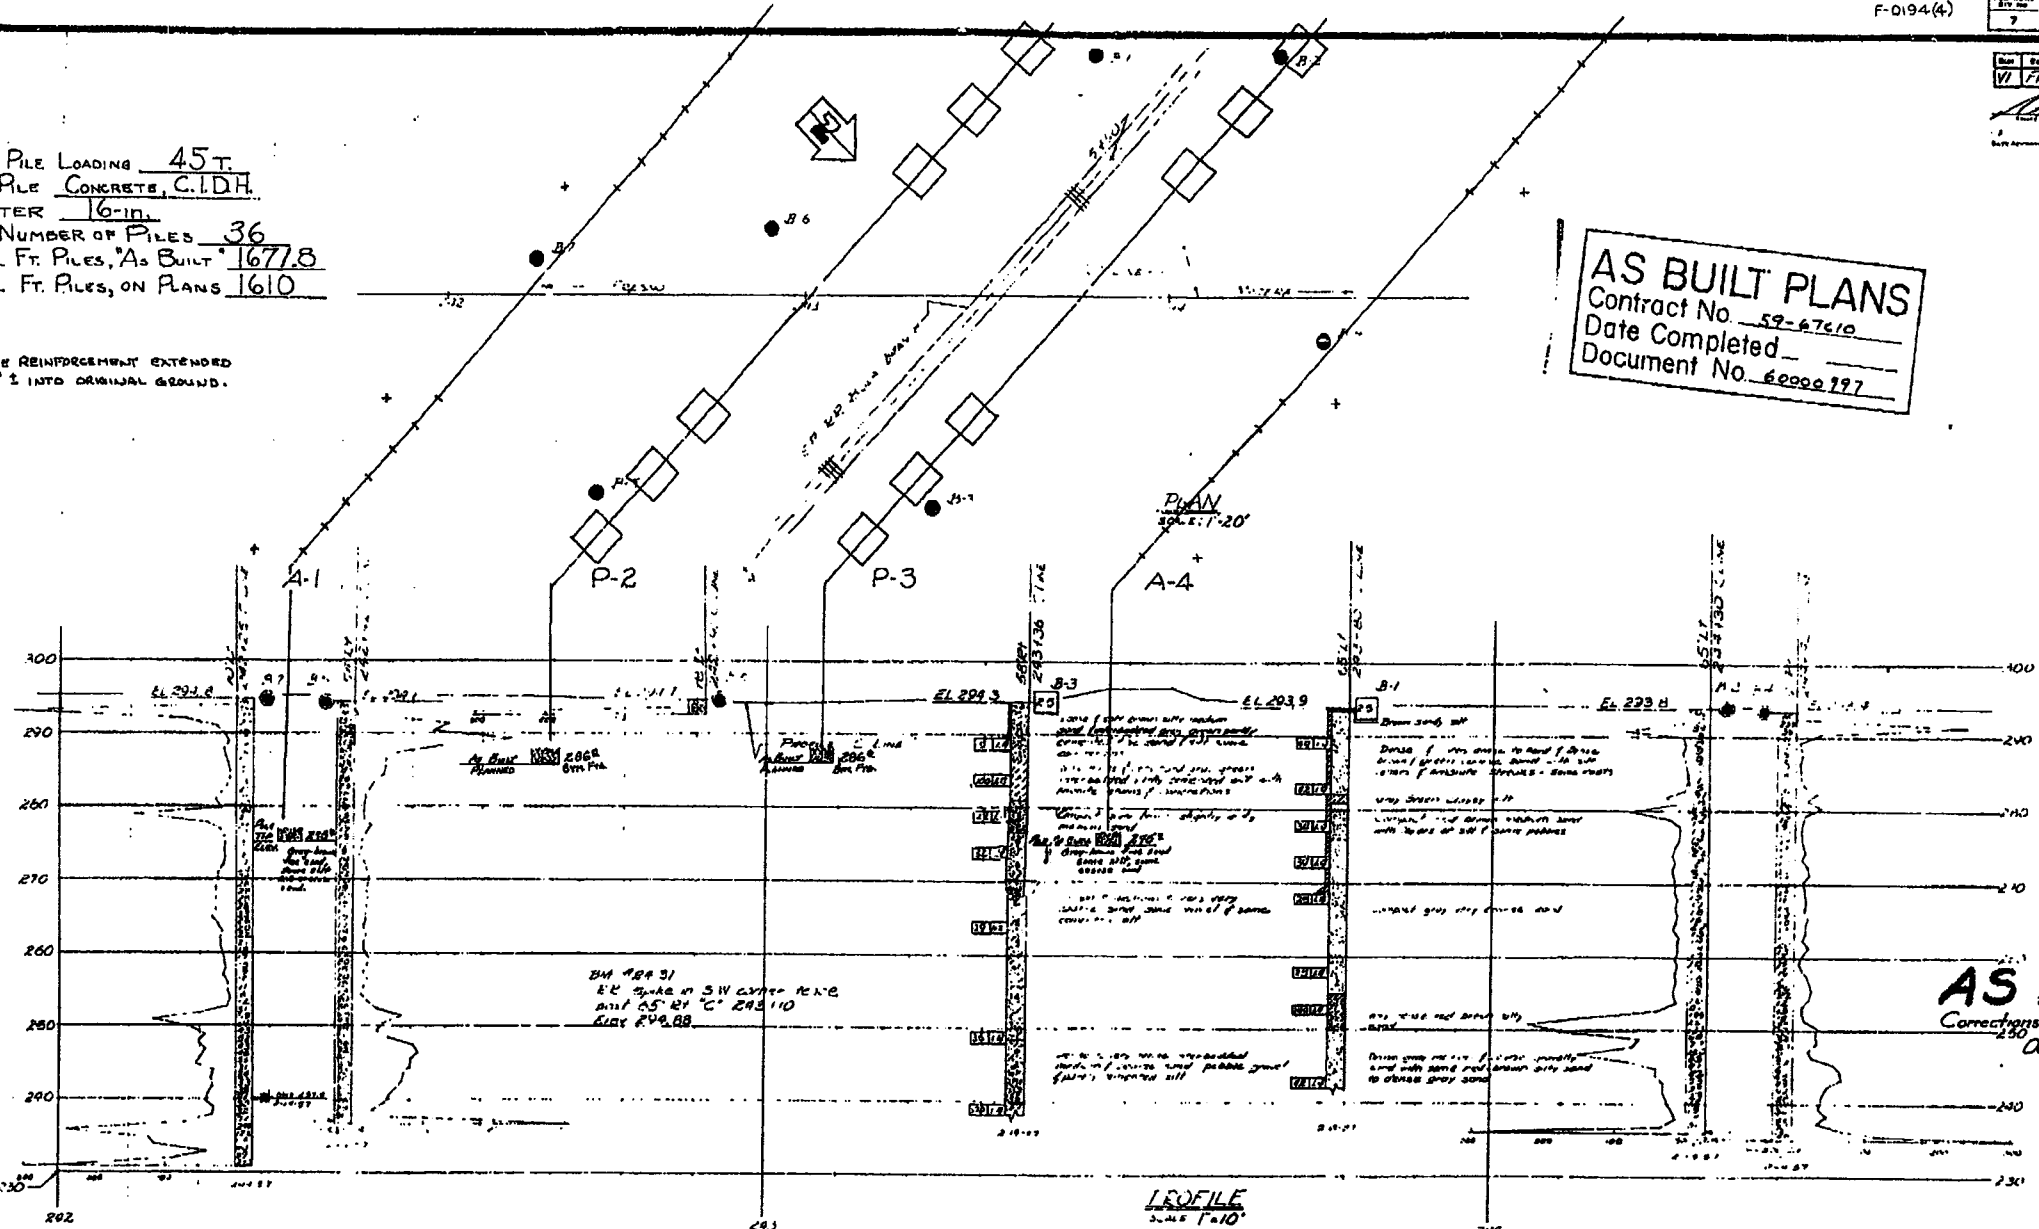

AS BUILT  
Corrections By R. G. Thompson  
Date March 31, 1959


CLASSIFICATION OF MATERIAL BASED ON STANDARD GRADE SIZE LIMITS

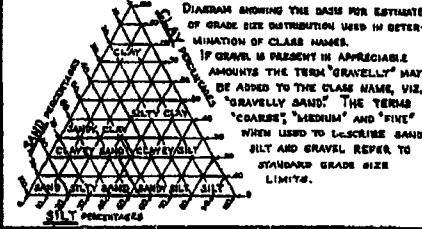

LEGEND OF EARTH MATERIALS

GRAVEL	SILTY CLAY OR CLAYEY SILT
SAND	PEAT AND/OR ORGANIC MATTER
SILT	FILL MATERIAL
CLAY	IGNEOUS ROCK
BANDY CLAY OR CLAYEY SAND	SEDIMENTARY ROCK
SANDY SILT OR SILTY SAND	METAMORPHIC ROCK

LEGEND OF BORING OPERATIONS

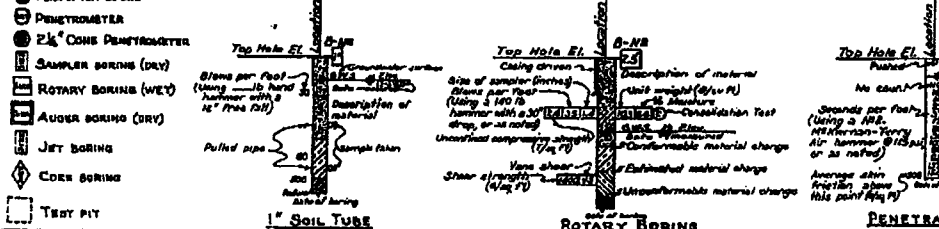

NOTES

The contractor's attention is directed to Section 2, Article (c) of the Standard Specifications and to the Special Provisions accompanying this set of plans. Classification of earth material as shown on this sheet is based upon field inspection and is not to be construed to imply mechanical analysis.

BIOLA JUNCTION O.H.  
LOG OF TEST BORINGS

SCALE AS SHOWN BRIDGE 92-131 1/2 FILE 42 DRAWING 5/197-7

PREL. DRAWING NO. 5/197-10 PR-5/197-3

I HEREBY CERTIFY THAT THIS IS A TRUE AND ACCURATE COPY OF THE ABOVE DOCUMENT TAKEN UNDER MY DIRECTION AND CONTROL ON THIS DATE IN SACRAMENTO, CALIFORNIA PURSUANT TO AUTHORIZATION BY THE DIRECTOR OF PUBLIC WORKS.  
DATE 7/1/59 SIGNATURE: [Signature] TITLE: [Title]



F-0194(4)

DESIGNED BY	STATE	PROJECT NO.	SHEET NO.	TOTAL SHEETS
7	CAL.		170	210


  

DATE	BY	CHECKED	DATE
AUGUST 4 1958			

**AS BUILT PLANS**  
 Contract No. 59-67C10  
 Date Completed \_\_\_\_\_  
 Document No. 60000 227

BRIDGE DEPARTMENT


TBM 'A'  
 RE spike of 'd'  
 284-24.88 POT  
 ELEV 299.57

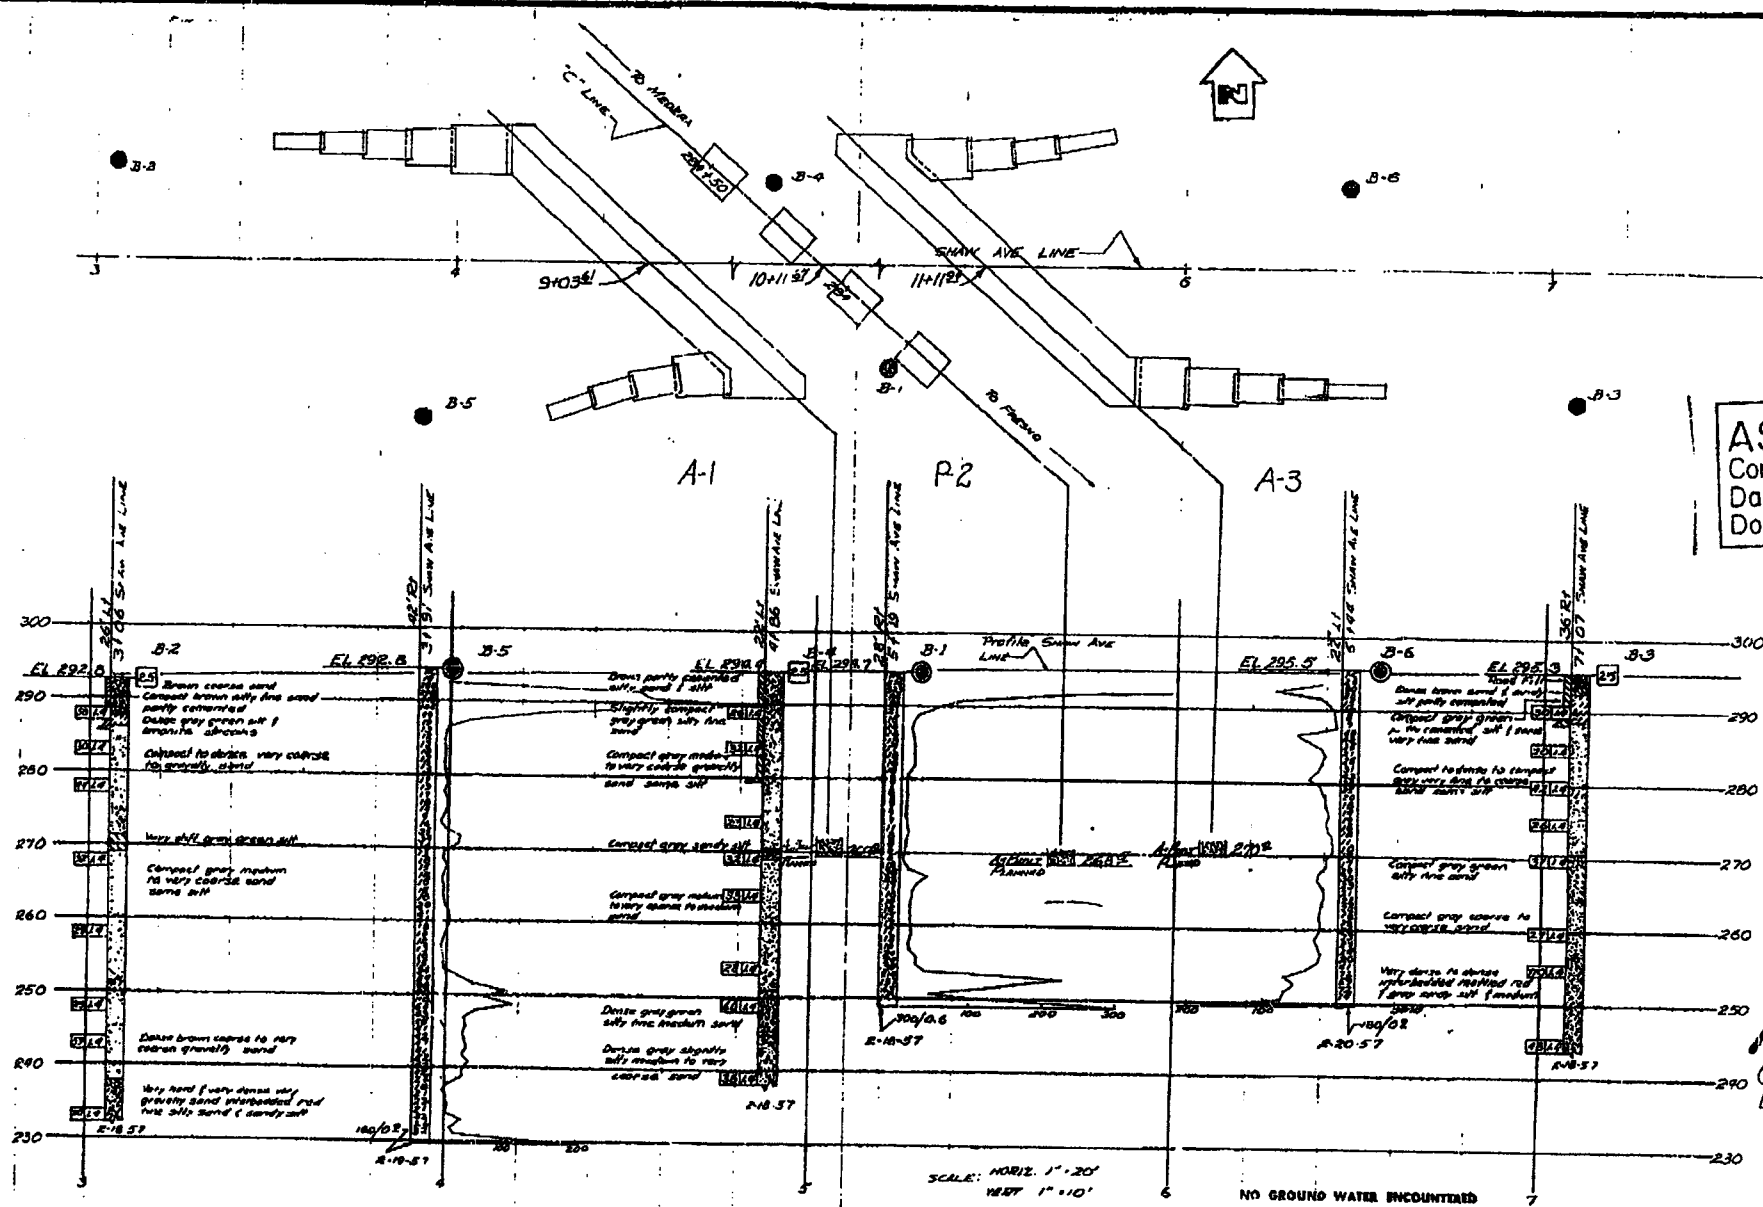

**AS BUILT**  
 Corrections By *R. E. Thompson*  
 Date April 20, 1959


SCALE: HORIZ. 1" = 20'  
 VERT. 1" = 10'

NO GROUND WATER ENCOUNTERED

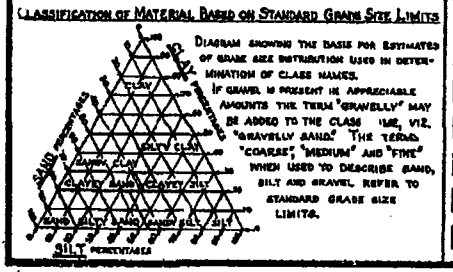

**LEGEND OF EARTH MATERIALS**

GRAVEL	SILTY CLAY OR CLAYEY SILT
SAND	PEAT AND/OR ORGANIC MATTER
SILT	FILL MATERIAL
CLAY	IGNEOUS ROCK
SANDY CLAY OR CLAYEY SAND	SEDIMENTARY ROCK
SANDY SILT OR SILTY SAND	METAMORPHIC ROCK

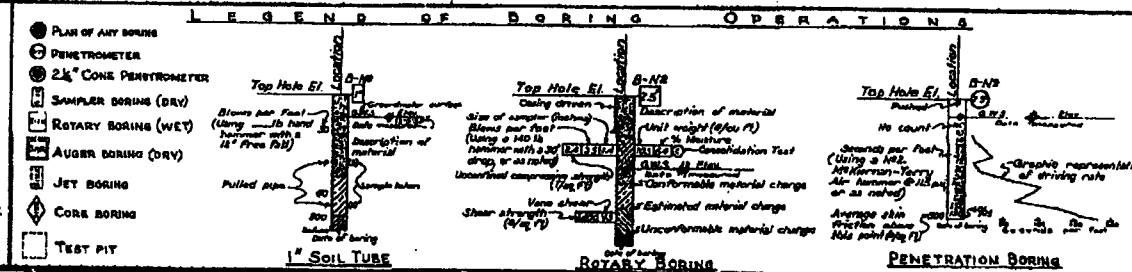

**NOTES**

The contractor's attention is directed to Section 2, Article (c) of the Standard Specifications and to the Special Provisions accompanying this set of plans.

Classification of earth material as shown on this sheet is based upon field inspection and is not to be construed to imply mechanical analysis.

**SHAW AVE OVERCROSSING**  
**LOG OF TEST BORINGS**

SCALE AS SHOWN BRIDGE 42-130 FILE 42 DRAWING C-5294-14

I HEREBY CERTIFY THAT THIS IS A TRUE AND ACCURATE COPY OF THE ABOVE MENTIONED TAKEN UNDER THE DIRECTION AND CONTROL ON THIS DATE IN SACRAMENTO, CALIFORNIA PURSUANT TO AUTHORIZATION BY THE DIRECTOR OF PUBLIC WORKS.

DATE 7/1/61 SIGNATURE: [Signature] TITLE: [Title]

DATE: AUGUST 1 1968

AS BUILT

Corrections by R. E. Hankamp  
date December 2, 1958

AS BUILT PLANS

Contract No. 59-47c10

Date Completed













Date Completed \_\_\_\_\_  
Document No. 60000 197



FIELD STUDY	1. SHOWS OF ACTION 2/5/7
CHARTER	2. SHOWS OF ACTION 2/5/7
CHARTER	3. SHOWS OF ACTION 2/5/7

Approved: *[Signature]*  
*[Signature]*

### LEGEND OF EARTH MATERIALS

	GRAVEL		SILTY CLAY OR CLAYEY SILT
	SAND		PEAT AND/OR ORGANIC MATTER
	SILT		FILL MATERIAL
	CLAY		IGNEOUS ROCK
	SANDY CLAY OR CLAYEY SAND		SEDIMENTARY ROCK
	SANDY SILT OR SILTY SAND		METAMORPHIC ROCK

<p align="center"><u>NOTES</u></p> <p>The contractor's attention is directed to Section 2, Article (c) of the Standard Specifications and to the Special Provisions accompanying this set of plans.</p> <p>Classification of earth material as shown on this sheet is based upon field inspection and is not to be construed to imply endorsement or analysis.</p> <p align="center">STATE OF CALIFORNIA DEPARTMENT OF PUBLIC WORKS DIVISION OF HIGHWAYS</p> <p align="center"><b>HERNDON CANAL</b></p> <p align="center"><b>LOG OF TEST BORINGS</b></p>	
--	--

SCALE AS SHOWN	BRIDGE 42-129	FILE E-42	DRAWING C25333-5
----------------	---------------	-----------	------------------

PR-5333-2

I HEREBY CERTIFY THAT THIS IS A TRUE AND ACCURATE COPY OF THE ABOVE DOCUMENT TAKEN UNDER MY DIRECTION AND CONTROL ON THIS DATE IN SACRAMENTO, CALIFORNIA PURSUANT TO AUTHORIZATION BY THE DIRECTOR OF PUBLIC WORKS.

DATE 9/12/76 SIGNATURE [Signature] TITLE ACIT




DESIGN PILE LOADING: 45T  
ACTUAL NO. PILES: 56  
TYPE PILE USED: Cast-in-drilled-hole  
PILE DIAMETER: 16"  
LINEAL FT. PILES 'AS BUILT': 195.9  
LINEAL FT. PILES ON PLANS: 1190

The State of California and the officials or agents thereof shall not be responsible for the accuracy or completeness of information herein.


AS BUILT

Corrections By *RECHAMP*  
Date December 9, 1958

DIST.	COUNTY	ROUTE	POST MILES - TOTAL PROJECT	POST MILES - THIS SHEET
06	Fres	99	27.3, 28.4	34.42
OFFICE OF ENGINEERING GEOLOGY - DIV. OF HIGHWAY, MAPS & RESEARCH				
11-6-95				
NAME: APPROVAL: DATE				
HERNDON CANAL BRIDGE (WIDEN)				
LOG OF TEST BORINGS 2 OF 2				
NOTE: THIS LOG OF TEST BORINGS IS AVAILABLE ON MICROFILM AT OFFICE OF STRUCTURES, DESIGN ENGINEERING, CALIFORNIA				
CIA DESIG	BRIDGE NO.			
BR-318421	45-129			

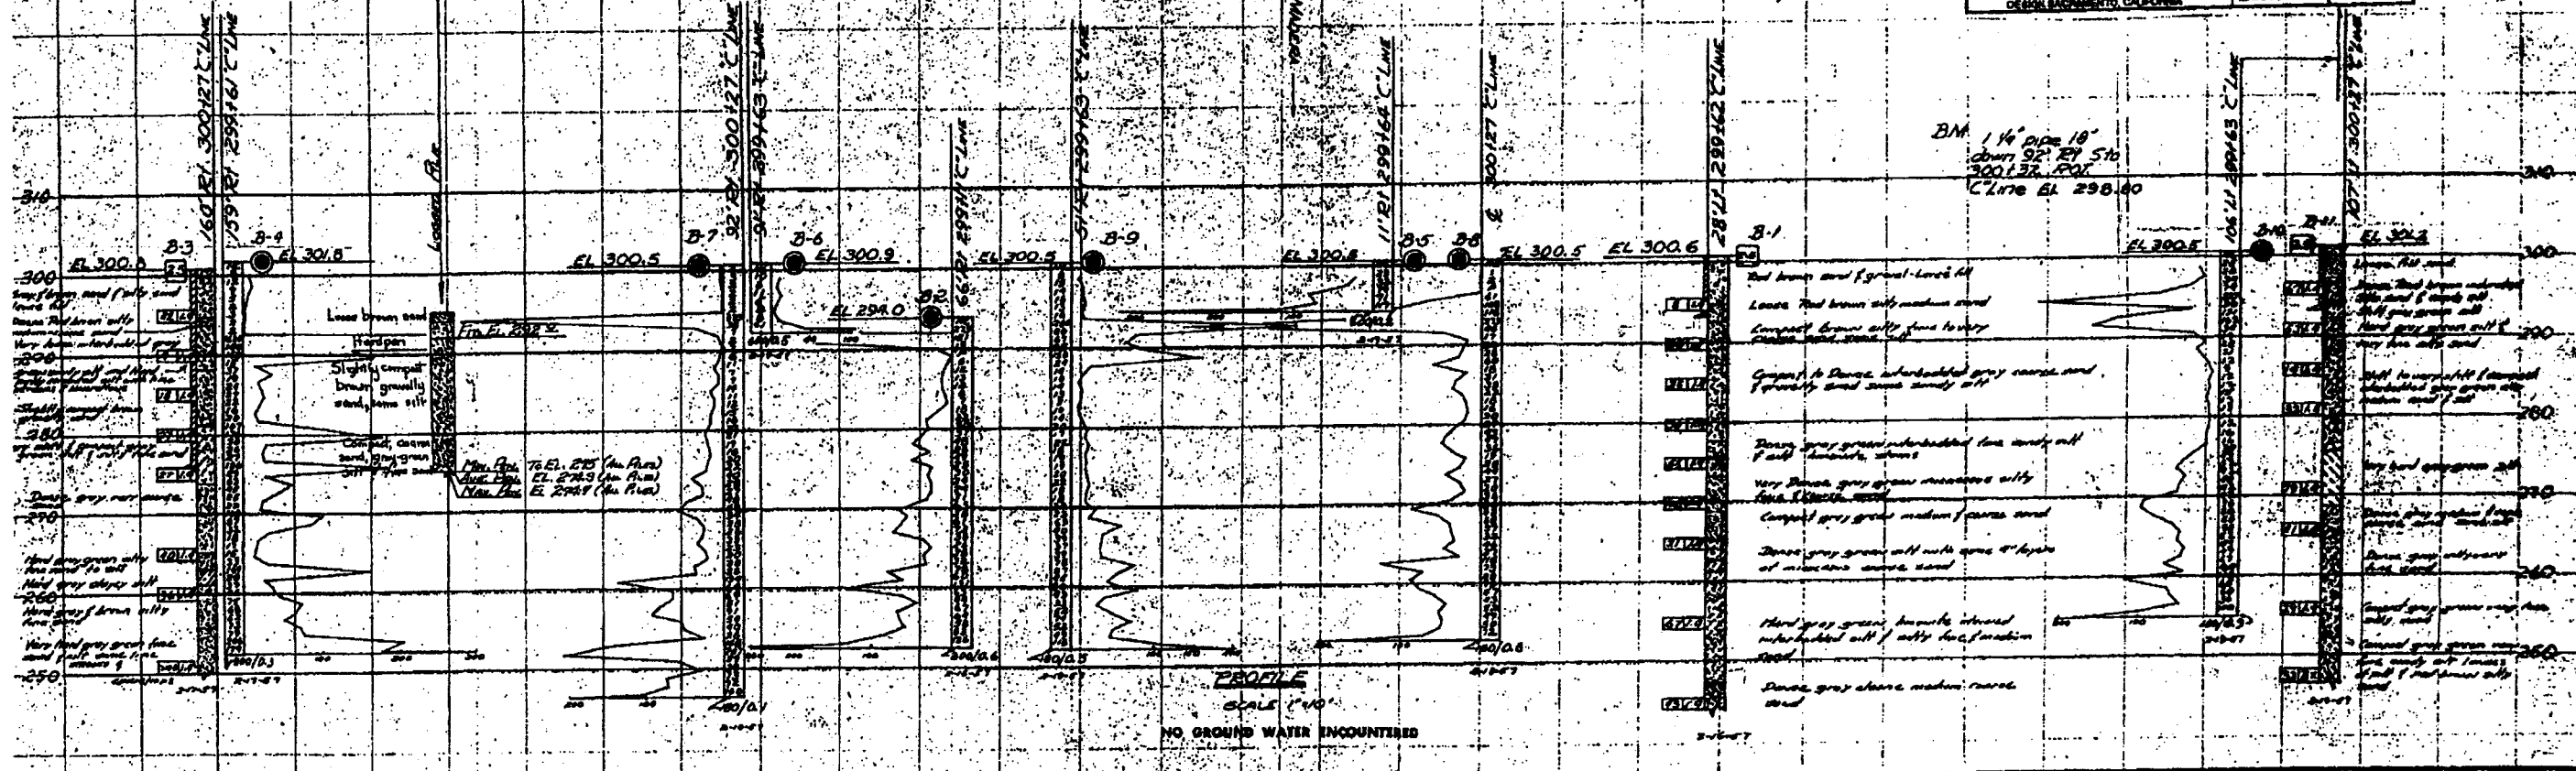

CLASSIFICATION OF MATERIAL BASED ON STANDARD GRADE SIZE LIMITS

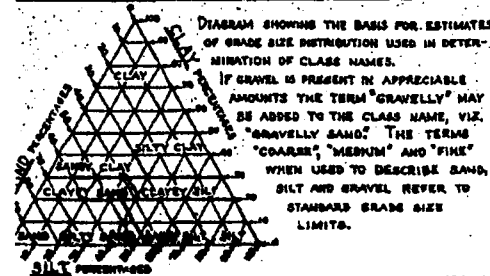


LEGEND OF EARTH MATERIALS

- |                           |                            |
|---------------------------|----------------------------|
| GRAVEL                    | SILTY CLAY OR CLAYEY SILT  |
| SAND                      | PEAT AND/OR ORGANIC MATTER |
| SILT                      | FILL MATERIAL              |
| CLAY                      | IGNEOUS ROCK               |
| SANDY CLAY OR CLAYEY SAND | SEDIMENTARY ROCK           |
| SANDY SILT OR SILTY SAND  | METAMORPHIC ROCK           |

- PLAN OF ANY BORING  
PENETROMETER  
2 1/2" CONE PENETROMETER  
SAMPLER BORING (DRY)  
ROTARY BORING (WET)  
AUGER BORING (DRY)  
JET BORING  
CORE BORING  
TEST PIT

LEGEND OF BORING OPERATIONS

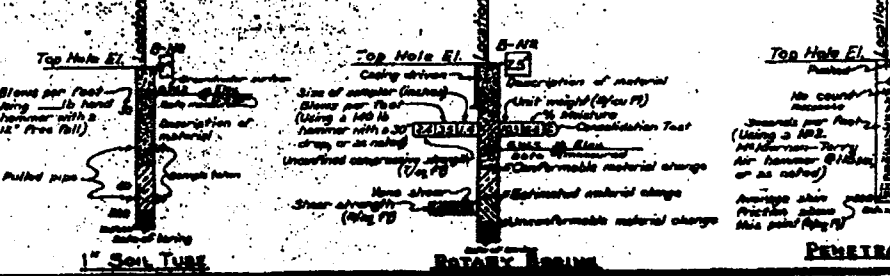

NOTES

The contractor's attention is directed to Section 2, Article (c) of the Standard Specifications and to the Special Provisions accompanying this set of plans. Classification of earth material as shown on this sheet is based upon field inspection and is not to be construed to imply mechanical samples.

HERNDON CANAL

LOG OF TEST BORINGS NO. 2


Scale As Shown	BRIDGE 45-129	PLAN E-42	BRIDGE C-5333-5
SHEET 14		OF 14	
PR-5333-2			

LEGEND OF BORING OPERATIONS

LEGEND OF EARTH MATERIALS

CONSISTENCY CLASSIFICATION

NOTE: Classification of earth material as shown on this sheet is based upon field inspection and is not to be considered as a final recommendation.

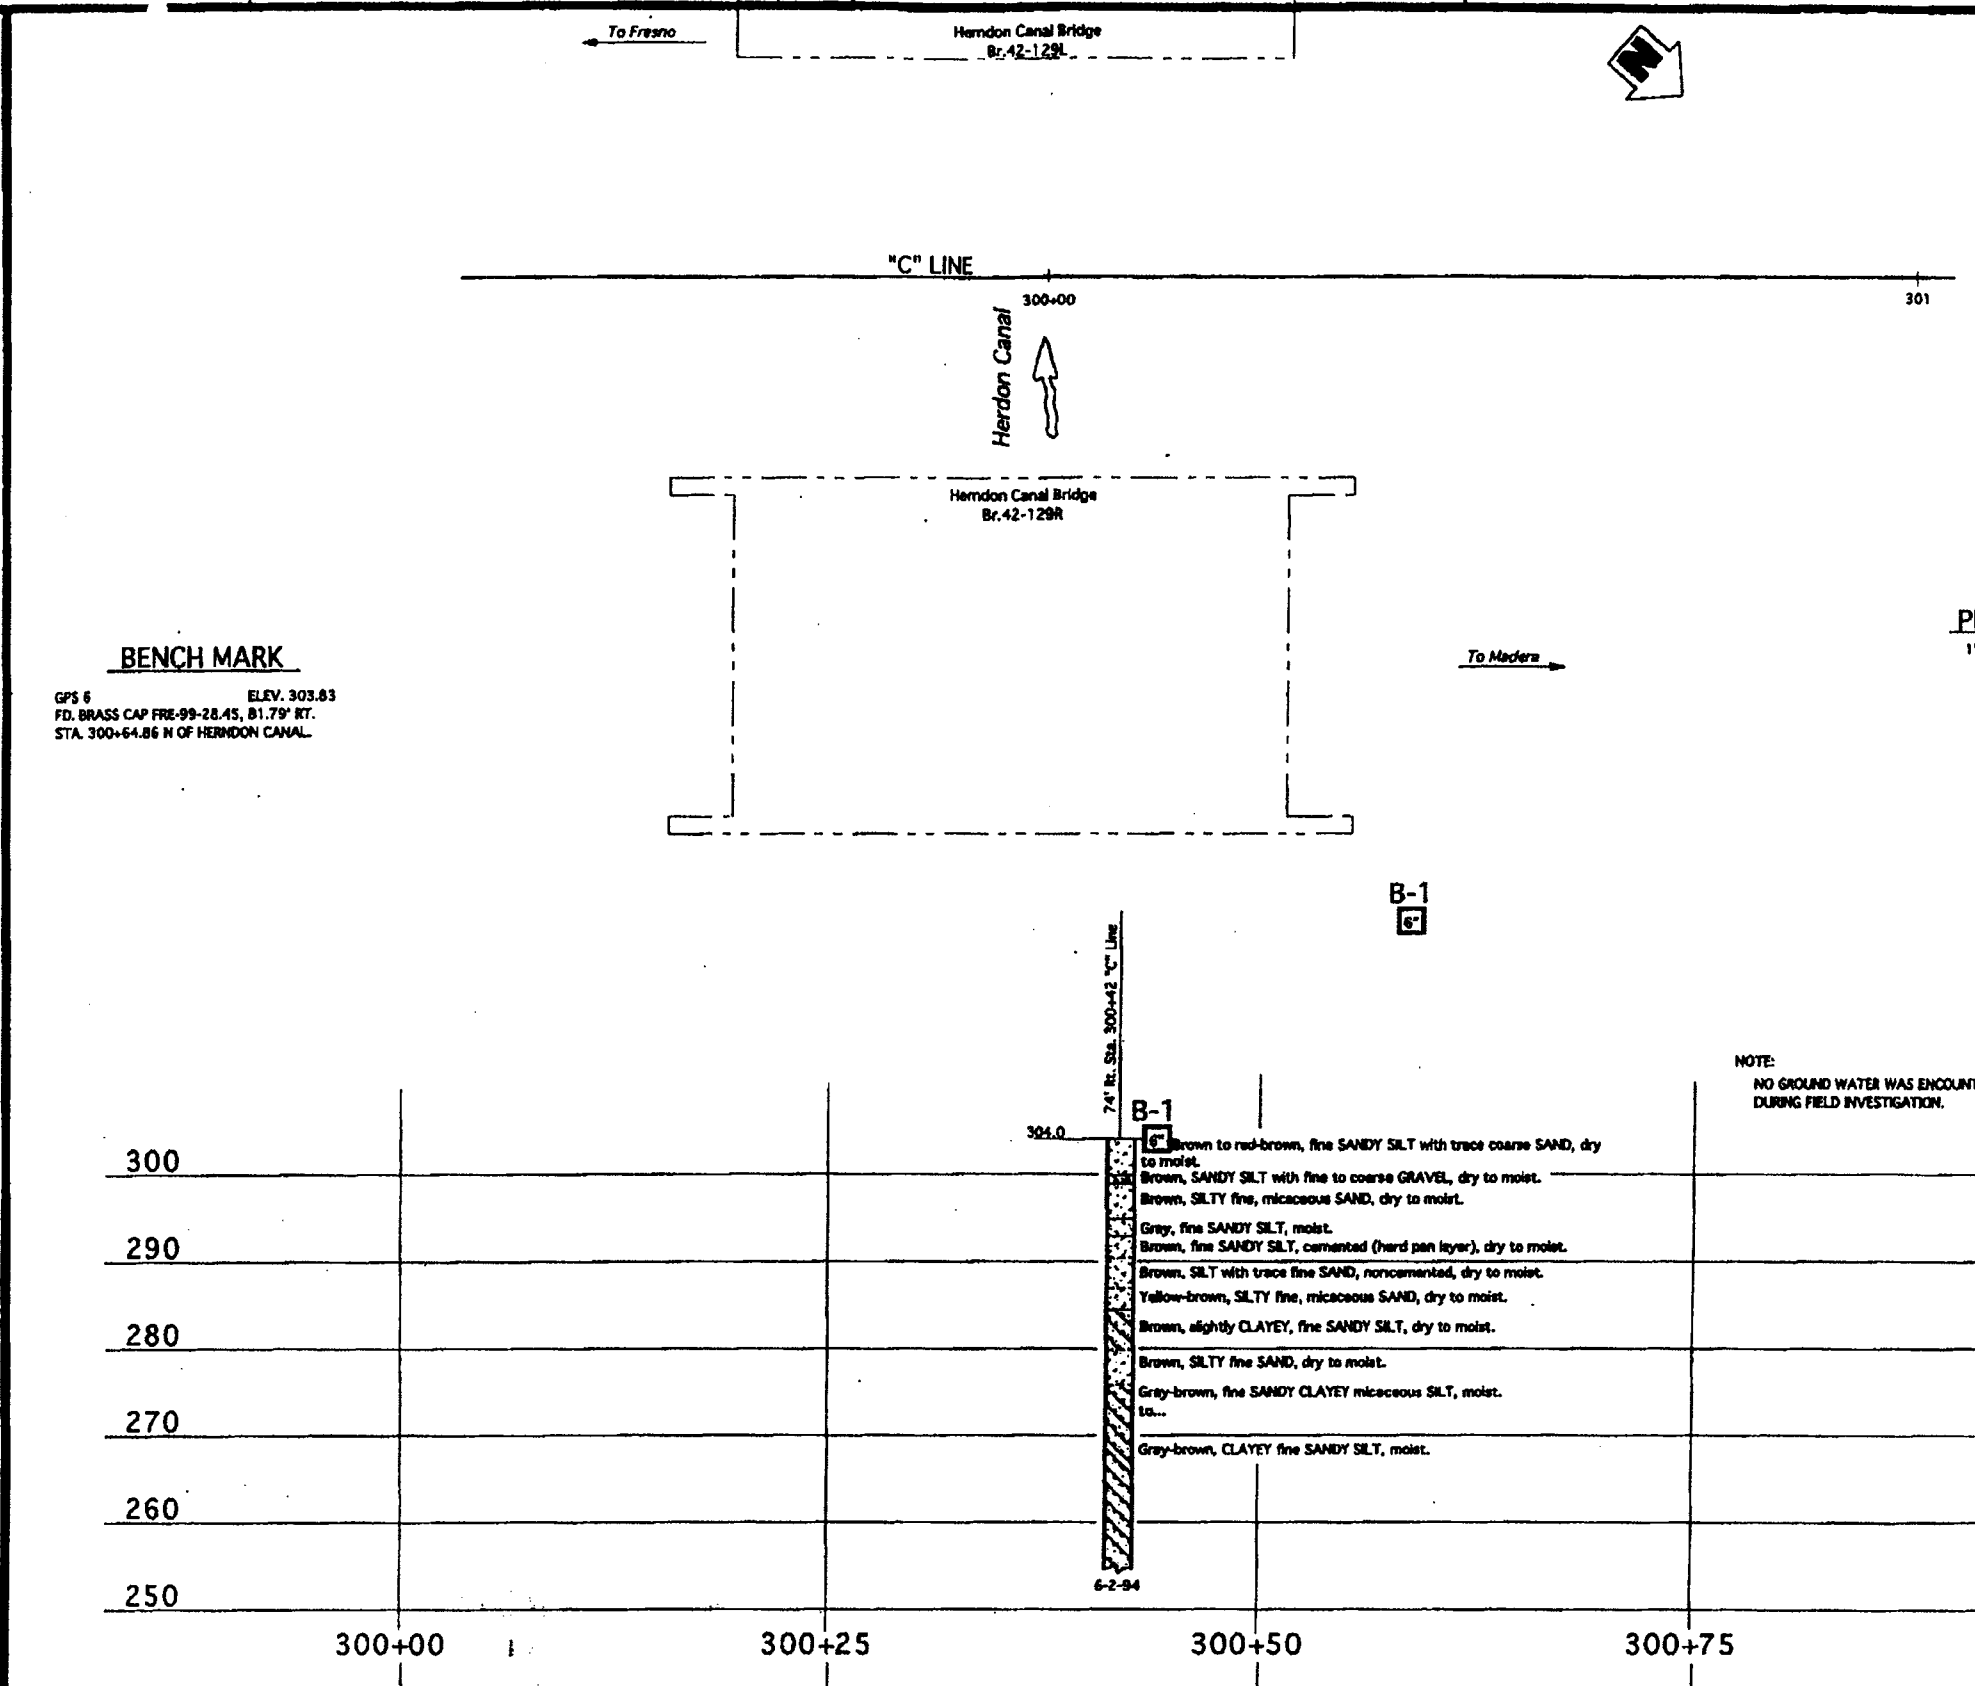

DIVISION OF NEW TECHNOLOGY, MATERIALS AND RESEARCH		OFFICE OF ENGINEERING GEOLOGY		FIELD INVESTIGATION BY: J. THORNE		State of CALIFORNIA DEPARTMENT OF TRANSPORTATION		DIVISION OF STRUCTURES STRUCTURE DESIGN		BRIDGE NO. 42-129R POST MILE 28.4		HERNDON CANAL BRIDGE (WIDEN) LOG OF TEST BORINGS NO. 1	
DRAWN BY: J. W. M.	7/94	CHECKED BY:		CU 06255 EA 318421		DISREGARD PRINTS BEARING EARLIER REVISION DATES		REVISION DATES (PRELIMINARY STAGE ON VI)					

DIST. 06	COUNTY Fre	ROUTE 99	POST MILES TOTAL PROJECT 27.3, 28.4	SHEET NO. 33	TOTAL SHEETS 42
P. W. J.			R. W. FOX		
CERTIFIED ENGINEERING GEOLOGIST			No. 8-31-95		
11-6-95			PLANS APPROVAL DATE		

The State of California or its officers or agents shall not be responsible for the accuracy or completeness of electronic copies of this plan sheet.



F-0194(4)

FED. ROAD DIST. NO.	STATE	PROJECT NO.	SHEET NO.	TOTAL SHEETS
7	CAL.		196	210


DATE	BY	CHKD	APP'D	DATE
VI	Pro			

DATE APPROVED: AUGUST 1, 1958

BRIDGE DEPARTMENT

BM 4050  
CHISELED SQUARE IN NORTH END  
EAST MEASUREMENT ON GUY WIRE 70' 11" ±  
4051.02 ELEV. 274.93

TYPE PILE USED: Cast-in-Drilled-Hole  
PILE DIAMETER: 16"  
LINEAL FT. PILES, AS BUILT: 2776.4  
LINEAL FT. PILES, ON PLANS: 2720  
SPECIFIED PILE LOADING: 45 T  
ACTUAL NO. PILES: 142


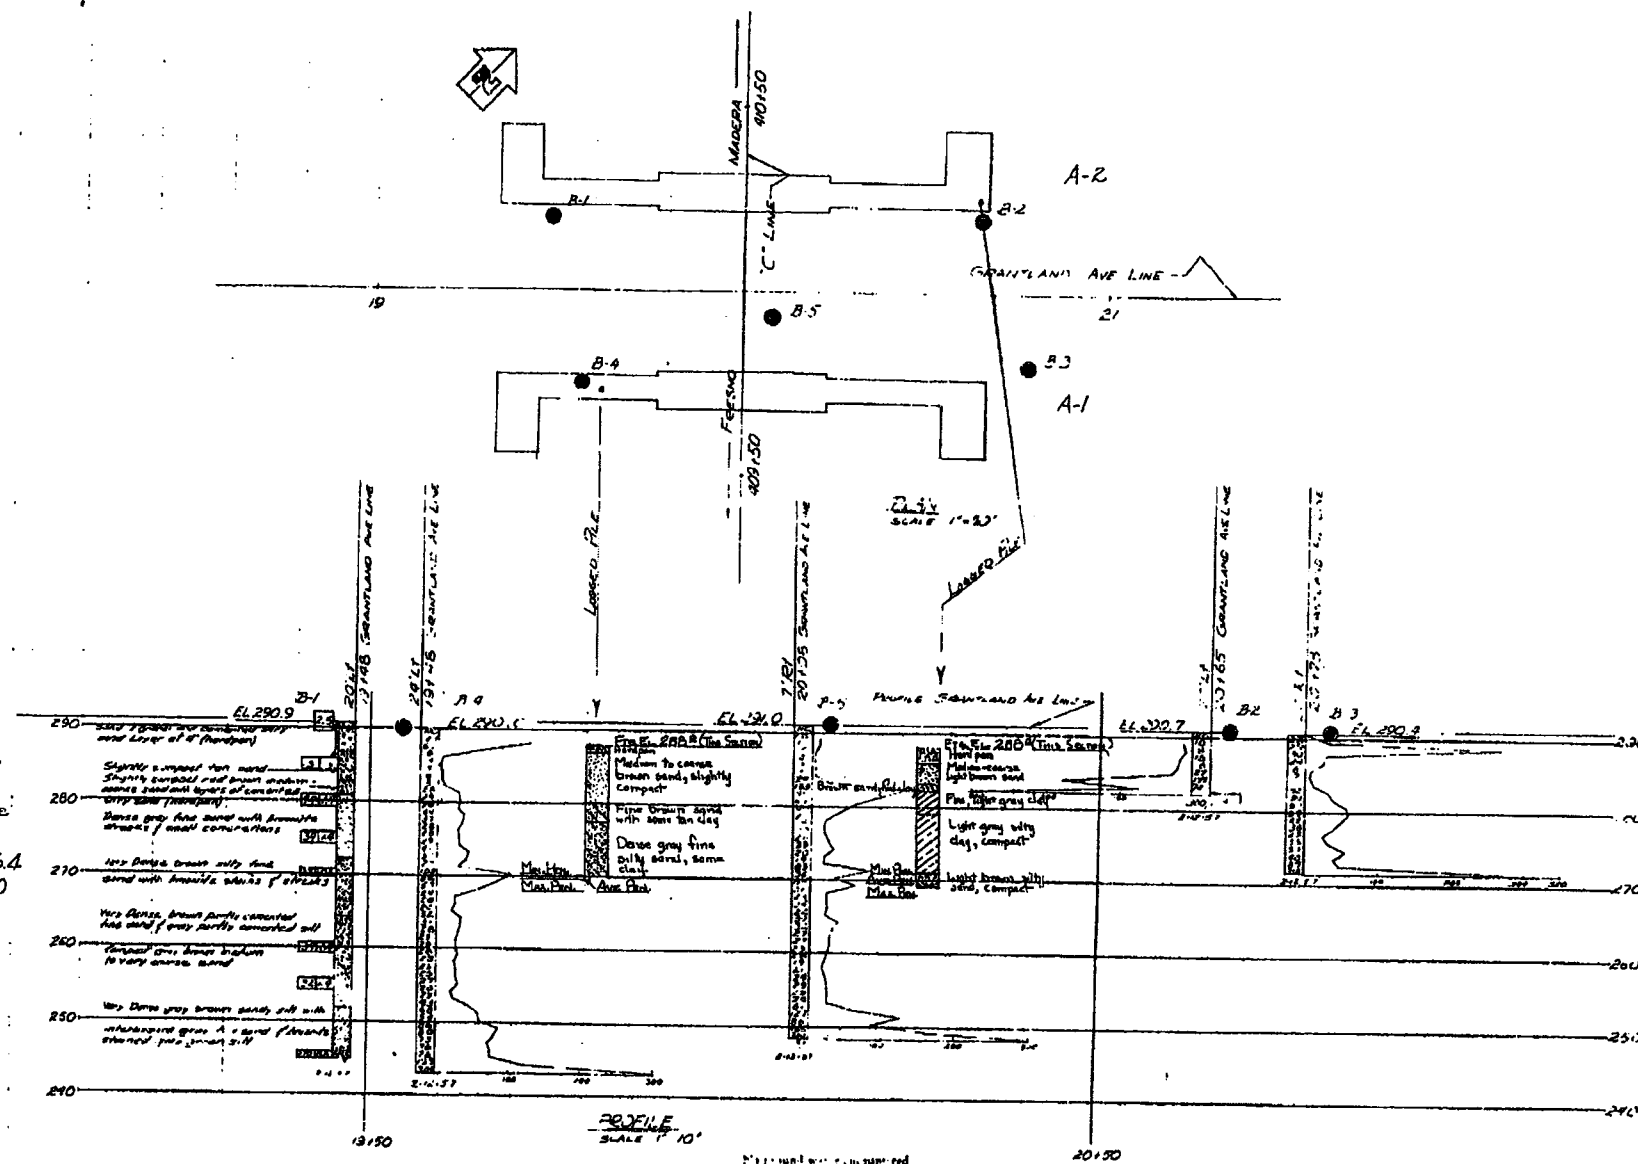


F-0194(4)

YEAR	STATE	PROJECT	SHEET	DATE
7	CAL.		204	210


DATE	BY	CHKD	APPD	DATE
7/1	Fre	6	5	8

DATE AUGUST 1, 1958

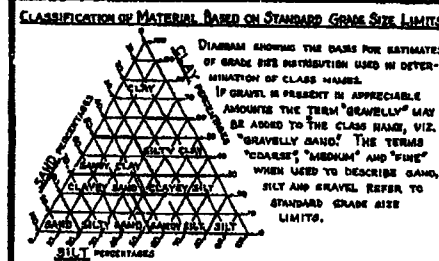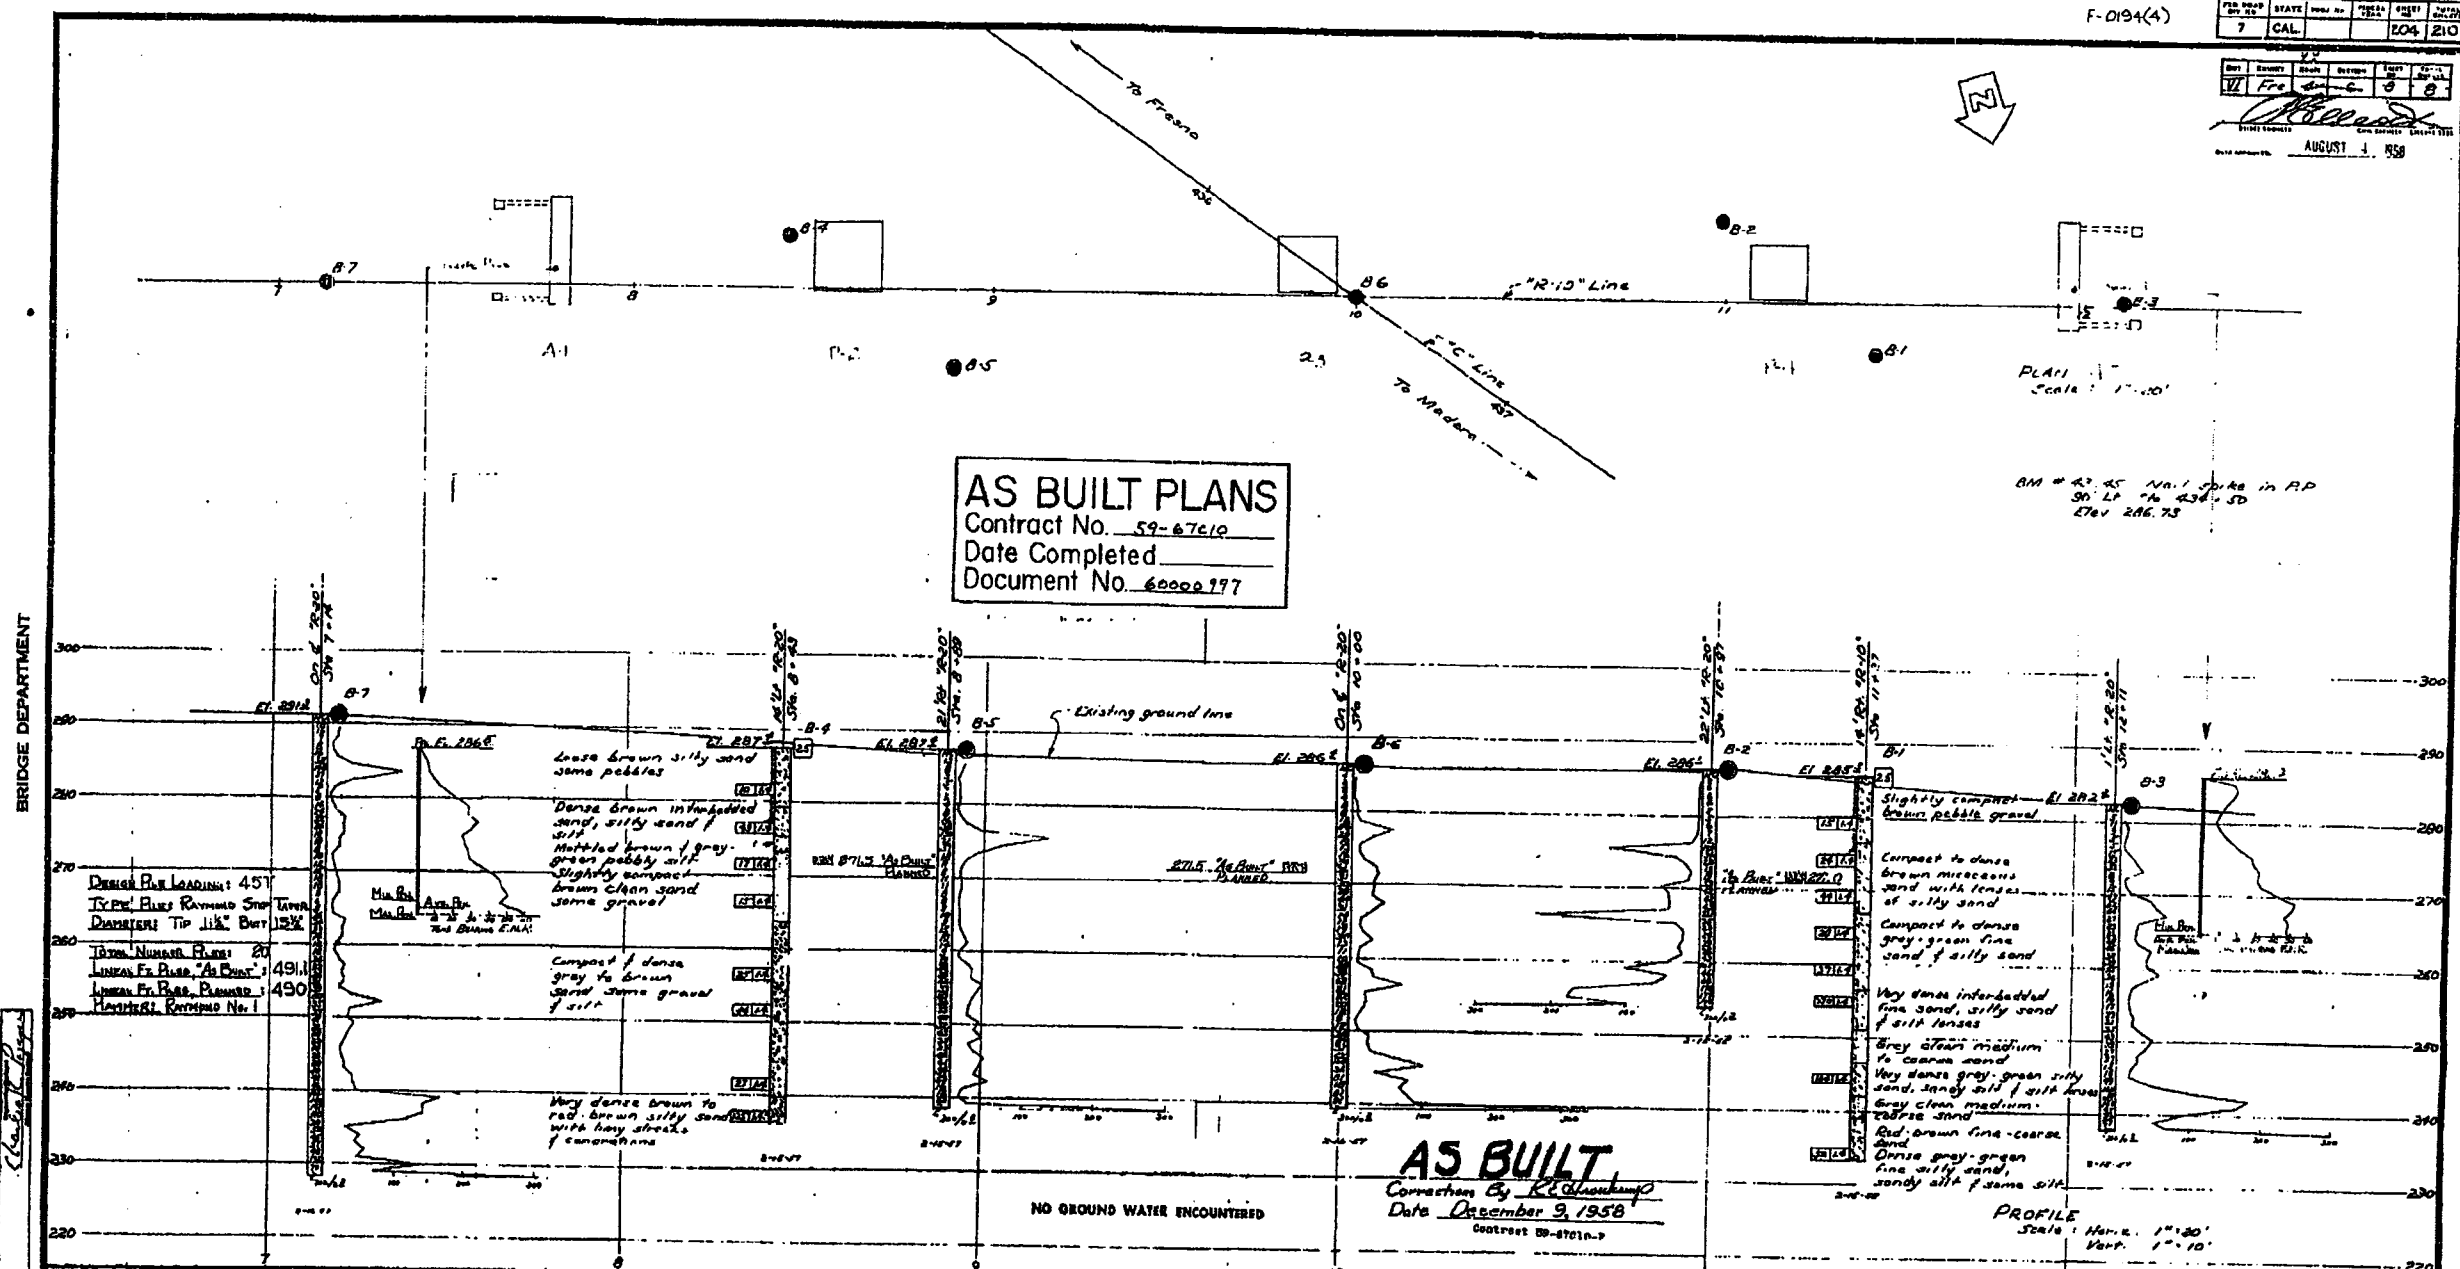

**LEGEND OF EARTH MATERIALS**

GRAVEL	SILTY CLAY OR CLAYEY SILT
SAND	PEAT AND/OR ORGANIC MATTER
SILT	FILL MATERIAL
CLAY	IGNEOUS ROCK
SANDY CLAY OR CLAYEY SAND	SEDIMENTARY ROCK
SANDY SILT OR SILTY SAND	METAMORPHIC ROCK

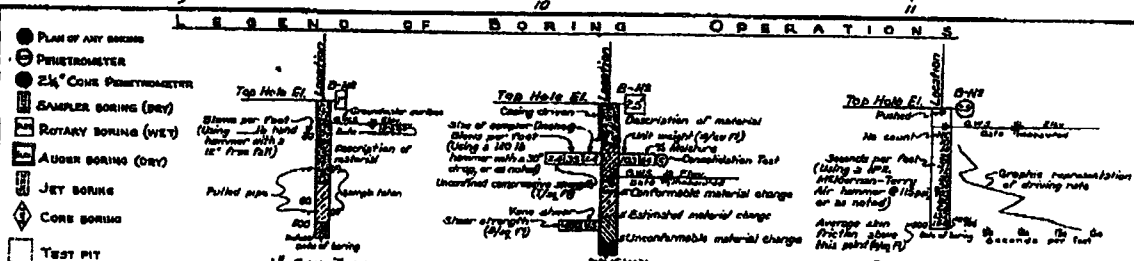

**NOTES**

The contractor's attention is directed to Section 2, Article (c) of the Standard Specifications and to the Special Provisions accompanying this set of plans.

Classification of earth material as shown on this sheet is based upon field inspection and is not to be construed to imply mechanical analysis.

STATE OF CALIFORNIA  
 DEPARTMENT OF PUBLIC WORKS  
 DIVISION OF HIGHWAYS

**HERNDON OVERCROSSING**

**LOG OF TEST BORINGS**

SCALE: As Noted BRIDGE 42-126 FILE: DRAWING C-5391-8

PREL. DRAWING NO. 5391-8


I HEREBY CERTIFY THAT THIS IS A TRUE AND ACCURATE COPY OF THE ABOVE DOCUMENT TAKEN UNDER MY DIRECTION AND CONTROL ON THIS DATE IN SACRAMENTO, CALIFORNIA PURSUANT TO AUTHORIZATION BY THE DIRECTOR OF PUBLIC WORKS.

DATE 7/1/54 SIGNATURE TITLE





BRIDGE DEPARTMENT

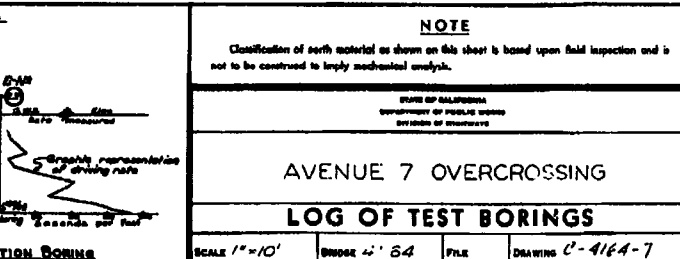

I HEREBY CERTIFY THAT THIS IS A TRUE AND ACCURATE COPY OF THE ABOVE DOCUMENT TAKEN UNDER MY DIRECTION AND CONTROL ON THIS DATE IN SACRAMENTO, CALIFORNIA PURSUANT TO AUTHORIZATION BY THE DIRECTOR OF PUBLIC WORKS.

DATE 12-22 SIGNATURE James E. Ginn TITLE SA




AS BUILT PLANS  
 Contract No. 63-6T1367  
 Date Completed  
 Document No. 60001065  
 September 24, 1962

BM #1.46  
 RR Spike in PP 19' L  
 "OC" 14+59  
 Elev. 202.307

PLAN  
 Scale: 1" = 20'


AS BUILT PLANS  
 Contract No. 63-6T1367  
 Date Completed  
 Document No. 60001065

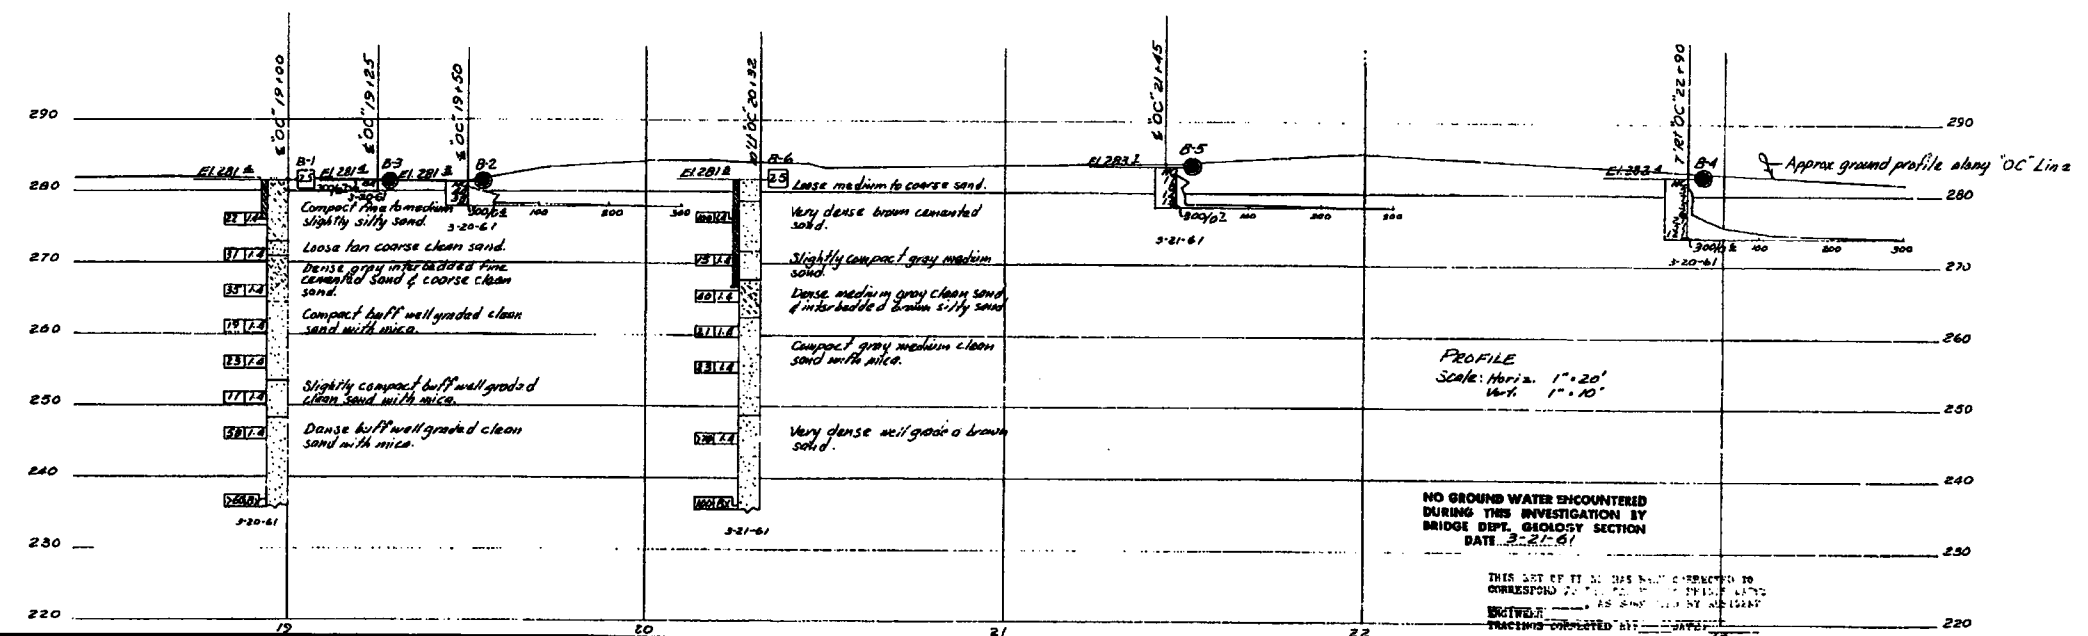

PROFILE  
 Scale: Horiz. 1" = 20'  
 Vert. 1" = 10'


NO GROUND WATER ENCOUNTERED  
 DURING THIS INVESTIGATION BY  
 BRIDGE DEPT. GEOLOGY SECTION  
 DATE 3-21-61

THIS SET OF PLANS HAS BEEN CORRECTED TO  
 CORRESPOND TO THE FIELD RECORDS  
 AS SHOWN BY THE  
 BRIDGE DEPT. GEOLOGY SECTION  
 DATE 3-21-61

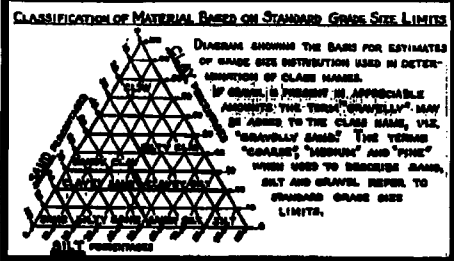

LEGEND OF EARTH MATERIALS

GRAVEL	SILTY CLAY OR CLAYEY SILT
SAND	PEAT AND ORGANIC MATTER
SILT	FILL MATERIAL
CLAY	IGNEOUS ROCK
SANDY CLAY OR CLAYEY SAND	SEDIMENTARY ROCK
SANDY SILT OR SILTY SAND	METAMORPHIC ROCK

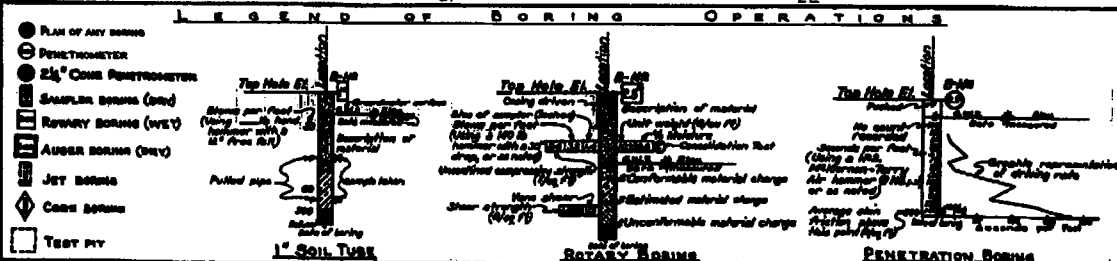

NOTE

Classification of earth material as shown on this sheet is based upon field inspection and is not to be construed as a laboratory analysis.

AVENUE 8 O.C.

LOG OF TEST BORINGS

Scale As Noted

Sheet 41-60

File



Drawn C-4160-7

PR-1160-4

I HEREBY CERTIFY THAT THIS IS A TRUE AND ACCURATE COPY OF THE ABOVE DOCUMENT TAKEN  
 UNDER MY DIRECTION AND CONTROL ON THIS DATE IN SACRAMENTO, CALIFORNIA PURSUANT TO  
 AUTHORIZATION BY THE DIRECTOR OF PUBLIC WORKS  
 DATE 1-17-72 SIGNATURE [Signature] TITLE SR 12110


BRIDGE DEPARTMENT

**AS BUILT PLANS**  
 Contract No. 63-6T13C7  
 Date Completed             
 Document No. 60001065

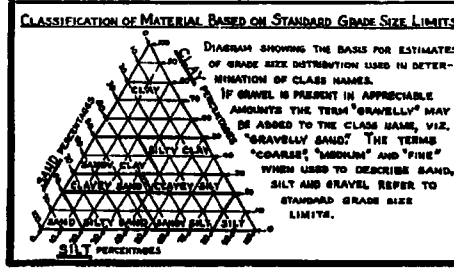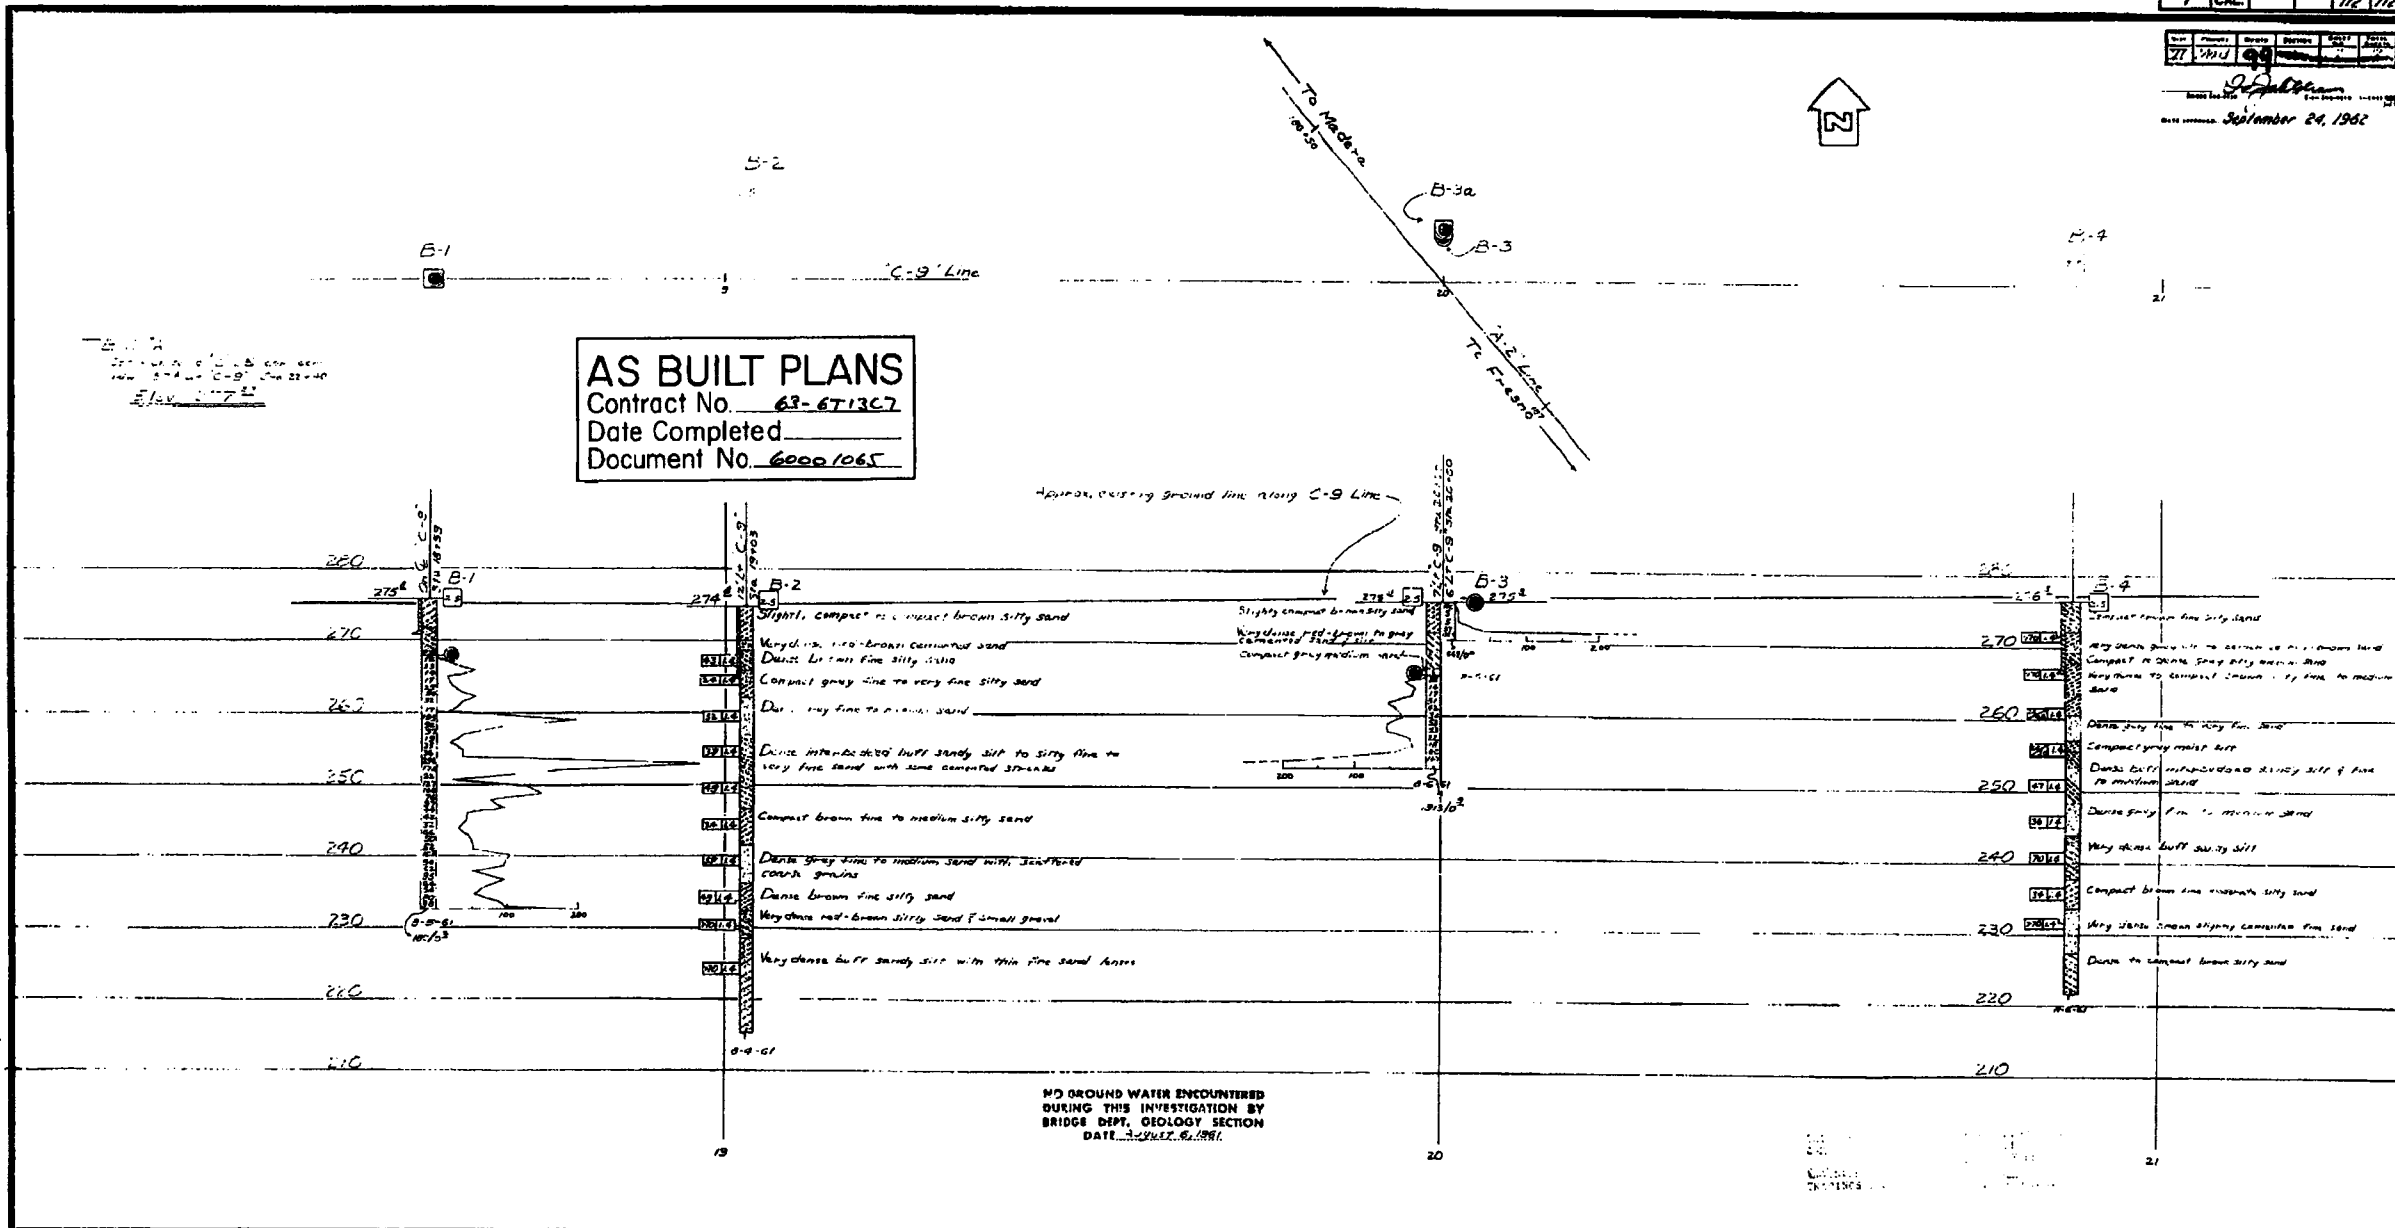

**LEGEND OF EARTH MATERIALS**

GRAVEL	SILTY CLAY OR CLAYEY SILT
SAND	PEAT AND/OR ORGANIC MATTER
SILT	FILL MATERIAL
CLAY	IGNEOUS ROCK
SANDY CLAY OR CLAYEY SAND	SEDIMENTARY ROCK
SANDY SILT OR SILTY SAND	METAMORPHIC ROCK

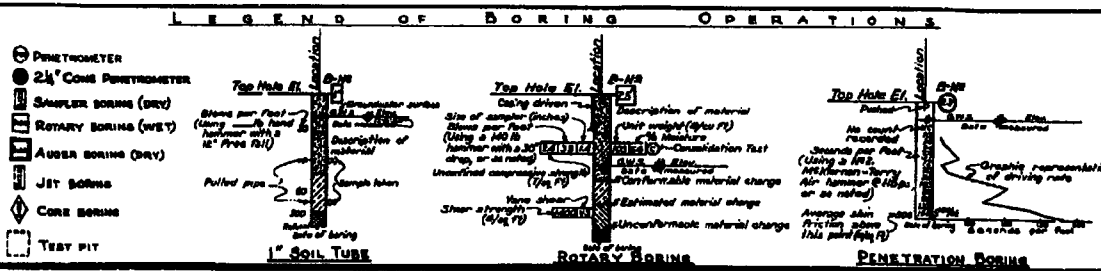

**NOTE**  
 Classification of earth material as shown on this sheet is based upon field inspection and is not to be construed to imply mechanical analysis.

**LOG OF TEST BORINGS**

SCALE 1"=10' BORING 4163 FILE DRAWING C-4163-1


I HEREBY CERTIFY THAT THIS IS A TRUE AND ACCURATE COPY OF THE ABOVE DOCUMENT TAKEN UNDER MY DIRECTION AND CONTROL ON THIS DATE IN SACRAMENTO, CALIFORNIA PURSUANT TO AUTHORIZATION BY THE DIRECTOR OF PUBLIC WORKS.

DATE 11-2-71 SIGNATURE [Signature] TITLE Engineer



BRIDGE DEPARTMENT


**AS BUILT PLANS**  
 Contract No. 62-5712(11)  
 Date Completed 6-20-61  
 Document No. 60001022

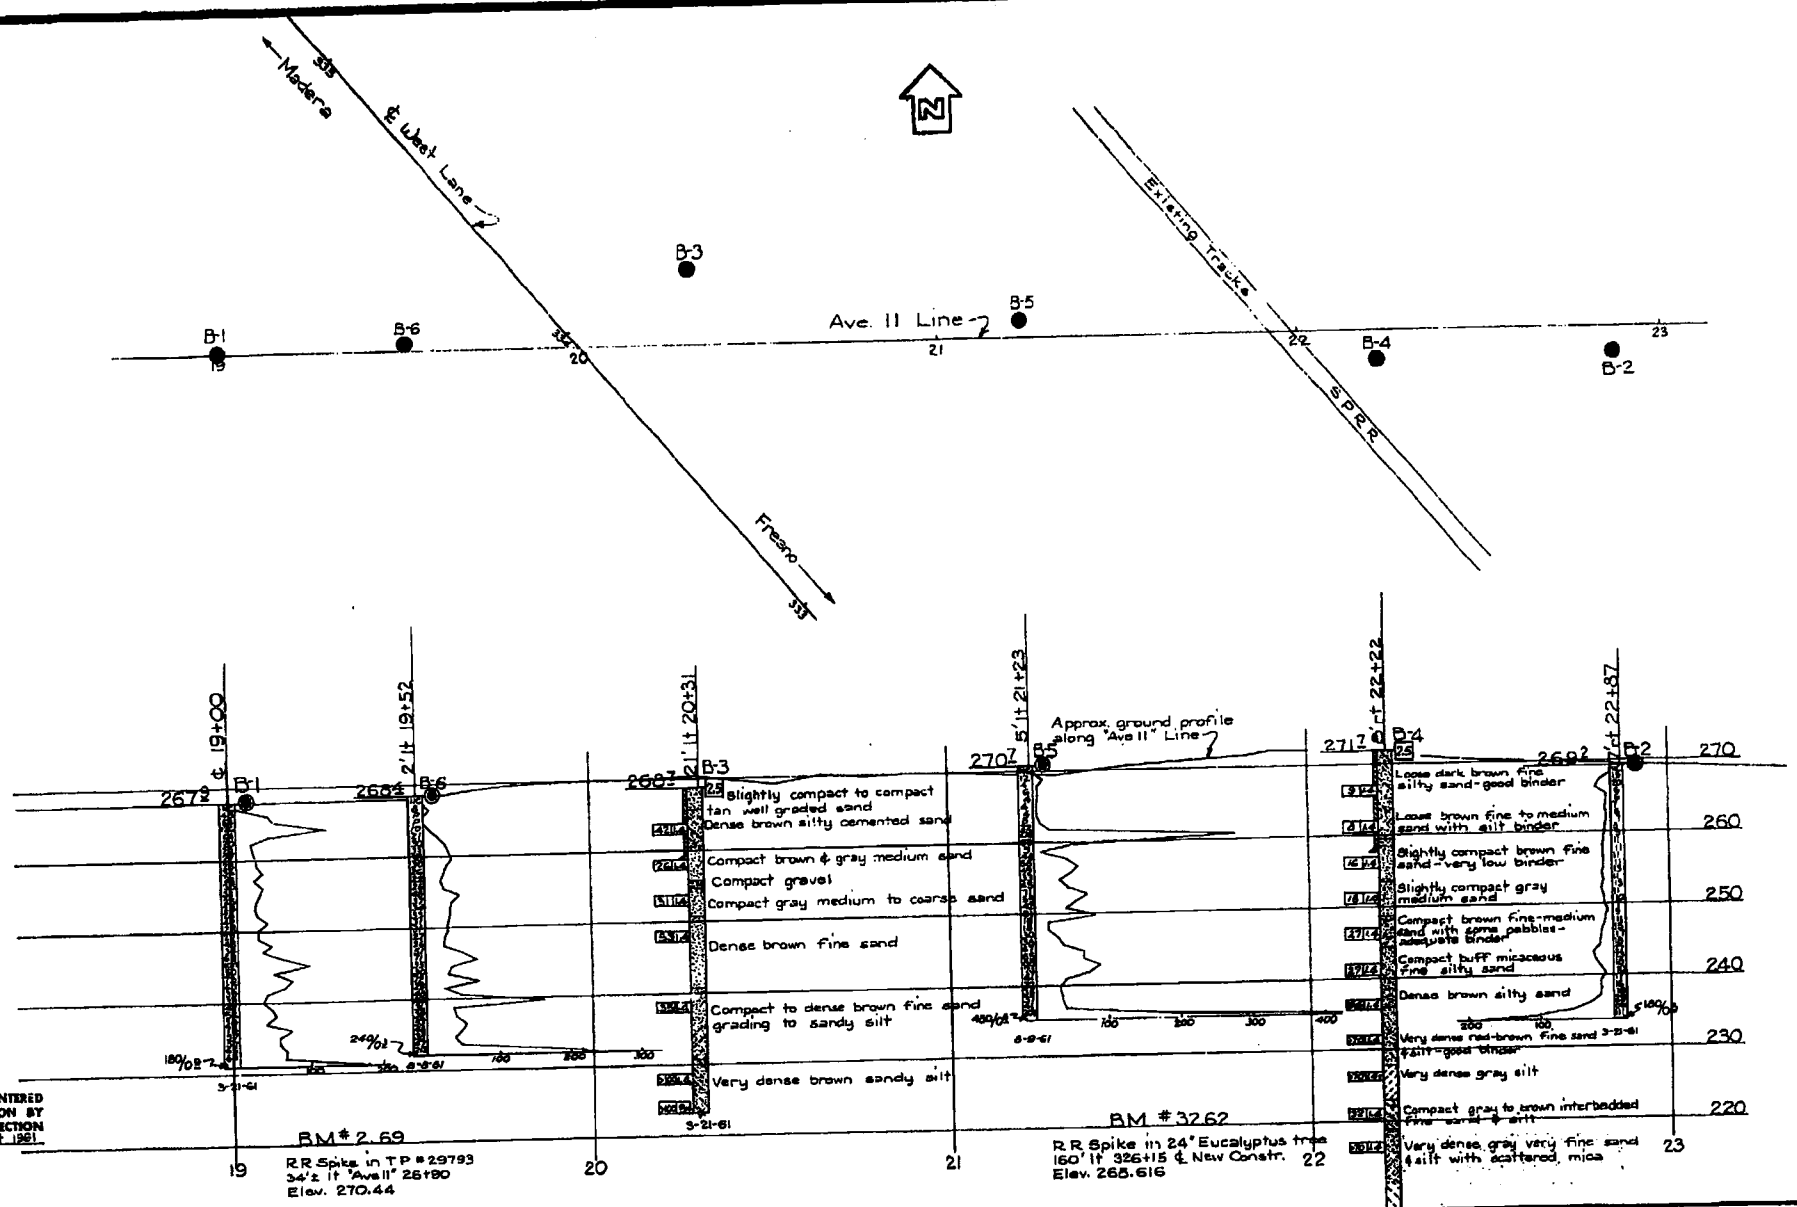

NO GROUND WATER ENCOUNTERED DURING THIS INVESTIGATION BY BRIDGE DEPT. GEOLOGY SECTION DATE March & August 1961

BM #2.69  
 RR Spike in T.P. #29793  
 34' x 1" "Ave. II" 26180  
 Elev. 270.44




BM #32.62  
 RR Spike in 24' Eucalyptus tree  
 160' 1" 326+15 & New Constr. 22  
 Elev. 265.616

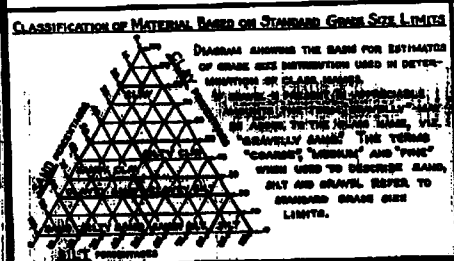

**LEGEND OF EARTH MATERIALS**

GRAVEL	SILTY CLAY OR CLAYEY SILT
SAND	CLAYEY SAND
SILT	FILL MATERIAL
CLAY	IGNEOUS ROCK
SANDY CLAY OR CLAYEY SAND	SEDIMENTARY ROCK
SANDY SILT OR SILTY SAND	METAMORPHIC ROCK

- LEGEND OF BORING OPERATIONS**
- PLAN OF ANY BORING
  - PERCENTIMETER
  - 2 1/2" CONE PERCENTIMETER
  - APPROX. BORING (SHE)
  - APPROX. BORING (SHE)
  - APPROX. BORING (SHE)
  - JET BORING
  - CONE BORING
  - TEST PIT

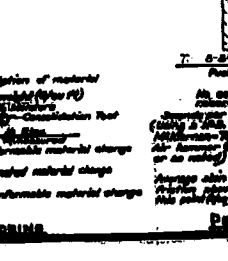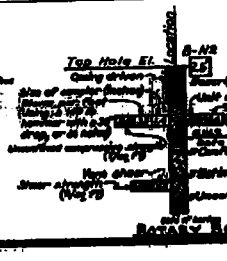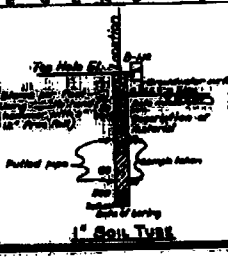

**NOTE**  
 Classification of earth material as shown on this sheet is based upon field inspection and is not to be construed to imply mechanical analysis.


**AVENUE II OVERCROSSING**

**LOG OF TEST BORINGS**


DATE 1-27-62  
 SCALE 1"=10' (SEE 41-61)  
 DRAWN BY 41-61-71  
 PR-41-61-71

I HEREBY CERTIFY THAT THIS IS A TRUE AND ACCURATE COPY OF THE ABOVE DOCUMENT TAKEN UNDER MY SUPERVISION AND CONTROL ON THIS DATE IN SACRAMENTO, CALIFORNIA PURSUANT TO AUTHORIZATION BY THE DIRECTOR OF PUBLIC WORKS.

DATE 1/27/62 SIGNATURE [Signature] TITLE SE DMS

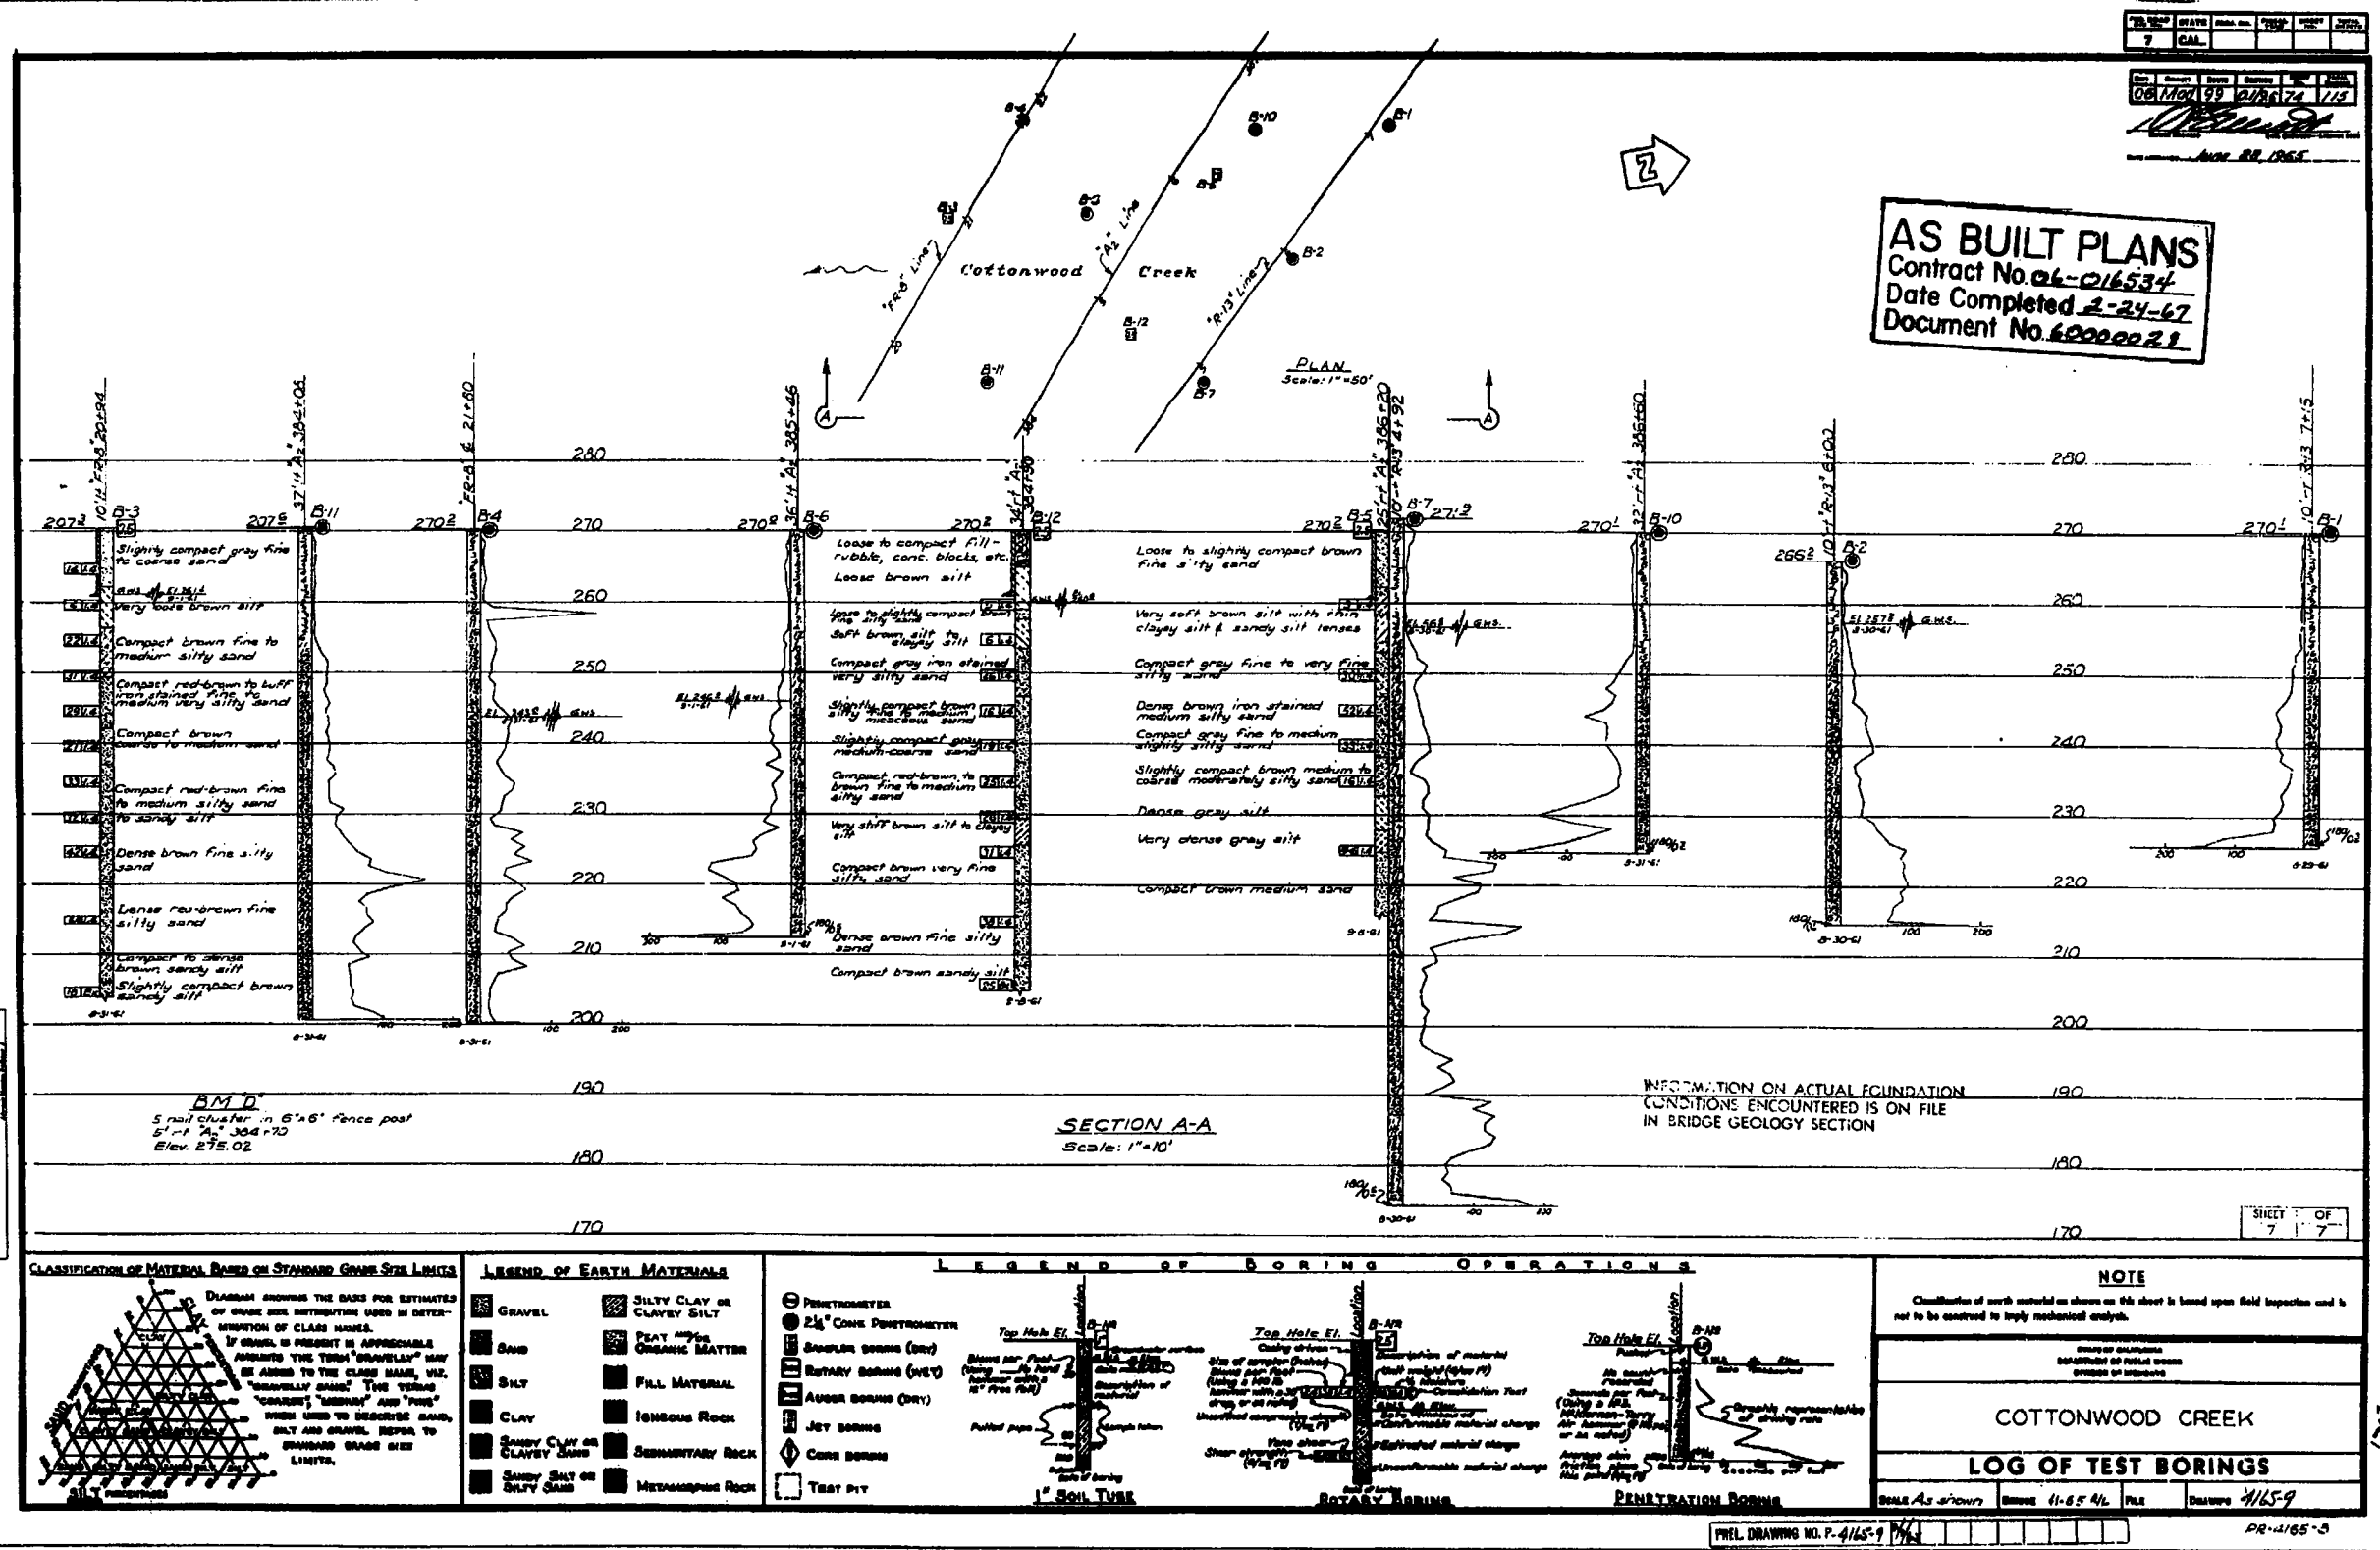




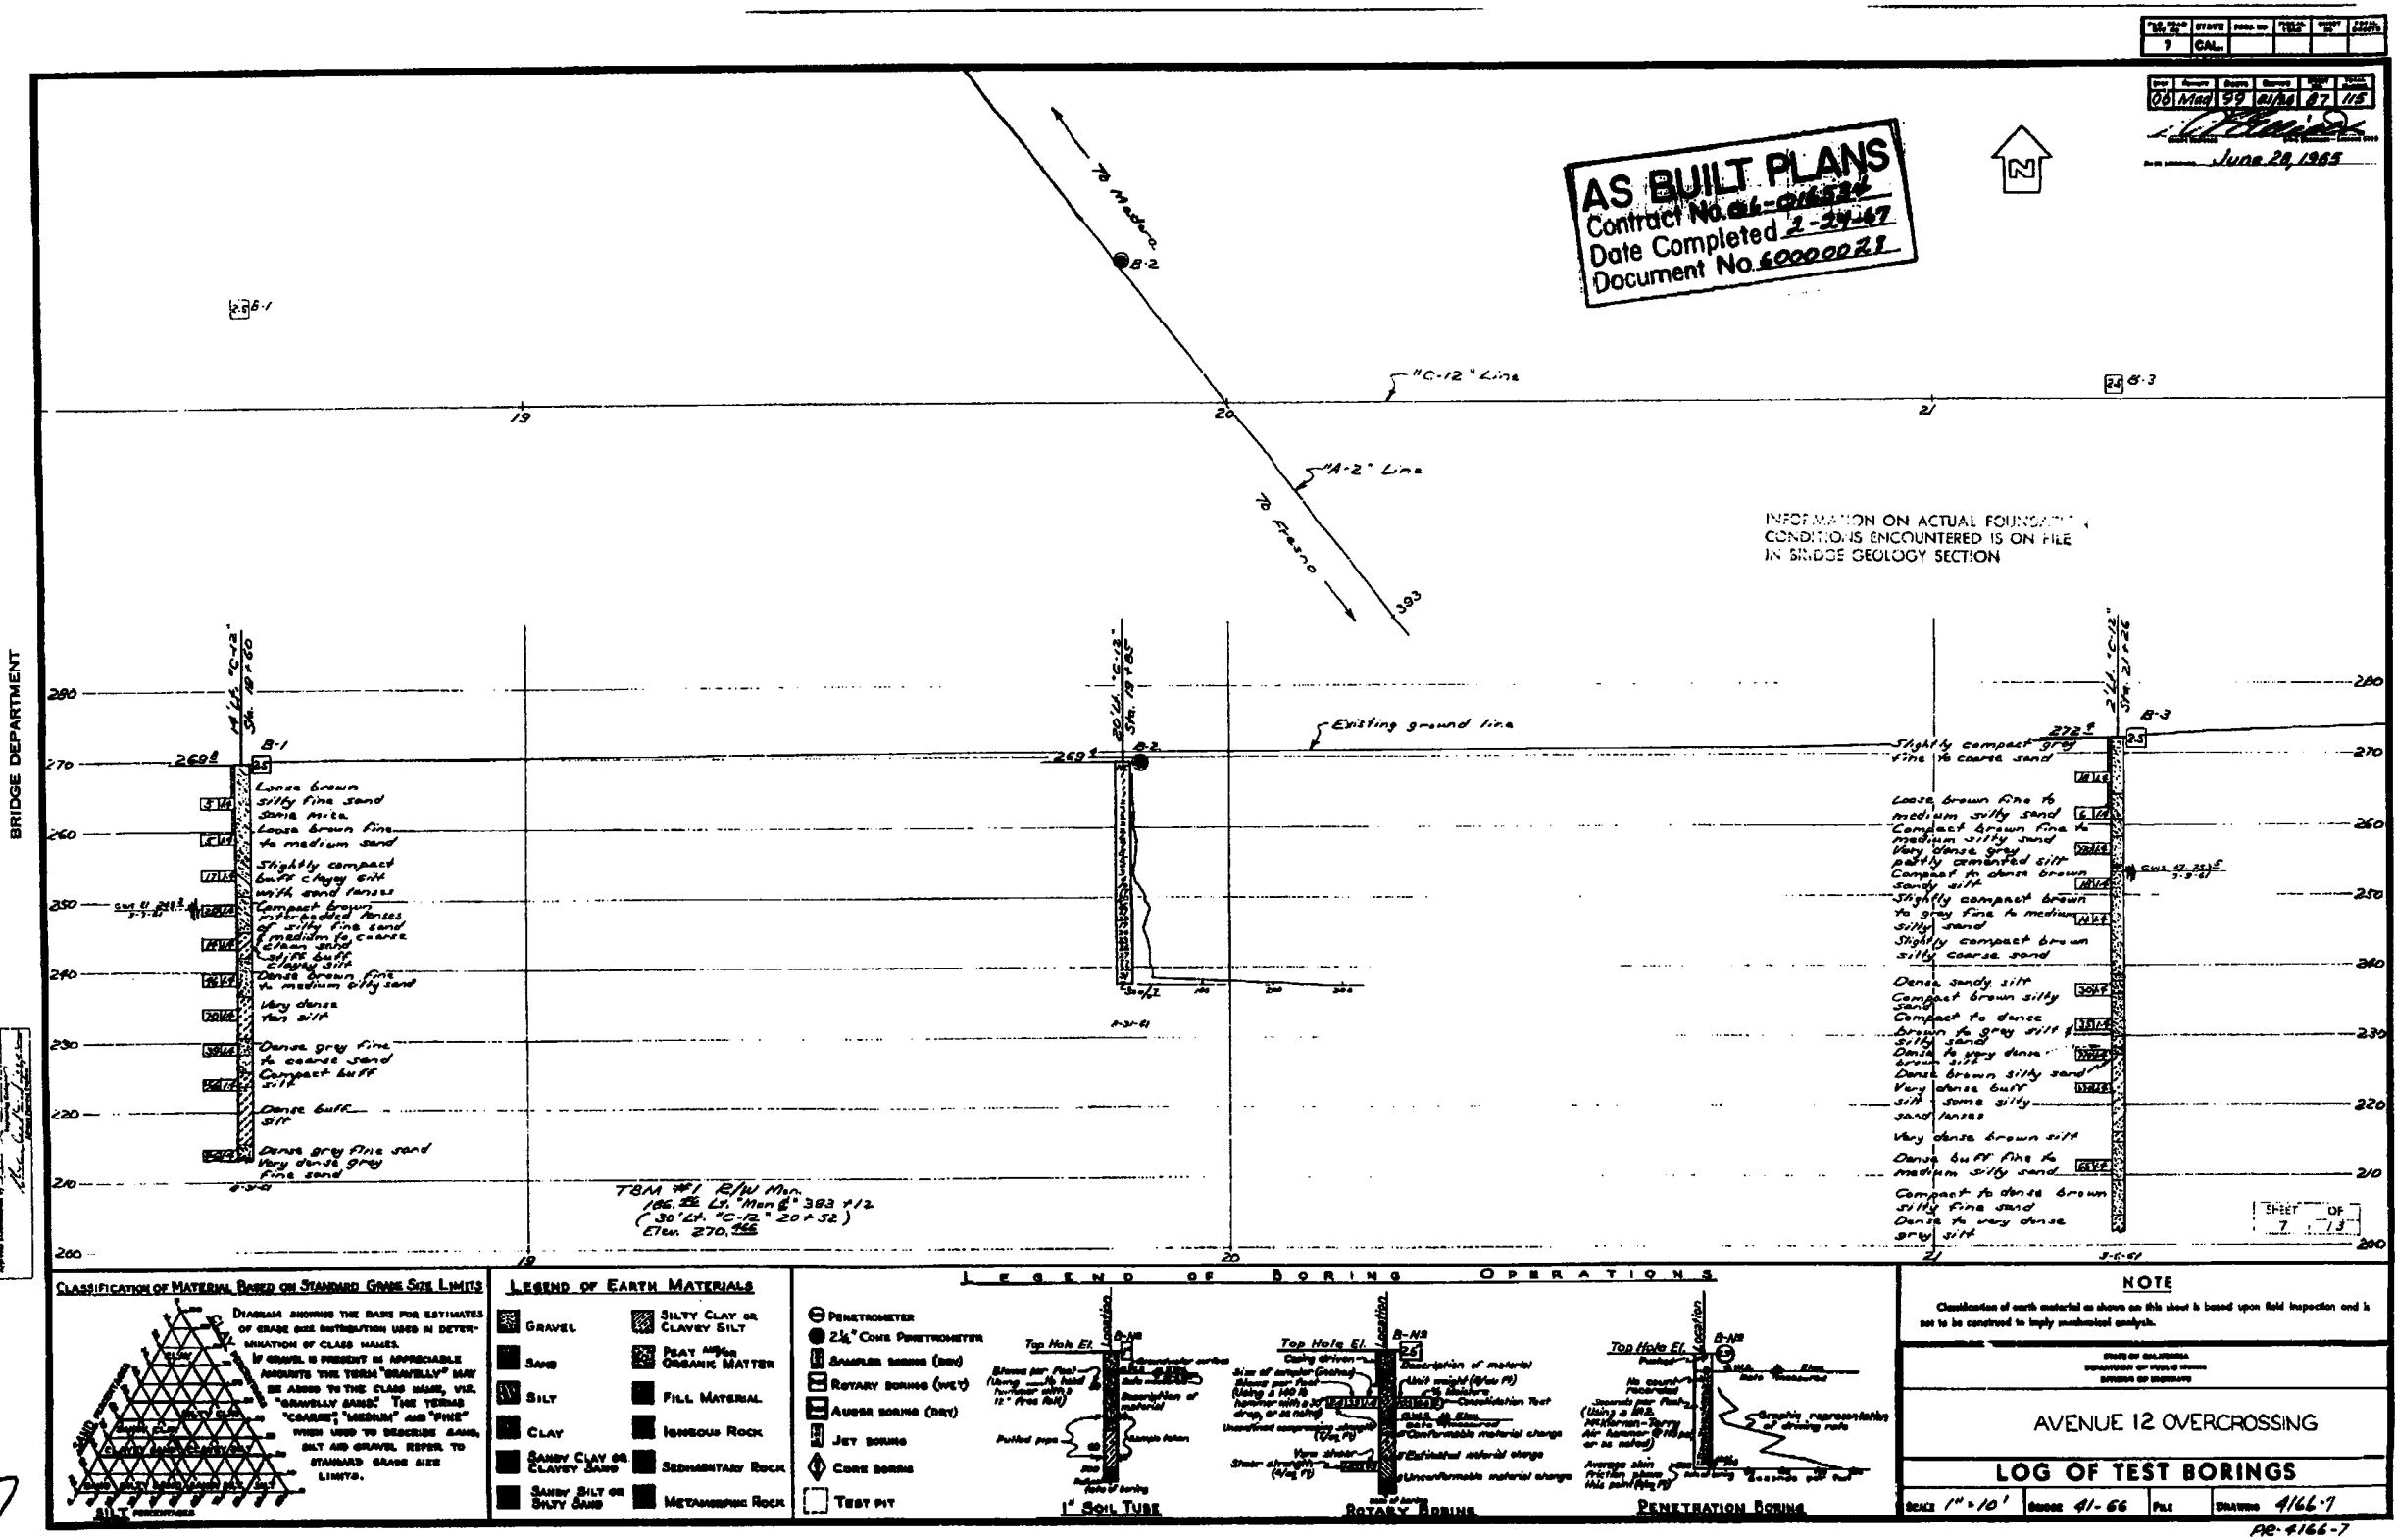

87


1320

BRIDGE DEPARTMENT

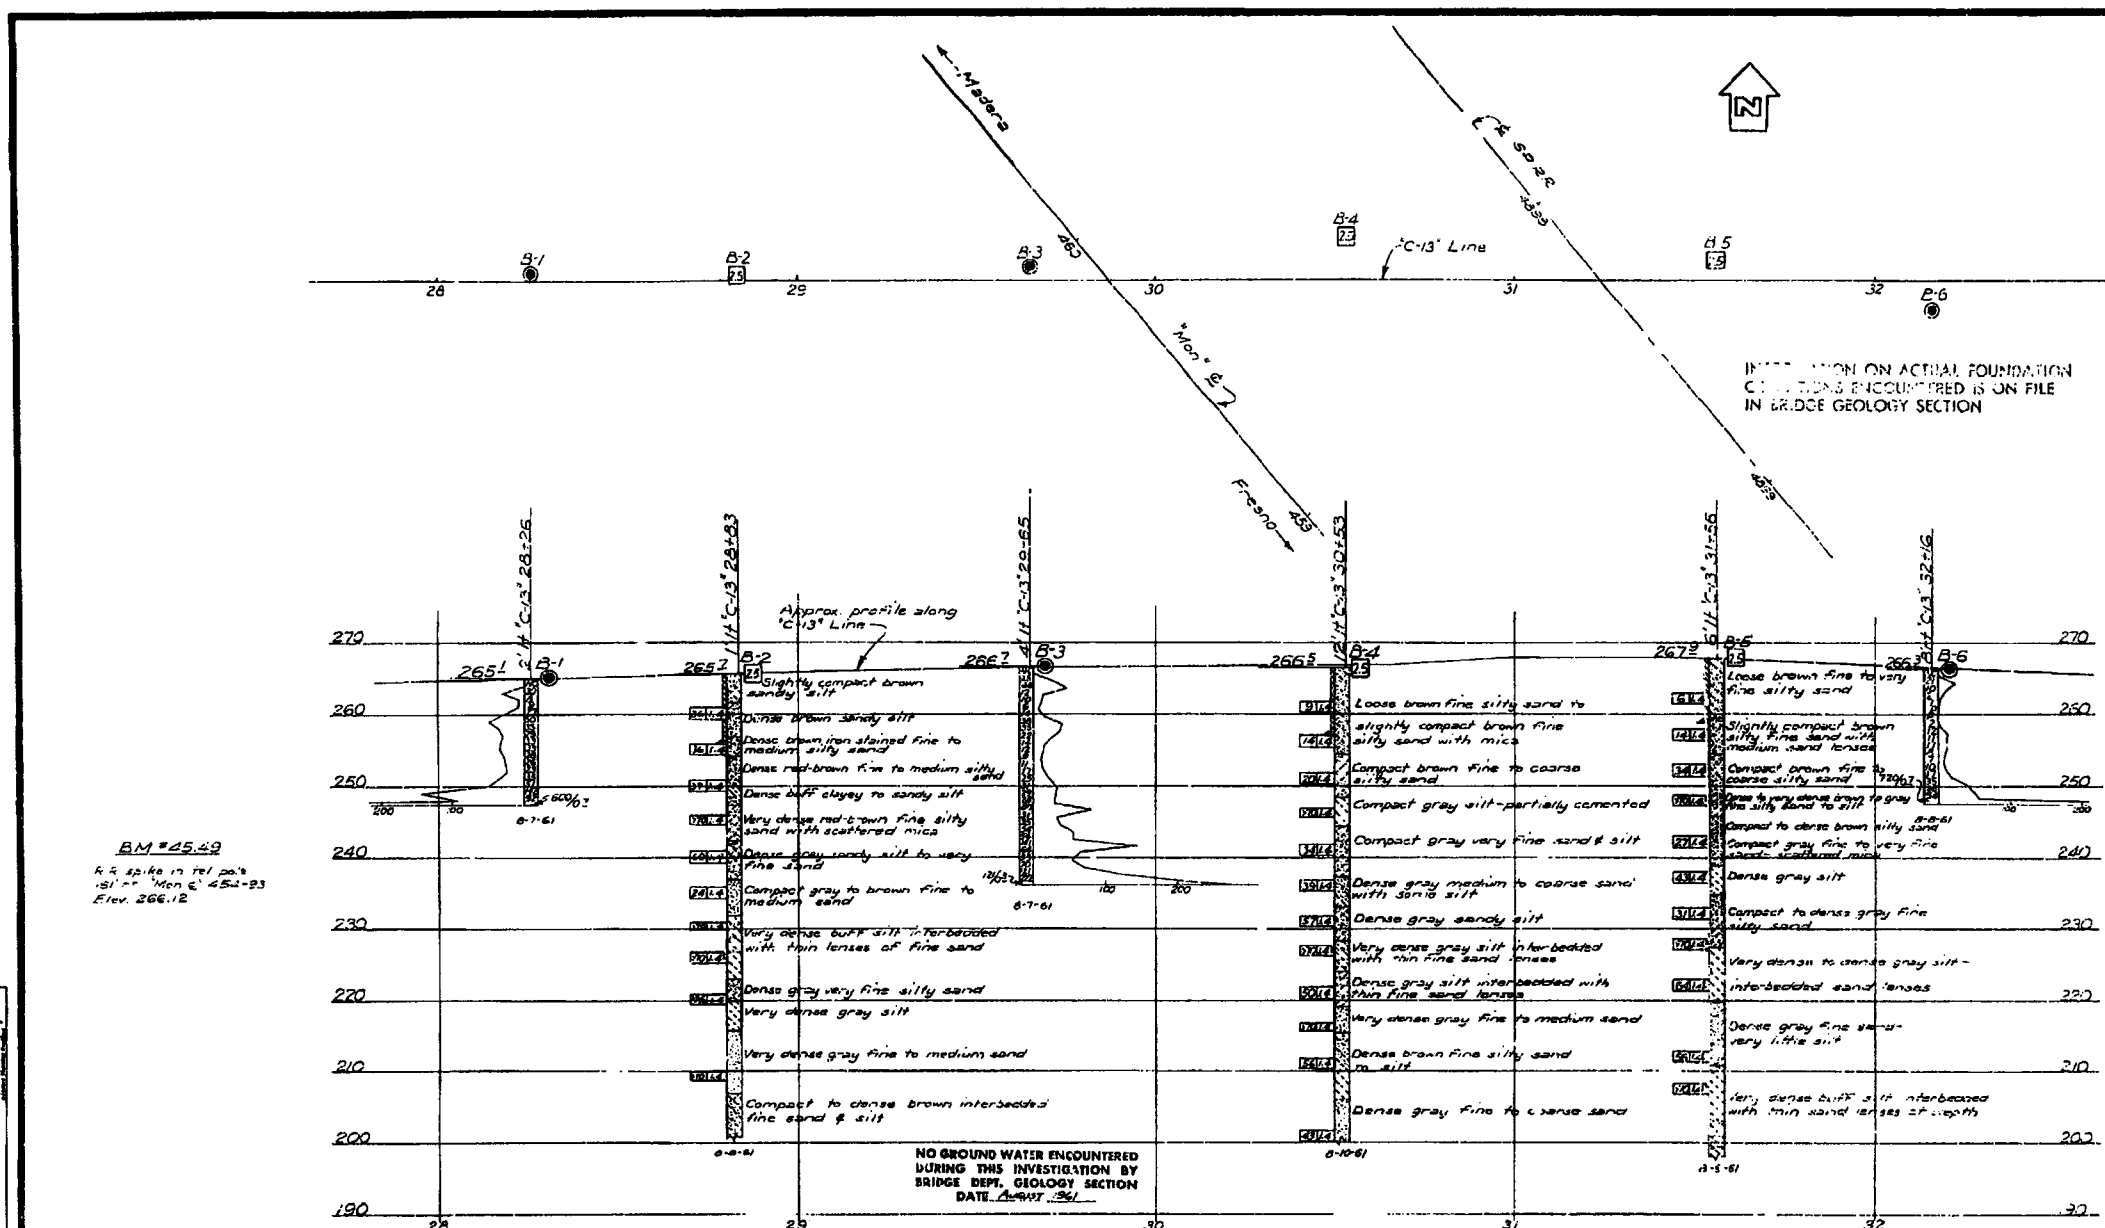


BM #45.49  
 R.R. spike in Tel. pole  
 151' = 'Mon' 45.49-93  
 Elev. 266.12

AS BUILT PLANS  
 Contract No. 41-62-115  
 Date Completed 1-24-67  
 Document No. 4162-115

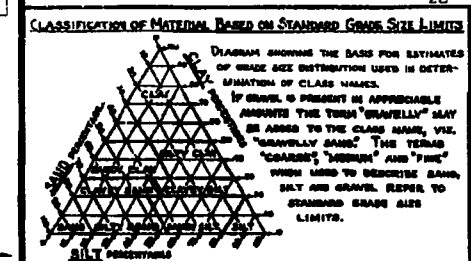

LEGEND OF EARTH MATERIALS

GRAVEL	SILTY CLAY OR CLAYEY SILT
SAND	CLAY WITH OR WITHOUT ORGANIC MATTER
SILT	FILL MATERIAL
CLAY	IGNEOUS ROCK
SANDY CLAY OR CLAYEY SAND	SEDIMENTARY ROCK
SANDY SILT OR SILTY SAND	METAMORPHIC ROCK

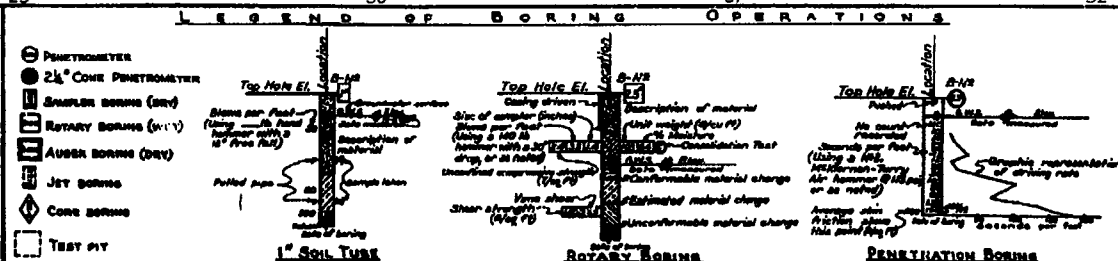

NOTE

Classification of earth material as shown on this sheet is based upon field inspection and is not to be construed to imply mechanical analysis.

AVENUE 13 OVERCROSSING

LOG OF TEST BORINGS

NOTE: 1"=20'  
SCALE: 1/4"=10'

BRIDGE 41-62 FILE DRAWING 4162-7


PR-4162-4



7	CAL	115	240
11	Mod	11	11


DATE COMPLETED: 11/15/51

**AS BUILT PLANS**  
 Contract No. 58-672-2  
 Date Completed  
 Document No. 60000914

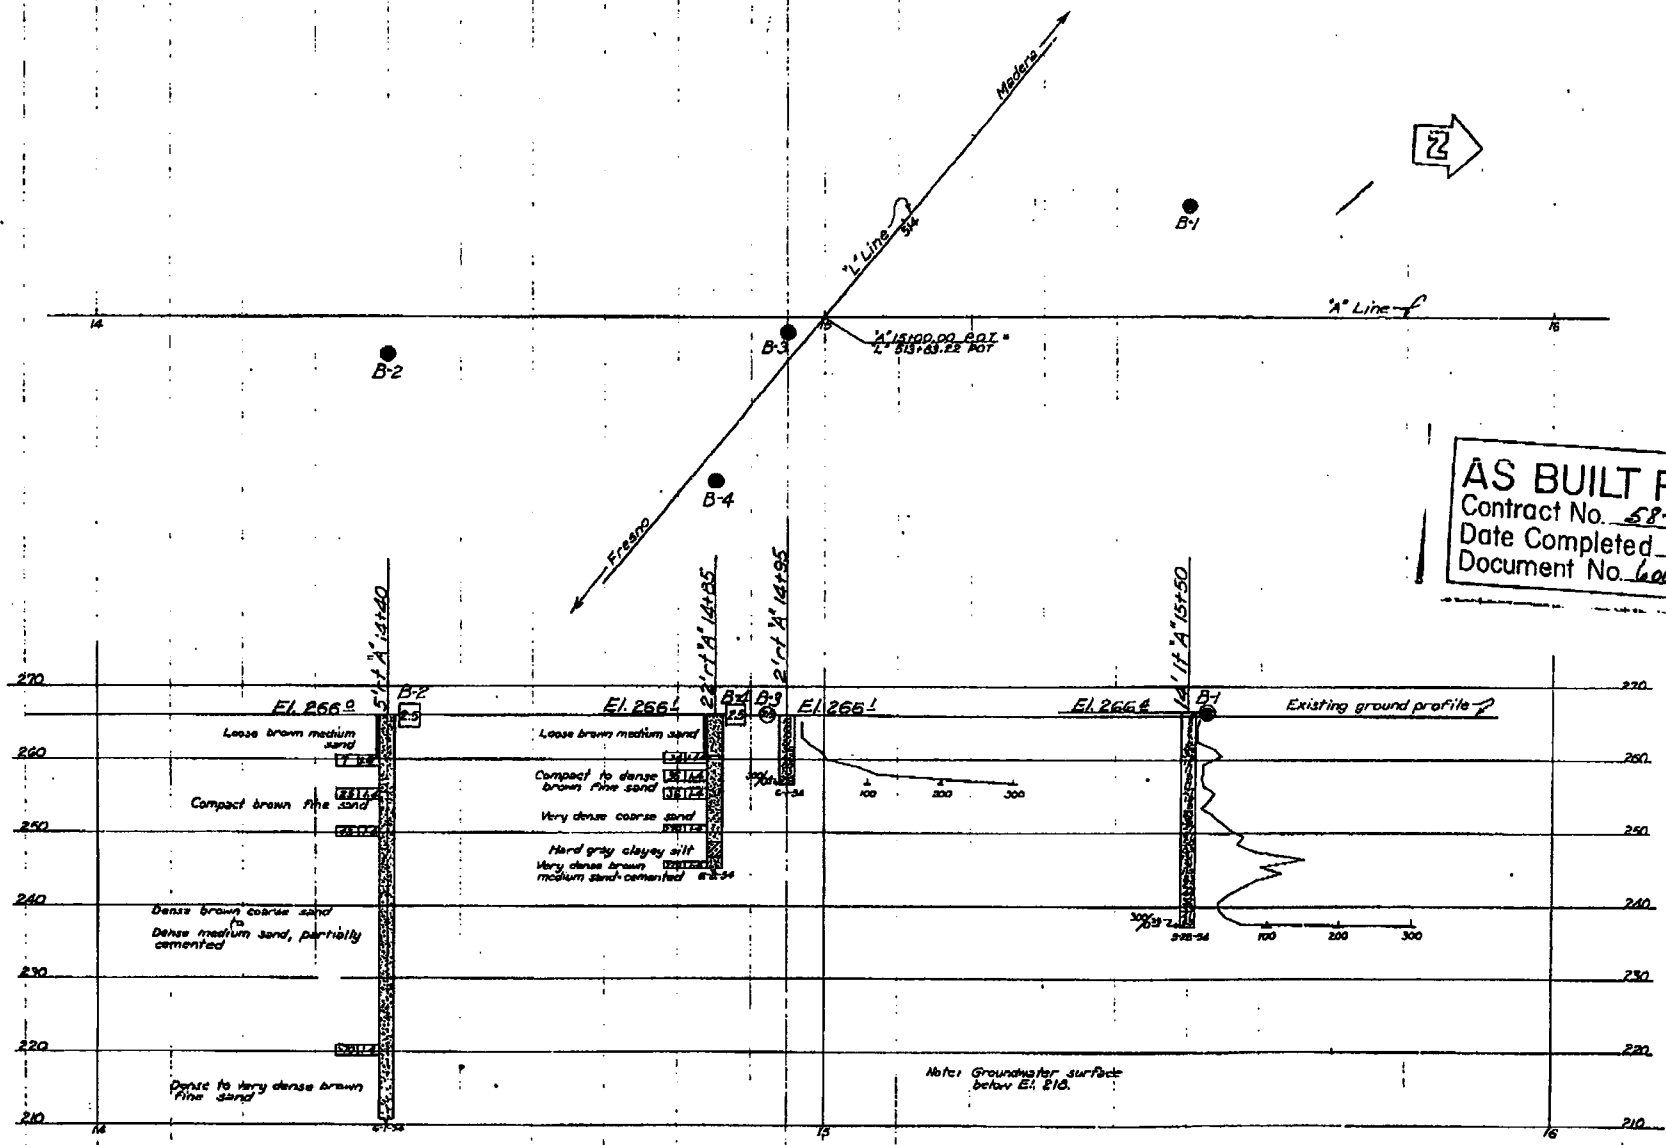


BM N512.3  
 RR Spike in 42" cottonwood  
 67' H of L 512+32  
 El. 262.86

AS BUILT  
 No CORRECTIONS BY E.S. Huber  
 2-19-58

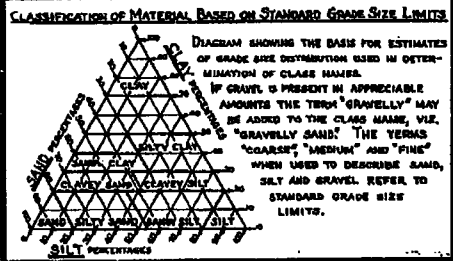

**LEGEND OF EARTH MATERIALS**

GRAVEL	SILTY CLAY OR CLAYEY SILT
SAND	PEAT AND/OR ORGANIC MATTER
SILT	FILL MATERIAL
CLAY	IGNEOUS ROCK
SANDY CLAY OR CLAYEY SAND	SEDIMENTARY ROCK
SANDY SILT OR SILTY SAND	METAMORPHIC ROCK

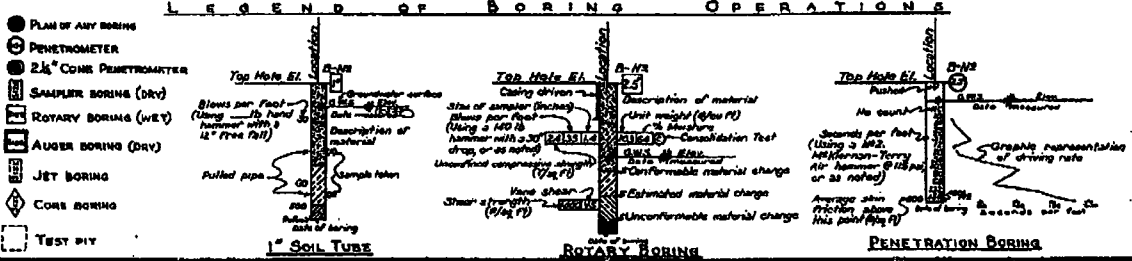

**NOTES**

The contractor's attention is directed to Section 2, Article (4) of the Standard Specifications and to the Special Provisions accompanying this set of plans. Classification of earth material as shown on this sheet is based upon field inspection and is not to be construed to imply mechanical analysis.

STATE OF CALIFORNIA  
 DEPARTMENT OF PUBLIC WORKS  
 DIVISION OF HIGHWAYS

**SOUTH MADERA OVERCROSSING**

**LOG OF TEST BORINGS**

SCALE 1"=10' BRIDGE 41-45 FILE DRAWING C-3642-11

I HEREBY CERTIFY THAT THIS IS A TRUE AND ACCURATE COPY OF THE ABOVE DOCUMENT TAKEN UNDER MY DIRECTION AND CONTROL ON THIS DATE IN SACRAMENTO, CALIFORNIA PURSUANT TO AUTHORIZATION BY THE DIRECTOR OF PUBLIC WORKS.

DATE 9/15/71 SIGNATURE: [Signature] TITLE: [Title]

To accompany plans dated 6-7-58


DIVISION OF ENGINEERING SERVICES - GEOTECHNICAL SERVICES  
AS-BUILT LOG OF TEST BORINGS  
LOG OF TEST BORINGS  
Notes: 1. See the General Plan and Foundation Plan for boring locations.  
2. Structure design provided the data presented in the logs above.  
The data are the boring logs for the AS-BUILT test borings.  
Referenced to the proposed new structure location. This data is  
presented on the AS-BUILT Log of Test Borings sheet for the convenience  
of the engineer, contractor or other interested party.



Boring	Station	Offset from "A" Line
B-1	100+10.00	1.75' Left
B-2	100+20.00	1.75' Right
B-3	100+30.00	0.50' Right
B-4	100+40.00	5.00' Right


Notes:  
1. See the General Plan and Foundation Plan for boring locations.  
2. Structure design provided the data presented in the logs above.  
The data are the boring logs for the AS-BUILT test borings.  
Referenced to the proposed new structure location. This data is  
presented on the AS-BUILT Log of Test Borings sheet for the convenience  
of the engineer, contractor or other interested party.

RM 10512-3  
R.D. Spikes in 40' cottonwood  
at 11' of 2" 5/8" x 1/2"  
EL 280.04

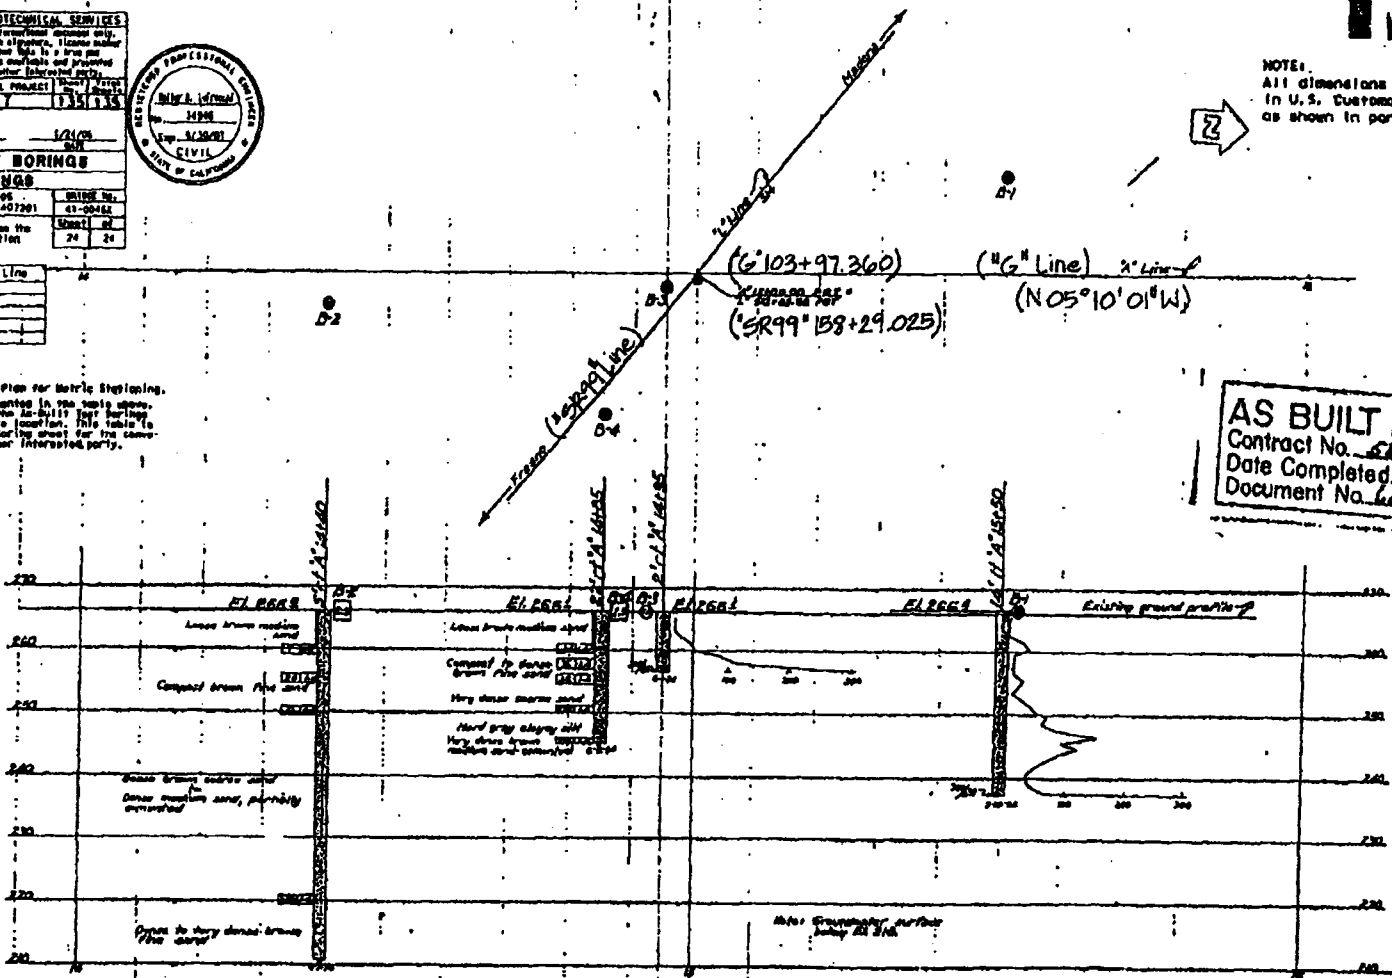


AS BUILT PLANS  
Contract No. 67-673-2  
Date Completed  
Document No. 60000000-4

AS BUILT  
CORRECTIONS BY Victor M. Diaz  
2-19-59

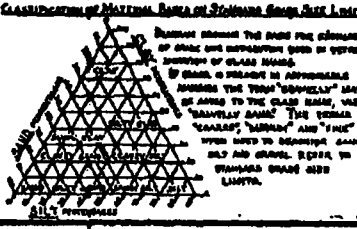

LEGEND OF EARTH MATERIALS

GRAVEL	SAND	SILT	CLAY	CLAYEY SILT	CLAYEY SAND	SANDY SILT	SANDY SAND
GRAVEL	SAND	SILT	CLAY	CLAYEY SILT	CLAYEY SAND	SANDY SILT	SANDY SAND

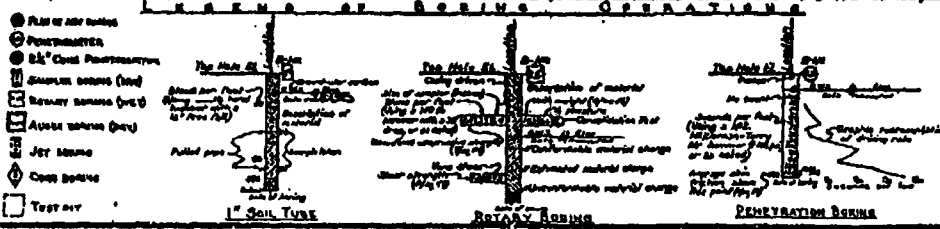

NOTE:  
The contractor's attention is directed to Section 5, Article 65 of the Standard Specifications  
and to the Special Provisions accompanying this set of plans.  
Classification of earth material as shown on this sheet is based upon field inspection and is  
not to be construed as a laboratory analysis.  
SOUTH MADERA OVERCROSSING  
LOG OF TEST BORINGS  
Scale 1"=10' (Horizontal) 1"=10' (Vertical)  
Sheet 41-65 of 65  
Drawing 60-3642-11

I HEREBY CERTIFY THAT THIS IS A TRUE AND ACCURATE COPY OF THE ABOVE DOCUMENT TAKEN  
FROM THE ORIGINAL AND CORRECT ON THIS DATE BY SIGNATURE, TESTIMONY PURSUANT TO  
ATTESTATION BY THE SIGNATURE OF PUBLIC WORKS.  
DATE 11/15/73 SIGNATURE A. J. J. TITLE P.E.


NO AS BUILT CHANGES  
AS BUILT  
CORRECTIONS BY Victor M. Diaz/CD  
CONTRACT NO. 06-407204  
DATE 09-26-07/05-30-08





145  
 11/14/58  
 11/14/58  
 11/14/58

BRIDGE DEPARTMENT

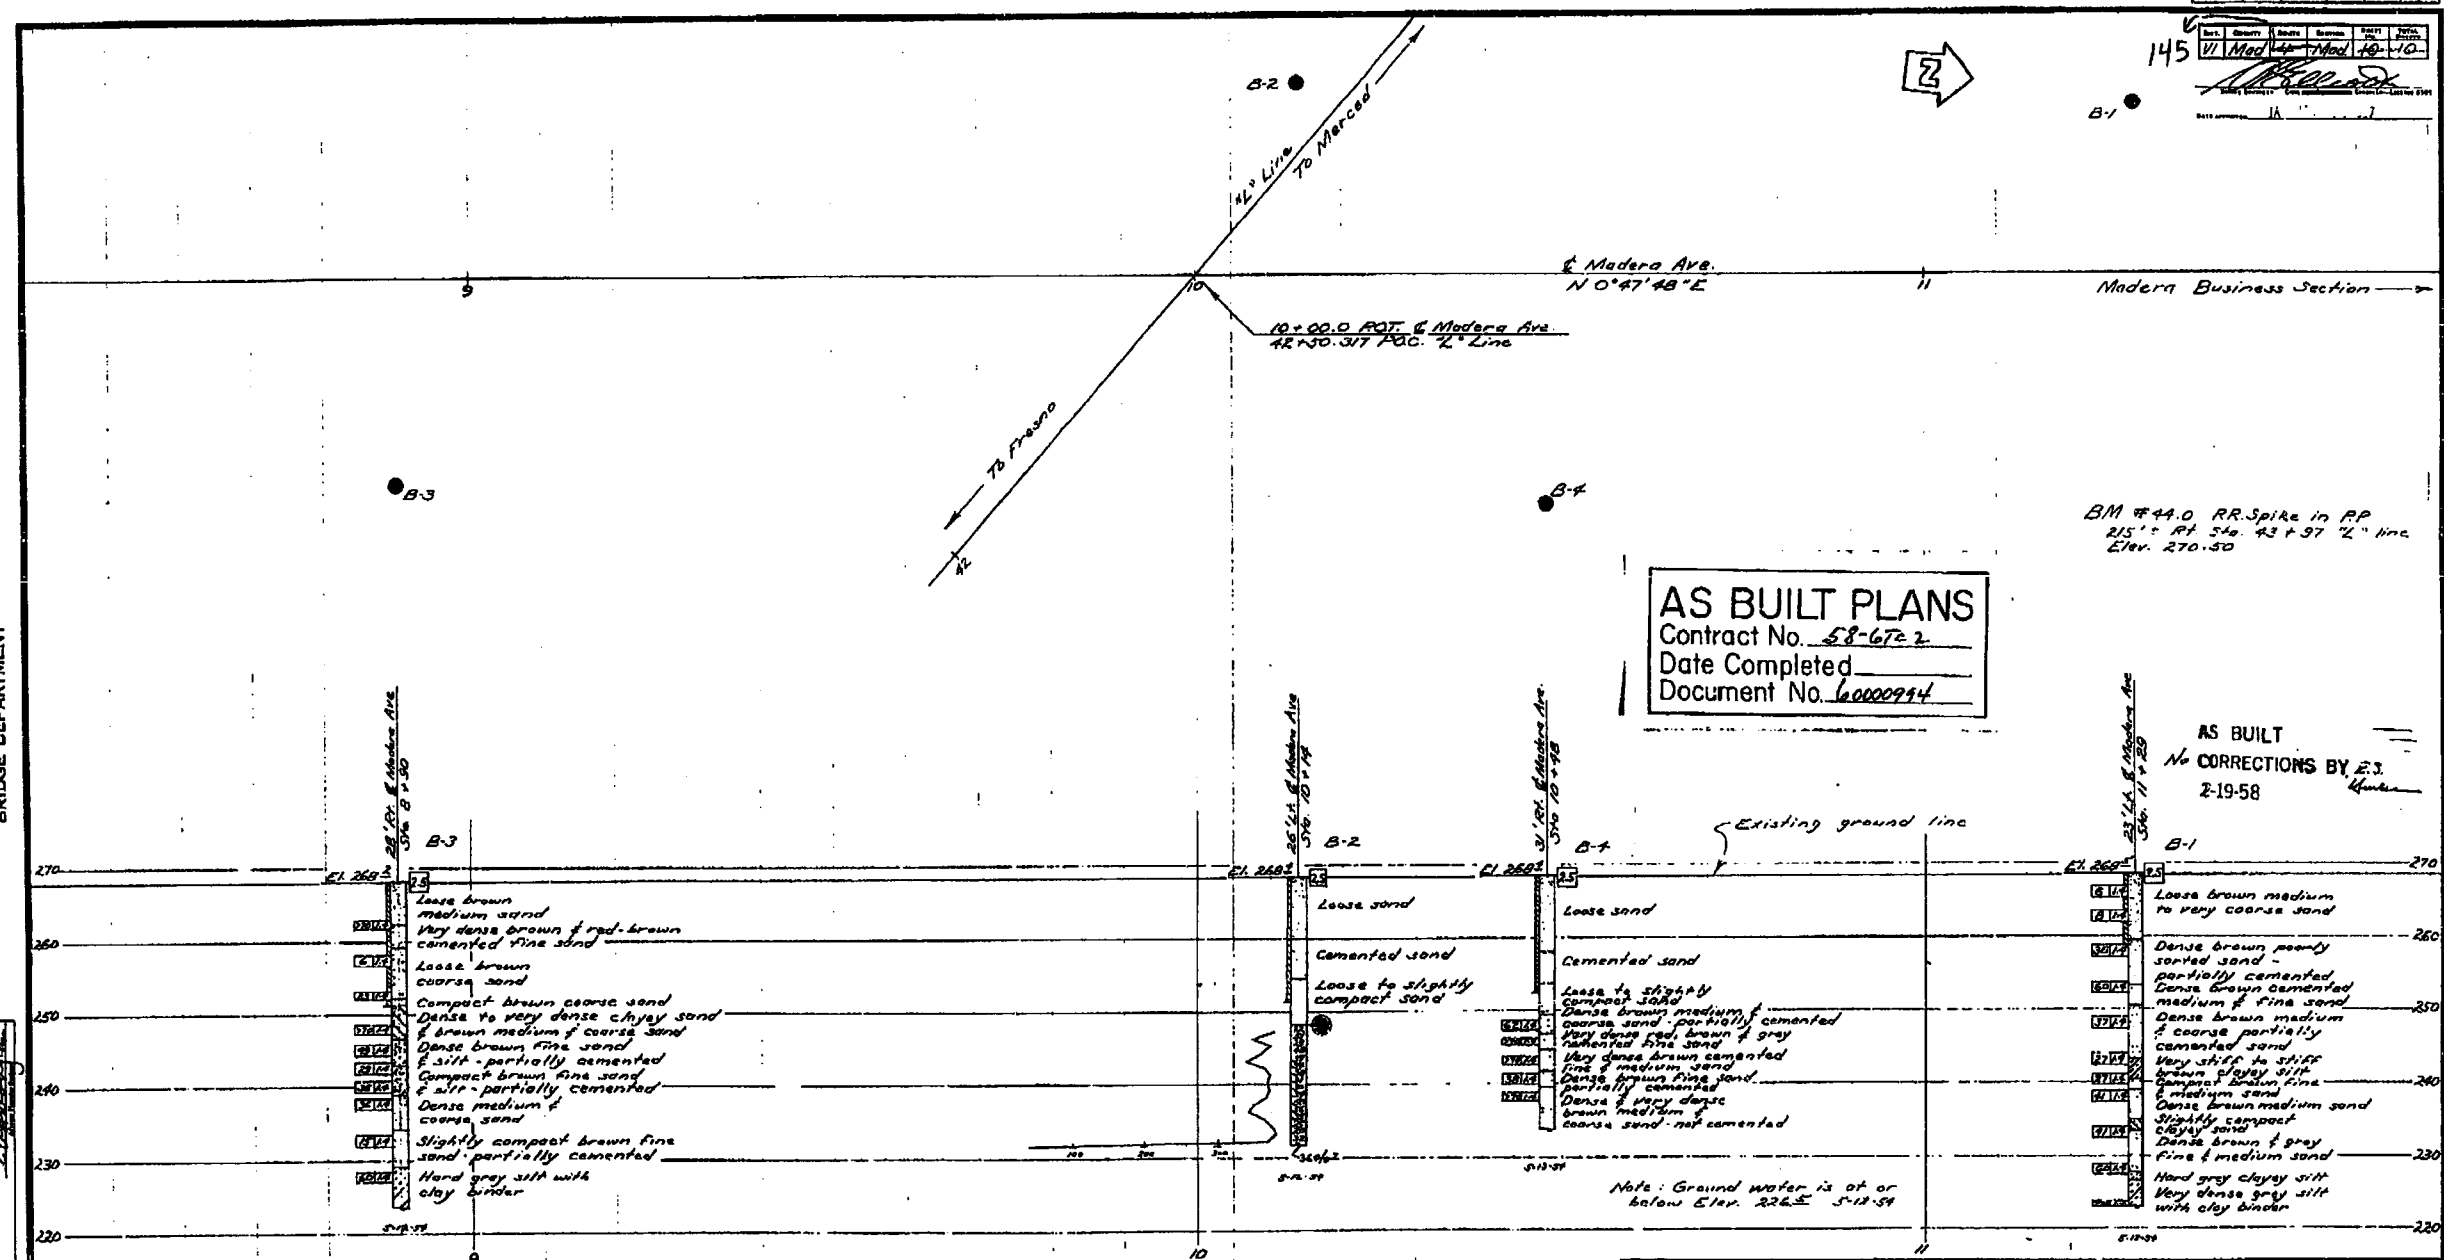

**CLASSIFICATION OF MATERIAL BASED ON STANDARD GRADE SIZE LIMITS**

DIAGRAM SHOWING THE BASIS FOR ESTIMATES OF GRADE SIZE DISTRIBUTION USED IN DETERMINATION OF CLASS NAMES. IF GRAVEL IS PRESENT IN APPRECIABLE AMOUNTS THE TERM "GRAVELLY" MAY BE ADDED TO THE CLASS NAME, VIZ. "GRAVELLY SAND". THE TERMS "COARSE", "MEDIUM" AND "FINE" WHEN USED TO DESCRIBE SAND, SILT AND GRAVEL REFER TO STANDARD GRADE SIZE LIMITS.

**LEGEND OF EARTH MATERIALS**

GRAVEL	SILTY CLAY OR CLAYEY SILT
SAND	PEAT AND/OR ORGANIC MATTER
SILT	FILL MATERIAL
CLAY	IGNEOUS ROCK
SANDY CLAY OR CLAYEY SAND	SEDIMENTARY ROCK
SANDY SILT OR SILTY SAND	METAMORPHIC ROCK

**LEGEND OF BORING OPERATIONS**

PLAN OF ANY BORING

PENETROMETER

2 1/4" CONE PENETROMETER

SAMPLER BORING (DRY)

ROTARY BORING (WET)

AUGER BORING (DRY)

JET BORING

CORE BORING

TEST PIT

1" SOIL TUBE

ROTARY BORING

PENETRATION BORING

**NOTES**

The contractor's attention is directed to Section 2, Article (c) of the Standard Specifications and to the Special Provisions accompanying this set of plans. Classification of earth material as shown on this sheet is based upon field inspection and is not to be construed to imply mechanical analysis.

**ROUTE 126 1/4 SEPARATION (MADERA AVENUE)**

**LOG OF TEST BORINGS**

SCALE 1" = 10' BRIDGE 41-47 FILE DRAWING 673045-10

I HEREBY CERTIFY THAT THIS IS A TRUE AND ACCURATE COPY OF THE ABOVE DOCUMENT TAKEN UNDER MY DIRECTION AND CONTROL ON THIS DATE IN SACRAMENTO, CALIFORNIA PURSUANT TO AUTHORIZATION BY THE DIRECTOR OF PUBLIC WORKS.

DATE 9/15/54 SIGNATURE: L. S. RILEY TITLE: ASST. DIR.





DATE OF REPORT: 9/15/76

BY: J. H. HALL

CHECKED BY: J. H. HALL


APPROVED BY: J. H. HALL

**AS BUILT PLANS**  
 Contract No. 58-6722  
 Date Completed \_\_\_\_\_  
 Document No. 6000994

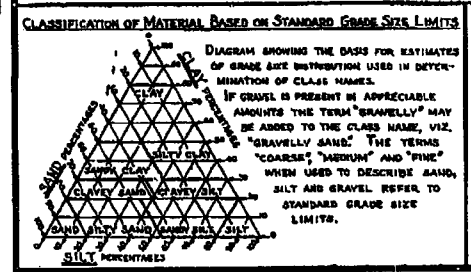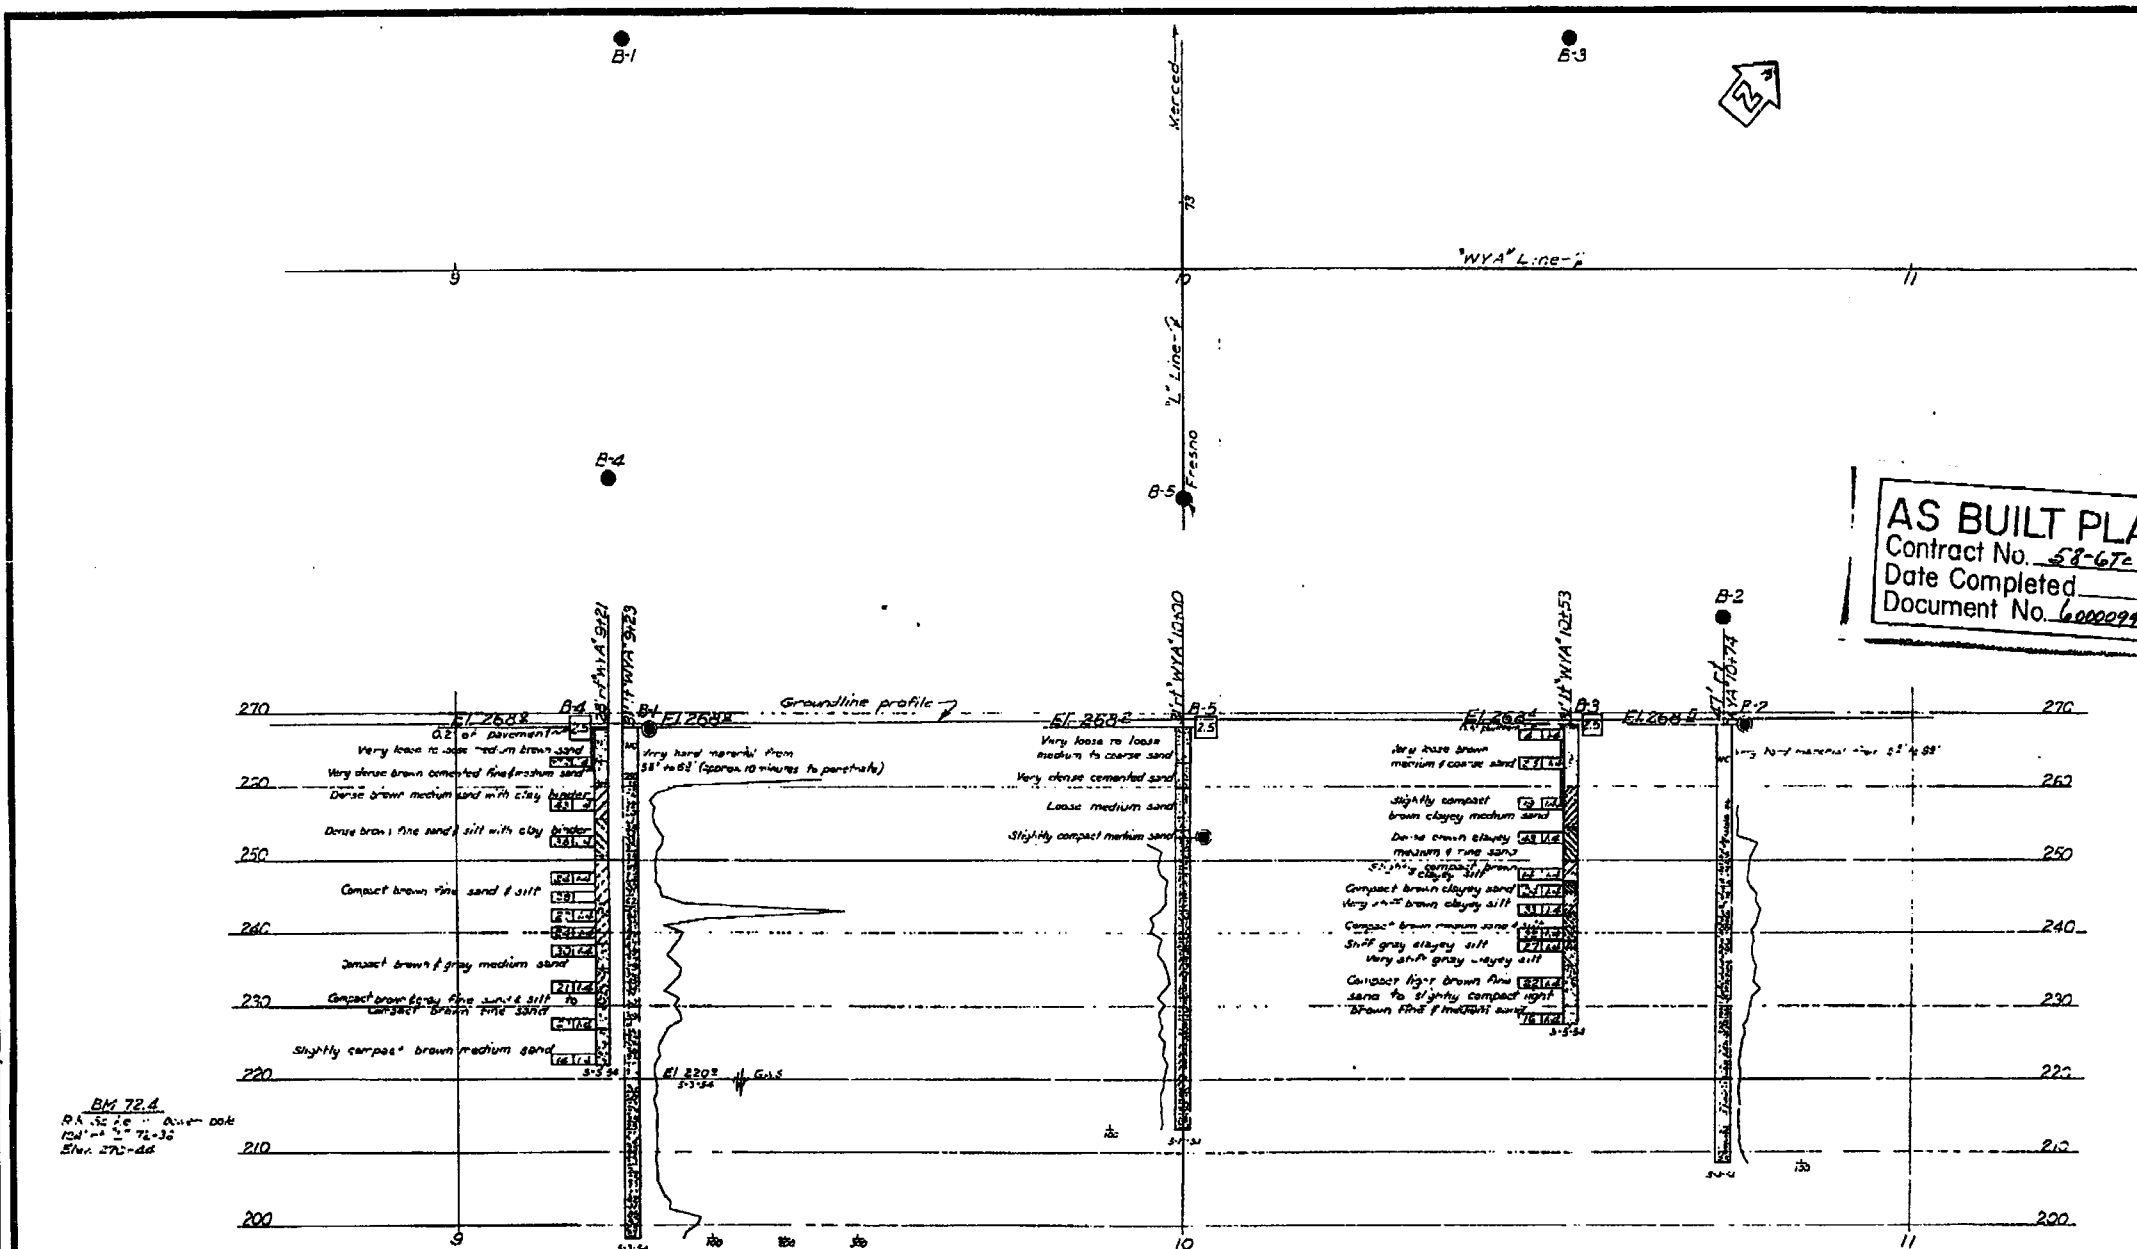

**LEGEND OF EARTH MATERIALS**

GRAVEL	SILTY CLAY OR CLAYEY SILT
SAND	PEAT AND/OR ORGANIC MATTER
SILT	FILL MATERIAL
CLAY	IGNEOUS ROCK
SANDY CLAY OR CLAYEY SAND	SEDIMENTARY ROCK
SANDY SILT OR SILTY SAND	METAMORPHIC ROCK

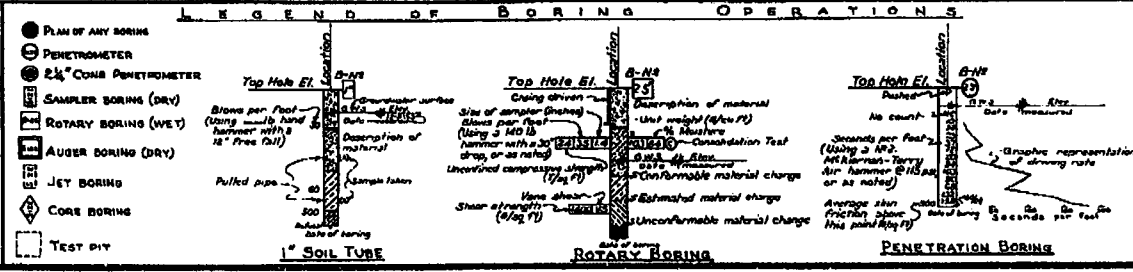

**NOTES**

The contractor's attention is directed to Section 2, Article (c) of the Standard Specifications and to the Special Provisions accompanying this set of plans.

Classification of earth material as shown on this sheet is based upon field inspection and is not to be construed to imply mechanical analysis.

STATE OF CALIFORNIA  
 DEPARTMENT OF PUBLIC WORKS  
 DIVISION OF HIGHWAYS

**WEST YOSEMITE AVENUE OVERCROSSING**

**LOG OF TEST BORINGS**

SCALE 1"=10' BRIDGE 41-49 FILE DRAWING C-143-11

I HEREBY CERTIFY THAT THIS IS A TRUE AND ACCURATE COPY OF THE ABOVE DOCUMENT TAKEN UNDER MY DIRECTION AND CONTROL ON THIS DATE IN SACRAMENTO, CALIFORNIA PURSUANT TO AUTHORIZATION BY THE DIRECTOR OF PUBLIC WORKS.


DATE 9/15/76 SIGNATURE J. H. HALL TITLE H.C.T.

BM - B1.3 R.R. Spike in P.P.  
288' RA. Sta. 81+35 "L" Line  
Elev. 263.33


BM "I.P." 1 1/2" I.P.  
Q "W" Sta. 12+00  
Elev. 268.36

BM "I.P." 1 1/2" I.P.  
Q "W" Sta. 10+05  
Elev. 268.09

**AS BUILT PLANS**  
Contract No. 58-672  
Date Completed  
Document No. 6000914

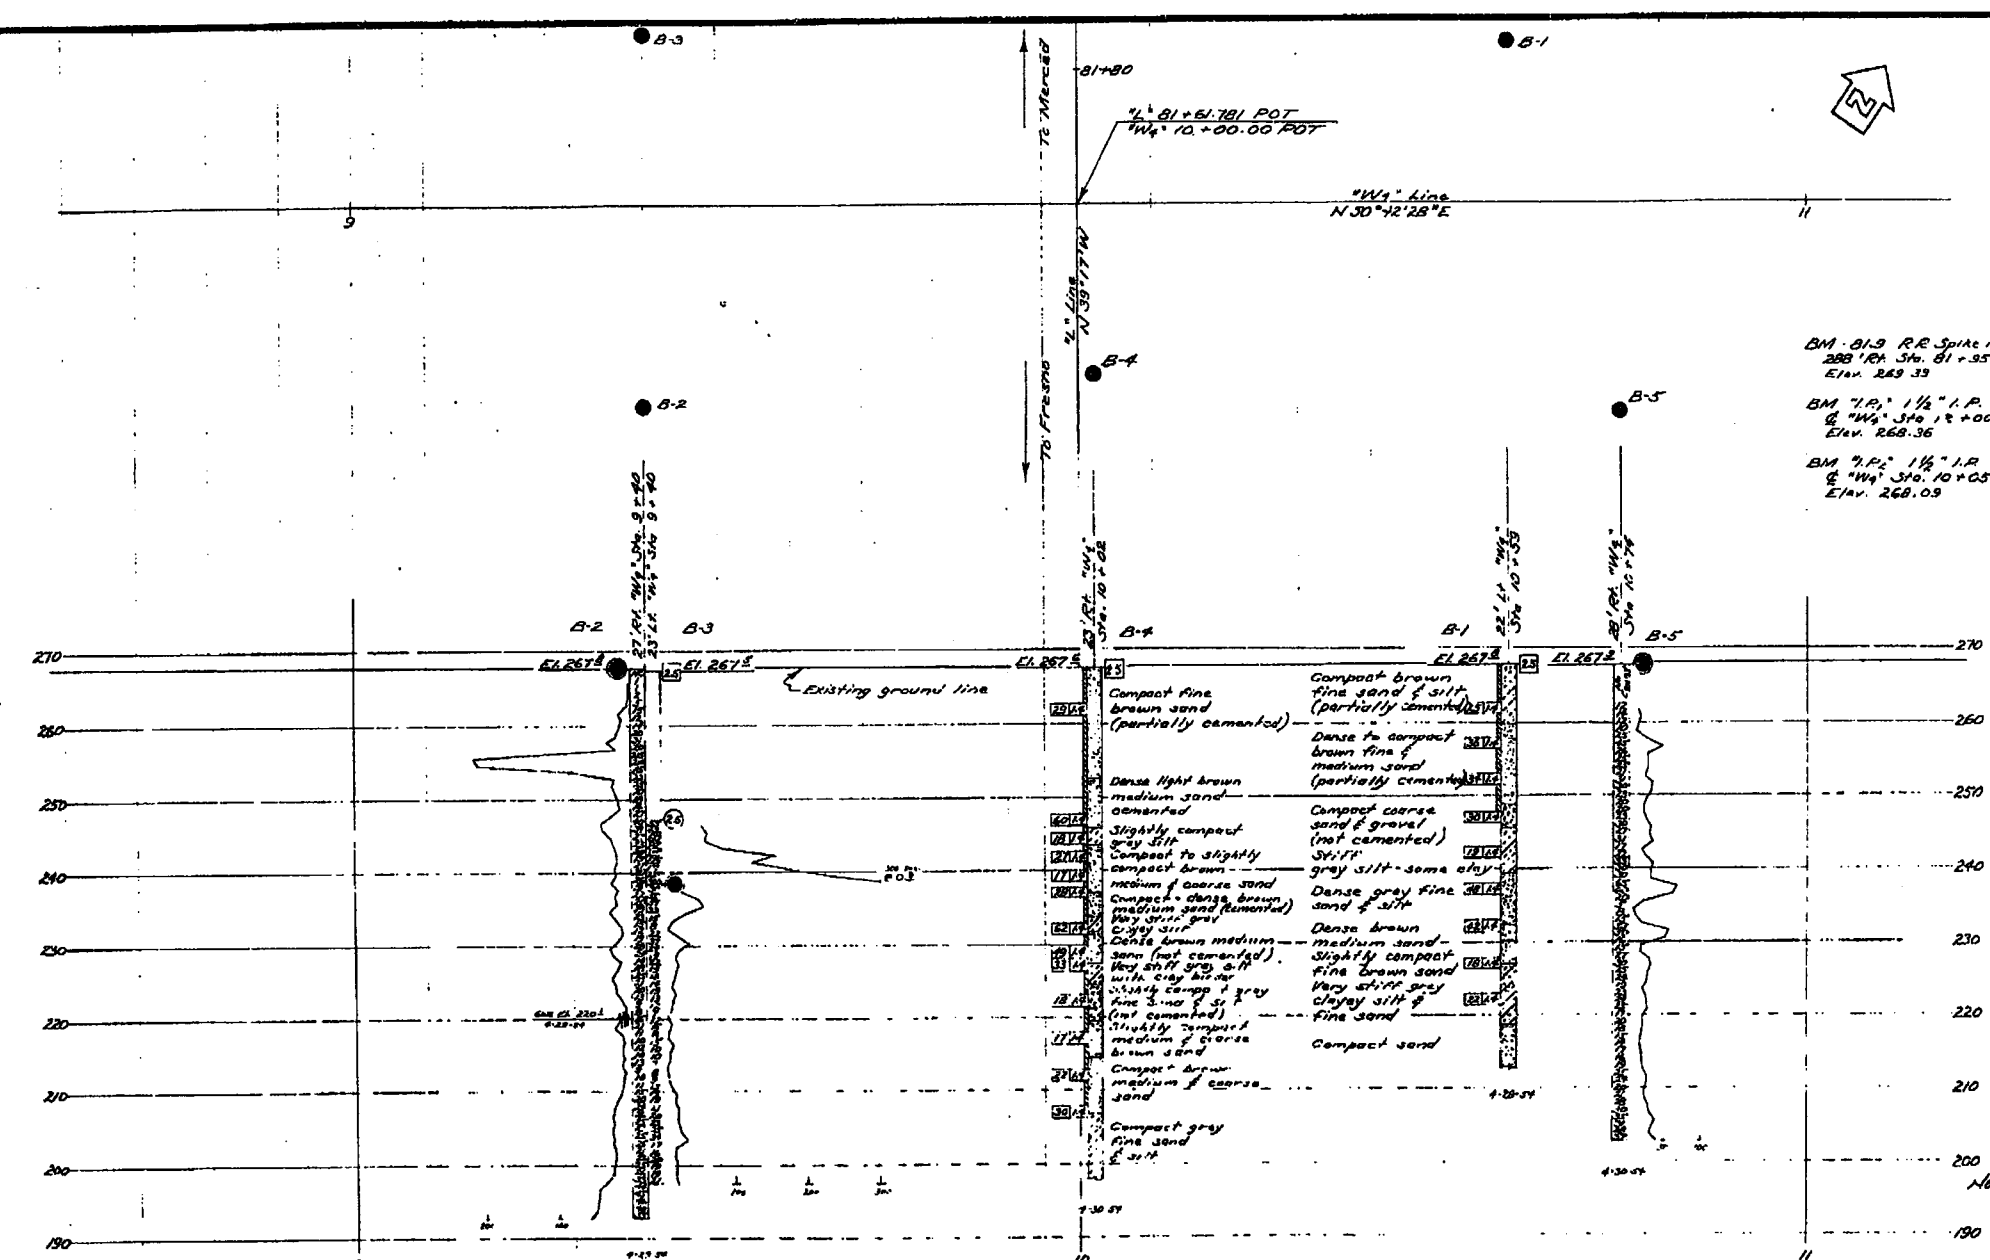


200 AS BUILT  
NO CORRECTIONS BY E.S.  
3/19/56

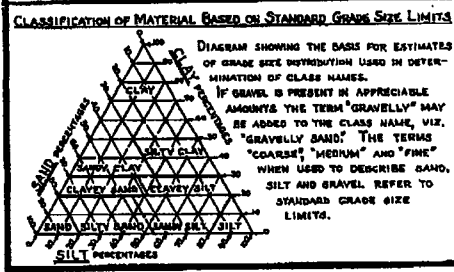

**LEGEND OF EARTH MATERIALS**

GRAVEL	SILTY CLAY OR CLAYEY SILT
SAND	PEAT AND/OR ORGANIC MATTER
SILT	FILL MATERIAL
CLAY	IGNEOUS ROCK
SANDY CLAY OR CLAYEY SAND	SEDIMENTARY ROCK
SANDY SILT OR SILTY SAND	METAMORPHIC ROCK

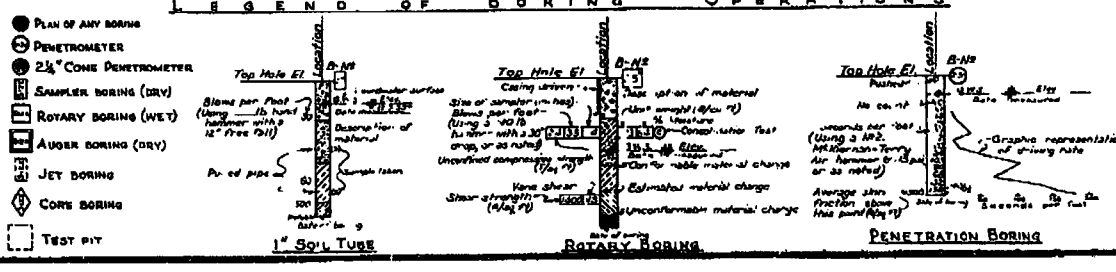

**NOTES**

The contractor's attention is directed to Section 2, Article (c) of the Standard Specifications and to the Special Provisions accompanying this set of plans.

Classification of earth material as shown on this sheet is based upon field inspection and is not to be construed to imply mechanical analysis.

STATE OF CALIFORNIA  
DEPARTMENT OF PUBLIC WORKS  
DIVISION OF HIGHWAYS

**WEST FOURTH STREET OVERCROSSING**


**LOG OF TEST BORINGS**

SCALE 1" = 10' BRIDGE 41-30 FILE DRAWING L-2046-9

I HEREBY CERTIFY THAT THIS IS A TRUE AND ACCURATE COPY OF THE ABOVE DOCUMENT TAKEN UNDER MY DIRECTION AND CONTROL ON THIS DATE IN SACRAMENTO, CALIFORNIA PURSUANT TO AUTHORIZATION BY THE DIRECTOR OF PUBLIC WORKS.


DATE 9/15/71 SIGNATURE [Signature] TITLE ASCLT



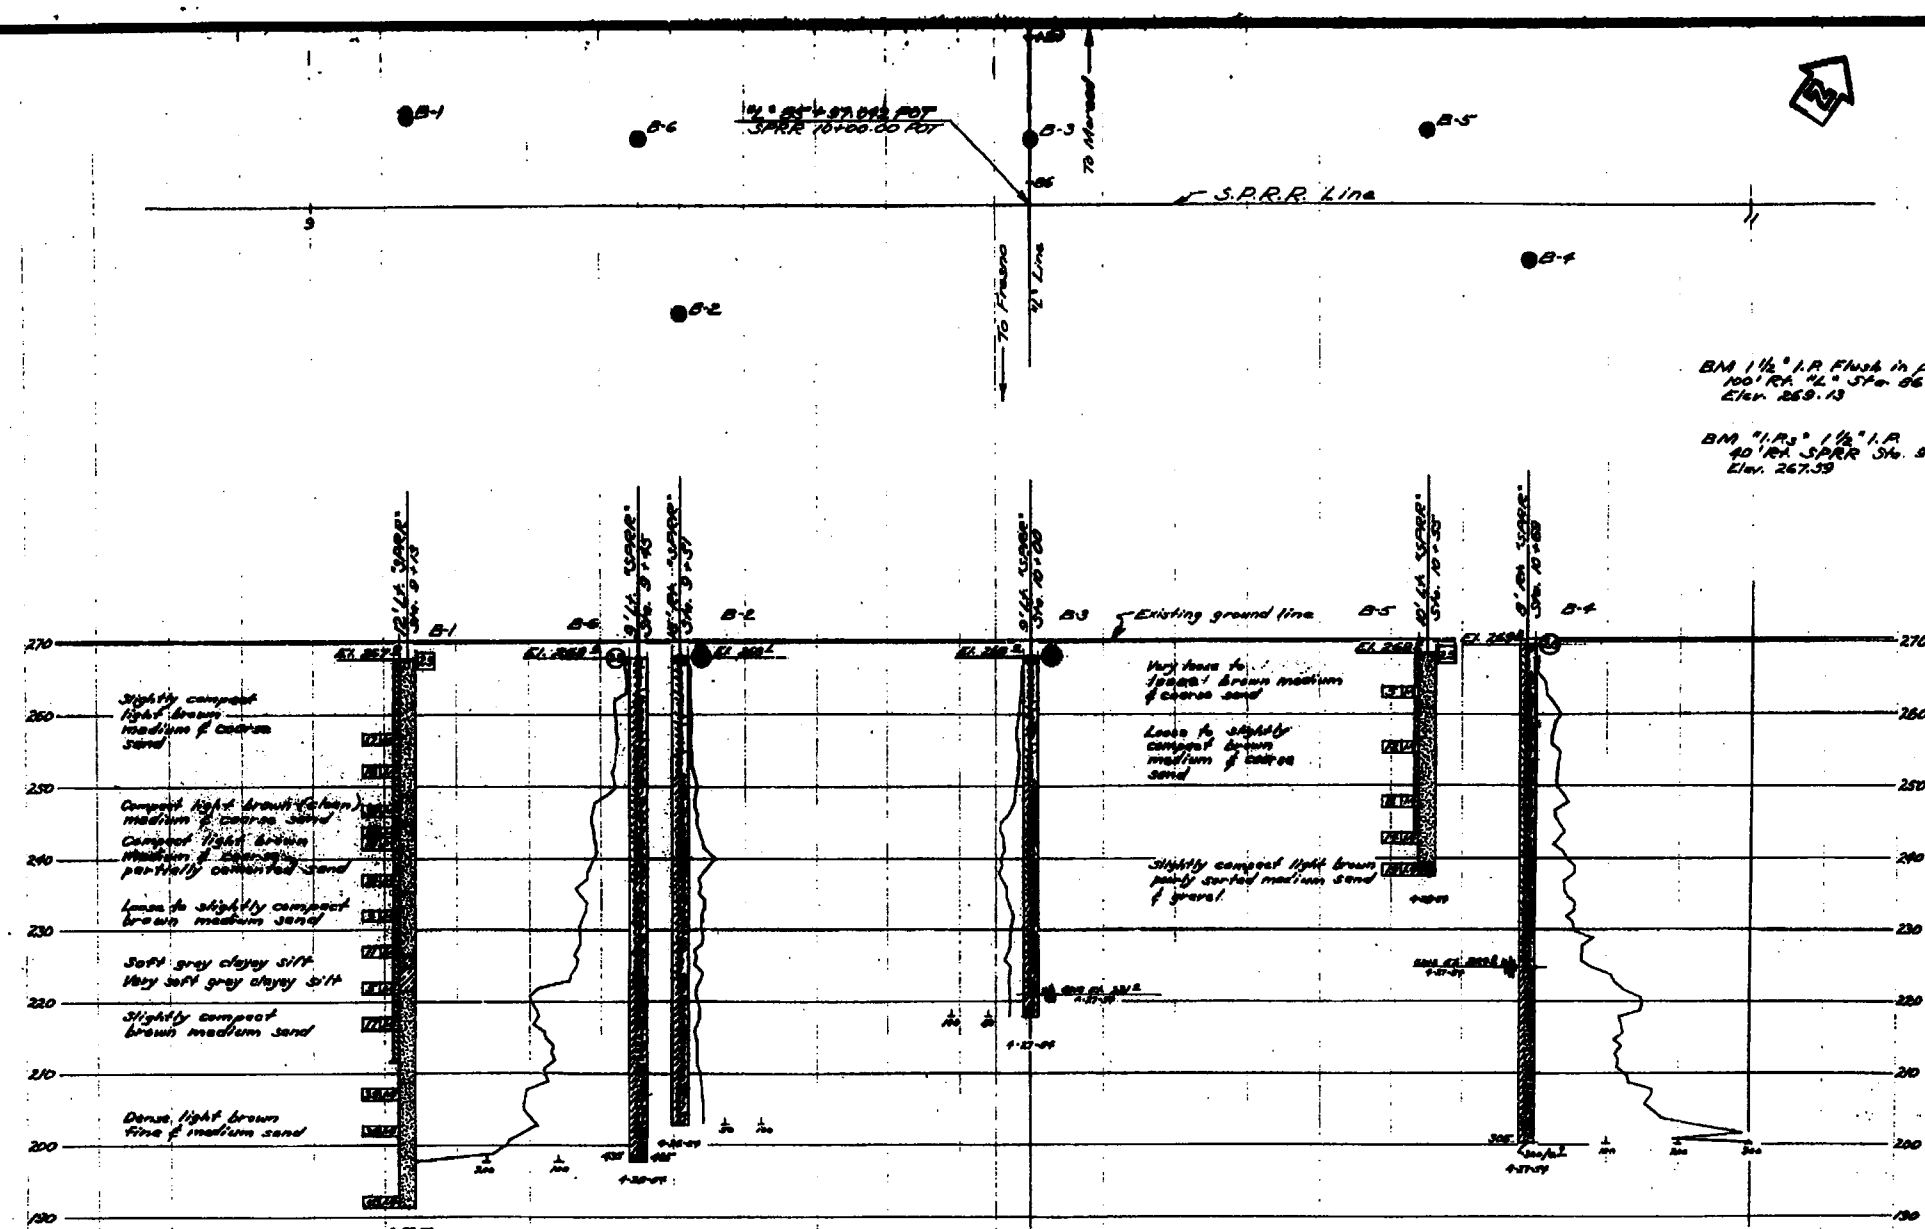


BM 1 1/2" I.P. Flush in pavement  
 100' RA. 1/2" 5' to 66' 37"  
 Elev. 269.13  
 BM 1 1/2" I.P. 1 1/2" I.P.  
 40' RA. S.P.R.R. Sta. 9+00  
 Elev. 267.39

NO AS BUILT CHANGES  
**AS BUILT**  
 CORRECTIONS BY E.S. HOWARD  
 CONTRACT NO. 58-67C2  
 DATE 2-19-58

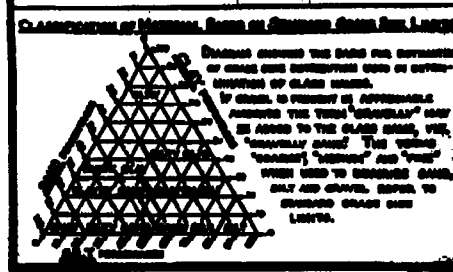

**LEGEND OF EARTH MATERIALS**

Gravel	Silty clay or clayey silt
Sand	Clay and organic matter
Silt	Fill material
Clay	Stratified rock
Sandy clay or clayey sand	Unstratified rock
Sandy silt or silty sand	Massive rock

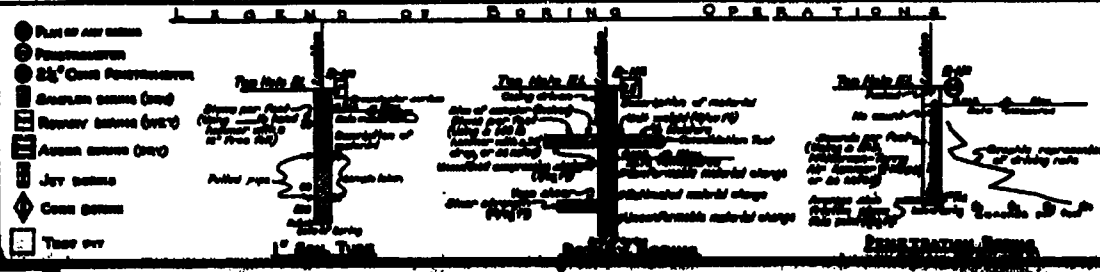

**NOTES**  
 The contractor's attention is directed to Section 5, Article (c) of the Standard Specifications and to the Special Provisions accompanying this set of plans.  
 Classification of work material as shown on this sheet is based upon field inspection and is not to be construed as final material analysis.  
**MADERA UNDERPASS**  
**LOG OF TEST BORINGS**  
 CONTRACT NO. 58-67C2  
 DATE 2-19-58

**AS BUILT PLANS**  
 Contract No. 58-67C2  
 Date Completed \_\_\_\_\_  
 Document No. 60000 994

I HEREBY CERTIFY THAT THIS IS A TRUE AND ACCURATE COPY OF THE ABOVE DOCUMENT TAKEN UNDER MY SUPERVISION AND CONTROL, ON THE DATE IN WHEREAS, CALIFORNIA PURSUANT TO AUTHORIZATION BY THE DIRECTOR OF TRANSPORTATION.  
 1-31-58 *John M. Galt* SUPERVISOR OF HIGHWAYS

180

AS BUILT PLANS  
Contract No. 06-178804  
Date Completed 11-9-89  
Document No.

STATE	PROJECT NO.	DATE	BY
CAL.	06-178804	11-9-89	

DATE	COUNTY	ROUTE	PROJECT NO.	DATE	BY
06	Med	99	11.412.0	35	48

To Accompany Plans Dated 3-28-88

GEOTECHNICAL BRANCH - TRANSPORTATION LABORATORY

FRESNO RIVER BRIDGE

LOG OF TEST BORINGS 2 of 2

DATE: 11-9-89



BY: [Signature]

PROJECT NO.: 06-178804

BRIDGE NO.: 41-0052

AS BUILT PLANS  
Contract No. 68-6722  
Date Completed  
Document No. 6000994

THIS ALTERNATIVE  
NOT CONSTRUCTED

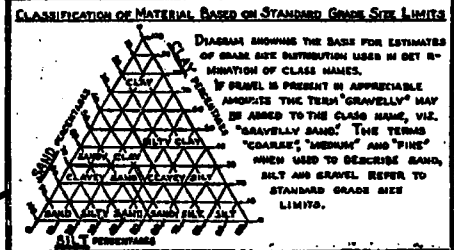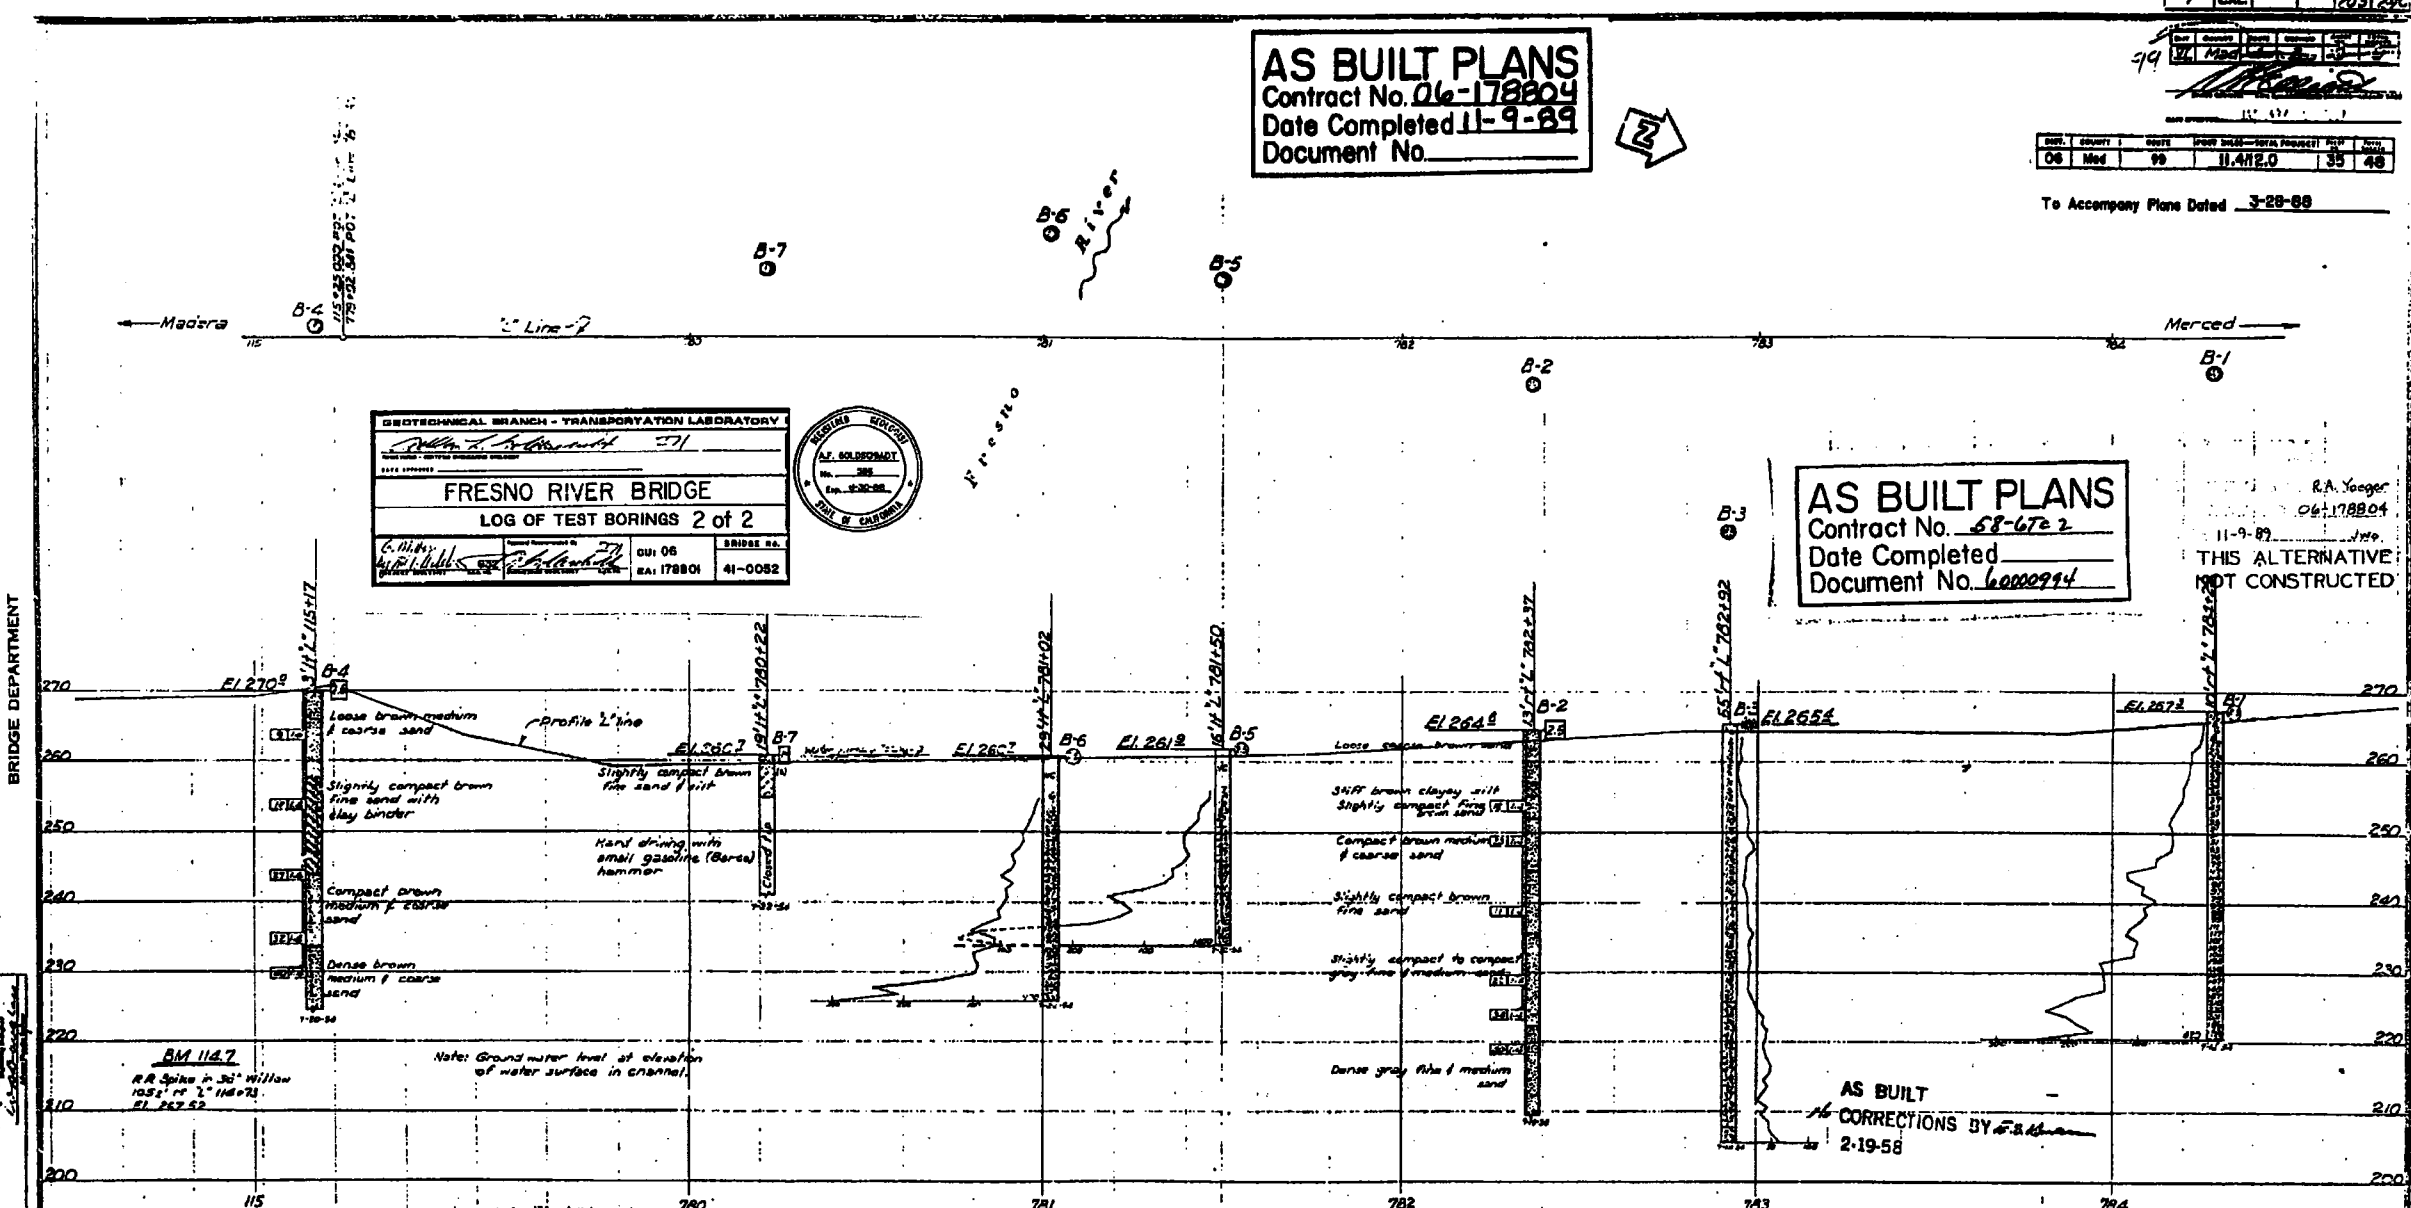

LEGEND OF EARTH MATERIALS

GRAVEL	SILTY CLAY OR CLAYEY SILT
SAND	PEAT AND/OR ORGANIC MATTER
SILT	FILL MATERIAL
CLAY	IGNEOUS ROCK
SANDY CLAY OR CLAYEY SAND	SEDIMENTARY ROCK
SANDY SILT OR SILTY SAND	METAMORPHIC ROCK

LEGEND OF BORING OPERATIONS

PLAN OF ANY BORING	Top Hole El.
PENETROMETER	Bottom Hole El.
2 1/2" CONE PENETROMETER	Penetration Boring
SAMPLER BORING (DEV)	Rotary Boring
ROTARY BORING (WET)	Auger Boring (DEV)
AUGER BORING (DEV)	JET BORING
JET BORING	CORE BORING
CORE BORING	TEST PIT

NOTES

The contractor's attention is directed to Section 8, Article (c) of the Standard Specifications and to the Special Provisions accompanying this set of plans.

Classification of earth material as shown on this sheet is based upon field inspection and is not to be construed to imply mechanical analysis.

BRIDGE ACROSS FRESNO RIVER

LOG OF TEST BORINGS

DATE: 11-9-89

BY: [Signature]

PROJECT NO.: 06-178804

BRIDGE NO.: 41-0052

I HEREBY CERTIFY THAT THIS IS A TRUE AND ACCURATE COPY OF THE ABOVE DOCUMENT TAKEN UNDER MY DIRECTION AND CONTROL ON THIS DATE IN SACRAMENTO, CALIFORNIA PURSUANT TO AUTHORIZATION BY THE DIRECTOR OF PUBLIC WORKS.

DATE: 11/13/92

SIGNATURE: [Signature]

TITLE: JACB

I HEREBY CERTIFY THAT THIS IS A TRUE AND ACCURATE COPY OF THE ABOVE DOCUMENT TAKEN UNDER MY DIRECTION AND CONTROL ON THIS DATE IN SACRAMENTO, CALIFORNIA PURSUANT TO AUTHORIZATION BY THE DIRECTOR OF TRANSPORTATION.

DATE: 8/12/90

SIGNATURE: [Signature]


TITLE: SUPERVISOR OF HIGHWAY DIVISION



BRIDGE DEPARTMENT

FIELD ENGINEER	DATE	BY
CHIEF ENGINEER	DATE	BY
INSPECTOR	DATE	BY

48  
283

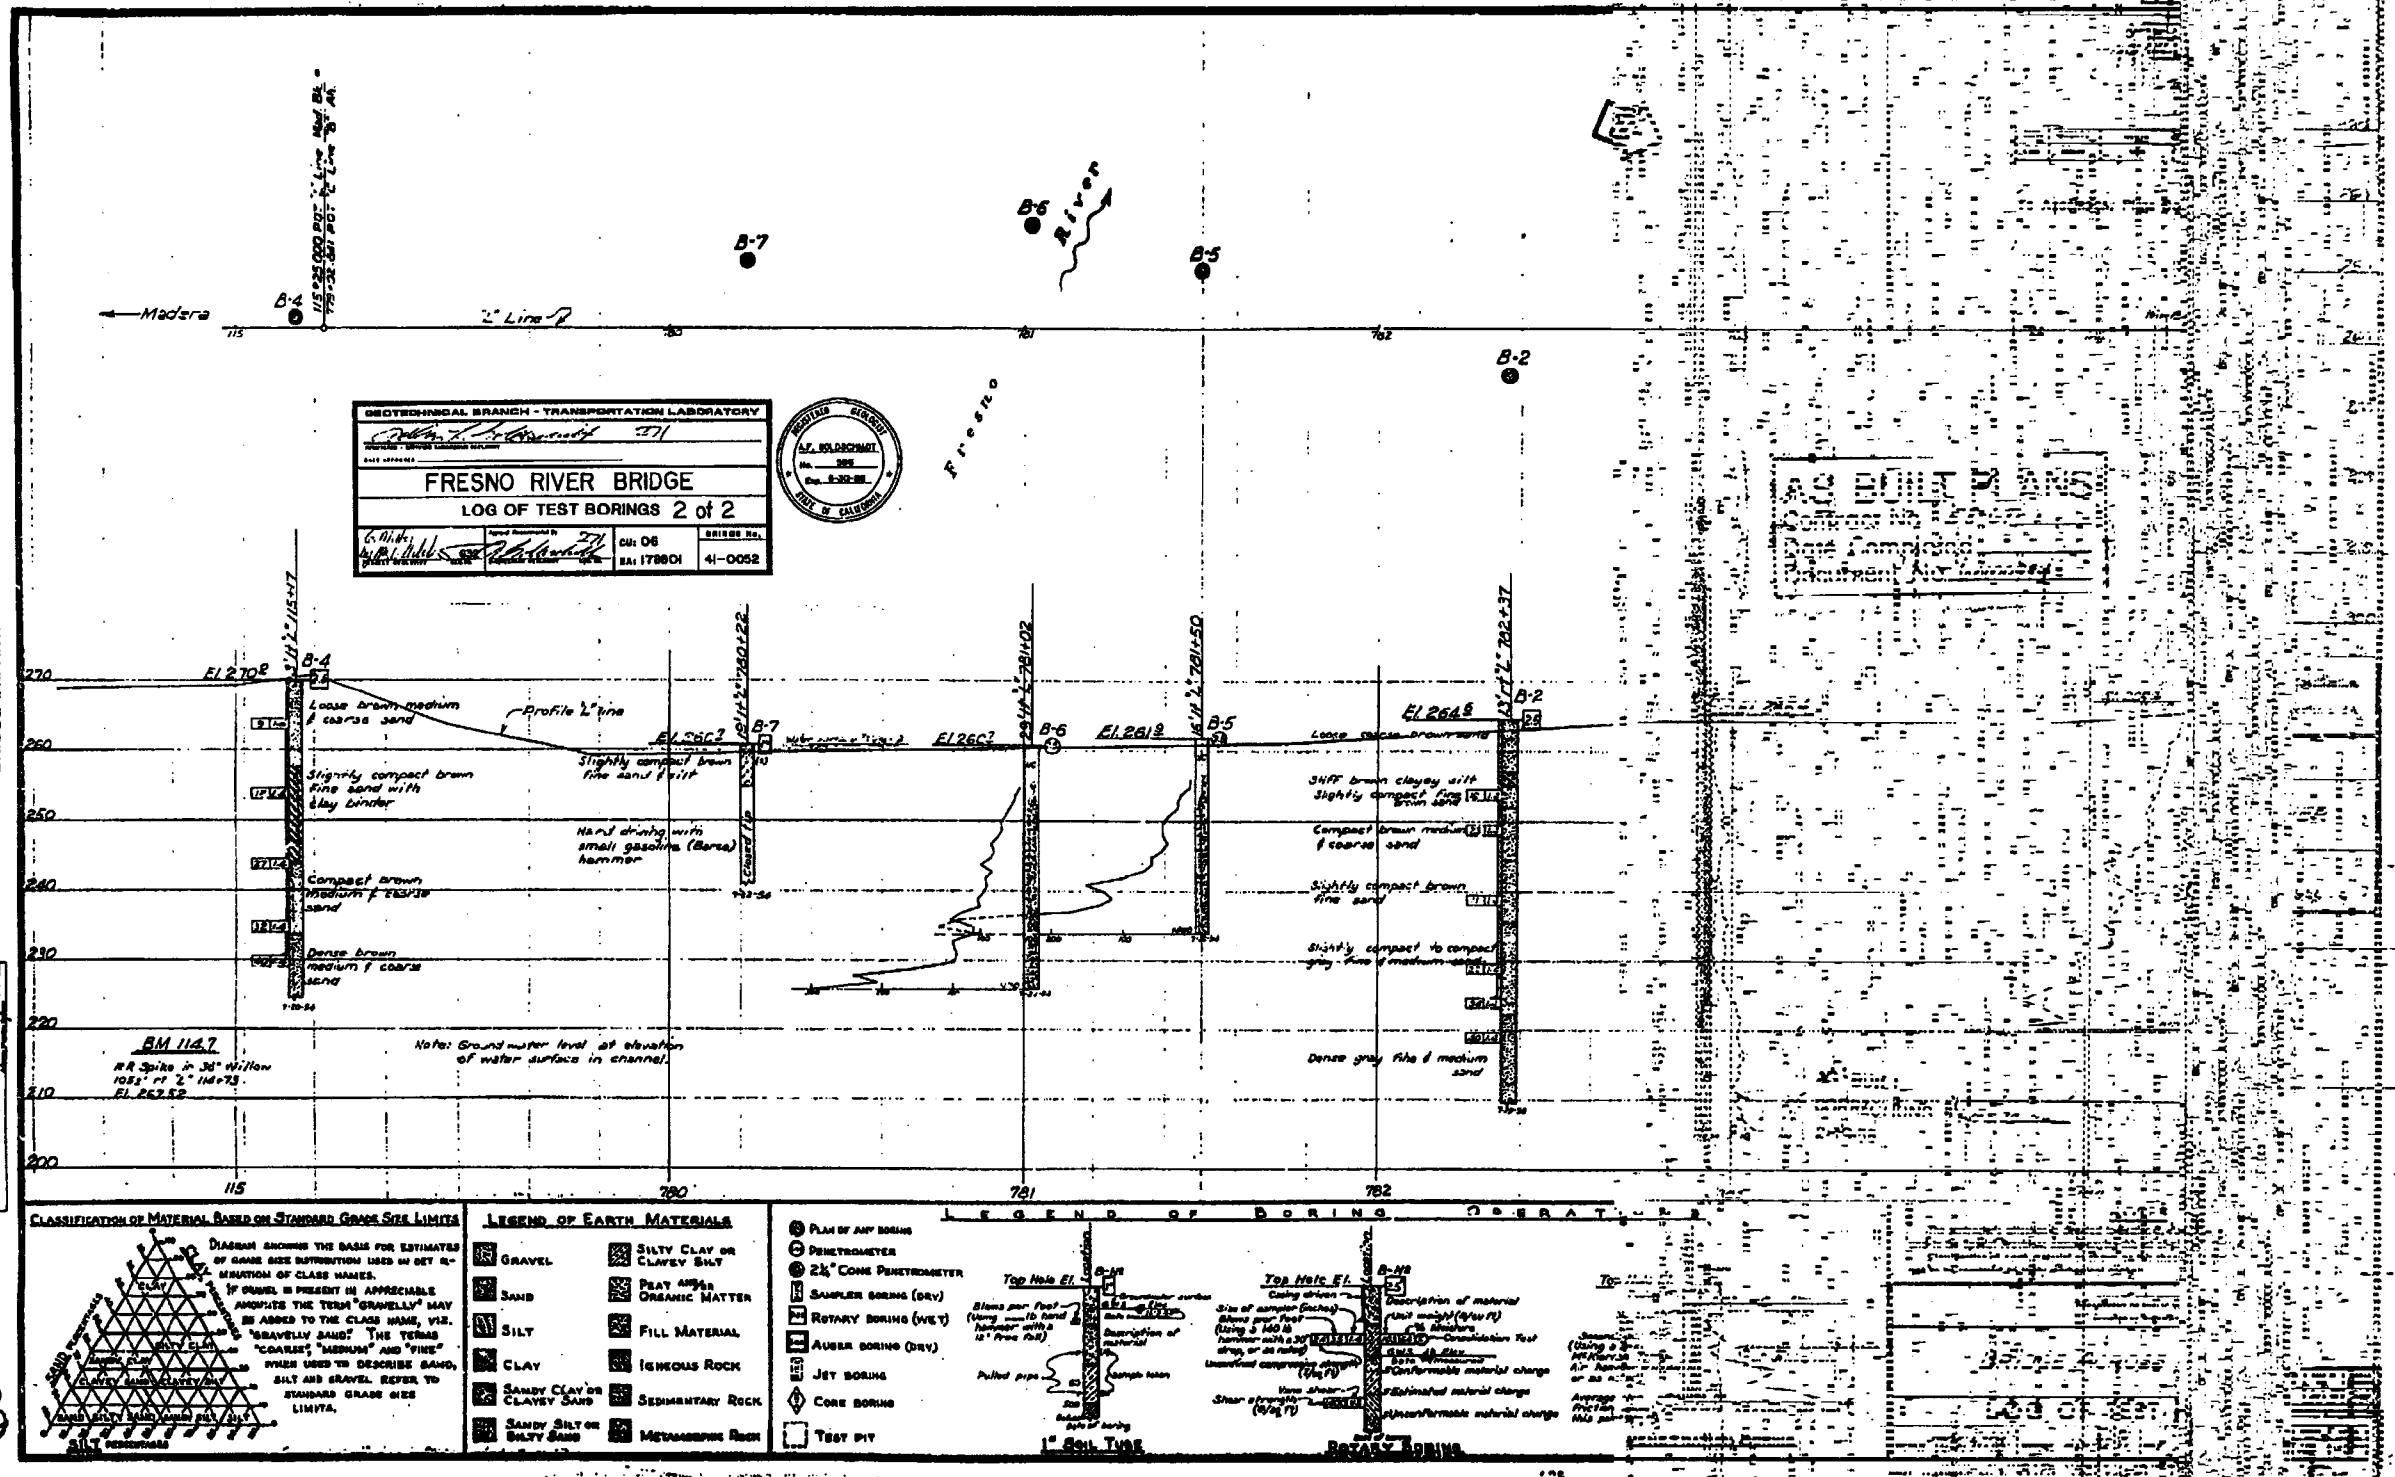

AS BUILT PLANS  
Contract No. 06-178004  
Date Completed 11-9-89  
Document No.

I HEREBY CERTIFY THAT THIS IS A TRUE AND ACCURATE COPY OF THE ABOVE DOCUMENT  
UNDER MY DIRECTION AND CONTROL, ON THIS DATE IN SACRAMENTO, CALIFORNIA  
AUTHORIZATION BY THE DIRECTOR OF TRANSPORTATION  
DATE 11/15/92 SIGNATURE [Signature] TITLE [Title]  
11/15/92 [Signature] SUPERVISOR

DIST	COUNTY	ROUTE	POST MILES TOTAL PROJECT	SHEET NO.	TOTAL SHEETS
06	Mod	99	11.4/12.0	34	48

REGISTERED-CERTIFIED  
ENGINEERING GEOLOGIST  
3-28-89  
PLANS APPROVAL DATE


SEAL  
J.E. SALASAR  
No. 788  
Exp. 8-30-90  
STATE OF CALIFORNIA

LEGEND OF BORING OPERATIONS

Legend of Earth Materials

Consistency Classification for Soils

Unified Soil Classification System

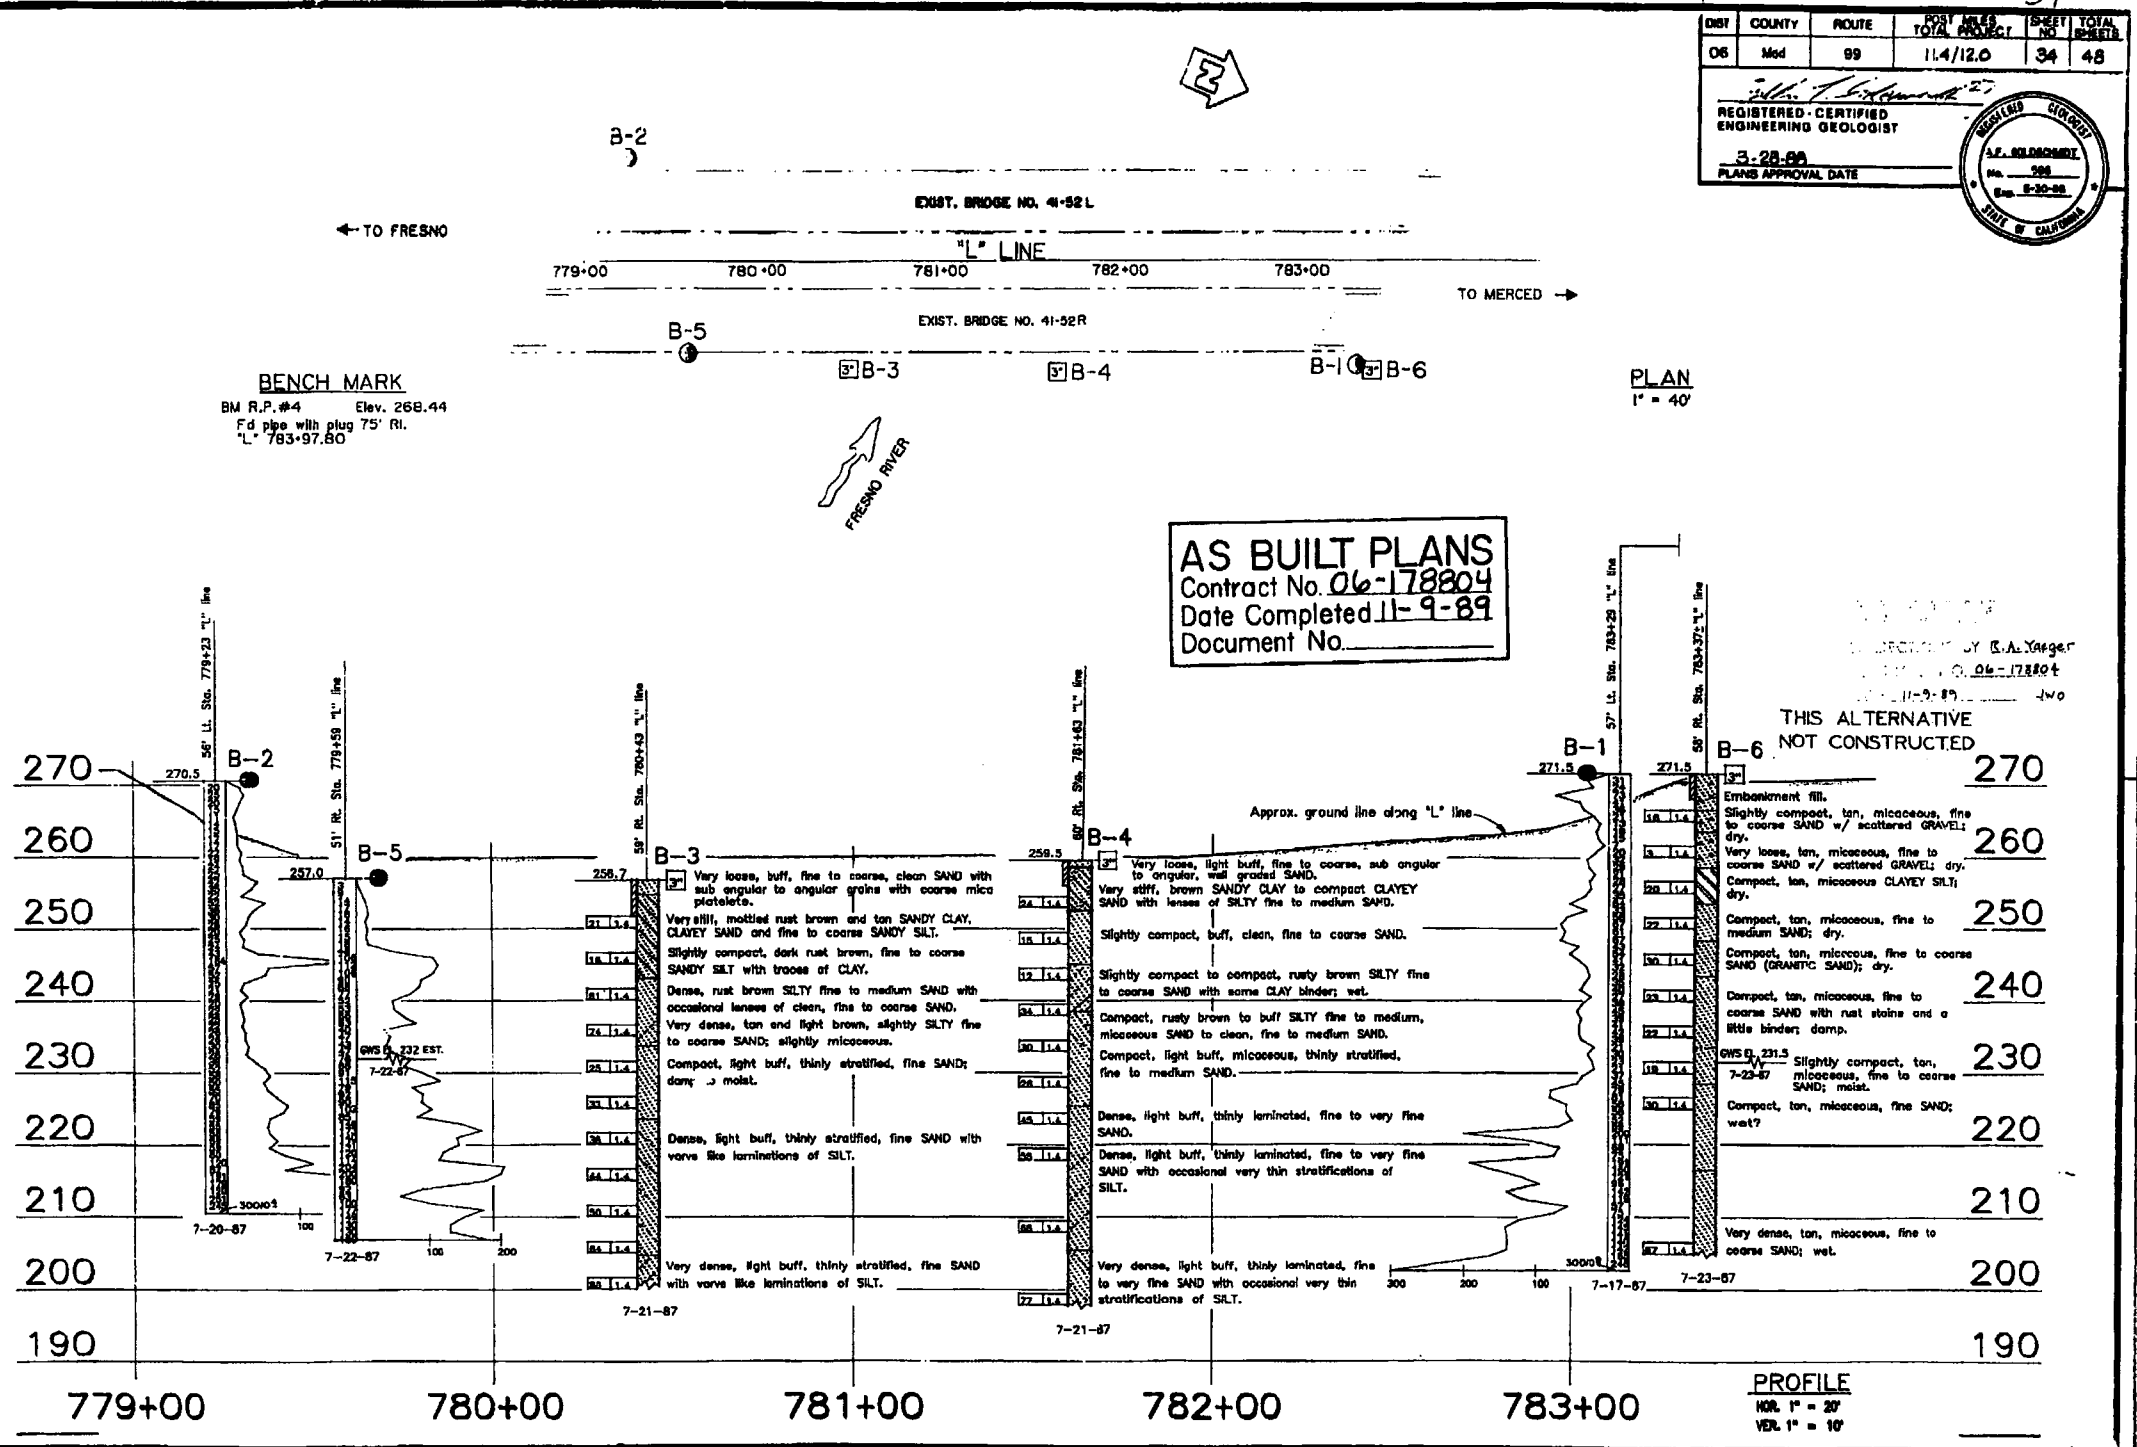

AS BUILT PLANS  
Contract No. 06-178804  
Date Completed 11-9-89  
Document No.

THIS ALTERNATIVE  
NOT CONSTRUCTED

GEOLOGICAL BRANCH - TRANSPORTATION LABORATORY				State of CALIFORNIA		STRUCTURES - DESIGN 7		BRIDGE NO. 41-52		FRESNO RIVER BRIDGE (WIDEN)	
DRAWN BY: L. Howell				CHECKED BY: J. E. Salazar		DATE: 11-9-89		POST MILES: 11.7		LOG OF TEST BORINGS 1 of 2	
PROJECT: 06-178804				SHEET: 34		CU 08200		SA 178804		14 15	

I HEREBY CERTIFY THAT THIS IS A TRUE AND ACCURATE COPY OF THE ABOVE DOCUMENT TAKEN UNDER MY DIRECTION AND CONTROL ON THE DATE IN SACRAMENTO, CALIFORNIA PURSUANT TO AUTHORIZATION BY THE DIRECTOR OF TRANSPORTATION.

8/1/90 Donald Blackford



47

DIST	COUNTY	ROUTE	POST MILES	SHEET NO.	TOTAL SHEETS
06	Med	99	11.4/12.0	47	48

REGISTERED - CERTIFIED  
ENGINEERING GEOLOGIST  
3-28-88  
PLANS APPROVAL DATE

U.S. GEOLOGICAL SURVEY  
CALIFORNIA DISTRICT OFFICE  
FRESNO, CALIF. 93701

**AS BUILT PLANS**  
Contract No. 06-178804  
Date Completed 11-9-89  
Document No.

**AS BUILT**  
CORRECTIONS BY: R.A. Yeager  
CONTRACT NO. 06-178804  
DATE 11-9-89 JWO


**LEGEND OF BORING OPERATIONS**

Legend of Earth Materials

Consistency Classification

Soil Scale

Unified Soil Classification System

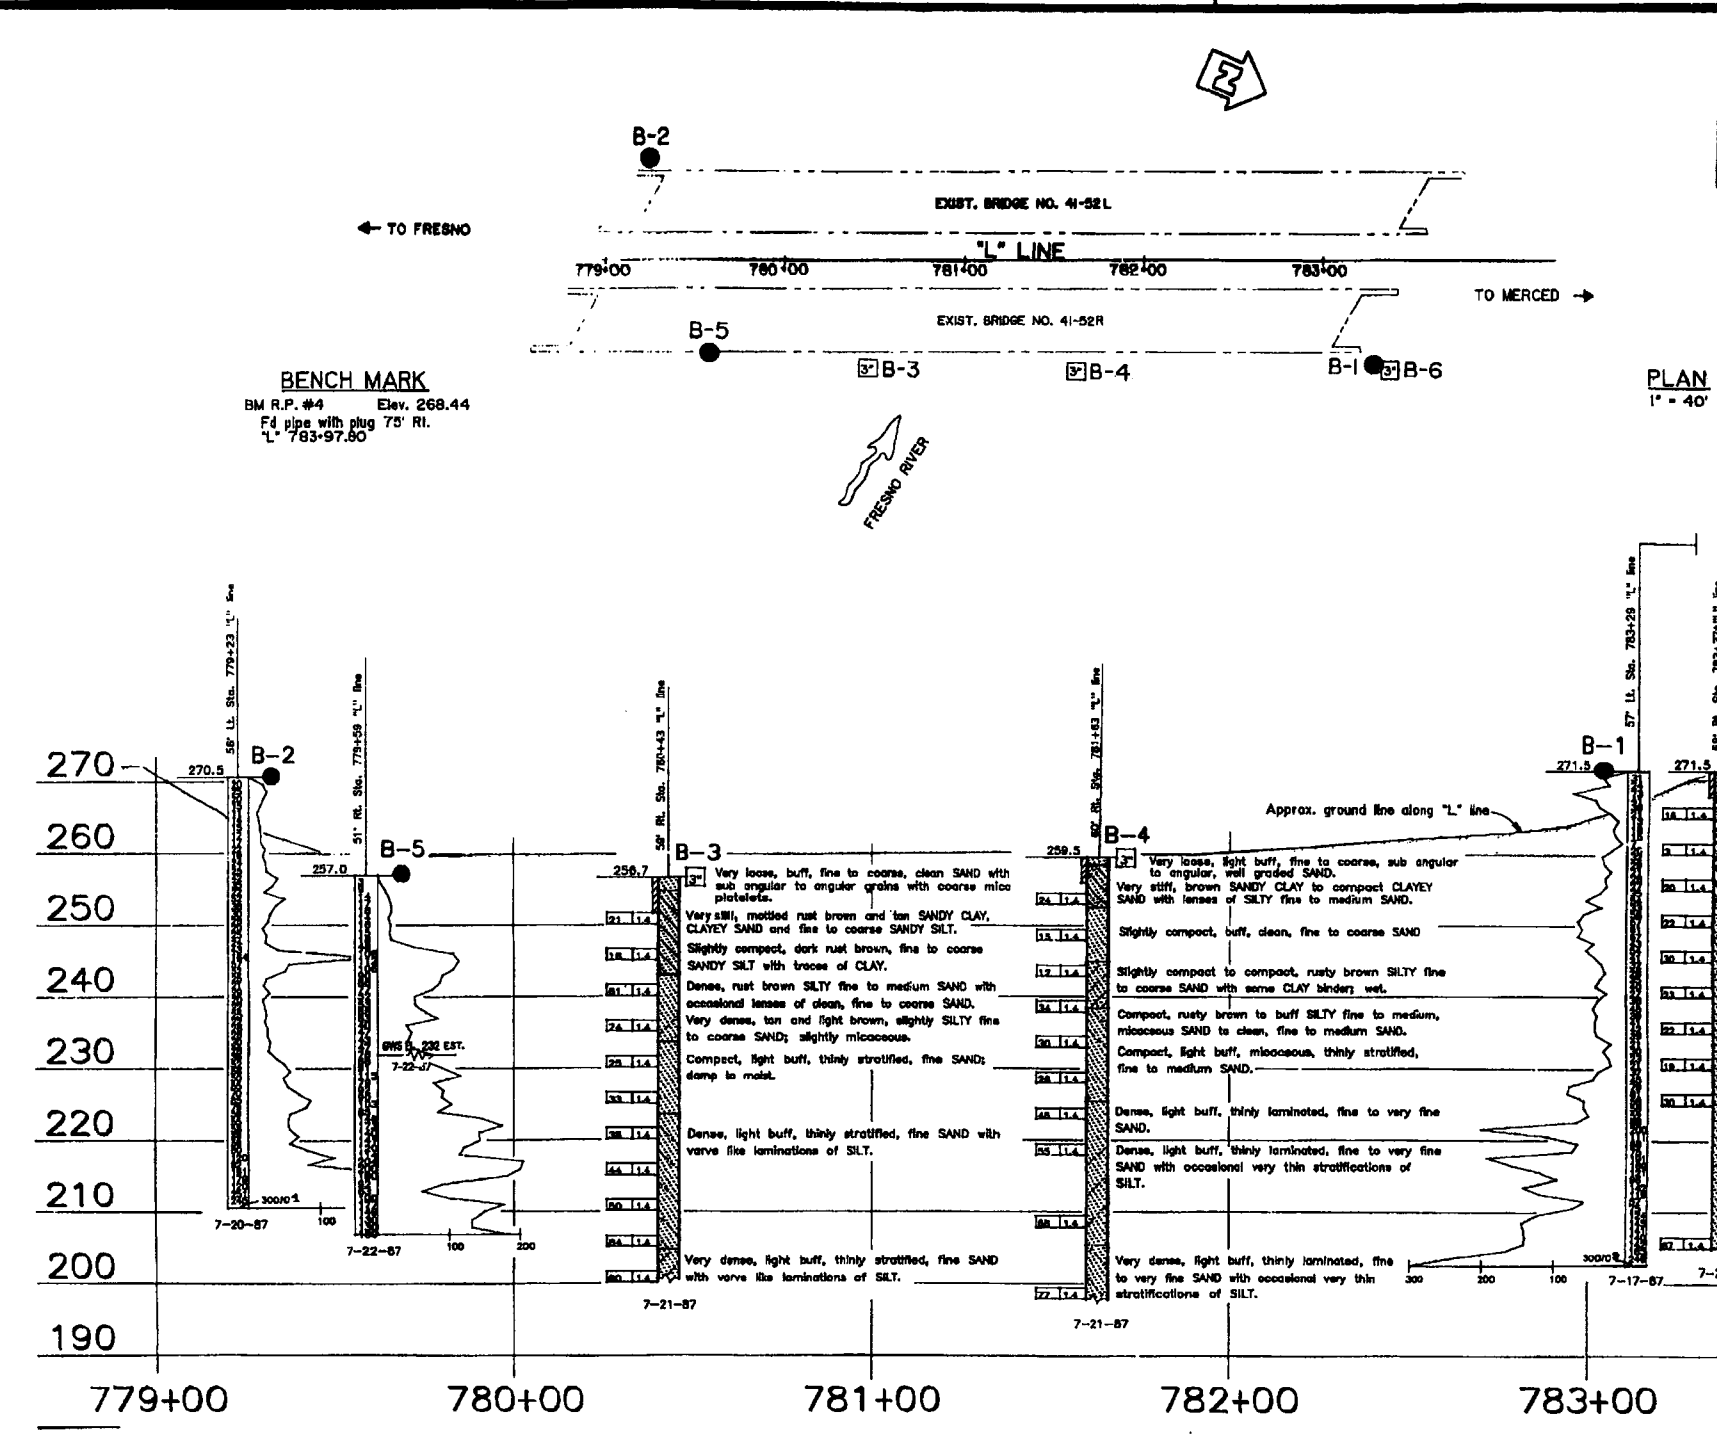

<b>GEOTECHNICAL BRANCH - TRANSPORTATION LABORATORY</b>				<b>State of CALIFORNIA</b>		<b>STRUCTURES - DESIGN</b>		<b>FRESNO RIVER BRIDGE (WIDEN)</b>	
DRAWN BY: L. Howell				DEPARTMENT OF TRANSPORTATION		PROJECT NO. 06-178804		LOG OF TEST BORINGS 1 of 2	
CHECKED BY: [Signature]				DATE: 11/9/89		SHEET NO. 47		TOTAL SHEETS 48	
APPROVED BY: [Signature]				DATE: 11/9/89		PROJECT NO. 06-178804		SHEET NO. 47	

I HEREBY CERTIFY THAT THIS IS A TRUE AND ACCURATE COPY OF THE ABOVE DOCUMENT TAKEN UNDER MY DIRECTION AND CONTROL ON THIS DATE IN SACRAMENTO, CALIFORNIA PURSUANT TO AUTHORIZATION BY THE DIRECTOR OF TRANSPORTATION.

8/21/90 [Signature]

## Log of Test Boring: MW-8

**Project No:** 17-99015  
**Project:** Harmin's Liquor  
**Location:** Madera, CA  
**Depth to Water (Initial):** 110'

**Figure:** A-4  
**Logged By:** S.B.  
**Client:** Amrik Gill  
**Depth to Water (Completion):** 110'

SUBSURFACE PROFILE			SAMPLE			Volatile Organic Concentration					Notes
Depth	Symbol	Description	Number	OVM	Blows/Foot	Parts Per Million (ppm)					
						100	300	500	700	900	
0		Ground Surface									
		Approximately 2 inches of asphalt beneath 3 inch layer pf soil.									
		<i>Silty Sand (SM)</i>									
5		Brown; moist; fine to medium grained; gravel particles; loose.									
10		Hardpan; grades light brown. Very hard drilling.									
15											
20											
25		Grades brown and gray. Medium to coarse grained.									
30											
35		Grades fine.									
40		Grades gray. Fine to medium grained.									
45											
	</										

**Drill Method:** H/S Auger

**Drill Date:** 3/23/05

**Hole Size:** 8"

ASR Engineering, Inc.  
 3629 W. Gettysburg Ave.  
 Fresno, CA. 93722  
 phone: (559) 271-5260  
 fax: (559) 271-5267

e-mail: asrengineering@sbcglobal.net  
**GEO TRACKER ID: T603900177**

**Drilled by:** CME-75

**Sheet:** 1 of 3

**Engineer:** Zaki Niaz  
**P.M. 11.80**



## Log of Test Boring: MW-6

**Project No:** 17-99015

**Project:** Harmin's Liquor

**Location:** Madera, CA

**Depth to Water (Initial):** 110'

**Figure:** A-2

**Logged By:** S.B.

**Client:** Amrik Gill

**Depth to Water (Completion):** 110'

SUBSURFACE PROFILE			SAMPLE			Volatile Organic Concentration Parts Per Million (ppm)	Notes
Depth	Symbol	Description	Number	OVM	Blows/Foot		
						100 300 500 700 900	
0		Ground Surface					
		<b>Clayey Sand (SC)</b> Dark brown; moist; fine to medium grained; very soft.	1	-	-		
5			2	2129	3		No petroleum odor present.
10		Grades light brown.	3	1035	22		"
15		Grades dark brown. Dense.	4	894	60		"
20			5	346	31		"
25			6	1409	100+		"
30			7	592	56		Petroleum odor present.
35			8	667	21		Moderate petroleum odor.
		<b>Poorly Graded Sand (SP)</b> Gray; moist; medium grained; loose.					
40			9	4488	61		Very strong petroleum odor.
		<b>Silty Sand (SM)</b> Brown; moist; medium grained; dense.					
45			10	512	36		Light petroleum odor.
		<b>Clayey Sand (SC)</b> Gray; moist; fine to medium grained; firm.					

**Drill Method:** H/S Auger

**Drill Date:** 3/21/05

**Hole Size:** 8"

ASR Engineering, Inc.  
3629 W. Gettysburg Ave.  
Fresno, CA. 93722  
phone: (559) 271-5260  
fax: (559) 271-5267

e-mail: asrengineering@sbcglobal.net  
**GEO TRACKER ID: T603900177**

**Drilled by:** CME-75

**Sheet:** 1 of 3

**Engineer:** Zaki Niaz  
**P.M. 11.80**

## Log of Test Boring: MW-6

**Project No:** 17-99015

**Project:** Harmin's Liquor

**Location:** Madera, CA






**Depth to Water (Initial):** 110'

**Figure:** A-2

**Logged By:** S.B.

**Client:** Amrik Gill

**Depth to Water (Completion):** 110'

SUBSURFACE PROFILE			SAMPLE			Volatile Organic Concentration  Parts Per Million (ppm)	Notes
Depth	Symbol	Description	Number	QVM	Blows/Foot		
						100 300 500 700 900	
54		<b>Clayey Sand (SC)</b> Gray; moist; fine to medium grained; firm.	11	412	32		"
59		<b>Well-Graded Sand (SW)</b> Light gray; damp; medium grained; loose.	12	1479	36		Moderate petroleum odor.
64			13	1006	37		"
69		<b>Poorly-Graded Sand (SP)</b> Light gray; damp; medium grained; medium dense.	14	1786	55		"
74			15	879	66		Mild petroleum odor.
79			16	190	100+		"
84		<b>Silty Sand (SM)</b> Light gray; damp; fine to medium grained; dense.	17	352	100+		No petroleum odor.
89		Grades light brown.	18	196	47		"
94			19	89	68		"
		<b>Well-Graded Sand (SW)</b> Light brown; moist; medium grained; dense.	20	27	48		No petroleum odor.

**Drill Method:** H/S Auger

**Drill Date:** 3/21/05

**Hole Size:** 8"

**ASR Engineering, Inc.**  
3629 W. Gettysburg Ave.  
Fresno, CA. 93722  
phone: (559) 271-5260  
fax: (559) 271-5267

e-mail: [asrengineering@sbcglobal.net](mailto:asrengineering@sbcglobal.net)  
**GEO TRACKER ID: T603900177**

**Drilled by:** CME-75

**Sheet:** 2 of 3

**Engineer:** Zaki Niaz  
**P.M. 11.80**



## Log of Test Boring: MW-6

**Project No:** 17-99015

**Project:** Harmin's Liquor

**Location:** Madera, CA

**Depth to Water (Initial):** 110'

**Figure:** A-2

**Logged By:** S.B.

**Client:** Amrik Gill

**Depth to Water (Completion):** 110'

SUBSURFACE PROFILE			SAMPLE			Volatile Organic Concentration  Parts Per Million (ppm)	Notes
Depth	Symbol	Description	Number	OVM	Blows/Foot		
						100 300 500 700 900	
103		<b>Clayey Sand (SC)</b> Light gray; moist; fine to medium grained; medium dense.	21	11	35		No petroleum odor.
108		<b>Silty Sand (SM)</b> Light brown; moist; fine to medium grained; medium dense.	22	38	38		"
		Grades light gray. Wet.	23	2	23		"
113							
118			24	-	-		Too wet to collect sample.
123			25	-	-		"
128		End of Borehole					"
133							
138							
143							

**Drill Method:** H/S Auger

**Drill Date:** 3/21/05

**Hole Size:** 8"

**ASR Engineering, Inc.**  
3629 W. Gettysburg Ave.  
Fresno, CA. 93722

phone: (559) 271-5260

fax: (559) 271-5267

e-mail: [asrengineering@sbcglobal.net](mailto:asrengineering@sbcglobal.net)

**GEO TRACKER ID: T603900177**

**Drilled by:** CME-75

**Sheet:** 3 of 3

**Engineer:** Zaki Niaz

**P.M. 11.80**

## Log of Test Boring: MW-8

**Project No:** 17-99015

**Project:** Harmin's Liquor

**Location:** Madera, CA

**Depth to Water (Initial):** 110'

**Figure:** A-4

**Logged By:** S.B.

**Client:** Amrik Gill

**Depth to Water (Completion):** 110'

SUBSURFACE PROFILE			SAMPLE			Volatile Organic Concentration  Parts Per Million (ppm)					Notes
Depth	Symbol	Description	Number	OVM	Blows/Foot						
						100	300	500	700	900	
		<del>Silty Sand (SM)</del> Brown; moist; fine to medium grained; gravel particles; loose.									
54											
59											
64		Grades fine grained.									
69											
74											
79											
84											
89											
94											

**Drill Method:** H/S Auger

**Drill Date:** 3/23/05

**Hole Size:** 8"

ASR Engineering, Inc.  
3629 W. Gettysburg Ave.  
Fresno, CA. 93722  
phone: (559) 271-5260  
fax: (559) 271-5267

e-mail: [asrengineering@sbcglobal.net](mailto:asrengineering@sbcglobal.net)  
**GEO TRACKER ID: T603900177**

**Drilled by:** CME-75

**Sheet:** 2 of 3

**Engineer:** Zaki Niaz  
**P.M. 11.80**



## Log of Test Boring: MW-8

**Project No:** 17-99015

**Project:** Harmin's Liquor

**Location:** Madera, CA

**Depth to Water (Initial):** 110'

**Figure:** A-4

**Logged By:** S.B.

**Client:** Amrik Gill

**Depth to Water (Completion):** 110'

SUBSURFACE PROFILE			SAMPLE			Volatile Organic Concentration  Parts Per Million (ppm)	Notes
Depth	Symbol	Description	Number	OVM	Blows/Foot		
						100 300 500 700 900	
103							
108							
113		End of Borehole					
118							
123							
128							
133							
138							
143							

**Drill Method:** H/S Auger

**Drill Date:** 3/23/05

**Hole Size:** 8"

ASR Engineering, Inc.  
3629 W. Gettysburg Ave.  
Fresno, CA. 93722  
phone: (559) 271-5260  
fax: (559) 271-5267

e-mail: asrengineering@sbcglobal.net  
**GEO TRACKER ID: T603900177**

**Drilled by:** CME-75

**Sheet:** 3 of 3

**Engineer:** Zaki Niaz  
**P.M. 11.80**

## Log of Test Boring: MW-7

**Project No:** 17-99015

**Project:** Harmin's Liquor

**Location:** Madera, CA

**Depth to Water (Initial):** 110'

**Figure:** A-4

**Logged By:** S.B.

**Client:** Amrik Gill

**Depth to Water (Completion):** 110'

SUBSURFACE PROFILE			SAMPLE			Volatile Organic Concentration  Parts Per Million (ppm)	Notes
Depth	Symbol	Description	Number	QVM	Blows/Foot		
0		Ground Surface					
0		<i>Silty Sand (SM)</i> Yellow brown; fine to medium grained; fill material					
5							
10		<i>Silty Sand (SM)</i> Yellow brown; cemented; no odor					
15							
20							
25							
30							
35		<i>Sand (SP)</i> Olive brown; moist; fine to medium grained					
40							
45		<i>Sandy Silt (ML)</i> Olive green; moist to wet; trace of clay					

**Drill Method:** H/S Auger

**Drill Date:** 3/23/05

**Hole Size:** 8"

ASR Engineering, Inc.  
3629 W. Gettysburg Ave.  
Fresno, CA. 93722  
phone: (559) 271-5260  
fax: (559) 271-5267

e-mail: [asrengineering@sbcglobal.net](mailto:asrengineering@sbcglobal.net)  
**GEO TRACKER ID: T603900177**

**Drilled by:** CME-75

**Sheet:** 1 of 3

**Engineer:** Zaki Niaz  
**P.M. 11.80**



## Log of Test Boring: MW-7

**Project No:** 17-99015

**Project:** Harmin's Liquor

**Location:** Madera, CA






**Depth to Water (Initial):** 110'

**Figure:** A-4

**Logged By:** S.B.

**Client:** Amrik Gill

**Depth to Water (Completion):** 110'

SUBSURFACE PROFILE			SAMPLE			Volatile Organic Concentration					Notes
Depth	Symbol	Description	Number	OVM	Blows/Foot	Parts Per Million (ppm)					
						100	300	500	700	900	
		<b>Sandy Silt (ML)</b> Olive green; moist to wet; trace of clay									
54		<b>Sand (SP)</b> Olive green; moist; fine to medium grained									
59											
64											
64		<b>Silty Sand (SM)</b> Grey; fine grained									
69											
69		<b>Sand (SP)</b> Grey; fine grained									
74											
79											
84											
89											
94											
94		<b>Sand (SP)</b> Grey; moist; fine to medium grained									

**Drill Method:** H/S Auger

**Drill Date:** 3/23/05

**Hole Size:** 8"

**ASR Engineering, Inc.**  
3629 W. Gettysburg Ave.  
Fresno, CA. 93722  
phone: (559) 271-5260  
fax: (559) 271-5267

e-mail: asrengineering@sbcglobal.net  
**GEO TRACKER ID: T603900177**

**Drilled by:** CME-75

**Sheet:** 2 of 3

**Engineer:** Zaki Niaz  
**P.M. 11.80**

## Log of Test Boring: MW-7

**Project No:** 17-99015

**Project:** Harmin's Liquor

**Location:** Madera, CA



**Depth to Water (Initial):** 110'

**Figure:** A-4

**Logged By:** S.B.

**Client:** Amrik Gill

**Depth to Water (Completion):** 110'

SUBSURFACE PROFILE			SAMPLE			Volatile Organic Concentration					Notes
Depth	Symbol	Description	Number	OVM	Blows/Foot	Parts Per Million (ppm)					
						100	300	500	700	900	
103		<i>Sand (SP)</i> Grey; moist; fine to medium grained  									
108											
113											
118											
123											
128		End of Borehole									
133											
138											
143											

**Drill Method:** H/S Auger

**Drill Date:** 3/23/05

**Hole Size:** 8"

ASR Engineering, Inc.  
3629 W. Gettysburg Ave.  
Fresno, CA. 93722

phone: (559) 271-5260

fax: (559) 271-5267

e-mail: asrengineering@sbcglobal.net

**GEO TRACKER ID: T603900177**

**Drilled by:** CME-75

**Sheet:** 3 of 3

**Engineer:** Zaki Niaz

**P.M. 11.80**



## Log of Test Boring: SVMP#1

**Project No:** 17-99015

**Project:** Harmin's Liquor

**Location:** Madera, CA

**Depth to Water (Initial):**

**Figure:** A-2

**Logged By:** A.G.

**Client:** Mr. Amrik Gill

**Depth to Water (Completion):**

SUBSURFACE PROFILE			SAMPLE			Volatile Organic Concentration  Parts Per Million (ppm)	Notes
Depth	Symbol	Description	Number	OVM	Blows/Foot		
0		Ground Surface				50 150 250	
		<b>Silty Sand (SM)</b> Dark brown; moist; fine grained					
5							
			1	0	-		
10		<b>Sandy Clay (CL)</b> Brown; moist	2	0	-		
		Grades dark brown					
		Grades olive gray between 14' and					
15			3	0	-		
		End of Borehole					
20							
25							

**Drill Method:** Geoprobe 66 DT

**Drill Date:** 7/18/08

**Hole Size:** 2.5"

**ASR Engineering, Inc.**  
3629 W. Gettysburg Ave.  
Fresno, CA. 93722  
phone: (559) 271-5260  
fax: (559) 271-5267

e-mail: asrengineering@sbcglobal.net  
**GEO TRACKER ID: T603900177**

**Drilled by:** Soilprobe Inc

**Sheet:** 1 of 1

**Engineer:** ASR

**P.M. 11.80**

## Log of Test Boring: SVMP#2

**Project No:** 17-99015

**Project:** Harmin's Liquor

**Location:** Madera, CA

**Depth to Water (Initial):**

**Figure:** A-3

**Logged By:** A.G.

**Client:** Mr. Amrik Gill

**Depth to Water (Completion):**

SUBSURFACE PROFILE			SAMPLE			Volatile Organic Concentration  Parts Per Million (ppm)	Notes
Depth	Symbol	Description	Number	QVM	Blows/Foot		
0		Ground Surface					
		<b>Silty Sand (SM)</b> Brown; moist; fine grained					
5							
			1	0	-		
10		<b>Sandy Clay (CL)</b> Dark brown; moist					
		<b>Clayey Sand (SC)</b> Dark brown; moist fine grained; 1' layer	2	0	-		
15		<b>Sandy Clay (CL)</b> Dark brown; moist					
			3	0	-		
		End of Borehole					
20							
25							

**Drill Method:** Geoprobe 66 DT

**Drill Date:** 7/18/08

**Hole Size:** 2.5"

**ASR Engineering, Inc.**

3629 W. Gettysburg Ave.

Fresno, CA. 93722

phone: (559) 271-5260

fax: (559) 271-5267

e-mail: asrengineering@sbcglobal.net

**GEO TRACKER ID: T603900177**


**Drilled by:** Soilprobe Inc

**Sheet:** 1 of 1

**Engineer:** ASR

**P.M. 11.80**



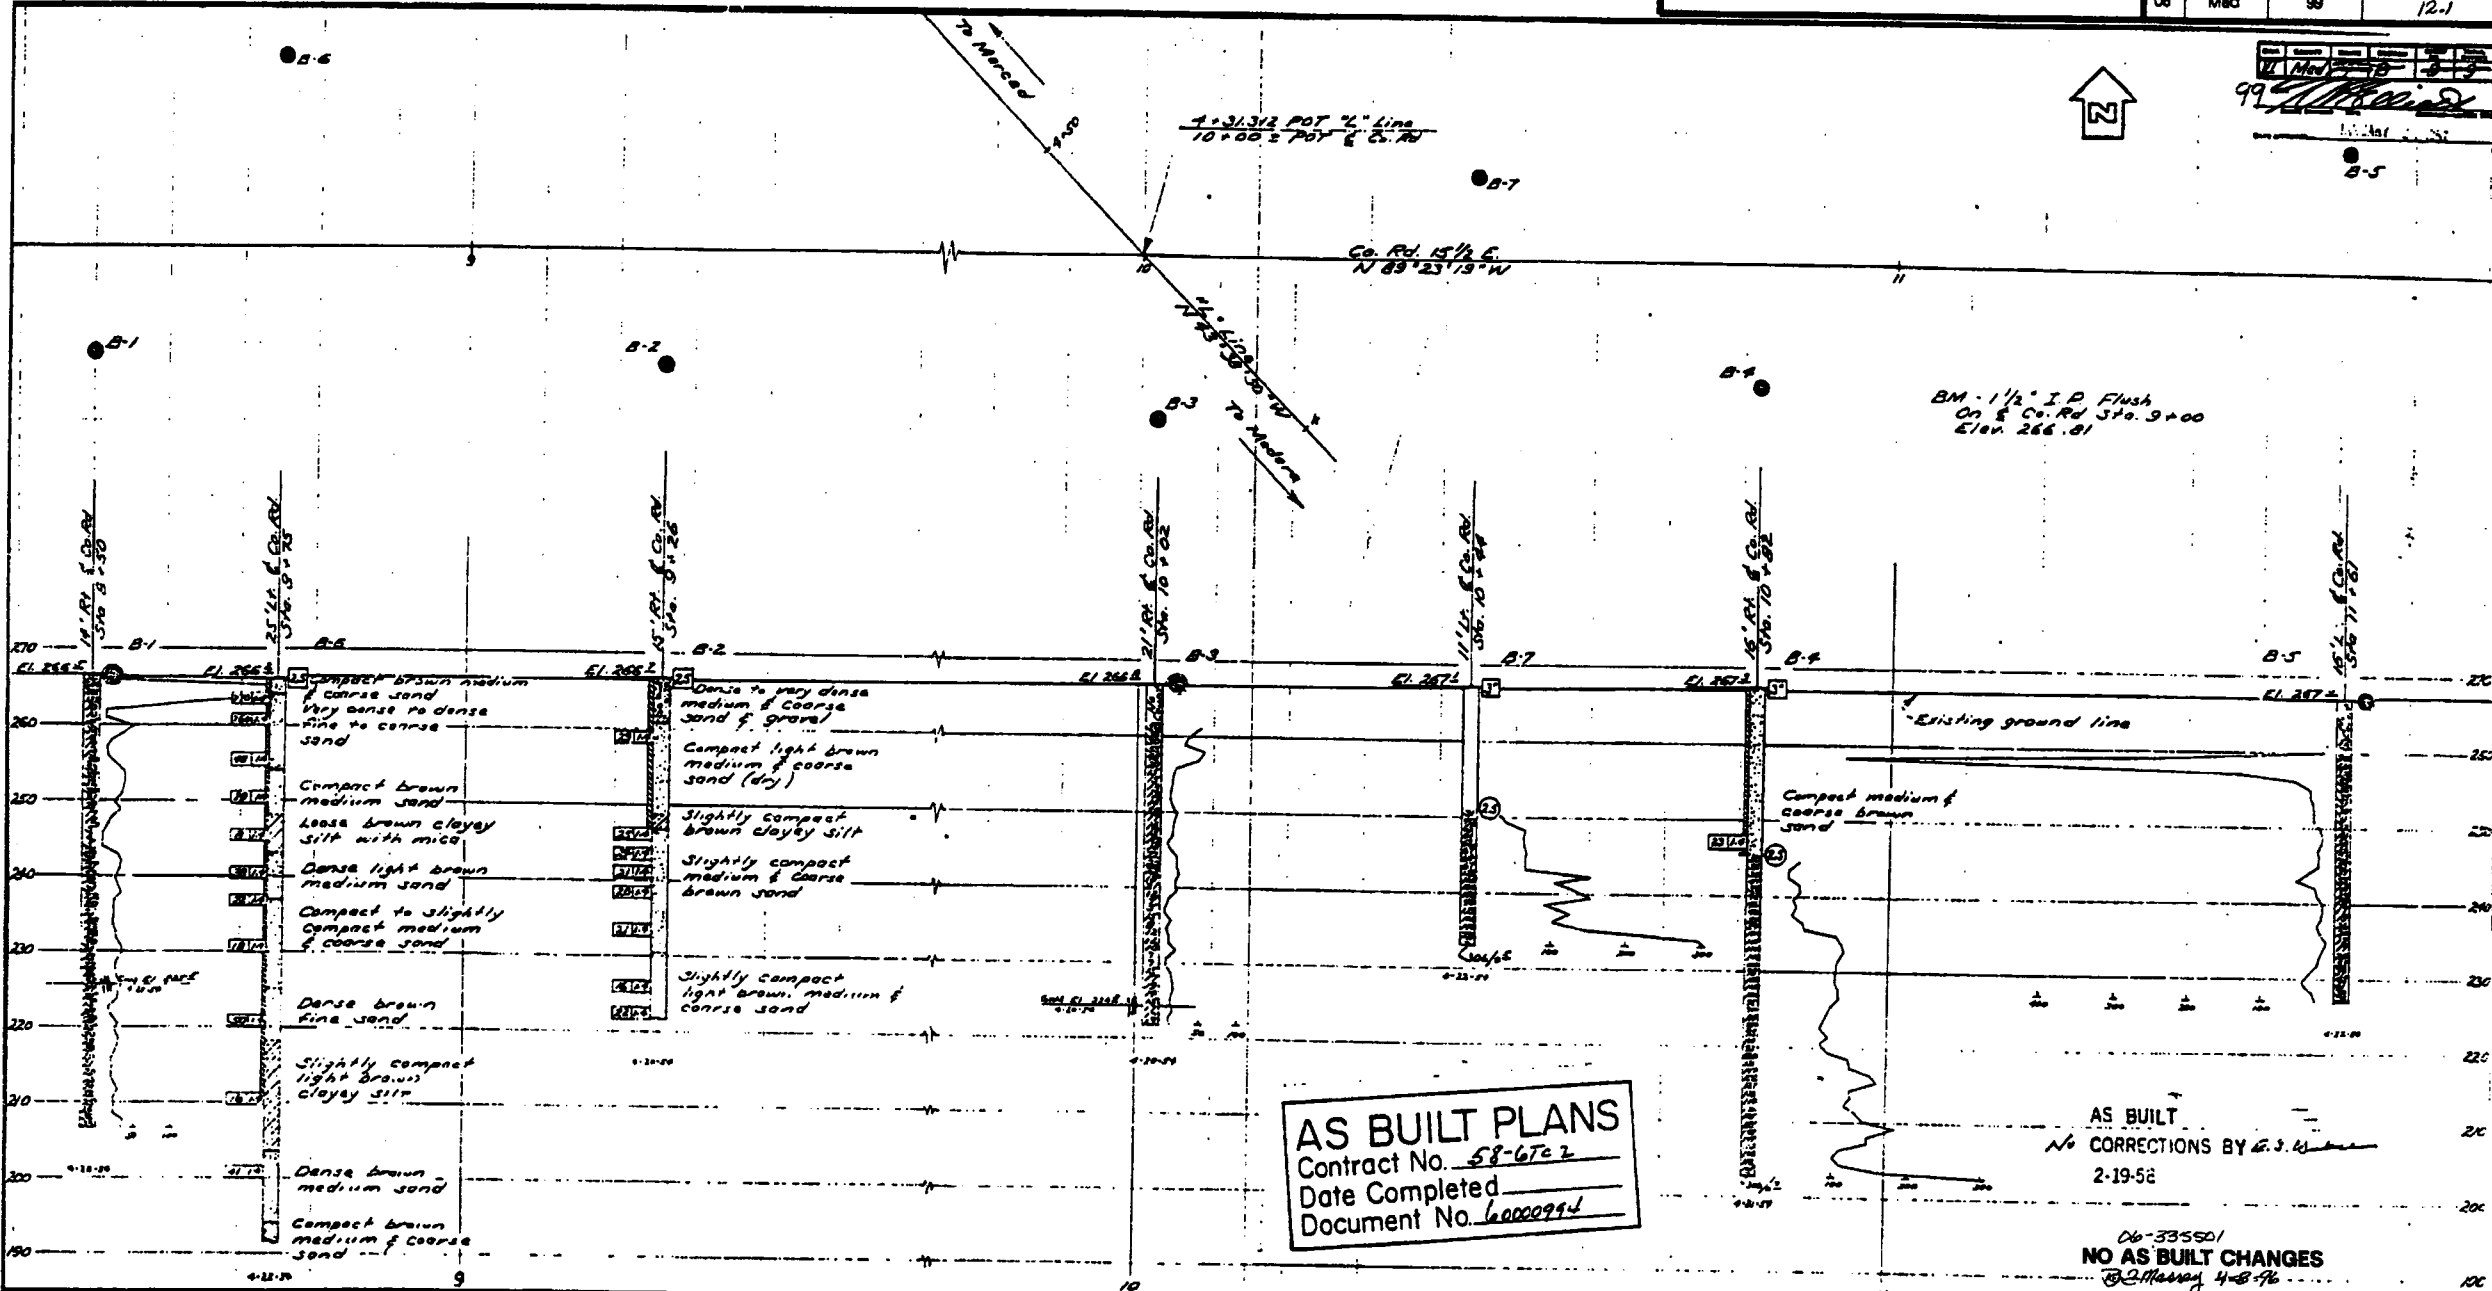

**CLASSIFICATION OF MATERIAL BASED ON STANDARD GRADE SIZING LIMITS**

DIAGRAM SHOWING THE BASIS FOR ESTIMATES OF GRADE SIZE DISTRIBUTION USED IN DETERMINATION OF CLASS NAMES. IF GRAVEL IS PRESENT IN APPRECIABLE AMOUNTS THE TERM "GRAVELLY" MAY BE ADDED TO THE CLASS NAME, VIZ. "GRAVELLY SAND." THE TERMS "COARSEST," "MEDIUM," AND "FINE" WHEN USED TO DESCRIBE SAND, SILT AND GRAVEL REFER TO STANDARD GRADE SIZE LIMITS.

**LEGEND OF EARTH MATERIALS**

GRAVEL	SILTY CLAY OR CLAYEY SILT
SAND	PEAT AND/OR ORGANIC MATTER
SILT	FILL MATERIAL
CLAY	IGNEOUS ROCK
SANDY CLAY OR CLAYEY SAND	SEDIMENTARY ROCK
SANDY SILT OR SILTY SAND	METAMORPHIC ROCK

**LEGEND OF BORING OPERATIONS**

PLAN OF ANY BORING  
PENETROMETER  
2 1/2" CONE PENETROMETER  
SAMPLER BORING (DRY)  
ROTARY BORING (WET)  
AUGER BORING (DRY)  
JET BORING  
CORE BORING  
TEST PIT

**NOTES**



The contractor's attention is directed to Section 2, Article (c) of the Standard Specifications and to the Special Provisions accompanying this set of plans. Classification of earth material as shown on this sheet is based upon field inspection and is not to be construed to imply mechanical analysis.

STATE OF CALIFORNIA  
DEPARTMENT OF PUBLIC WORKS  
DIVISION OF HIGHWAYS

ROAD 15 1/2 E OVERCROSSING

LOG OF TEST BORINGS

SCALE 1"=10' BRIDGE 41-53 FILE DRAWING C-3641-9

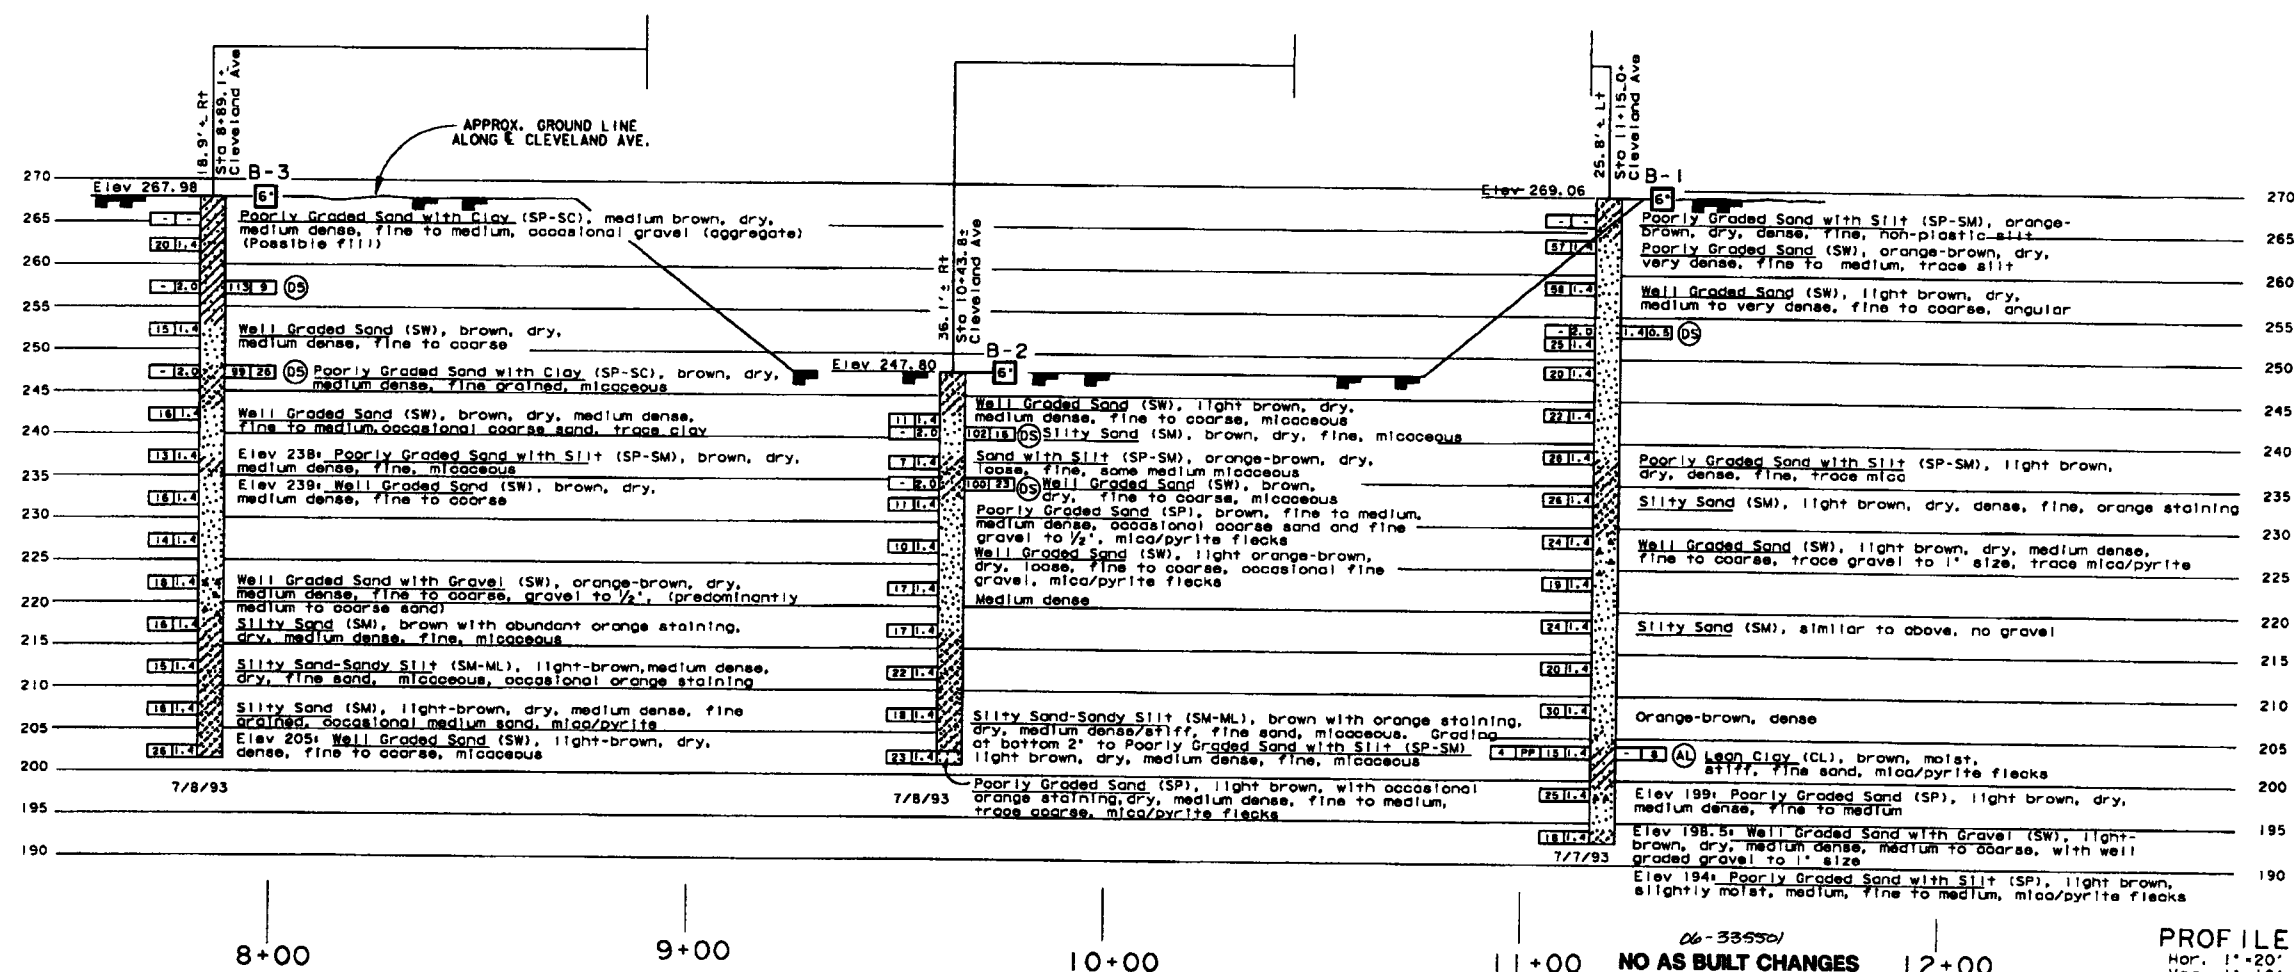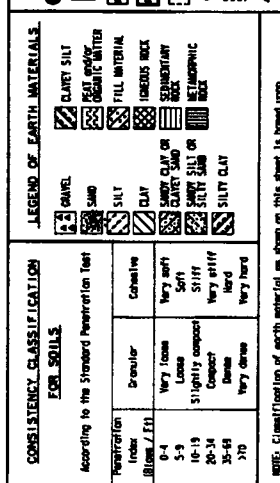

Notes:

1. The boring logs and related information represent the opinion of the geotechnical engineer as to the character of the material at the locations shown. Soil and groundwater conditions between adjacent test holes and at other locations may differ from those shown. Groundwater conditions may change with the passage of time.
2. Groundwater was not encountered in the exploration.
3. Refer to Foundation Plan for bench mark information.


Soil Test Designation  
AL-Atterberg Limits  
DS-Direct Shear Test  
GS-Sieve Analysis

ClibPDF - [www.fastio.com](http://www.fastio.com)




7	CAL.	212	210
---	------	-----	-----

99 *[Signature]*

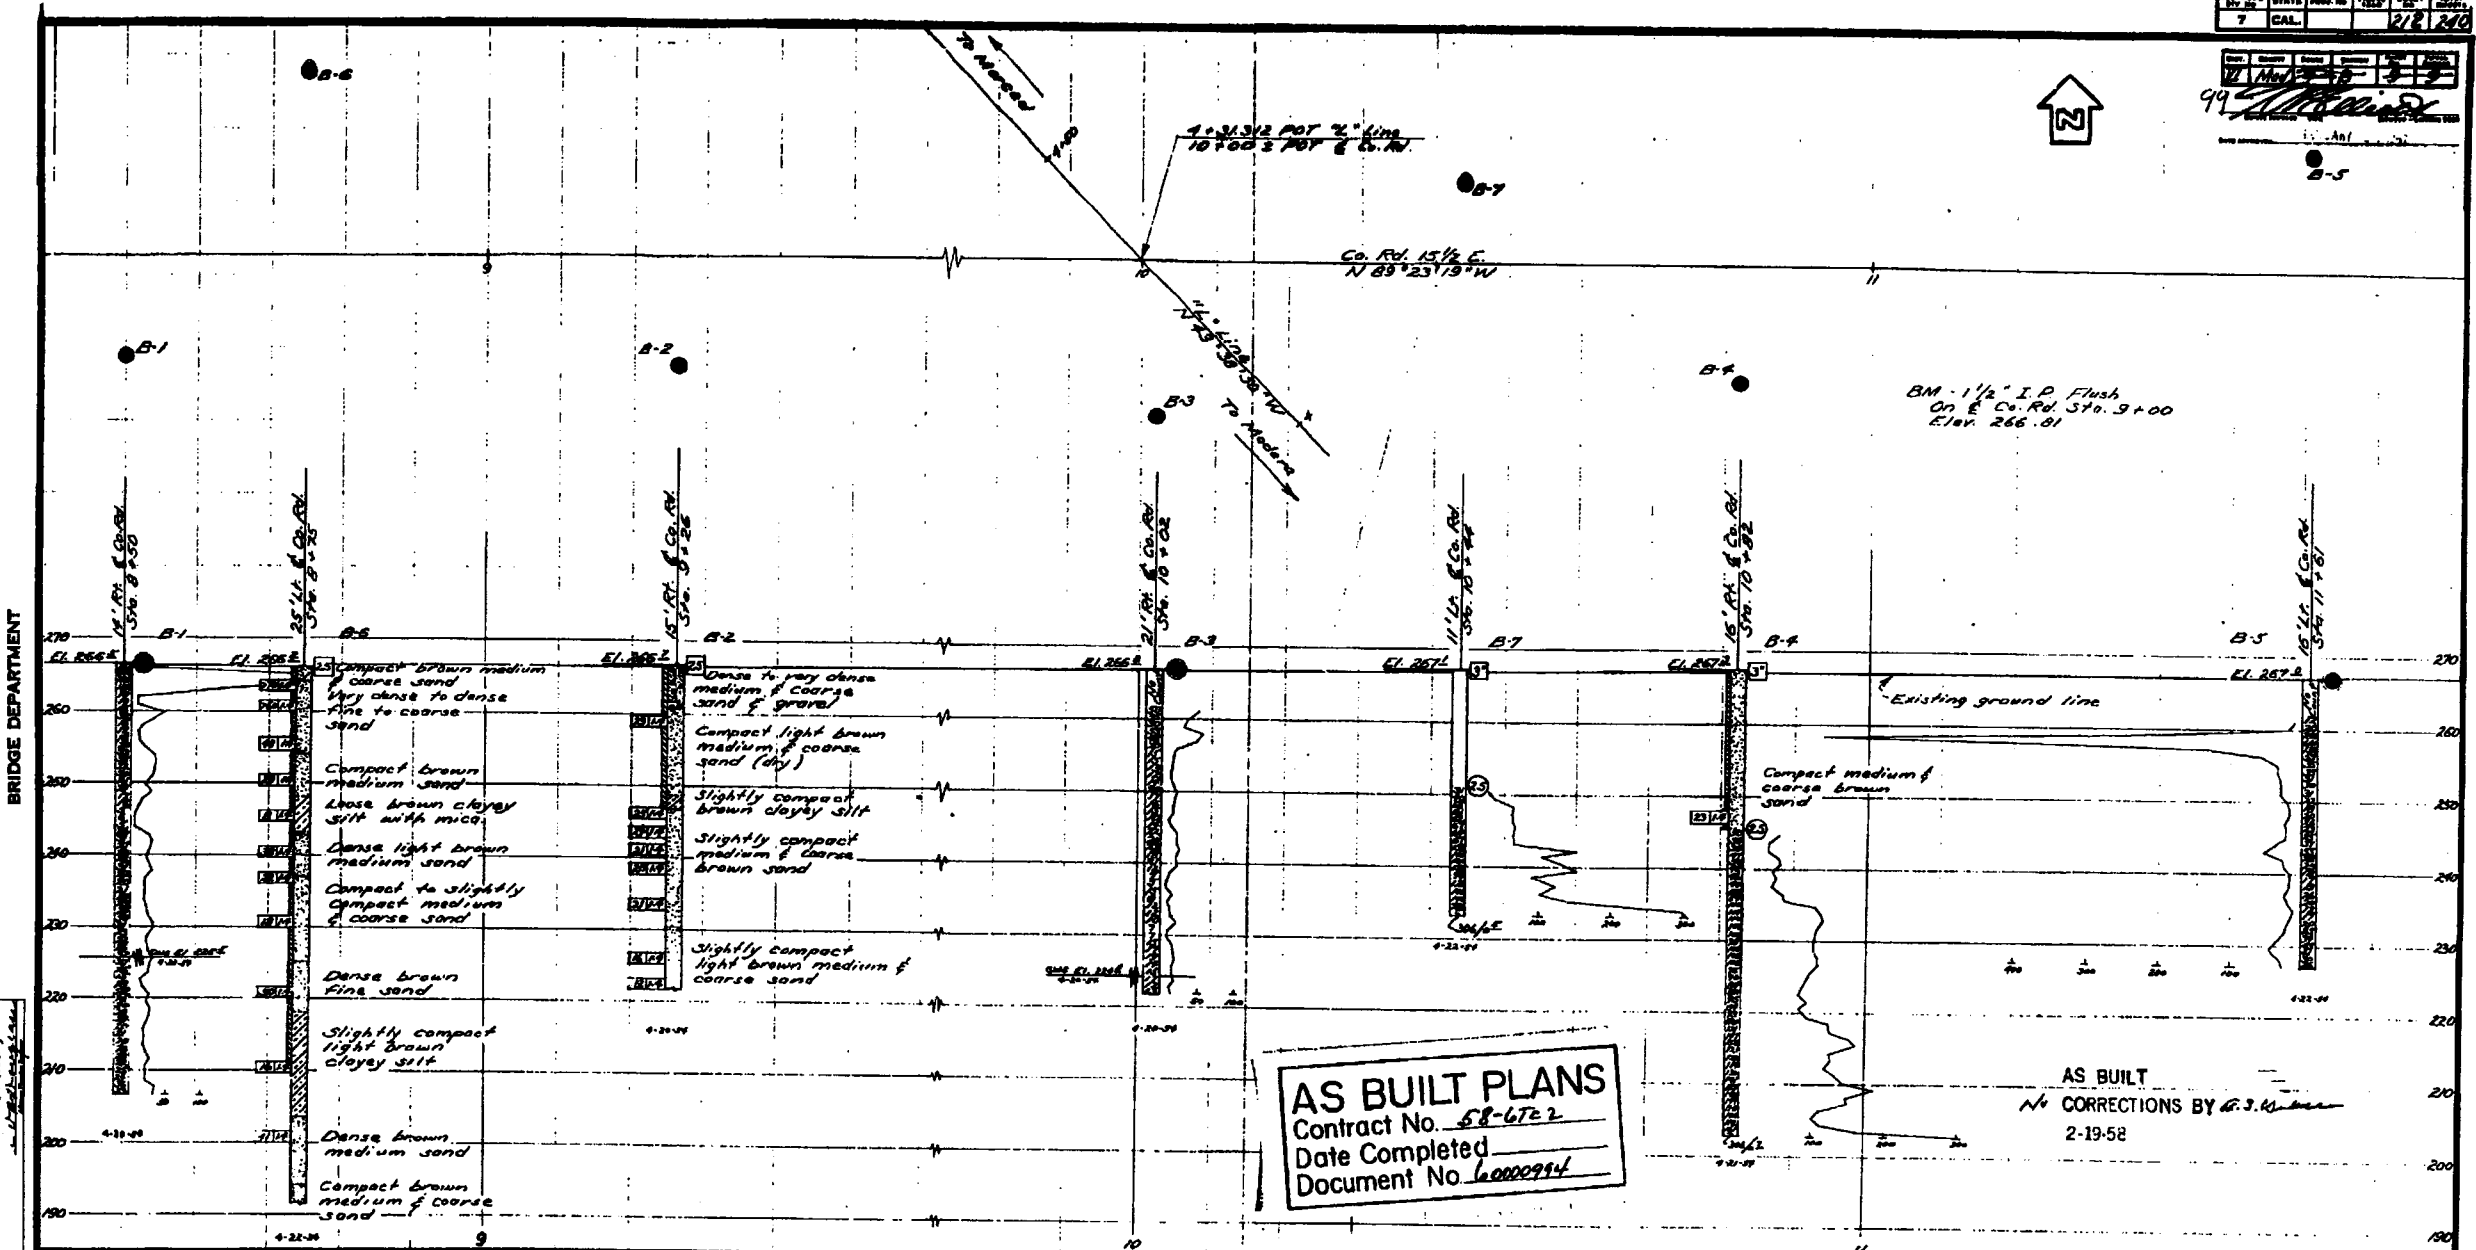


**AS BUILT PLANS**  
 Contract No. 58-6762  
 Date Completed \_\_\_\_\_  
 Document No. 6000994

AS BUILT  
 CORRECTIONS BY G. S. [Signature]  
 2-19-58

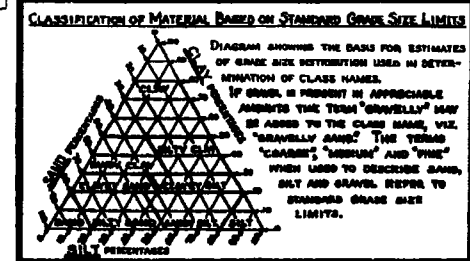

**LEGEND OF EARTH MATERIALS**

GRAVEL	SILTY CLAY OR CLAYEY SILT
SAND	PEAT OR ORGANIC MATTER
SILT	FILL MATERIAL
CLAY	IGNEOUS ROCK
SANDY CLAY OR CLAYEY SAND	SEDIMENTARY ROCK
SANDY SILT OR SILTY SAND	METAMORPHIC ROCK

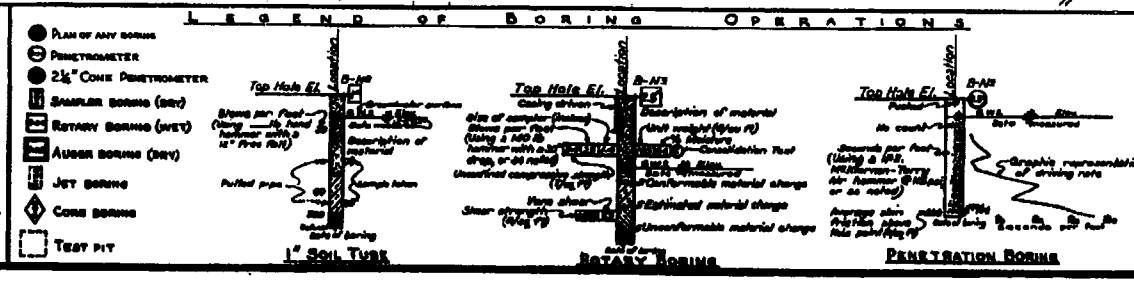

**NOTES**

The contractor's attention is directed to Section 2, Article (4) of the Standard Specifications and to the Special Provisions accompanying this set of plans. Classification of earth material as shown on this sheet is based upon field inspection and is not to be construed to imply mechanical analysis.

STATE OF CALIFORNIA  
 DEPARTMENT OF PUBLIC WORKS  
 DIVISION OF HIGHWAYS

**ROAD 15 1/2 E OVERCROSSING**

**LOG OF TEST BORINGS**


SCALE 1"=10' BORING 41-53 FILE DRAWING 5:3641-9

I HEREBY CERTIFY THAT THIS IS A TRUE AND ACCURATE COPY OF THE ABOVE DOCUMENT TAKEN UNDER MY DIRECTION AND CONTROL ON THIS DATE IN SACRAMENTO, CALIFORNIA PURSUANT TO AUTHORIZATION BY THE DIRECTOR OF PUBLIC WORKS.

DATE 7/15/71 SIGNATURE [Signature] TITLE HAC II

STATE	CAL.	PROJECT NO.	240	SHEET NO.	240
DATE	11/15/71	DESIGNED BY	E.S.H.	CHECKED BY	E.S.H.
DRAWN BY: <i>[Signature]</i> DATE: 11/15/71					

BM TOP 1 1/4" IRON PIPE  
 RD. RT. "R.A." STA. 15+00  
 Elev. 260.36

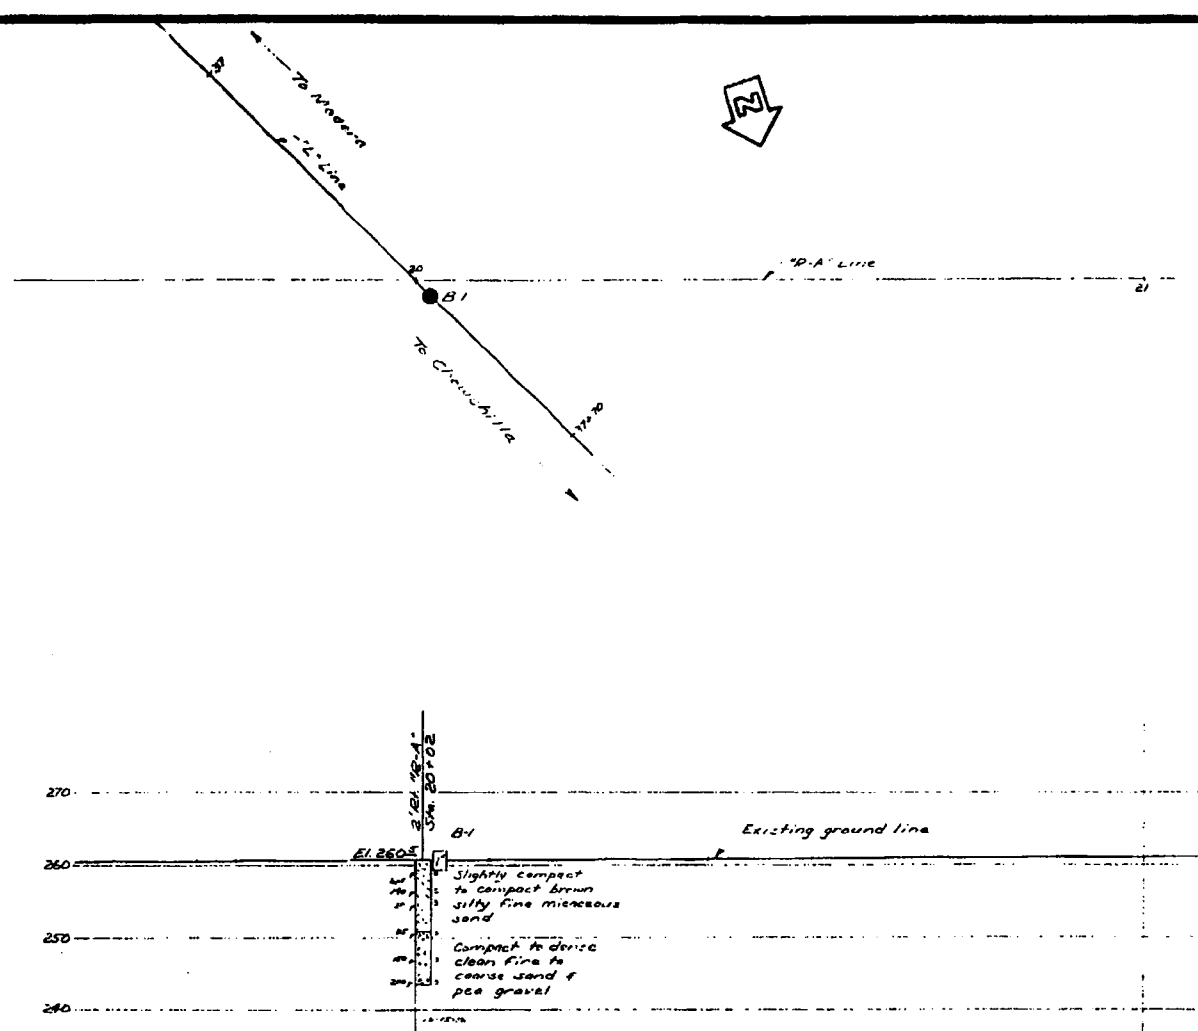

NO GROUND WATER ENCOUNTERED


**AS BUILT PLANS**  
 Contract No. 58-676.2  
 Date Completed \_\_\_\_\_  
 Document No. 6000994

AS BUILT  
 CORRECTIONS BY E.S.H.  
 2-19-58


<p><b>CLASSIFICATION OF MATERIAL BASED ON STANDARD GRADE SIZE LIMITS</b></p> <p>DIAGRAM SHOWING THE BASIS FOR ESTIMATES OF GRADE SIZE DISTRIBUTION USED IN DETERMINATION OF CLASS NAMES.</p> <p>IF GRAVEL IS PRESENT IN APPRECIABLE AMOUNTS THIS TERM "GRAVELLY" MAY BE ADDED TO THE CLASS NAME, VIZ. "GRAVELLY SAND". THE TERMS "COARSE", "MEDIUM" AND "FINE" WHEN USED TO DESCRIBE SAND, SILT AND GRAVEL REFER TO STANDARD GRADE SIZE LIMITS.</p>	<p><b>LEGEND OF EARTH MATERIALS</b></p> <table border="0"> <tr> <td>GRAVEL</td> <td>SILTY CLAY OR CLAYEY SILT</td> </tr> <tr> <td>SAND</td> <td>PEAT AND/OR ORGANIC MATTER</td> </tr> <tr> <td>SILT</td> <td>FILL MATERIAL</td> </tr> <tr> <td>CLAY</td> <td>IGNEOUS ROCK</td> </tr> <tr> <td>SANDY CLAY OR CLAYEY SAND</td> <td>SEDIMENTARY ROCK</td> </tr> <tr> <td>SANDY SILT OR SILTY SAND</td> <td>METAMORPHIC ROCK</td> </tr> </table>	GRAVEL	SILTY CLAY OR CLAYEY SILT	SAND	PEAT AND/OR ORGANIC MATTER	SILT	FILL MATERIAL	CLAY	IGNEOUS ROCK	SANDY CLAY OR CLAYEY SAND	SEDIMENTARY ROCK	SANDY SILT OR SILTY SAND	METAMORPHIC ROCK	<p><b>LEGEND OF BORING OPERATIONS</b></p> <table border="0"> <tr> <td>PLAN OF ANY BORING</td> <td>2 1/2" CONE PENETROMETER</td> </tr> <tr> <td>SAMPLER BORING (DRY)</td> <td>ROTARY BORING (WET)</td> </tr> <tr> <td>AUGER BORING (DRY)</td> <td>JET BORING</td> </tr> <tr> <td>CORE BORING</td> <td>TEST PIT</td> </tr> </table> <p><b>1" SOIL TUBE</b></p> <p><b>ROTARY BORING</b></p> <p><b>PENETRATION BORING</b></p>	PLAN OF ANY BORING	2 1/2" CONE PENETROMETER	SAMPLER BORING (DRY)	ROTARY BORING (WET)	AUGER BORING (DRY)	JET BORING	CORE BORING	TEST PIT	<p><b>NOTES</b></p> <p>The contractor's attention is directed to Section 2, Article (c) of the Standard Specifications and to the Special Provisions accompanying this set of plans.</p> <p>Classification of earth material as shown on this sheet is based upon field inspection and is not to be construed to imply mechanical analysis.</p> <p>STATE OF CALIFORNIA          DEPARTMENT OF PUBLIC WORKS          DIVISION OF HIGHWAYS</p> <p><b>AVENUE 16 OVERCROSSING</b></p> <p><b>LOG OF TEST BORINGS</b></p> <p>SCALE 1"=10' SHEET 41-5B FILE DRAWING C-5121-14</p>
GRAVEL	SILTY CLAY OR CLAYEY SILT																						
SAND	PEAT AND/OR ORGANIC MATTER																						
SILT	FILL MATERIAL																						
CLAY	IGNEOUS ROCK																						
SANDY CLAY OR CLAYEY SAND	SEDIMENTARY ROCK																						
SANDY SILT OR SILTY SAND	METAMORPHIC ROCK																						
PLAN OF ANY BORING	2 1/2" CONE PENETROMETER																						
SAMPLER BORING (DRY)	ROTARY BORING (WET)																						
AUGER BORING (DRY)	JET BORING																						
CORE BORING	TEST PIT																						

I HEREBY CERTIFY THAT THIS IS A TRUE AND ACCURATE COPY OF THE ABOVE DOCUMENT TAKEN UNDER MY DIRECTION AND CONTROL ON THIS DATE IN SACRAMENTO, CALIFORNIA PURSUANT TO AUTHORIZATION BY THE DIRECTOR OF PUBLIC WORKS.

DATE 11/15/71 SIGNATURE *[Signature]* TITLE *HACU*


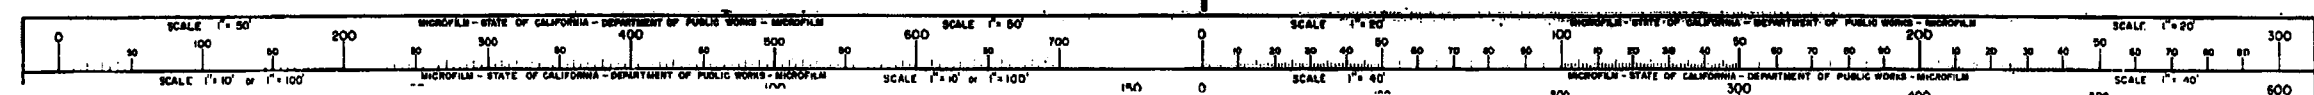




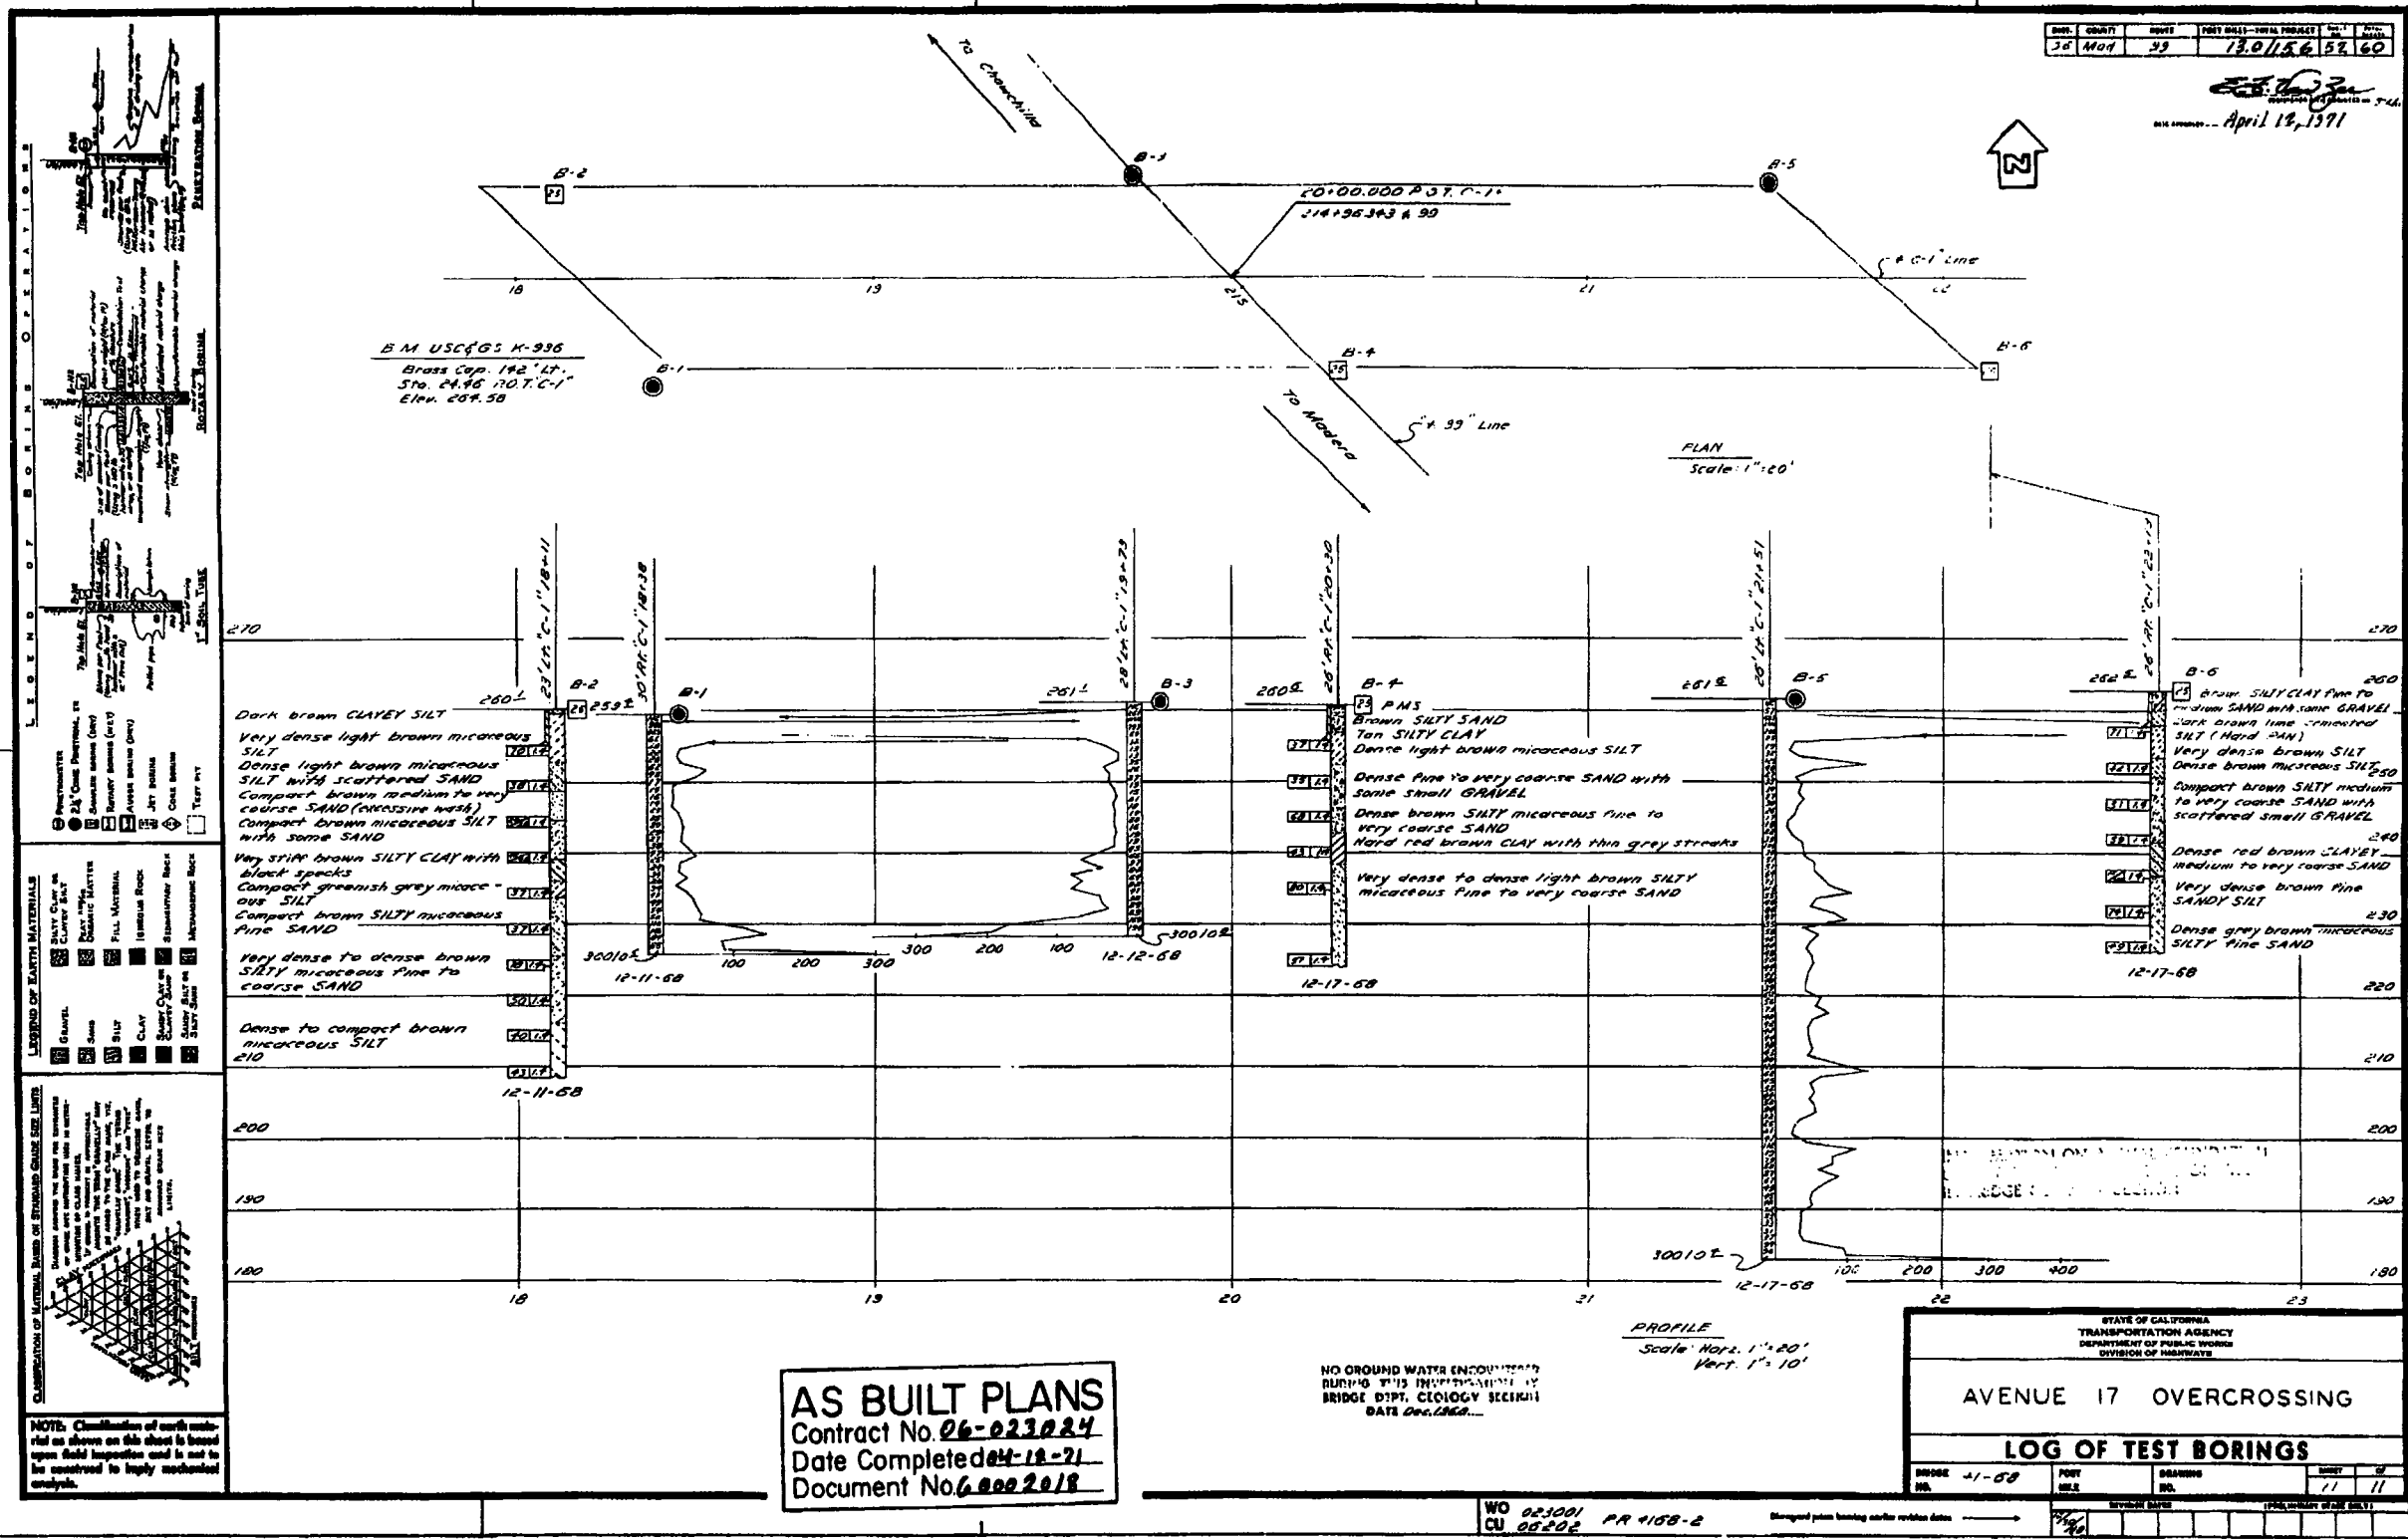



DIST.	COUNTY	ROUTE	POST MILES-TOTAL PROJECT	POST MILES	DATE
06	Mad	99	15.6/17.8	50	70

September 11, 1973

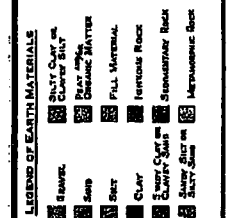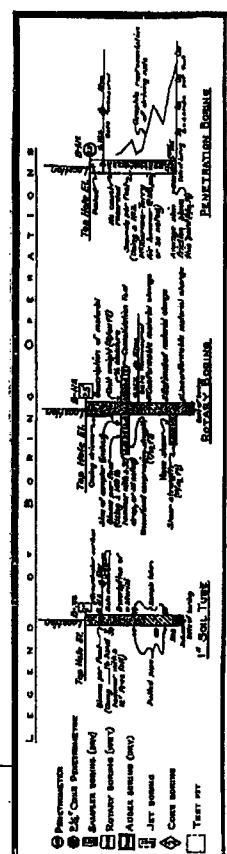

NOTE: Classification of earth material as shown on this sheet is based upon field inspection and is not to be construed to imply mechanical analysis.

LIST 1-05 8M \* 7-85 (1970)  
SYD. 6-455 cap N corner  
Dry Creek, N.B. 10/10/55  
Elev. 251.40

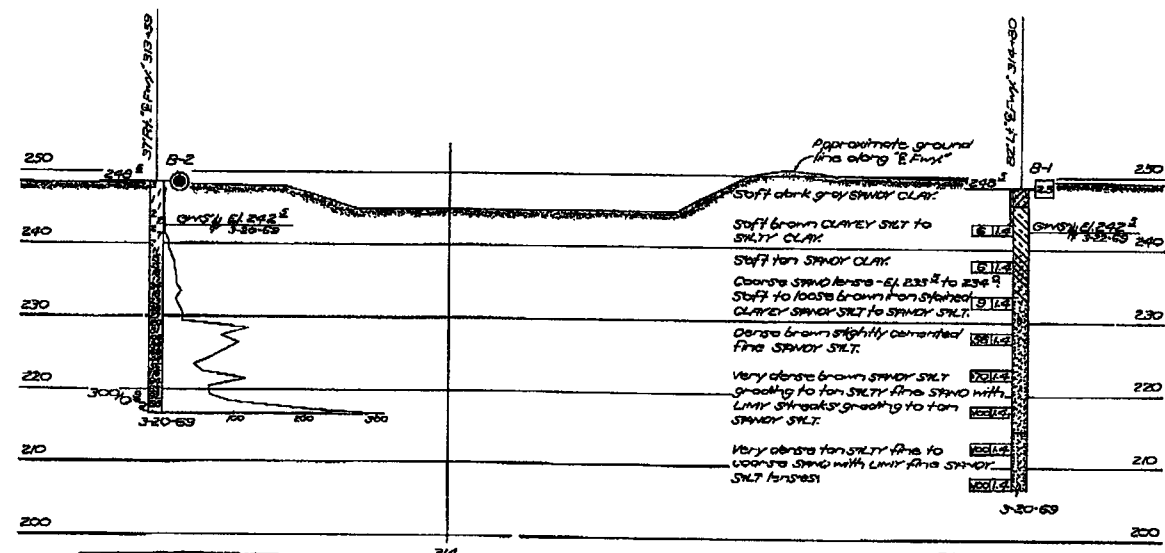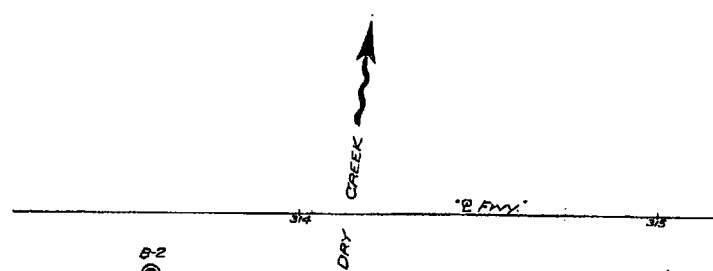

AS BUILT No Changes  
CORRECTIONS BY P. Arle  
CONTRACT NO. 06-023034  
DATE 03/19/75  
JRM/08-29-75

STATE OF CALIFORNIA DEPARTMENT OF TRANSPORTATION			
DRY CREEK BRIDGE			
LOG OF TEST BORINGS			
BRIDGE NO.	POST MILE	DRAWING NO.	SHEET OF
41-05 3/4			6 6
REVISION DATA			
(PRELIMINARY REVISION ONLY)			

AS BUILT PLANS  
Contract No. 06-023034  
Date Completed 5-5-75  
Document No. 6006595

I HEREBY CERTIFY THAT THIS IS A TRUE AND ACCURATE COPY OF THE ABOVE DOCUMENT TAKEN UNDER MY DIRECTION AND CONTROL ON THIS DATE IN SACRAMENTO, CALIFORNIA PURSUANT TO AUTHORIZATION BY THE DIRECTOR OF TRANSPORTATION.

9-8-75 [Signature] [Signature]




**LEGEND OF EARTH MATERIALS**

☐ Gravel  
☐ Sand  
☐ Silt  
☐ Clay  
☐ Organic  
☐ Shell  
☐ Hardpan  
☐ Bedrock  
☐ Water  
☐ Air  
☐ Ice  
☐ Other

**NOTES:** Classification of earth materials as shown on this sheet is based upon field inspection and is not to be construed to imply mechanical analysis.

H.M. #245  
 R.R. SPIKE IN TP  
 143' LT. "C-2" 29+50  
 ELEV. 252.65'

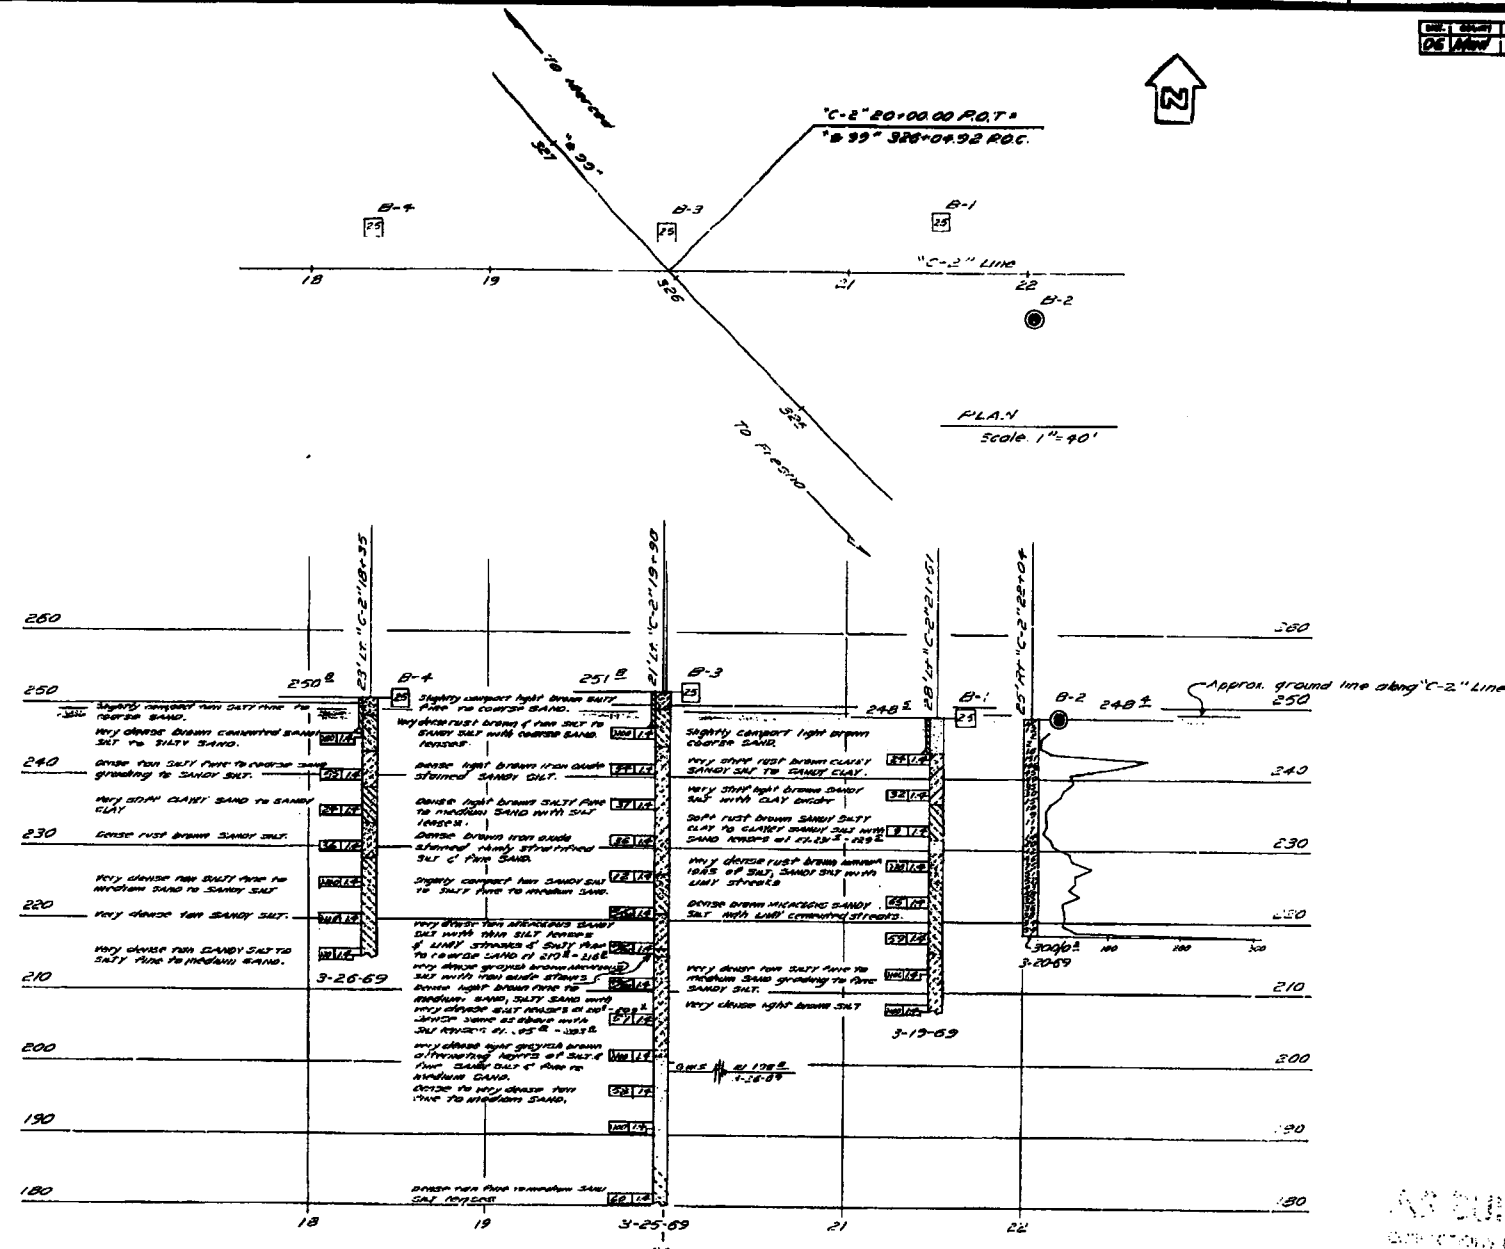

DATE	BY	REVISED	BY	DATE
06/10/75	99	10/6/77	70	70

AS BUILT No Changes  
 CONTRACT NO. 06-023034  
 DATE: 05-2-75  
 JRMV 05-29-75

STATE OF CALIFORNIA  
 DEPARTMENT OF TRANSPORTATION

AVENUE 18 1/2 OVERCROSSING

**LOG OF TEST BORINGS**


BORING NO.	DATE	FILE	DRAWING NO.	REMARKS
41-69	10-3			

**AS BUILT PLANS**  
 Contract No. 06-023034  
 Date Completed 5-5-75  
 Document No. 000659

MICROFILMED  
 SEP 8 1975

I HEREBY CERTIFY THAT THIS IS A TRUE AND ACCURATE COPY OF THE ABOVE DOCUMENT TAKEN UNDER MY DIRECTION AND CONTROL ON THIS DATE IN SACRAMENTO, CALIFORNIA PURSUANT TO AUTHORIZATION BY THE DIRECTOR OF TRANSPORTATION.

08-75 [Signature]

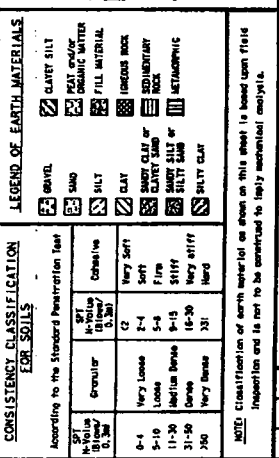

~~THIS IS A COPY~~



APPROVED: *[Signature]*  
DATE: April 3, 1976

BM #7.84 Top 1" I.P. On 0.5'  
25' R. 78 + 42.31 P.O.T. "FR-4"  
Elev. 246.43

STRUCTURAL FOUNDATIONS BRANCH - ENGINEERING SERVICE CENTER

As-Built Log of Test Borings sheet is considered an informational document only. As such, the State of California registration seal with signature, license number and registration certificate expiration date will not be required. This drawing is available and presented only for the convenience of any bidder, contractor or other interested party.

DIST.	COUNTY	ROUTE	POST MILES - TOTAL PROJECT	Sheet No.	Total Sheets
06	Mad	99	28.2/R29.3	43	43

**BERENDA CREEK BRIDGE (WIDEN)**

**LOG OF TEST BORINGS 2 OF 2**


The State of California or its officers or agents shall not be responsible for the accuracy or completeness of electronic copies of this plan sheet.

CU: 06222	BRIDGE No.
EA: 336001	41-0004

To accompany plans dated 4-13-98

**REDUCED PLAN**  
USE SCALE BELOW

0 1 2 3  
3 INCHES ON ORIGINAL PLAN

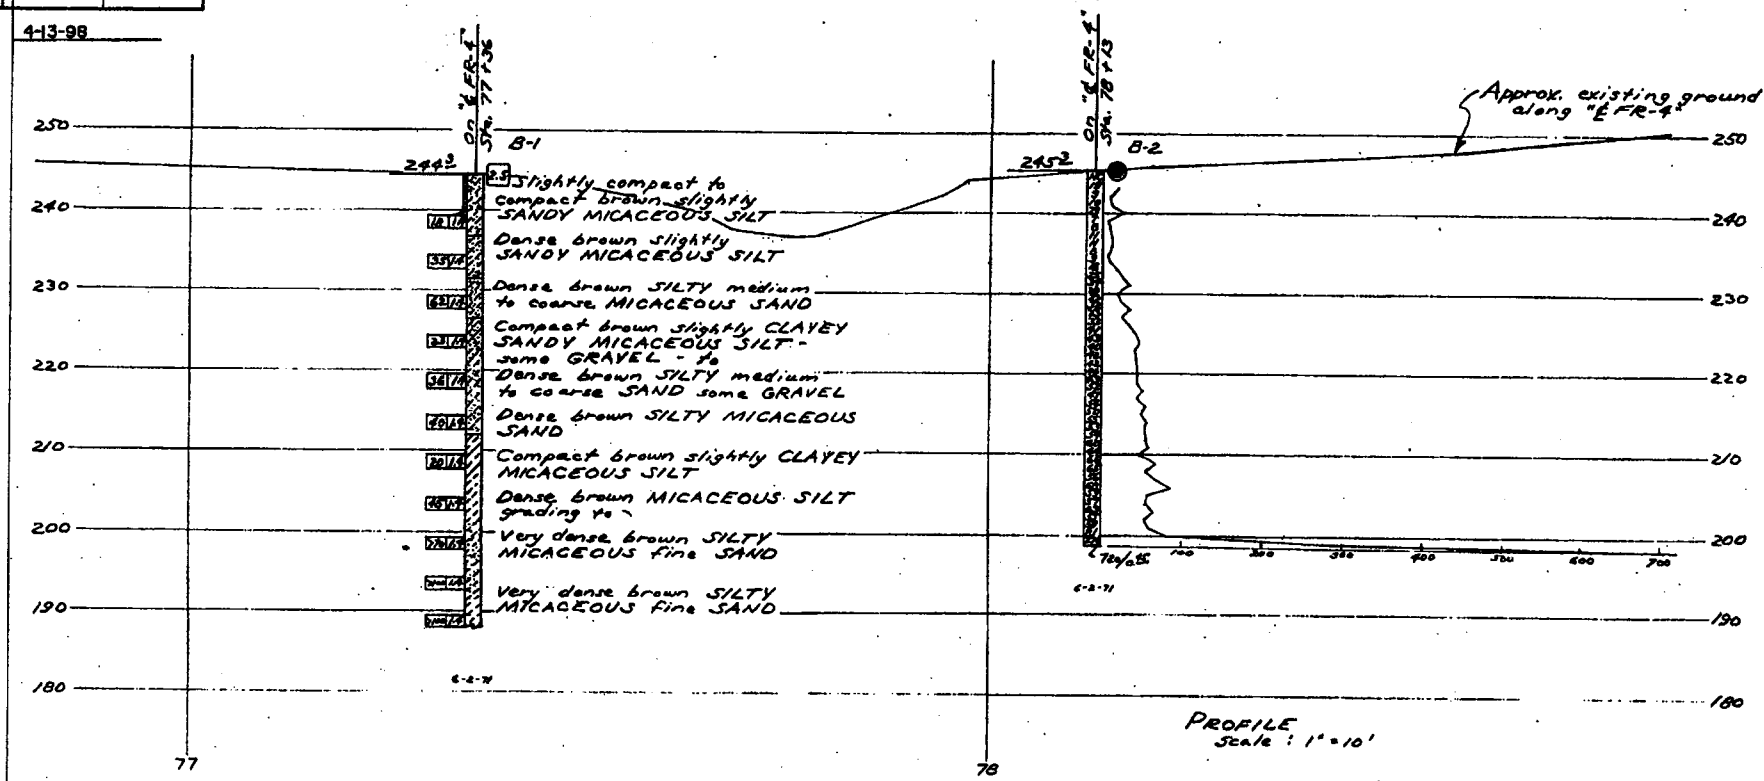

NO GROUND WATER ENCOUNTERED  
DURING THIS INVESTIGATION BY  
BRIDGE DEPT. GEOLOGY SECTION  
DATE 6-77

STATE OF CALIFORNIA  
DEPARTMENT OF TRANSPORTATION

BERENDA CREEK BRIDGE

**LOG OF TEST BORINGS**


BRIDGE NO.	41-04 K	FOOT MILES	17.9	DRAWING NO.	1	SHEET	OF
WO 0230 41	CU 06100						

BRIDGE DEPARTMENT

FILE NO.	STATE	PROJECT NO.	SHEET NO.	TOTAL SHEETS
7	CAL.		100	177

DATE	BY	CHKD.	APP'D.	DATE
VI Mac	C			10-10-57


January 15, 1960

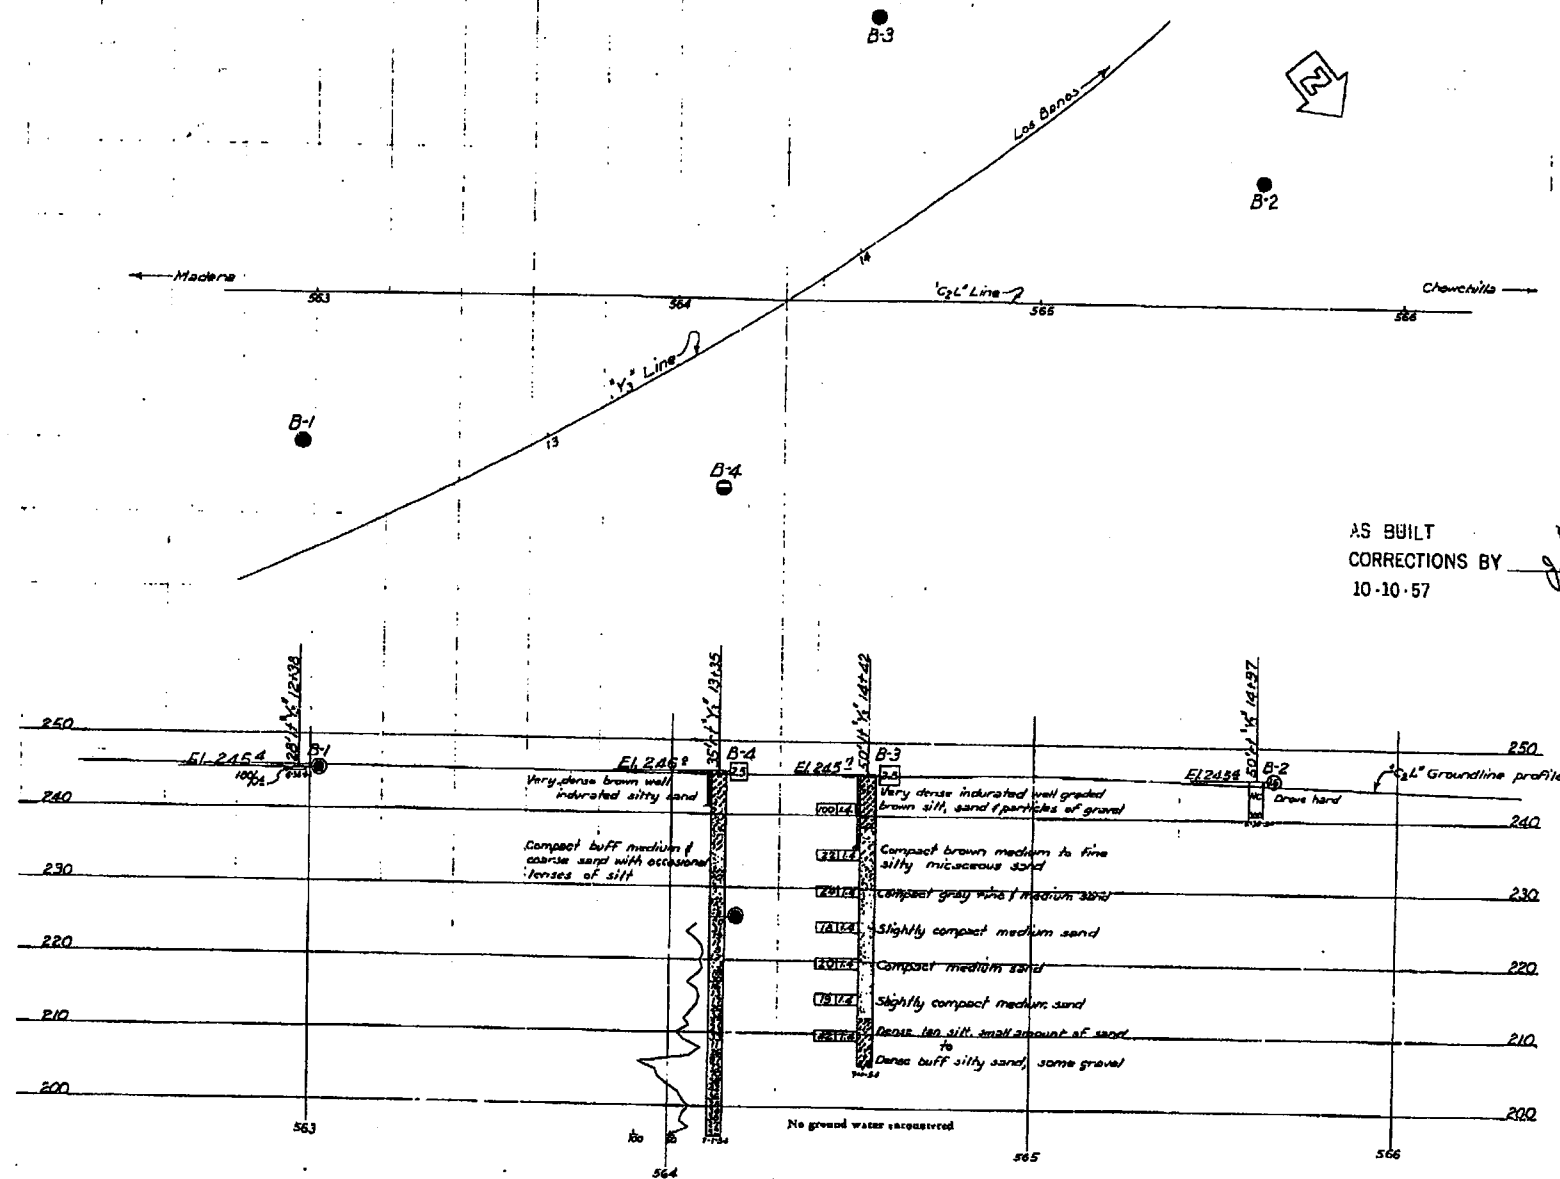

B.M.  
1/2" iron pipe with caps & lock  
50' x 1 1/2" S.W. 15+00  
Elev. 245.46

AS BUILT PLANS  
Contract No. 57-6763  
Date Completed  
Document No. 60000293


CLASSIFICATION OF MATERIAL BASED ON STANDARD GRADE SIZE LIMITS

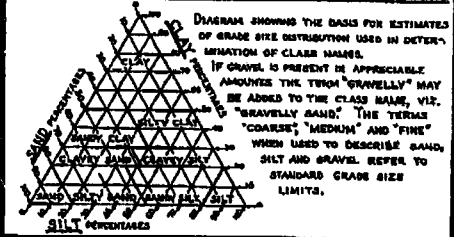

LEGEND OF EARTH MATERIALS

GRAVEL	SILTY CLAY OR CLAYEY SILT
SAND	PEAT OR ORGANIC MATTER
SILT	FILL MATERIAL
CLAY	IGNEOUS ROCK
SANDY CLAY OR CLAYEY SAND	SEDIMENTARY ROCK
SANDY SILT OR SILTY SAND	METAMORPHIC ROCK

LEGEND OF BORING OPERATIONS

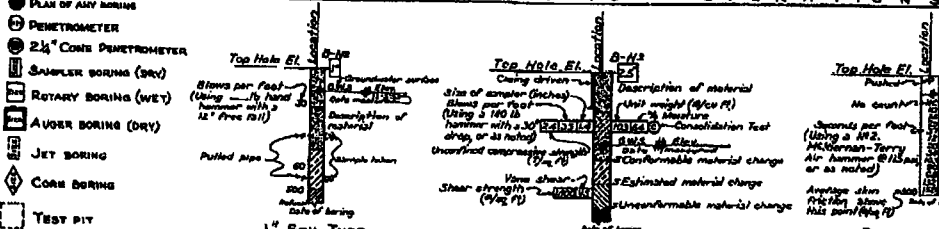

NOTES

The contractor's attention is directed to Section 2, Article (4) of the Standard Specifications and to the Special Provisions accompanying this set of plans. Classification of earth material as shown on this sheet is based upon field inspection and is not to be construed to imply mechanical analysis.

STATE OF CALIFORNIA  
DEPARTMENT OF PUBLIC WORKS  
DIVISION OF HIGHWAYS

ROUTE 32/4 SEPARATION

LOG OF TEST BORINGS

SCALE: Horizontal 1"=20' Vertical 1"=10'

BRIDGE 41-43 FILE DRAWING C-2186-10

PREL. DRAWING NO. P. 2186 27

I HEREBY CERTIFY THAT THIS IS A TRUE AND ACCURATE COPY OF THE ABOVE DOCUMENT TAKEN UNDER MY DIRECTION AND CONTROL ON THIS DATE IN SACRAMENTO, CALIFORNIA PURSUANT TO AUTHORIZATION BY THE DIRECTOR OF PUBLIC WORKS.  
DATE Jan 11, 1971 SIGNATURE [Signature] TITLE Highway Administration Officer



STRUCTURAL FOUNDATIONS BRANCH - ENGINEERING SERVICE CENTER

As-Built Log of Test Borings sheet is considered an informational document only. As such, the State of California registration seal with signature, license number and registration expiration date confirm that this is a true and accurate copy of the original document. It does not attest to the accuracy or validity of the information contained in the original document. This drawing is available and presented only for the convenience of any bidder, contractor or other interested party.


DIST.	COUNTY	ROUTE	KILOMETER POST - TOTAL PROJECT	Sheet No.	Total Sheets
05	Mad	152	251		

Michael T. Rogers 4/29/89  
CERTIFIED ENGINEERING GEOLOGIST

ROUTE 152/99 SEPARATION (WIDEN)  
LOG OF TEST BORINGS 2 of 2

NOTE: A COPY OF THIS LOG OF TEST BORINGS IS AVAILABLE AT OFFICE OF STRUCTURE MAINTENANCE AND INVESTIGATIONS, SACRAMENTO, CALIFORNIA

CU: 08220	BRIDGE No.
EA: 338821	41-0043 G

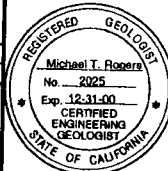


Revisions made to this Log of Test Borings from the original 1956 Log of Test Borings are:

1. New "Const." Line was added. See "General Plan" for curve data and "Foundation Plan" sheets.

2. Metric stations and offsets are as follows:


BORING	STATION	OFFSET FROM "CONST." LINE
B-1	3+78 ±	±10.0 m LL
B-2	4+57 ±	±15.0 m Rt.
B-3	4+41 ±	±16.0 m Lt.
B-4	4+07 ±	± 9.0 m Rt.

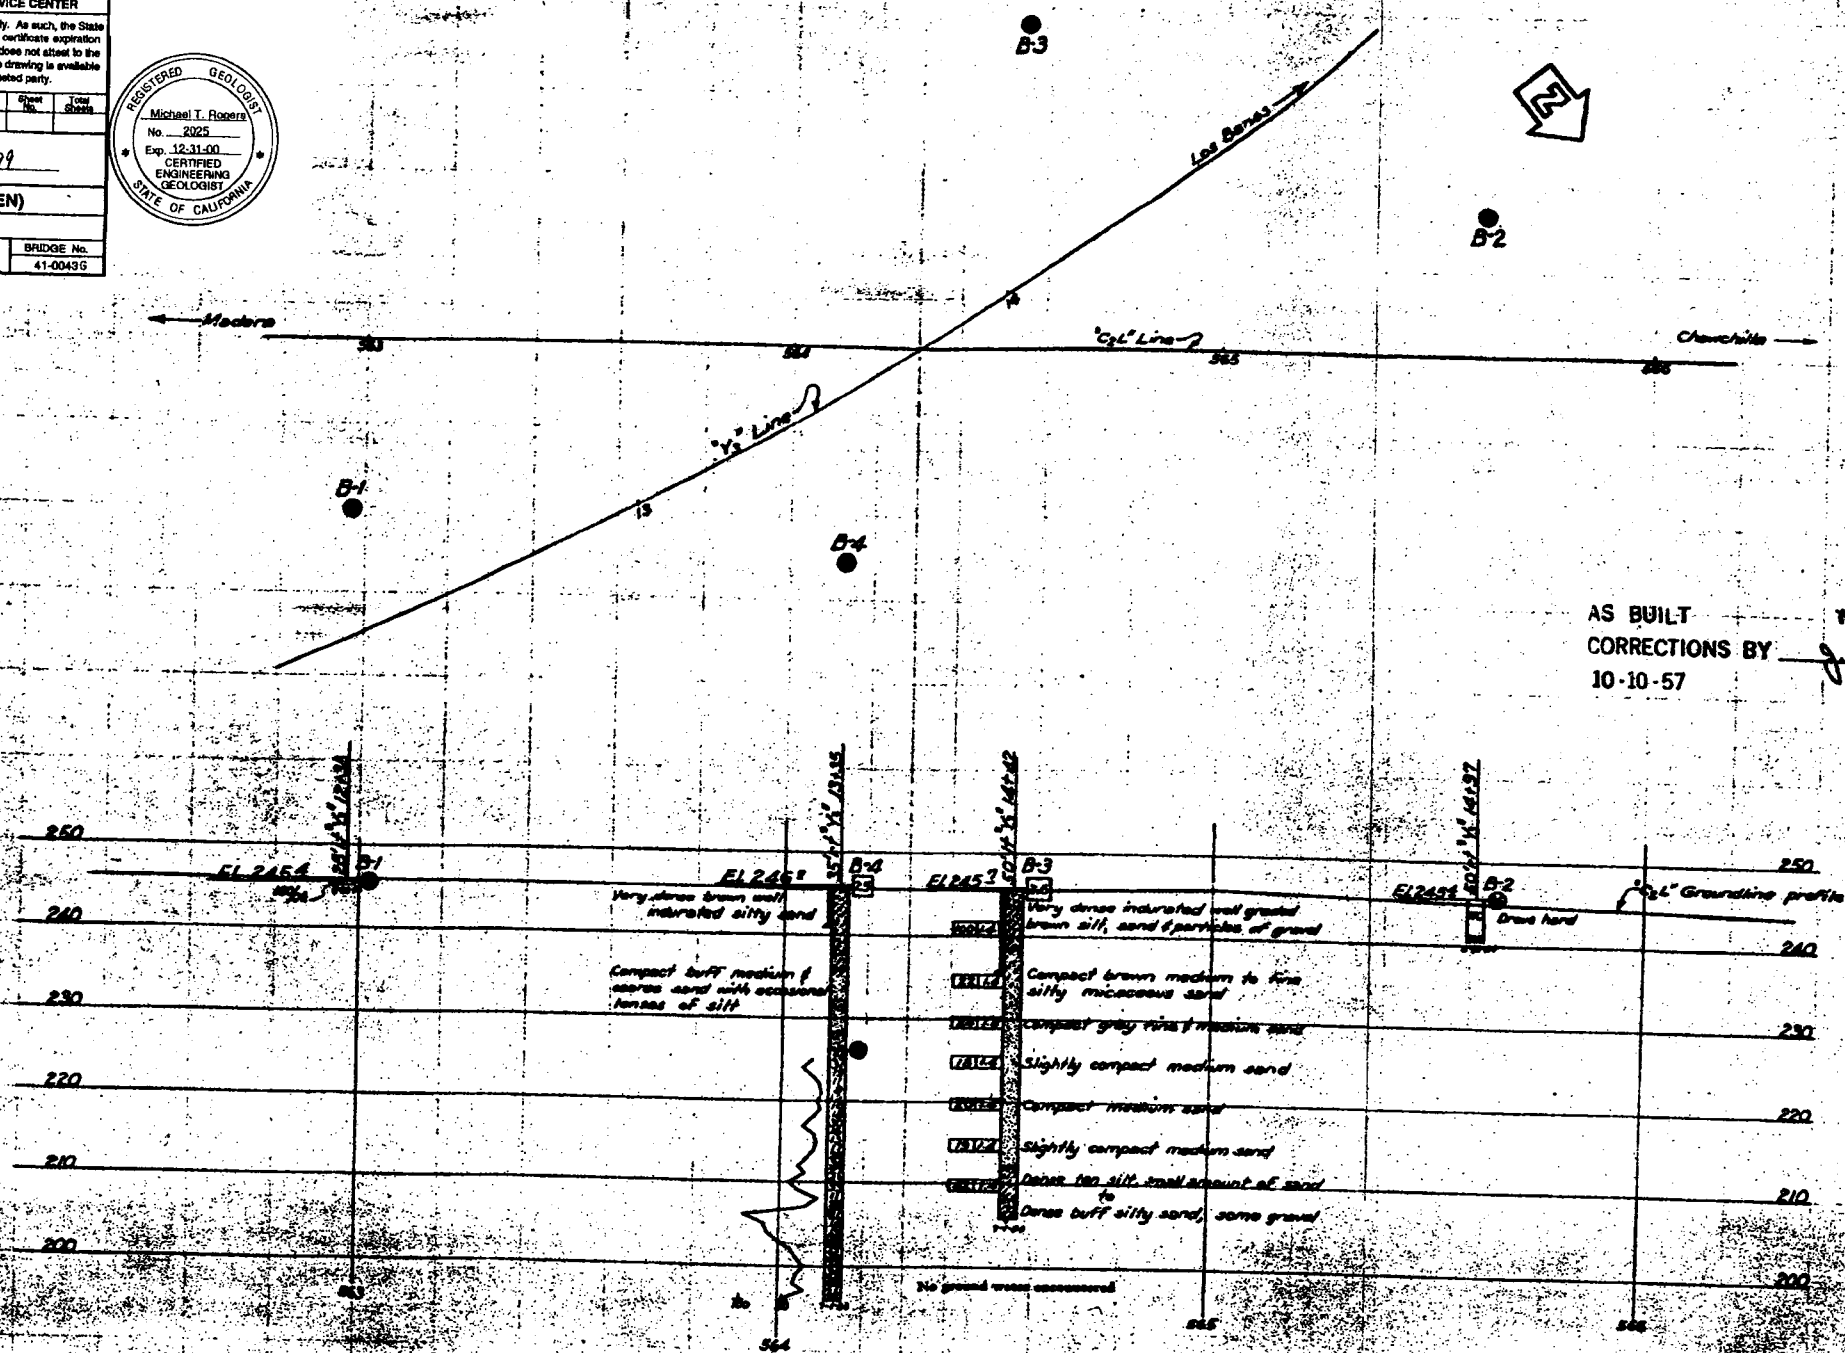

AS BUILT  
CORRECTIONS BY *J. D. T. [Signature]*  
10-10-57

AS BUILT PLANS  
Contract No. 57-67c3  
Date Completed  
Document No. 60000993

CLASSIFICATION OF MATERIAL BASED ON STANDARD GRADE SIZE LIMITS

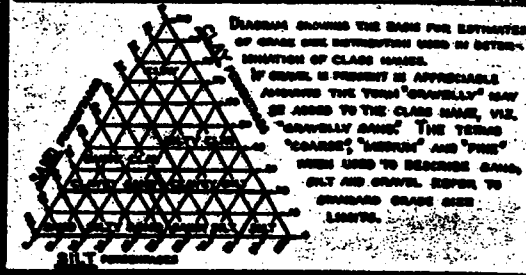


LEGEND OF EARTH MATERIALS

GRAVEL	SILTY CLAY OR CLAYEY SILT
SAND	PEAT OR/OR ORGANIC MATTER
SILT	FILL MATERIAL
CLAY	IGNEOUS ROCK
SANDY CLAY OR CLAYEY SAND	SEDIMENTARY ROCK
SANDY SILT OR SILTY SAND	METAMORPHIC ROCK

LEGEND OF BORING OPERATIONS

- PLAN OF ANY BORING
- PENETROMETER
- 2 1/2" CONE PENETROMETER
- SAMPLER BORING (WET)
- ROTARY BORING (WET)
- AUGER BORING (WET)
- JET BORING
- CORE BORING
- TEST PIT

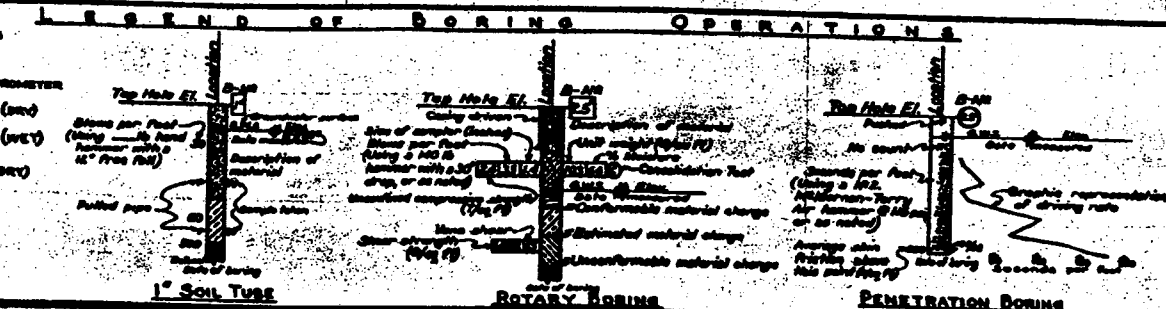

NOTES

The contractor's attention is directed to Section 2, Article 4 of the Standard Specifications and to the Special Provisions accompanying this set of plans. Classification of earth material as shown on this sheet is based upon field inspection and is not to be construed as implying mechanical analysis.

ROUTE 32 1/4 SEPARATION

LOG OF TEST BORINGS

SCALE: 1"=20'	SHEET 41-43	FILE	SECTION 52106-10
---------------	-------------	------	------------------

**LEGEND OF BORING OPERATIONS**

SYMBOLS FOR BORING TYPES:   
- PENETRATION BORING (P.B.)   
- ELECTRONIC CONE PENETROMETER TEST (E.C.P.T.)   
- ROTARY SAMPLE BORING (R.S.B.)   
- JET BORING (J.B.)   
- DIAMOND CORE BORING (D.C.B.)   
- TEST PIT (T.P.)   
- BORING LOG (B.L.)

**LEGEND OF EARTH MATERIALS**


SYMBOLS FOR EARTH MATERIALS:   
- CLAYEY SILT   
- SILT   
- SAND   
- GRAVEL   
- COBBLES   
- Boulders   
- Organic Material   
- FILL MATERIAL   
- Cobble and/or Boulders   
- Volcanic Rock   
- Sedimentary Rock   
- Metamorphic Rock

**CONSISTENCY CLASSIFICATION FOR SOILS**

According to the Standard Penetration Test (SPT) N-value (blows per foot) and Liquid Limit (LL) and Plasticity Index (PI).

SPT N-value (blows/ft)	Consistency
0-4	Very Loose
5-10	Loose
11-20	Medium Dense
21-30	Dense
31-50	Very Dense
>50	Hard

NOTE: Classification of earth material as shown on this sheet is based upon field investigation and is not to be construed to imply mechanical analysis.

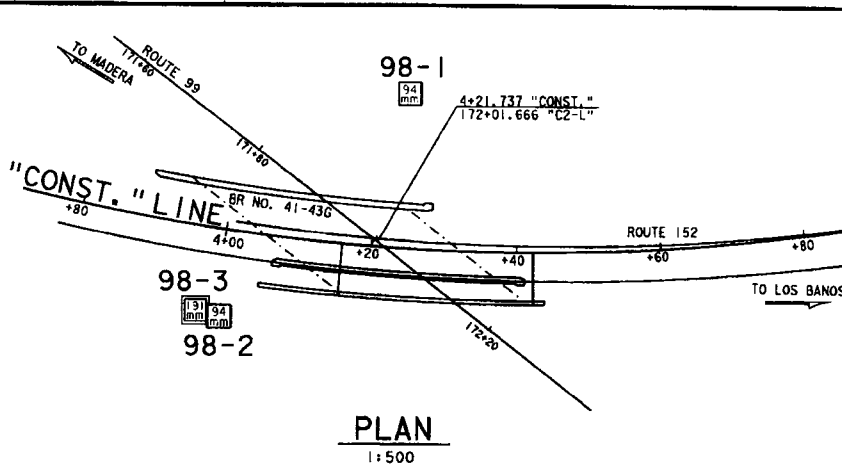


76 m	No logged from elev. 76.50 m to 56.71 m. See log for 98-2.
73 m	
70 m	
67 m	
64 m	
61 m	
58 m	Lean CLAY, CL, moist, olive-gray, moderately plastic, SILTY.
55 m	SILT, ML, stiff, olive, moist, low plastic, some fine SAND.
52 m	Poorly graded SAND, SP, dense, light gray, dry, fine grained, with milky white QUARTZ GRAVEL at elev. 54.3 m.
49 m	SILT with SAND, ML, medium dense, green-gray, slightly moist, non plastic, 30-40% fine SAND, micaceous.
46 m	Poorly graded SAND, SP, medium dense, light gray (salt and pepper), slightly moist, fine grained, white quartz 60% black mafics 40%.
43 m	SILT, ML, stiff, olive-tan, slightly moist, with dark ORGANICS, qu <sub>tp</sub> =120 kPa At elev. 44.82 m milky white QUARTZ GRAVEL.

BENCH MARK	
Pt. 2	Elev. 76.15 m At Southwest corner existing bridge as shown on Preliminary Foundation Plan dated 9-2-98.
Pt. 4	Elev. 77.07 m At Northeast corner existing bridge as shown on Preliminary Foundation Plan dated 9-2-98.
98-1	76 m
98-2	76 m
98-3	76 m
98-480	76 m



BRIDGE DEPARTMENT

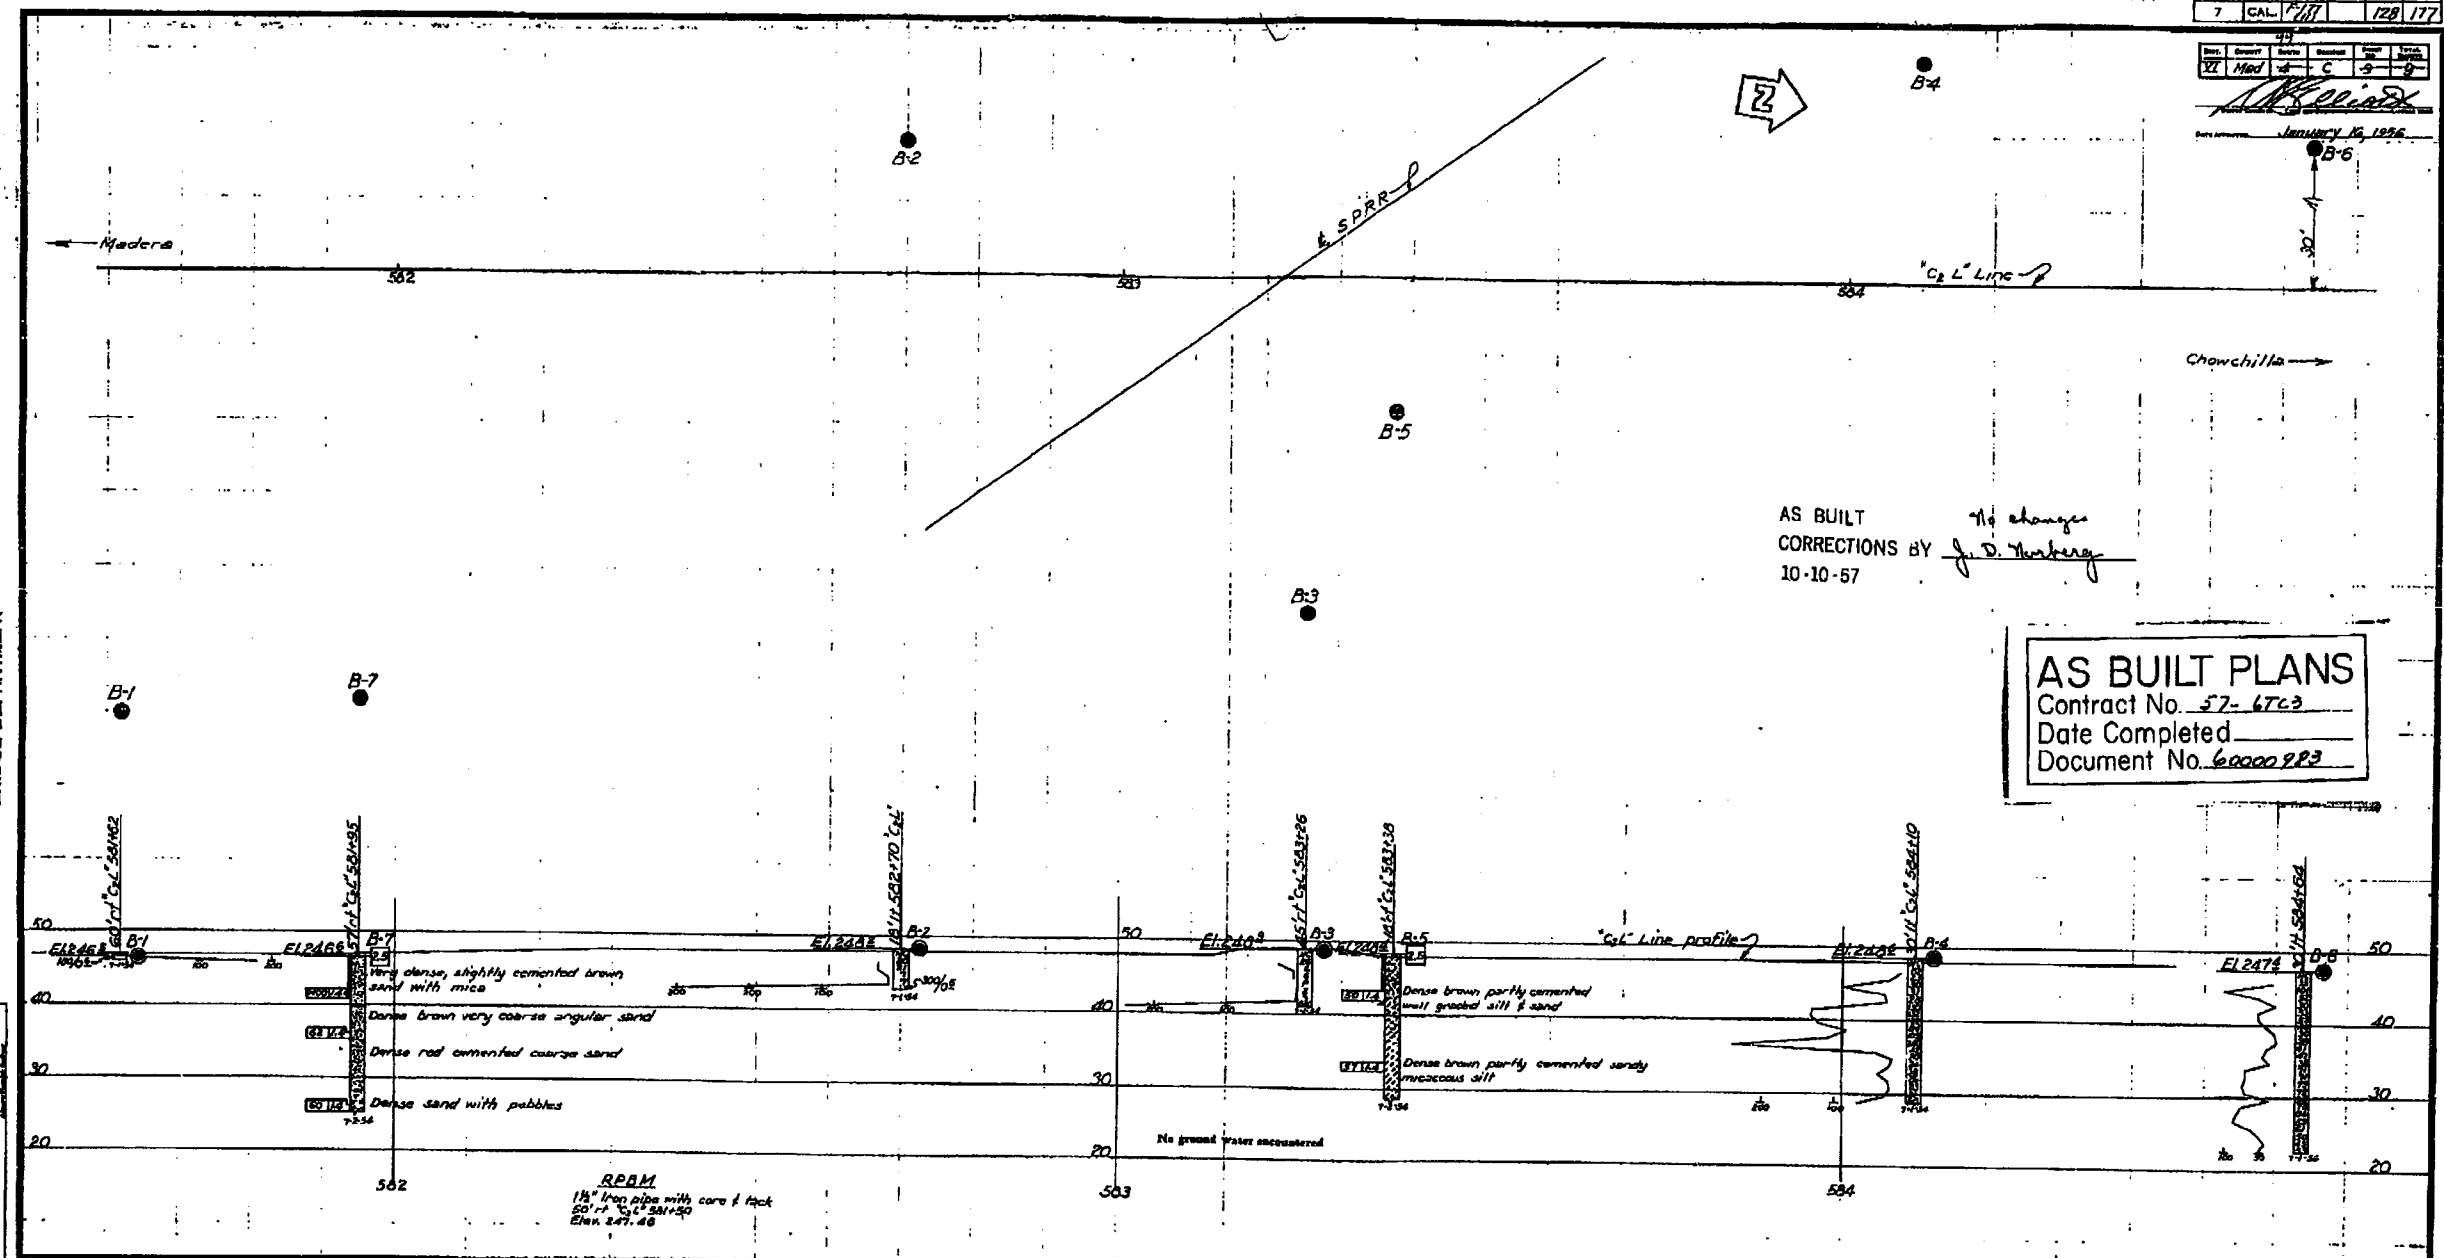

AS BUILT  
CORRECTIONS BY J. D. Humberg  
10-10-57

**AS BUILT PLANS**  
Contract No. 57-67C3  
Date Completed             
Document No. 60000983

<p><b>CLASSIFICATION OF MATERIAL BASED ON STANDARD GRADE SIZE LIMITS</b></p>	<p><b>LEGEND OF EARTH MATERIALS</b></p> <table border="0"> <tr> <td>GRAVEL</td> <td>SILTY CLAY OR CLAYEY SILT</td> </tr> <tr> <td>SAND</td> <td>PEAT AND/OR ORGANIC MATTER</td> </tr> <tr> <td>SILT</td> <td>FILL MATERIAL</td> </tr> <tr> <td>CLAY</td> <td>IGNEOUS ROCK</td> </tr> <tr> <td>SANDY CLAY OR CLAYEY SAND</td> <td>SEDIMENTARY ROCK</td> </tr> <tr> <td>SANDY SILT OR SILTY SAND</td> <td>METAMORPHIC ROCK</td> </tr> </table>	GRAVEL	SILTY CLAY OR CLAYEY SILT	SAND	PEAT AND/OR ORGANIC MATTER	SILT	FILL MATERIAL	CLAY	IGNEOUS ROCK	SANDY CLAY OR CLAYEY SAND	SEDIMENTARY ROCK	SANDY SILT OR SILTY SAND	METAMORPHIC ROCK	<p><b>LEGEND OF BORING OPERATIONS</b></p> <ul style="list-style-type: none"> <li>PLAN OF ANY BORING</li> <li>PENETROMETER</li> <li>2 1/2" CONE PENETROMETER</li> <li>SAMPLER BORING (DRY)</li> <li>ROTARY BORING (WET)</li> <li>AUGER BORING (DRY)</li> <li>JET BORING</li> <li>CORE BORING</li> <li>TEST PIT</li> </ul> <p><b>1" SOIL TUBE</b></p> <p><b>ROTARY BORING</b></p> <p><b>PENETRATION BORING</b></p>	<p><b>NOTES</b></p> <p>The contractor's attention is directed to Section 2, Article (c) of the Standard Specifications and to the Special Provisions accompanying this set of plans. Classification of earth material as shown on this sheet is based upon field inspection and is not to be construed to imply mechanical analysis.</p> <p>STATE OF CALIFORNIA DEPARTMENT OF PUBLIC WORKS OFFICE OF THE DIRECTOR</p> <p><b>CALIFA OVERHEAD</b></p> <p><b>LOG OF TEST BORINGS</b></p> <p>SCALE 1"=10' BRIDGE 41-12L PLS 41 DRAWING 6-1940-9</p>
GRAVEL	SILTY CLAY OR CLAYEY SILT														
SAND	PEAT AND/OR ORGANIC MATTER														
SILT	FILL MATERIAL														
CLAY	IGNEOUS ROCK														
SANDY CLAY OR CLAYEY SAND	SEDIMENTARY ROCK														
SANDY SILT OR SILTY SAND	METAMORPHIC ROCK														

I HEREBY CERTIFY THAT THIS IS A TRUE AND ACCURATE COPY OF THE ABOVE DOCUMENT TAKEN UNDER MY DIRECTION AND CONTROL ON THIS DATE IN SACRAMENTO, CALIFORNIA PURSUANT TO AUTHORIZATION BY THE DIRECTOR OF PUBLIC WORKS.  
DATE June 11, 1971 SIGNATURE [Signature] TITLE Highway Engineer

Madera

582

583

584

G.L. Line


Chowchilla

NOTE  
THIS LOG OF TEST BORINGS IS AVAILABLE ON  
MICROFILM AT OFFICE OF STRUCTURES DESIGN  
SACRAMENTO, CALIFORNIA

Approved 4-29-91

DIST.	COUNTY	ROUTE	POST MILES - TOTAL PROJECT	SHEET NO.	TOTAL SHEETS
06	Mad	99	23.1/26.9	33	55

ENGINEERING GEOLOGY BRANCH - TRANSPORTATION MATERIALS & RESEARCH  
CERTIFIED ENGINEERING GEOLOGIST - PROJECT GEOLOGIST  
**CALIFA OVERHEAD (WIDEN)**  
**LOG OF TEST BORINGS 2 OF 2**  
NOTE: THIS LOG OF TEST BORINGS IS AVAILABLE ON MICROFILM AT OFFICE OF STRUCTURES DESIGN SACRAMENTO, CALIFORNIA  
CU: 06  
EA: 282401  
BRIDGE No. 41-14L

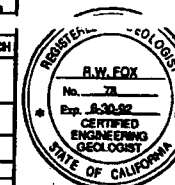

AS BUILT

CORRECTIONS BY J. D. Werberg  
10-10-57

NO CORRECTIONS THIS SHEET

AS BUILT

CORRECTIONS BY J. Abercrombie

CONTRACT NO. 06-282404


DATE 7-27-93

AS BUILT PLANS

Contract No. 57-6Tc3


Date Completed

Document No. 60000 983

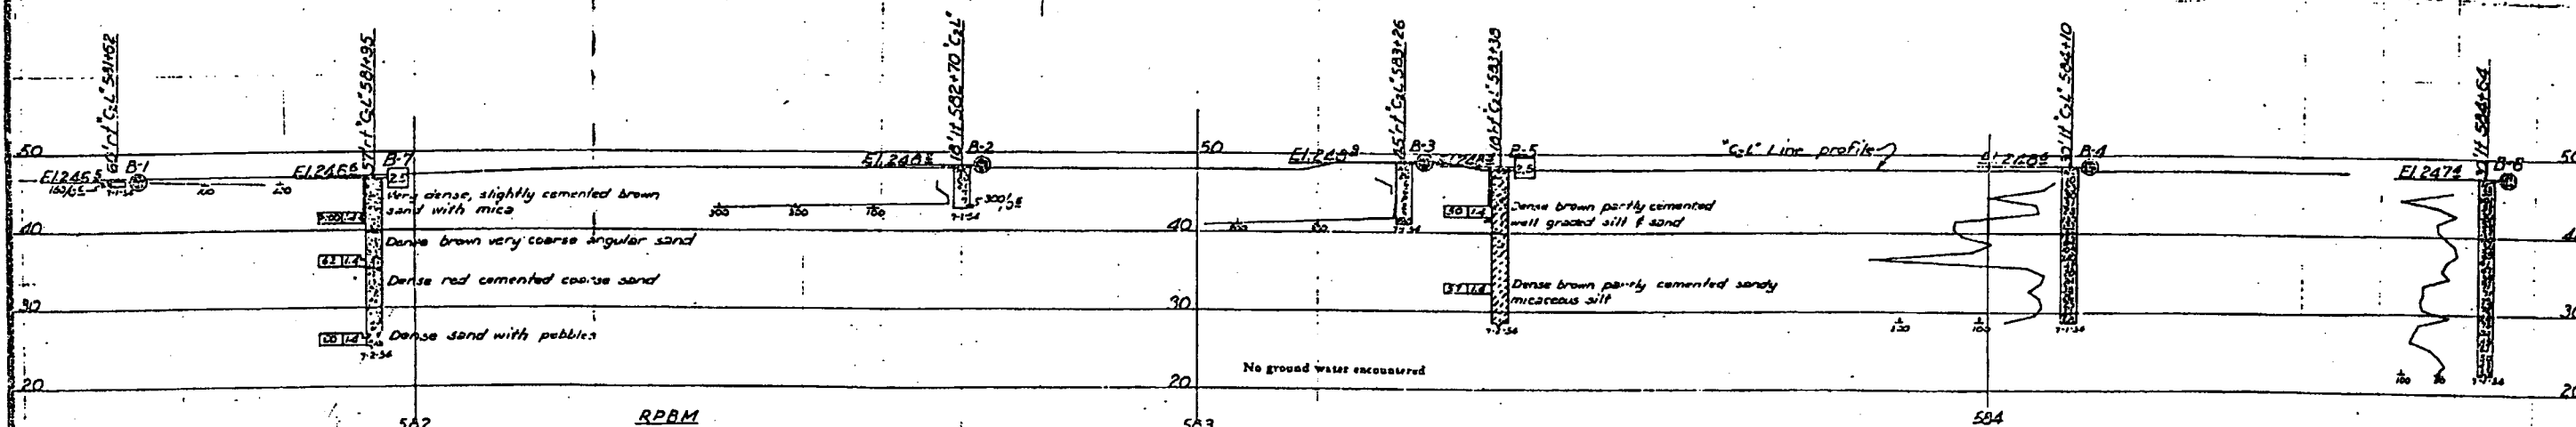

RPRM  
1 1/2" iron pipe with core & tack  
50' x 1 1/2" x 50' x 50'  
Elev. 247.48


## CLASSIFICATION OF MATERIAL BASED ON STANDARD GRADE SIZE LIMITS

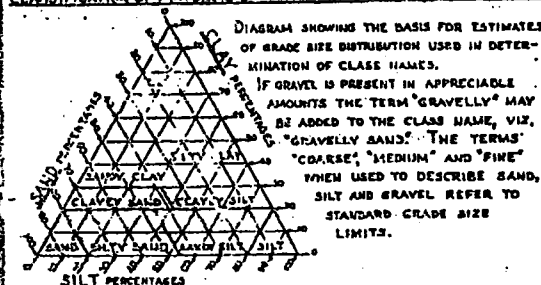

## LEGEND OF EARTH MATERIALS

GRAVEL	SILTY CLAY OR CLAYEY SILT
SAND	PEAT AND/OR ORGANIC MATTER
SILT	FILL MATERIAL
CLAY	IGNEOUS ROCK
SANDY CLAY OR CLAYEY SAND	SEDIMENTARY ROCK
SANDY SILT OR SILTY SAND	METAMORPHIC ROCK

## LEGEND OF BORING OPERATIONS

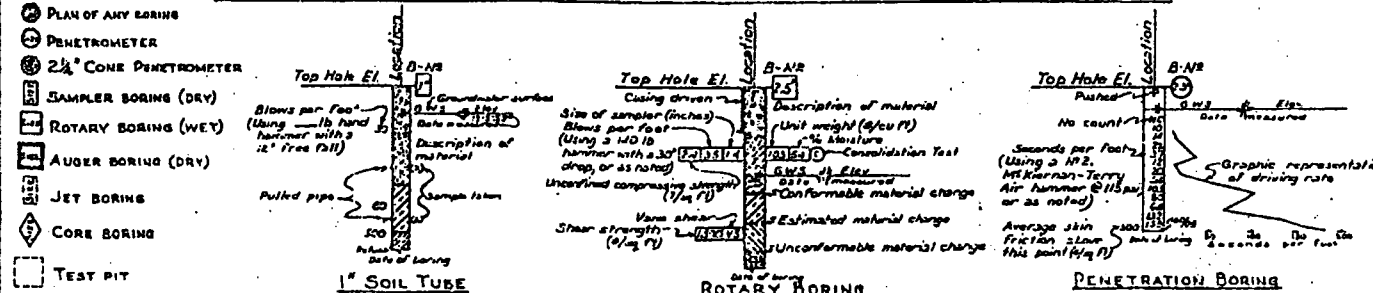

## NOTES

The contractor's attention is directed to Section 2, Article (c) of the Standard Specifications and to the Special Provisions accompanying this set of plans.  
Classification of earth material as shown on this sheet is based upon field inspection and is not to be construed to imply mechanical analysis.

CALIFA OVERHEAD

LOG OF TEST BORINGS

SCALE 1"=10' BRIDGE 41-14L FILE 41 DRAWING C-1940-1

PREL. DRAWING NO. 1940 35

SHEET 19 OF 19



---



NO CORRECTIONS THIS SHEET

## AS BUILT

6 AC 9-7-93  
CORRECTIONS BY J. Abernethy

CONTRACT NO. 06-282404


DATE 7-27-93

### BENCH MARK

FD. P-85 USCGB BM BRASS DISC STAMPED 248.677  
P-85 1930 LOCATED 330' SOUTHEAST ON EAST  
SIDE OF SOUTH ABUT. BRIDGE NO. B-171.78  
ELEVATION 248.23".

**NOTE**

NO GROUNDWATER ENCOUNTERED DURING  
FIELD INVESTIGATION.

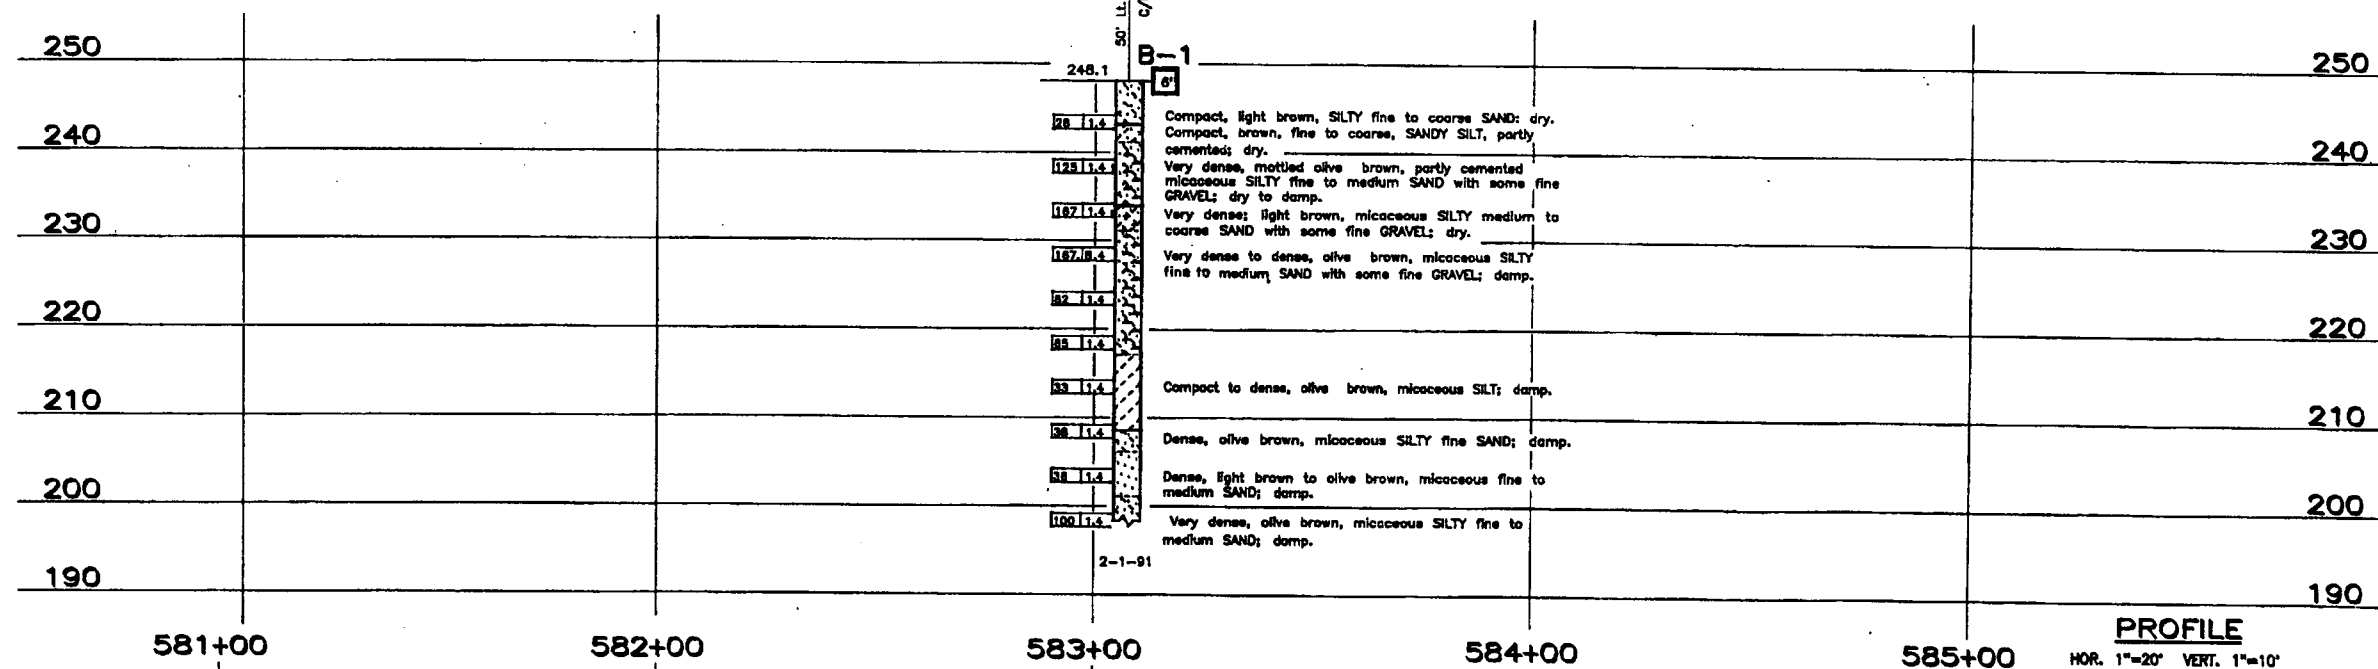

## PROFILE

HOR. 1"=20' VERT. 1"=10'

OFFICE OF TRANSPORTATION MATERIALS & RESEARCH		ENGINEERING GEOLOGY BRANCH
DRAWN BY	LEONY L. LOPEZ	2/91
CHECKED BY		

State of  
**CALIFORNIA**  
DEPARTMENT OF TRANSPORTATION

## DIVISION OF STRUCTURES STRUCTURE DESIGN

BRIDGE NO.
41-14L
POST MILE
23.1

CALIFA OVERHEAD (WIDEN)

LOG OF TEST BORINGS 1 OF 2

ORIGINAL SCALE IN INCHES  
FOR REDUCED PLANS

CU	06200
EA	282401

DISREGARD PRINTS BEARING  
EARLIER REVISION DATES -

REVISION DATES (PRELIMINARY STAGE ONLY)


SHEET	OF
18	19

STATE	PROJECT	DATE	BY	CHKD	APP'D
7	CAL.				

DATE	BY	CHKD	APP'D
1/11	Mad		


January 16, 1956

BRIDGE DEPARTMENT

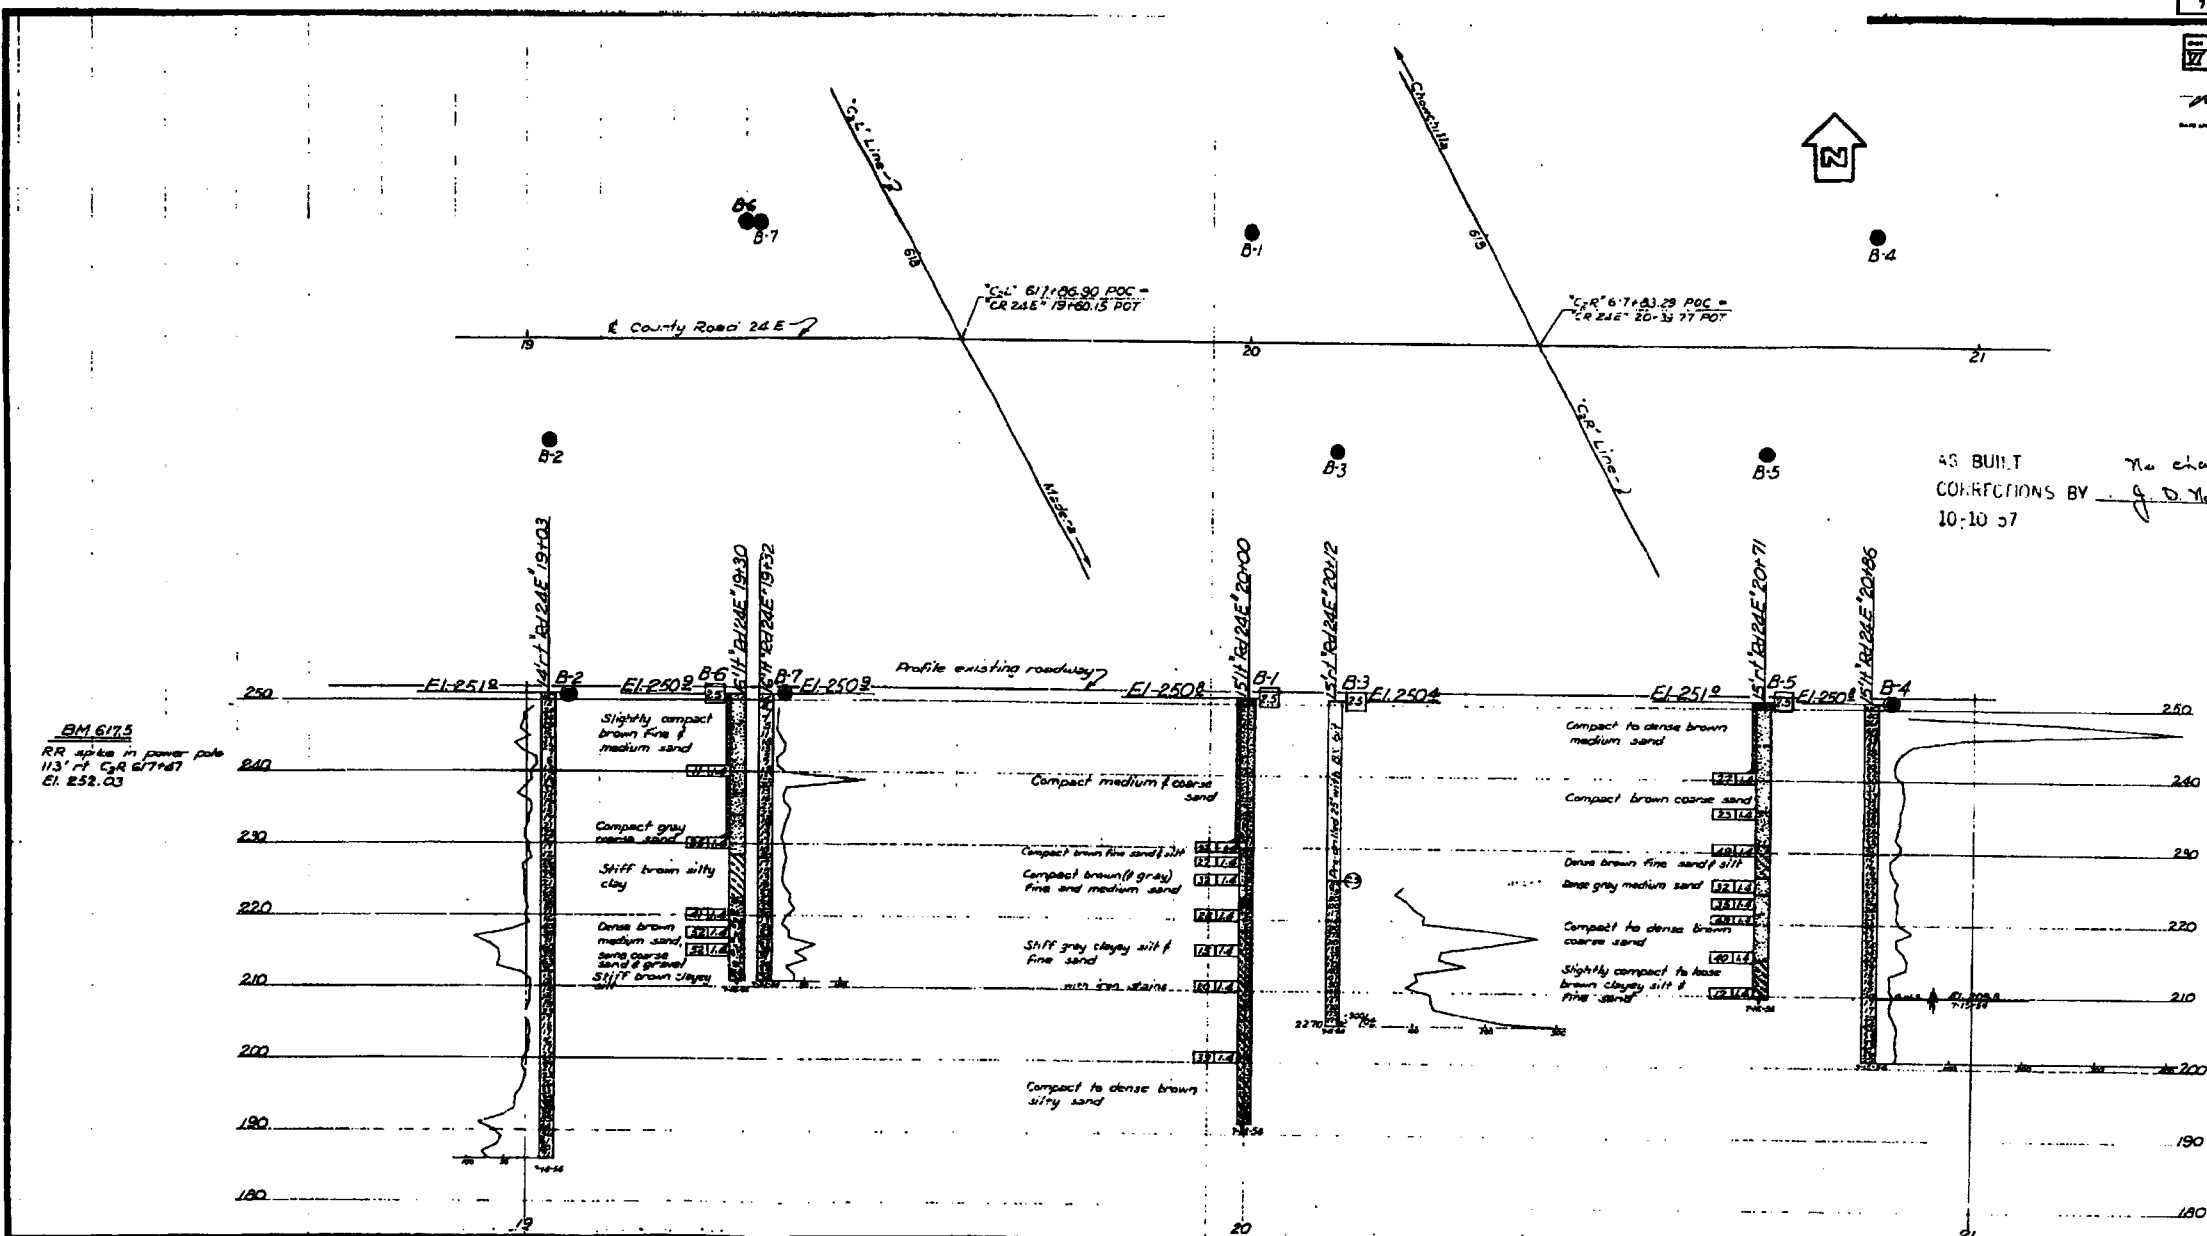

AS BUILT  
CORRECTIONS BY *J. D. Harting*  
10:10 57

AS BUILT PLANS  
Contract No. 57-67c3  
Date Completed  
Document No. 60000993

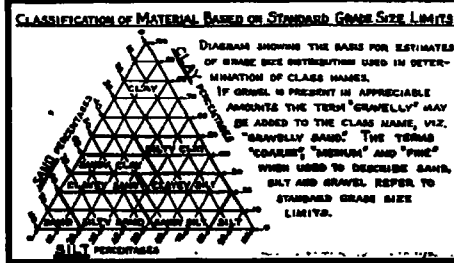

**LEGEND OF EARTH MATERIALS**

GRAVEL	SILTY CLAY OR CLAYEY SILT
SAND	PEAT AND/OR ORGANIC MATTER
SILT	FILL MATERIAL
CLAY	IGNEOUS ROCK
SANDY CLAY OR CLAYEY SAND	SEDIMENTARY ROCK
SANDY SILT OR SILTY SAND	METAMORPHIC ROCK

**LEGEND OF BORING OPERATIONS**

PLAN OF ANY BORING	Top Hole El.	Bottom Hole El.	Penetration
PENETROMETER	Blows per foot	Blows per foot	Blows per foot
2 1/2" CONE PENETROMETER	Blows per foot	Blows per foot	Blows per foot
SAMPLER BORING (DRY)	Blows per foot	Blows per foot	Blows per foot
ROTARY BORING (WET)	Blows per foot	Blows per foot	Blows per foot
AUGER BORING (DRY)	Blows per foot	Blows per foot	Blows per foot
JET BORING	Blows per foot	Blows per foot	Blows per foot
COKE BORING	Blows per foot	Blows per foot	Blows per foot
TEST PIT	Blows per foot	Blows per foot	Blows per foot

**NOTES**

The contractor's attention is directed to Section 2, Article (c) of the Standard Specifications and to the Special Provisions accompanying this set of plans.

Classification of earth material as shown on this sheet is based upon field inspection and is not to be construed to imply mechanical analysis.

**ROAD 24E OVERCROSSING**

**LOG OF TEST BORINGS**

Scale 1"=10'

PREL. DRAWING NO. P-3477-2

I HEREBY CERTIFY THAT THIS IS A TRUE AND ACCURATE COPY OF THE ABOVE DOCUMENT TAKEN UNDER MY DIRECTION AND CONTROL ON THIS DATE IN SACRAMENTO, CALIFORNIA PURSUANT TO AUTHORIZATION BY THE DIRECTOR OF PUBLIC WORKS.

DATE *June 11, 1971* SIGNATURE *John L. Harting* TITLE *Highway Engineer*



NOTE  
THIS LOG OF TEST BORINGS IS AVAILABLE ON  
MICROFILM AT OFFICE OF STRUCTURES DESIGN  
SACRAMENTO, CALIFORNIA

TEST NO.	STATE	PROJECT NO.	SECTION	DATE
27	MOD	99	C	5-5

January 16, 1956

ENGINEERING GEOLOGY BRANCH - TRANSPORTATION LABORATORY

REGISTERED ENGINEER - CIVIL

BERENDA SLOUGH

LOG OF TEST BORINGS 2012

CU: 08  
EA: 282401

BRIDGE No.  
41-44 R/L



DIST	COUNTY	ROUTE	POST MILES TOTAL PROJECT	SHEET NO.	TOTAL SHEETS
06	Mod	99	23.1/26.9	44	55


Approved 4-29-91

NO CORRECTIONS THIS SHEET

DES 9-8-92  
CORRECTION BY V. Abernethy  
CONTRACT NO. 06-282404  
DATE 7-27-92

BUILT  
CORRECTED  
10-10-57


No changes  
J. D. Norberg

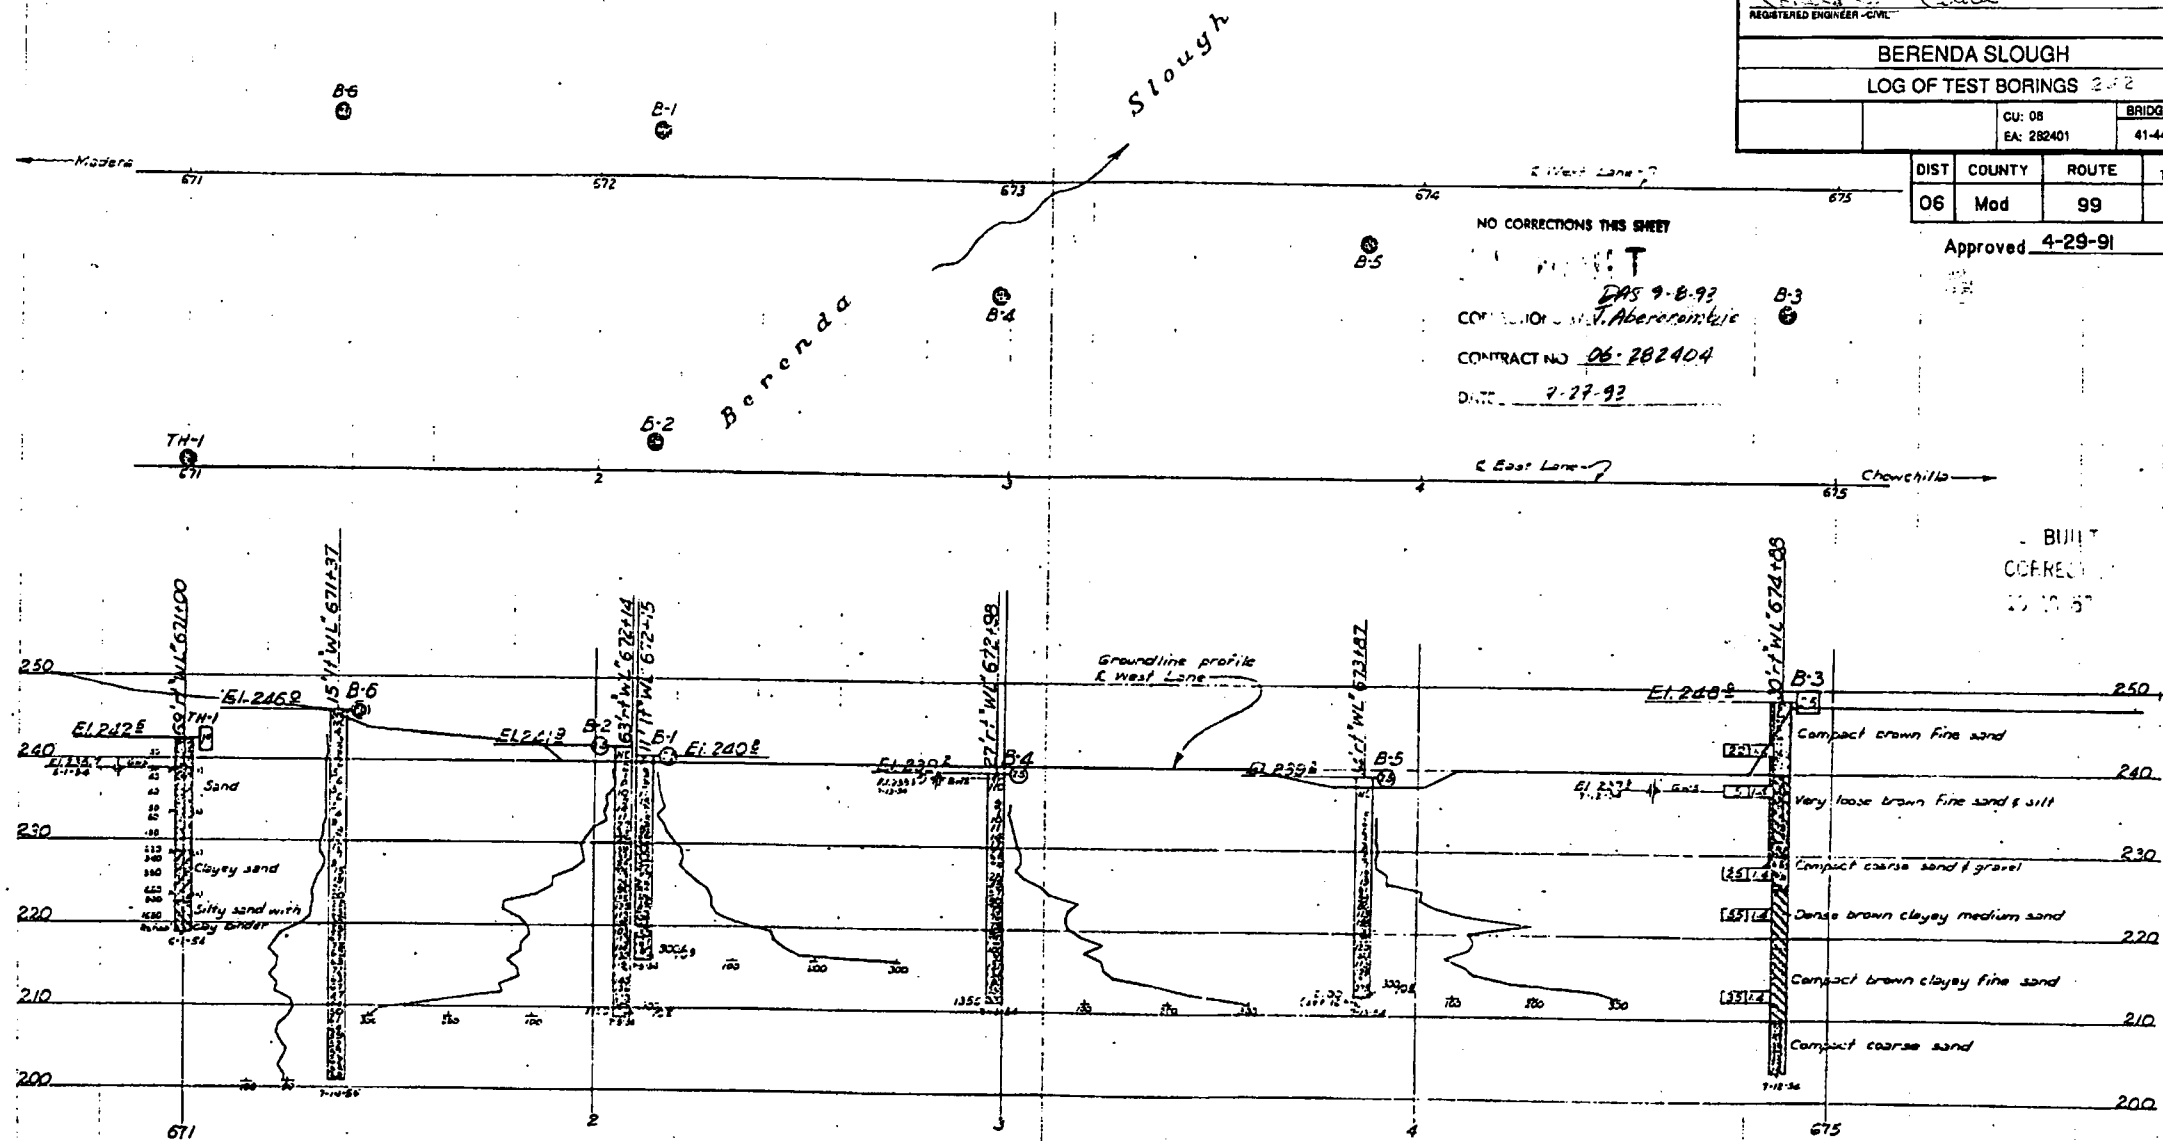

B.M. 669.7  
RR Spike in power pole  
120' N. E.L. 669+70  
Elev. 255.09


AS BUILT PLANS  
Contract No. 57-61c3  
Date Completed  
Document No. 6000223

Sheet No. 11 of 11

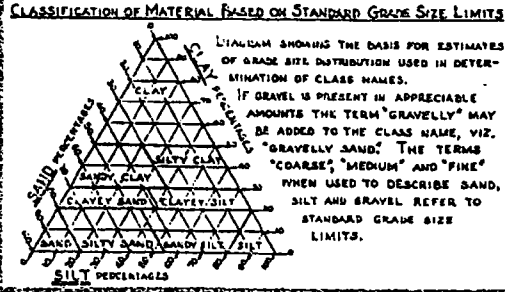

LEGEND OF EARTH MATERIALS

GRAVEL	SILTY CLAY OR CLAYEY SILT
SAND	PEAT AND/OR ORGANIC MATTER
SILT	FILL MATERIAL
CLAY	IGNEOUS ROCK
SANDY CLAY OR CLAYEY SAND	SEDIMENTARY ROCK
SANDY SILT OR SILTY SAND	METAMORPHIC ROCK

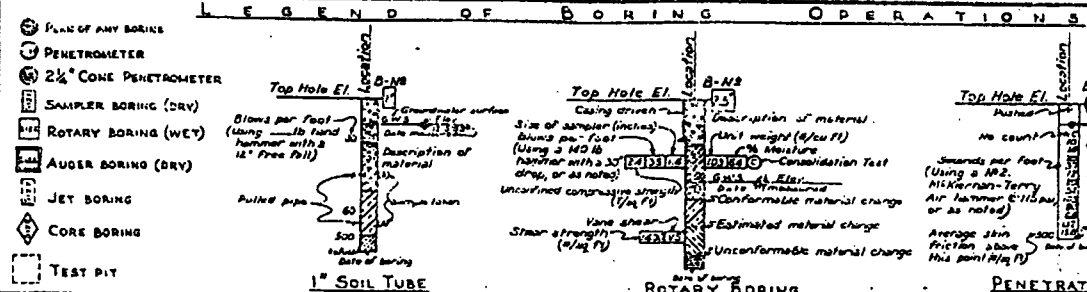

NOTES

The contractor's attention is directed to Section 2, Article (c) of the Standard Specifications and to the Special Provisions accompanying this set of plans.

Classification of earth material as shown on this sheet is based upon field inspection and is not to be construed to imply mechanical analysis.

STATE OF CALIFORNIA  
DEPARTMENT OF PUBLIC WORKS  
DIVISION OF HIGHWAYS

BERENDA SLOUGH BRIDGE (WIDEN)

LOG OF TEST BORINGS 2012


Horizontal Scale 1"=50'  
Vertical Scale 1"=10'

BRIDGE 41-44 R/L FILE 4-1 DRAWING 6-3316-5

DIST.	COUNTY	ROUTE	POST MILES TOTAL PROJECT	SHEET NO.	TOTAL SHEETS
06	Mad	99	24.8, 26.8	14	15

Registered Engineer - Civil  
 R. RICHMAN  
 No. 38889  
 Exp. 12-31-93  
 CIVIL  
 STATE OF CALIFORNIA

12-6-93  
 PLANS APPROVAL DATE

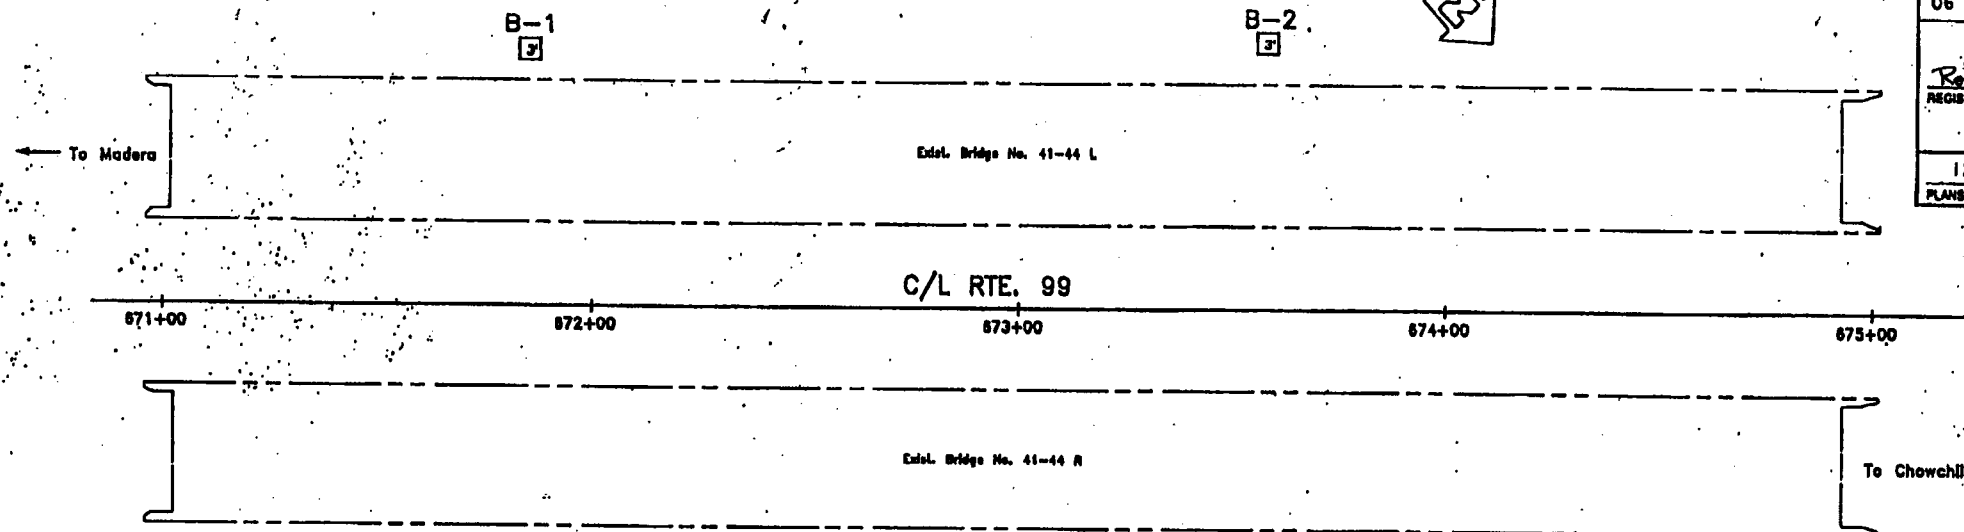

### BENCH MARK

BM Elev. 249.15  
 Fnd 3/4" ID IP with plastic plug stamped  
 LS4014 1" N. 675+05.2


### PLAN

1" = 20'

NOTE: GROUNDWATER LEVELS WILL LIKELY  
 VARY WITH WATER LEVELS IN  
 BERENDA SLOUGH

**AS BUILT**  
 No correction  
 Corrections to  
 06-831701  
 Date 3/16/95

**THIS IS A COPY**  
 NOT AN ORIGINAL

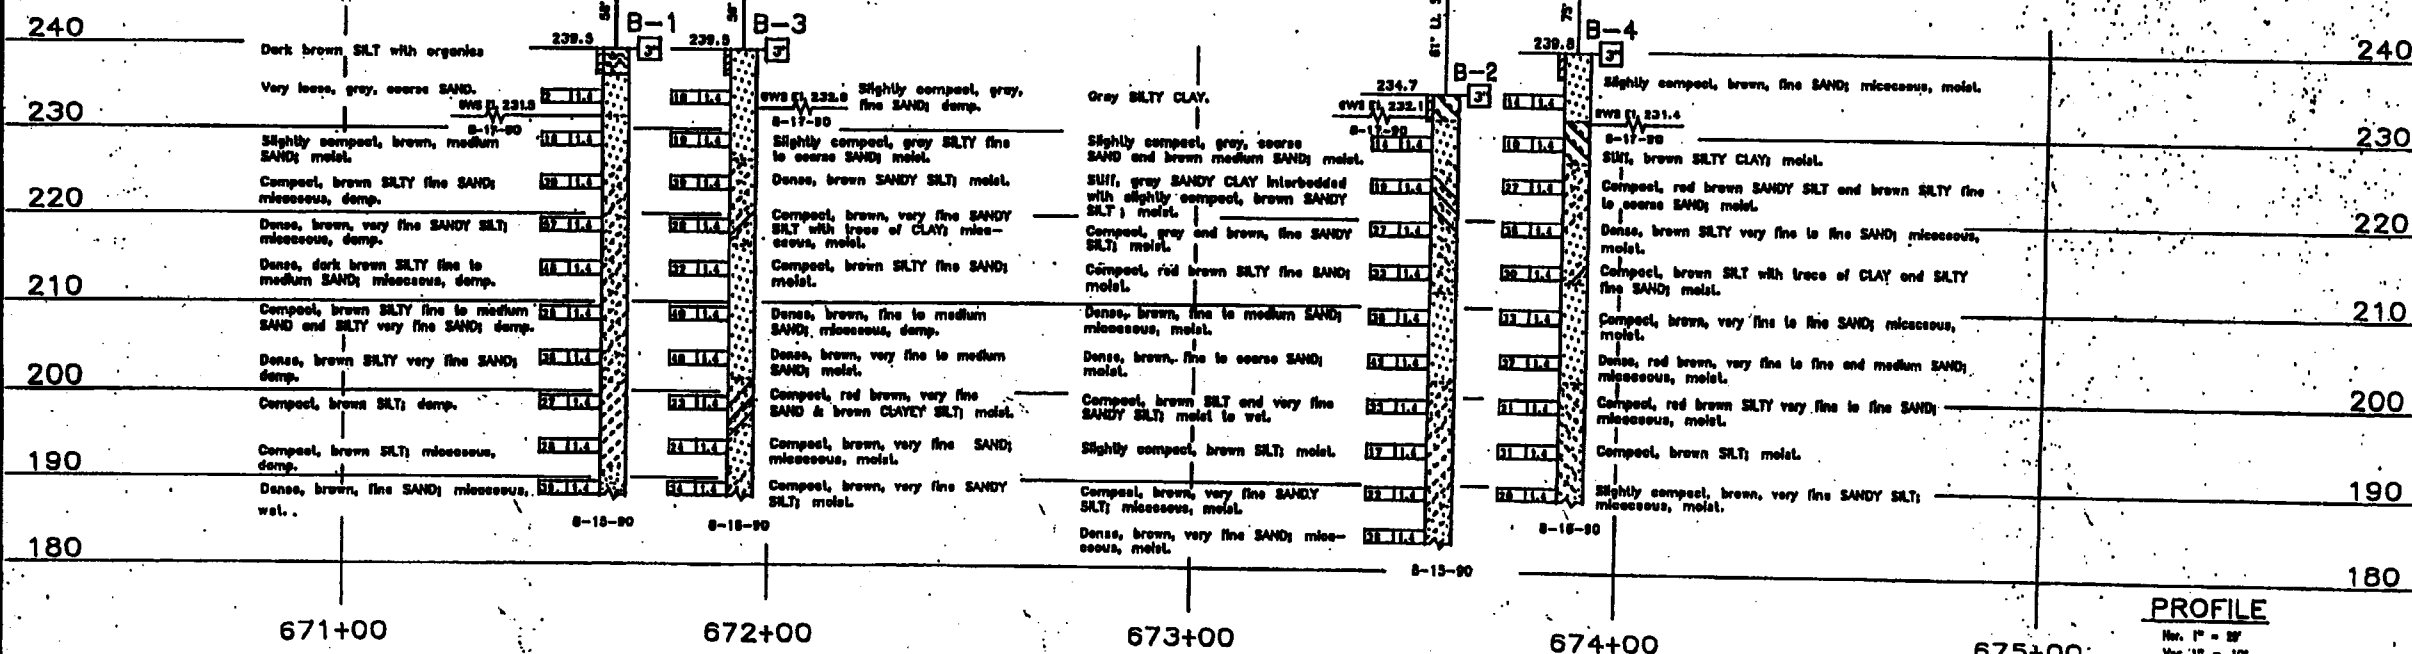

ENGINEERING GEOLOGY BRANCH - TRANSPORTATION LABORATORY				State of CALIFORNIA		DIVISION OF STRUCTURES		BRIDGE NO. 41-044RL		BERENDA SLOUGH BRIDGE (STRENGTHEN)	
DRAWN BY: RIMA GAMARRA 8/90				PROJECT ENGINEER: [Signature]		STRUCTURE DESIGN 9		POST MILE 24.8		LOG OF TEST BORINGS 10F2	
CHECKED BY: R.L.R. 9/90				DEPARTMENT OF TRANSPORTATION							

ORIGINAL SCALE IN INCHES FOR REDUCED PLANS

CU 08200 EA 229701

DELEGATED PRINTS BEARING EARLIER REVISION DATES

REVISION DATES APPROPRIATE STAGE ONLY

SHEET 4 OF 5



NOTE  
THIS LOG OF TEST BORINGS IS AVAILABLE ON  
MICROFILM AT OFFICE OF STRUCTURES DESIGN  
SACRAMENTO, CALIFORNIA.

DIST	COUNTY	ROUTE	POST MILES	TOTAL PROJECT	SHEET NO.	TOTAL SHEETS
06	Mad	99	24.8, 26.8	15	15	

ENGINEERING GEOLOGY BRANCH, TRANSPORTATION LABORATORY


*Paul J. Richman*  
REGISTERED ENGINEER - CIVIL

BERENDA SLOUGH  
LOG OF TEST BORINGS 2 of 2

12-6-93  
PLANS APPROVAL DATE

CH. 98  
SA-282401



BRIDGE No.  
41-44 RA.

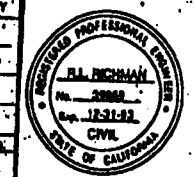

AS BUILT

THIS IS A COPY  
OF AN ORIGINAL

AS BUILT PLANS  
Contract No. 57-623  
Date Completed  
Document No. 60000993

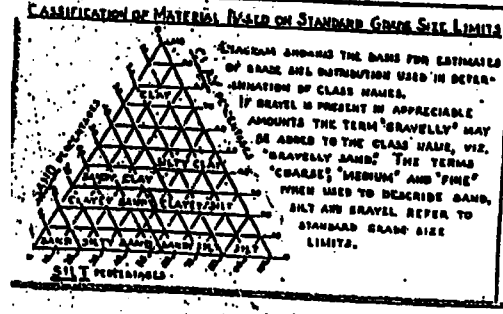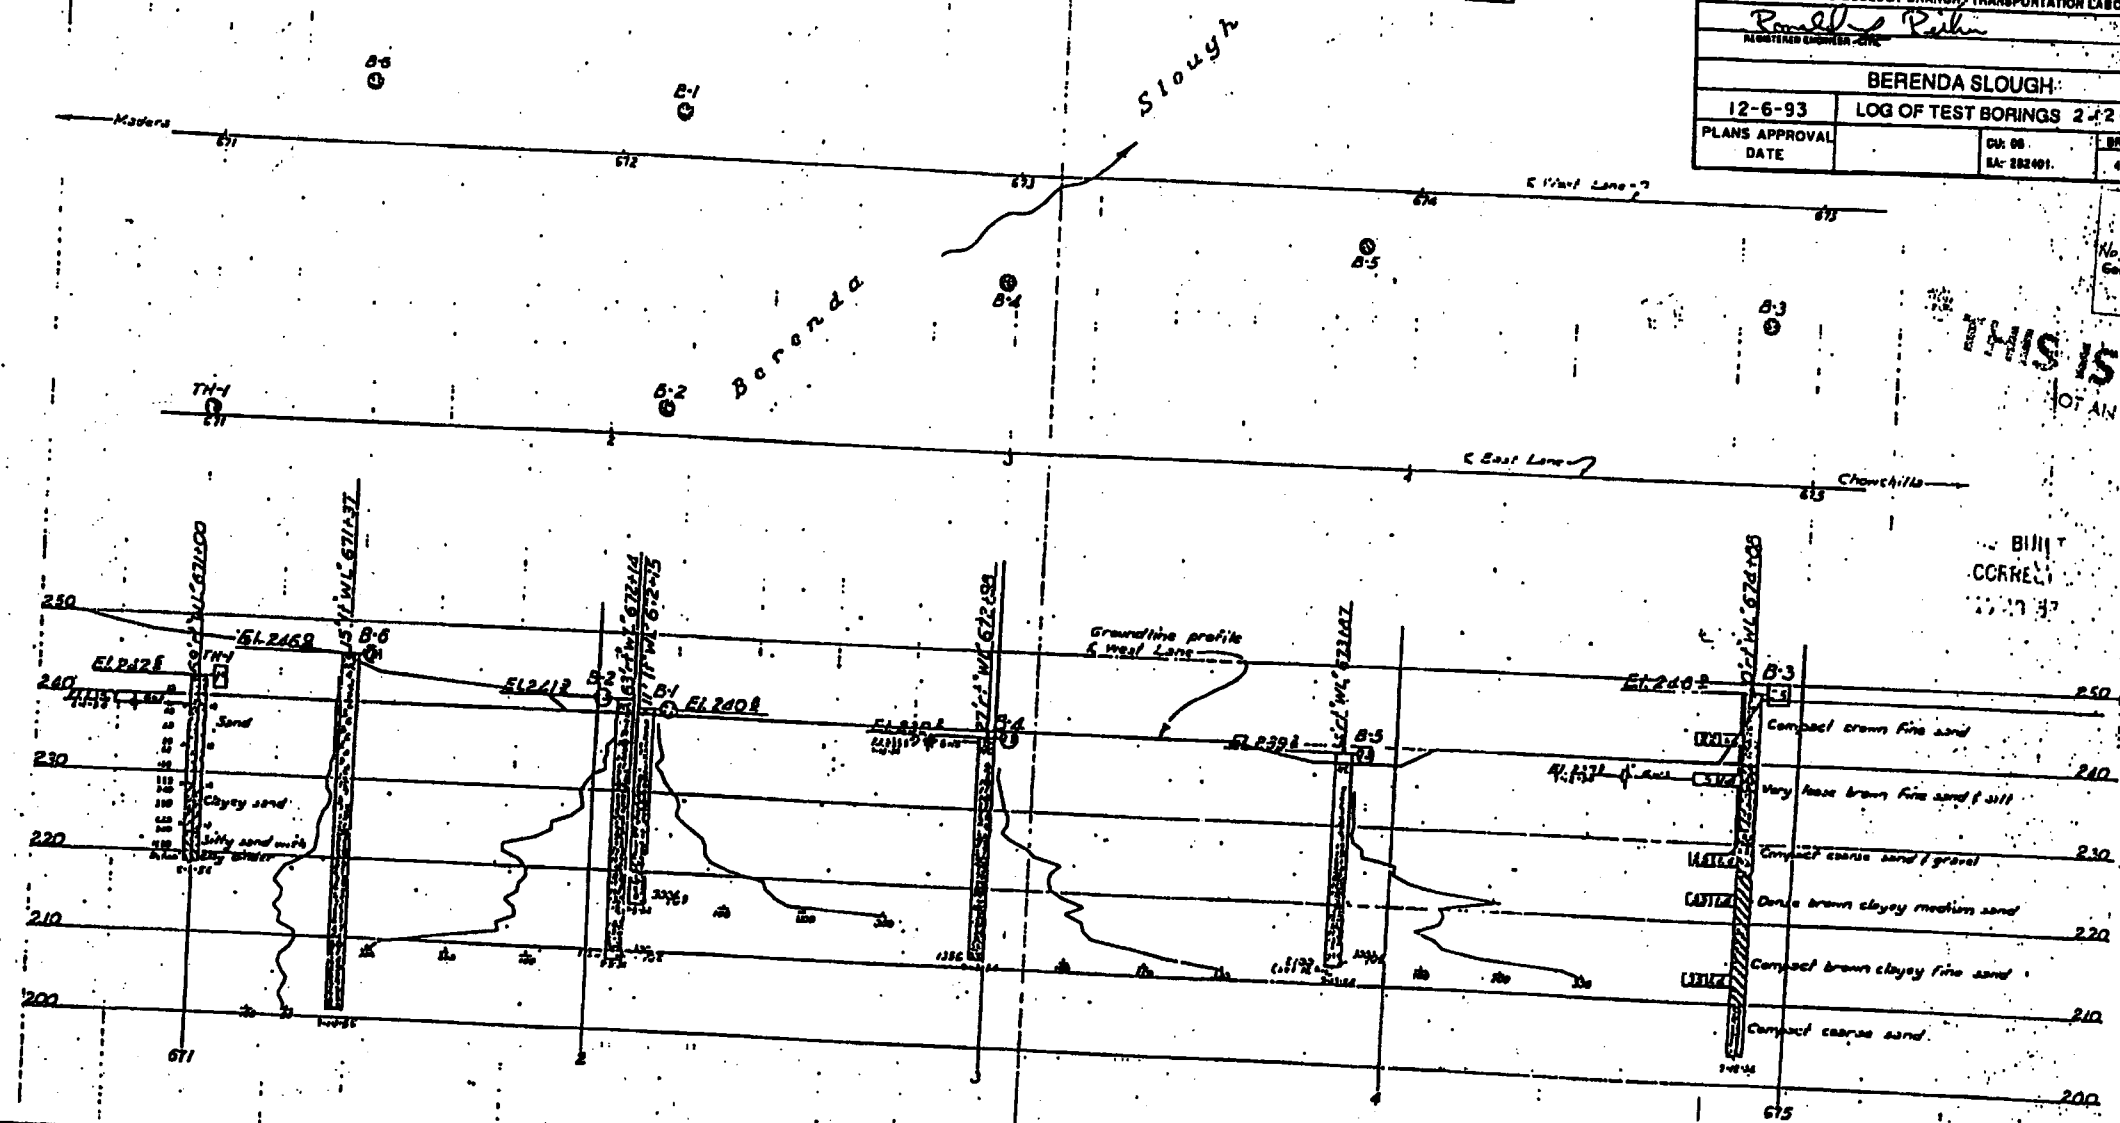

- LEGEND OF EARTH MATERIALS
- |                           |                            |
|---------------------------|----------------------------|
| GRAVEL                    | SILTY CLAY OR CLAYEY SILT  |
| SAND                      | PEAT AND/OR ORGANIC MATTER |
| SILT                      | FILL MATERIAL              |
| CLAY                      | IGNEOUS ROCK               |
| SANDY CLAY OR CLAYEY SAND | SEDIMENTARY ROCK           |
| SANDY SILT OR SILTY SAND  | METAMORPHIC ROCK           |

- LEGEND OF BORING OPERATIONS
- PLAN OF ANY BORING
  - PENETROMETER
  - 2 1/2" CONE PENETROMETER
  - SAMPLER BORING (DRY)
  - ROTARY BORING (WET)
  - AUGER BORING (DRY)
  - JET BORING
  - CORE BORING
  - TEST PIT
- 1" SOIL TUBE
- ROTARY BORING
- PENETRATION BORING

NOTES:

The contractor's attention is directed to Section 2, Article (c) of the Standard Specifications and to the Special Provisions accompanying this set of plans.


Classification of earth material as shown on this sheet is based upon field inspection and is not to be construed to imply mechanical analysis.

BERENDA SLOUGH BRIDGE (STRENGTHEN)  
LOG OF TEST BORINGS 2 of 2

Scale: Horiz. 1"=20', Vert. 1"=10'

DATE: JAN 16 1994

BRIDGE DEPARTMENT

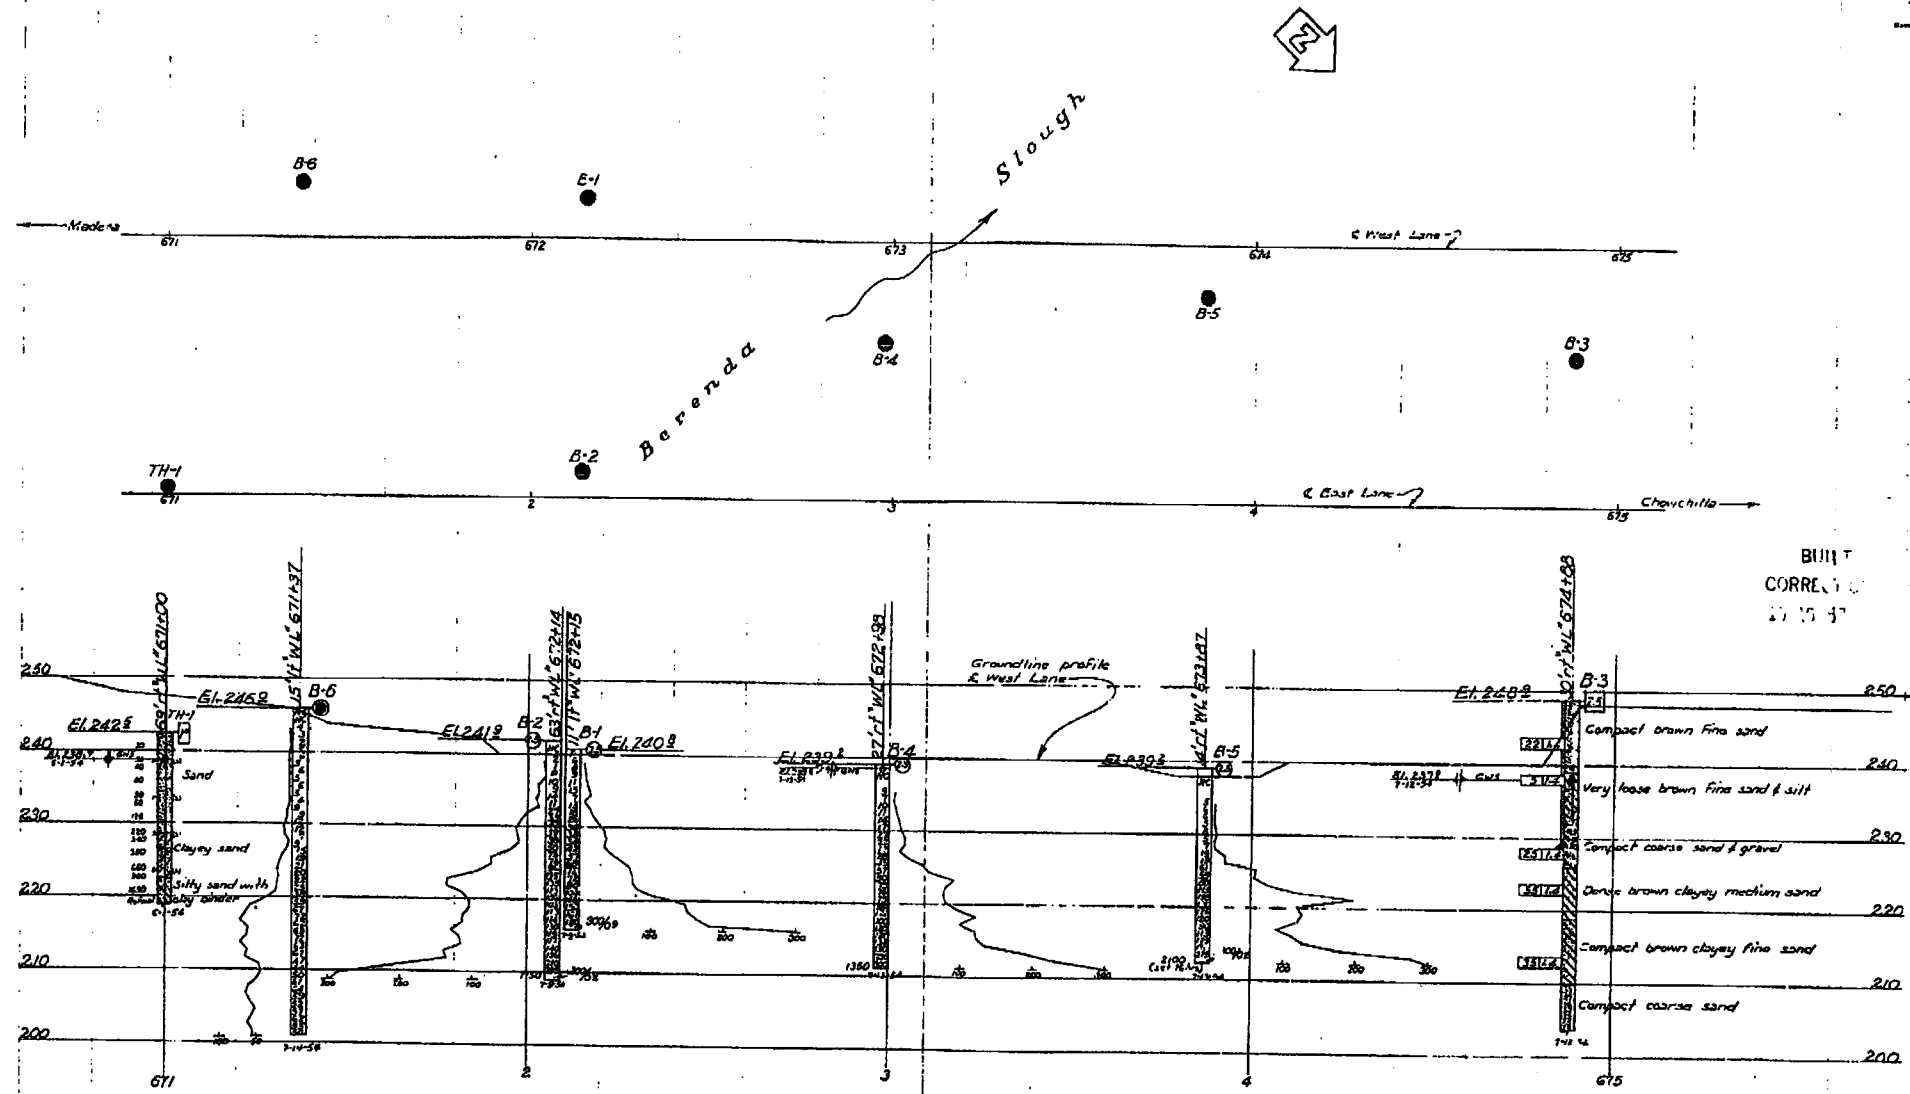


B.M. 659.7  
RR Spike in power pole  
120' W. EL. 659.70  
Elev. 255.08

BUILT  
CORRECTION  
No changes  
J. D. Norberg

AS BUILT PLANS  
Contract No. 52-67c3  
Date Completed  
Document No. 60000993


CLASSIFICATION OF MATERIAL BASED ON STANDARD GRADE SIZE LIMITS

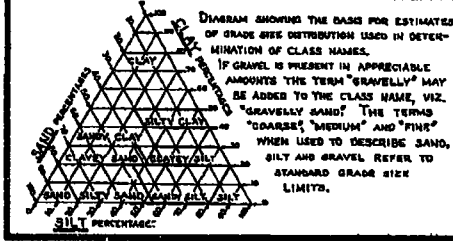

LEGEND OF EARTH MATERIALS

GRAVEL	SILTY CLAY OR CLAYEY SILT
SAND	PEAT AND/OR ORGANIC MATTER
SILT	FILL MATERIAL
CLAY	IGNEOUS ROCK
SANDY CLAY OR CLAYEY SAND	SEDIMENTARY ROCK
SANDY SILT OR SILTY SAND	METAMORPHIC ROCK

LEGEND OF BORING OPERATIONS

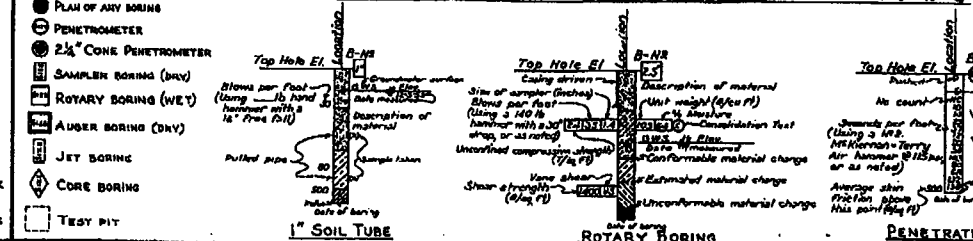

NOTES  
The contractor's attention is directed to Section 1, Article (c) of the Standard Specifications and to the Special Provisions accompanying this set of plans.  
Classification of earth material as shown on this sheet is based upon field inspection and is not to be construed to imply mechanical analysis.

STATE OF CALIFORNIA  
DEPARTMENT OF PUBLIC WORKS  
DIVISION OF HIGHWAYS

BRIDGE ACROSS BERENDA SLOUGH

LOG OF TEST BORINGS  
SCALE: HORIZ. 1"=20' VERT. 1"=10' BRIDGE 4-44 RRL FILE 4-41 DRAWING 62-3316-5

148

I, J. D. NORBERG, hereby certify that this is a true and correct copy of the original instrument taken on my direction and control on this date in Sacramento, California pursuant to the provisions of the Public Works Law.



DIST.	COUNTY	ROUTE	POST MILES TOTAL PROJECT	SHEET NO.	TOTAL SHEETS
06	Mod	99	23.1/26.9	43	55

REGISTERED ENGINEER - CIVIL

R. RICHMAN

No. 39869


Exp. 12-31-93

CIVIL

STATE OF CALIFORNIA

4-29-91

PLANS APPROVAL DATE

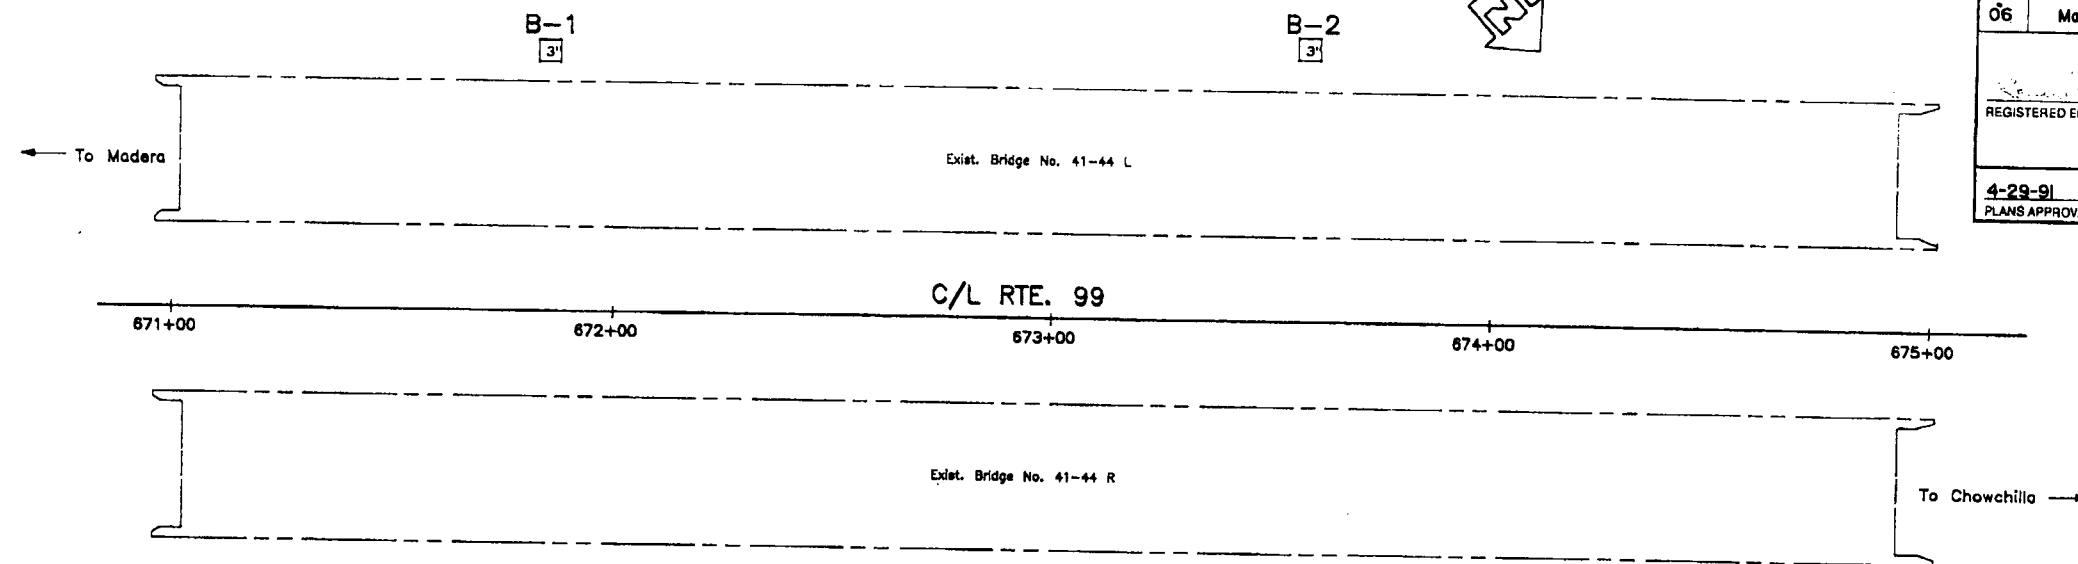


**BENCH MARK**  
BM Elev. 249.15  
Fnd 3/4" ID IP with plastic plug stamped  
LS4014 1' ft. 675+06 ±

**PLAN**  
1" = 20'

NO CORRECTIONS THIS SHEET

PROJECT  
EAS 9-8-93  
CONTRACT NO. 06-282404  
DATE 7-27-93

NOTE: GROUNDWATER LEVELS WILL LIKELY VARY WITH WATER LEVELS IN BERENDA SLOUGH.

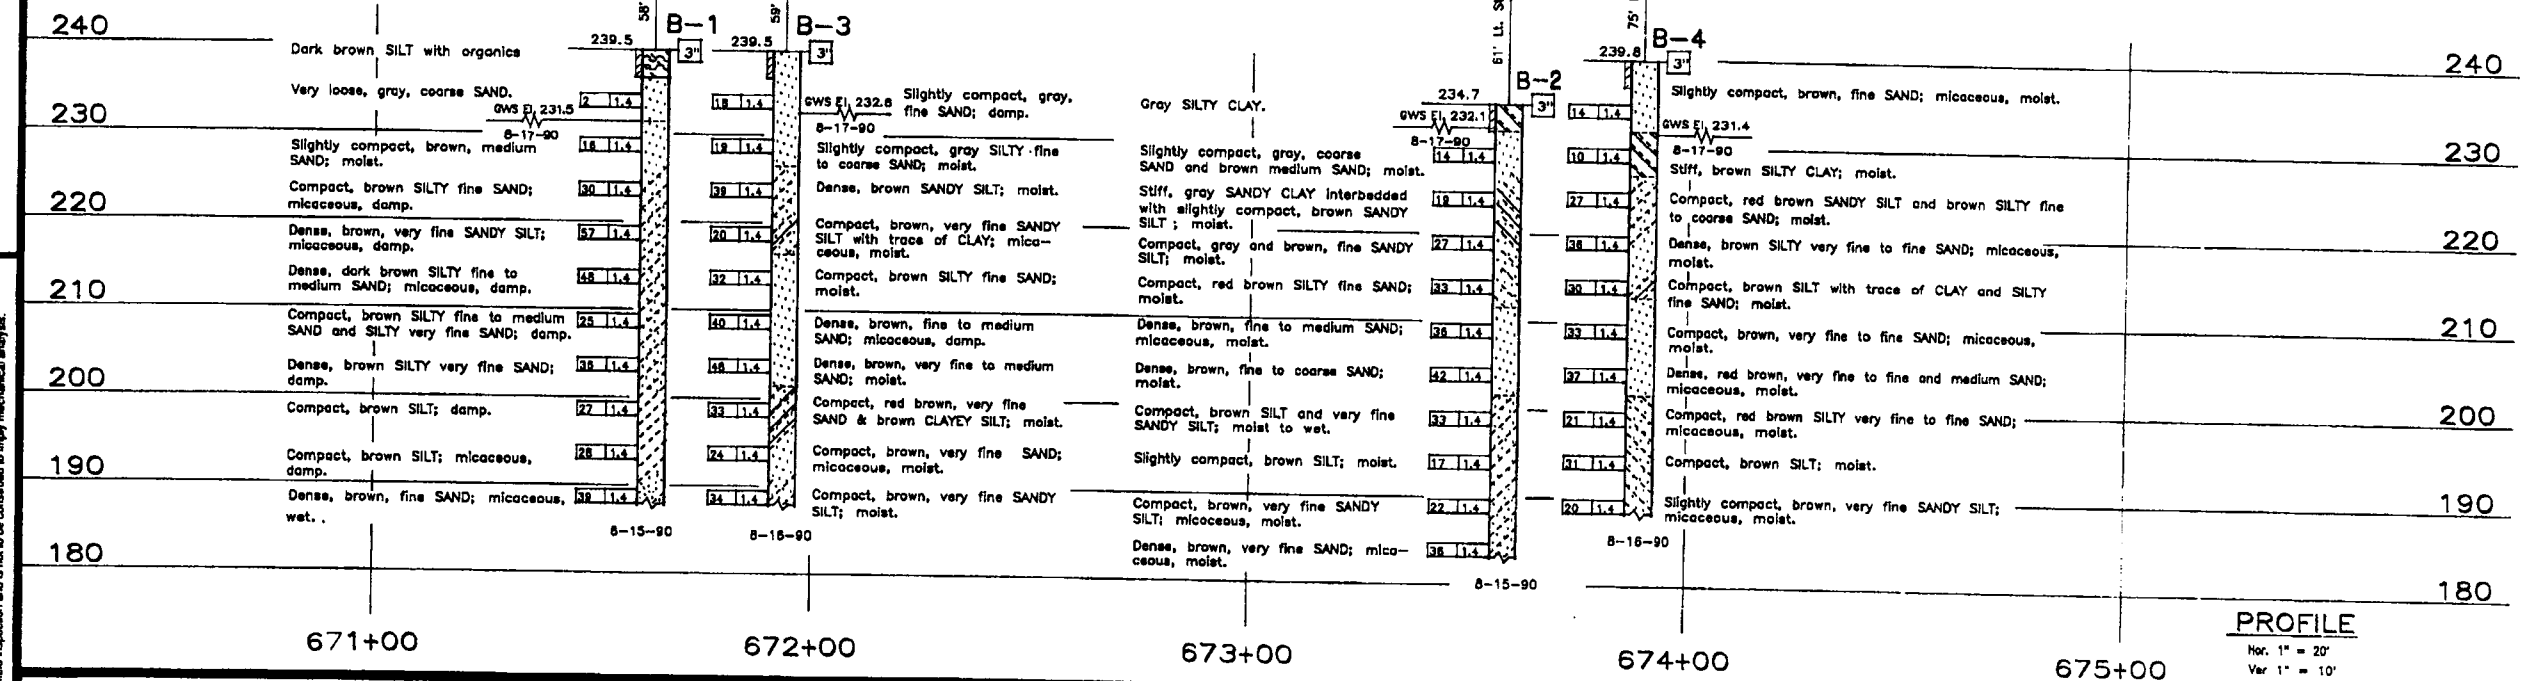

ENGINEERING GEOLOGY BRANCH - TRANSPORTATION LABORATORY

DRAWN BY IRMA GAMARRA 8/90  
CHECKED BY S-R 9/90

PROJECT ENGINEER

State of  
CALIFORNIA  
DEPARTMENT OF TRANSPORTATION

DIVISION OF STRUCTURES  
STRUCTURE DESIGN

BRIDGE NO.  
41-044R/L  
POST MILE  
24.8

BERENDA SLOUGH BRIDGE (WIDEN)  
LOG OF TEST BORINGS 10F2

ORIGINAL SCALE IN INCHES  
FOR REDUCED PLANS

CU 06  
EA 282401

DISREGARD PRINTS BEARING  
EARLIER REVISION DATES

REVISION DATES (PRELIMINARY STAGE ONLY)

REVISION DATES

**HORIZON ENVIRONMENTAL INC.**

4970 Windplay Drive, Suite #5  
 El Dorado Hills, California 95762  
 (916) 939-2170 -- Fax: (916) 939-2172

Monitoring Well No. MW-24

Drilling Company: AWA Drilling  
 Date Drilled: 12/23/08  
 Drilling Method: 10" hollow stem auger  
 Sampling Method: 2" split spoon

Project No.: 1121.116  
 Site: Former Beacon Bulk Plant  
No. 13464  
 Location: Chowchilla, CA  
 Geologist: Craig Roth

Depth In Feet	Sample Number	Blow Count	Inches Driven	Inches Recovered	PID Reading (ppm)	Sampling Interval	Soil Description/ Comments	Well Construction
						0	Silty Sand and Gravel (SM/GM): FILL	
						1		
						2		
						3		
						4		
5		4				5		
	6	4 4 5	18	18	0	6	SANDY SILT (ML): brown, very fine-grained sand, stiff, moist	
						7		
						8		
						9		
10	10	20 27 50/5"	17	15	0	10	SANDY SILT (ML): light brown, very fine-grained sand, hard, moist,	
						11		
						12		
						13		
						14		
15	15	50/6"	6	6	5	15	SILTY SAND (SM): fine to medium-grained sand, very dense, moist	
						16		
						17		
						18		
						19		
20	20	50/6"	6	6	6	20	SILTY SAND (SM): fine to medium-grained sand, moist, very dense	
						21		
						22		
						23		
						24		
25	25	58/6"	6	6	2	25	SILTY SAND (SM): reddish brown, medium-grained sand, trace rounded pebble gravel, very dense, moist	
						26		
						27		
						28		
						29		
30	30	40 30 40	18	17	5	30	SAND (SW): tan, medium to coarse-grained sand, very dense, moist	

MW-24: Page 1 of 3



**HORIZON ENVIRONMENTAL INC.**

4970 Windplay Drive, Suite 5  
El Dorado Hills, California 95762  
(916) 939-2170 -- Fax: (916) 939-2172

Monitoring Well No. MW-24

Drilling Company: AWA Drilling  
Date Drilled: 12/23/08  
Drilling Method: 10" hollow stem auger  
Sampling Method: 2" split spoon

Project No.: 1121.116  
Site: Former Beacon Bulk Plant  
No. 13646  
Location: Chowchilla, CA  
Geologist: Craig Roth

Depth In Feet	Sample Number	Blow Count	Inches Driven	Inches Recovered	PID Reading (ppm)	Sampling Interval	Soil Description/ Comments	Well Construction
30								
31								
32								
33								
34		30						
35	35	35	18	17	5		SAND (SW): tan, medium to coarse-grained sand, very dense, moist	
36		42						
37								
38								
39		21						
40	40	32	18	14	6		SAND, gravelly (SW): tan to light brown, medium to coarse-grained sand, very dense, moist	
41		44						
42								
43								
44		32						
45	45	44	18	15	8		SAND (SW): tan to light brown, medium to very coarse-grained sand, trace gravel, very dense, very moist	
46		49						
47								
48								
49		20						
50	50	50/6"	12	10	68		SILTY SAND (SM): olive green, fine to medium-grained sand, very dense, very moist to wet	
51							Water	
52								
53								
54								
55	55	53/6"	6	6	1865		SAND (SW): olive green, medium to coarse-grained sand, very dense, wet	
56								
57								
58								
59		9						
60	60	13	18	14	350		SAND and GRAVEL (SW): olive green, medium to coarse-grained sand, very dense, wet	
		17						

4" diameter  
PVC casing

neat cement

Bentonite

#3 sand

4" diameter PVC  
0.020"-continuous slot screen

**HORIZON ENVIRONMENTAL INC.**

4970 Windplay Drive Suite 5  
El Dorado Hills, California 95762  
(916) 939-2170 -- Fax: (916) 939-2172

Well No. MW-24

Drilling Company: AWA Drilling  
Date Drilled: 12/23/08  
Drilling Method: 10" hollow-stem auger  
Sampling Method: 2" split-spoon

Project No.: 1121.116  
Site: Former Beacon Bulk Plant  
No. 13646  
Location: Chowchilla, CA  
Geologist: Craig Roth

Depth In Feet	Sample Number	Blow Count	Inches Driven	Inches Recovered	PID Reading (ppm)	Sampling Interval	Soil Description/ Comments	Well Construction
60							SAND (SW): continues	#3 sand
61								
62								
63								
64							SILTY SAND (SM): olive brown, medium to fine-grained	
65	65	54/6"	6	6	42		sand, very dense, very moist	
66								
67								
68								
69							CLAY (CL): olive green-brown, medium plasticity, hard, moist	
70	70	30 50/3"	9	7	11			
71							Total Depth = 70 feet	
72							Well Casing to 68 feet	
73								
74								
MW-24: Page 3 of 3



JOB 10101  
LOG DESIGNATION  
WELL # 1


Date: March 29 & 30, 1994  
Logged by: Norman Hanson  
Elevation: Bench Mark assumed Elev. 100.00  
Equipment: 8 inch auger with 4 inch hollow stem

Depth Feet	Blows per 6 inches	U S C	Soil Description	Notes
0				
5				
10	33		brown sandy clay	PID meter 160 mg/kg *
15	21		brown sand	PID meter 9700 mg/kg *
20	20		brown sand coarse	PID meter 825 mg/kg *
25	15		brown sand	PID meter 60 mg/kg *
30	29		brown sandy clay	PID meter 80 mg/kg *
35	22		brown sandy clay	PID meter 1500 mg/kg *
40	23		brown sand	PID meter 220 mg/kg *
45	22		brown sand	PID meter 320 mg/kg *
50	23		brown sandy clay	PID meter 2330 mg/kg *
55	14		brown sandy clay	PID meter 960 mg/kg *
60	11		silty sandy clay very wet	PID meter 60 mg/kg *
65	15		brown sandy clay water	PID meter 275 mg/kg *
70	25		silty sandy clay water	PID meter 1400 mg/kg *
75	32		silty sandy clay water	PID meter 2100 mg/kg *

filled hole with clean sand up to 68 ft. below the surface placed in the hole 20 ft. of perforated 2 inch PVC pipe starting at the bottom and then at the top of the perforated pipe added 48 ft. of blank 2 inch PVC pipe. Filled the hole with clean sand around the perforated pipe up 21 ft. from the bottom at 47 ft below the surface then placed in the hole 3 ft. of bentonite the remainder of the hole was filled with cement sand slurry. A metal watertight cover was set into the slurry with the top approximately 6 inches above the surrounding ground surface A water tight locking stopper was placed in the PVC 2 inch pipe.

\* No odor was detected on any of the samples.


BRIDGE DEPARTMENT

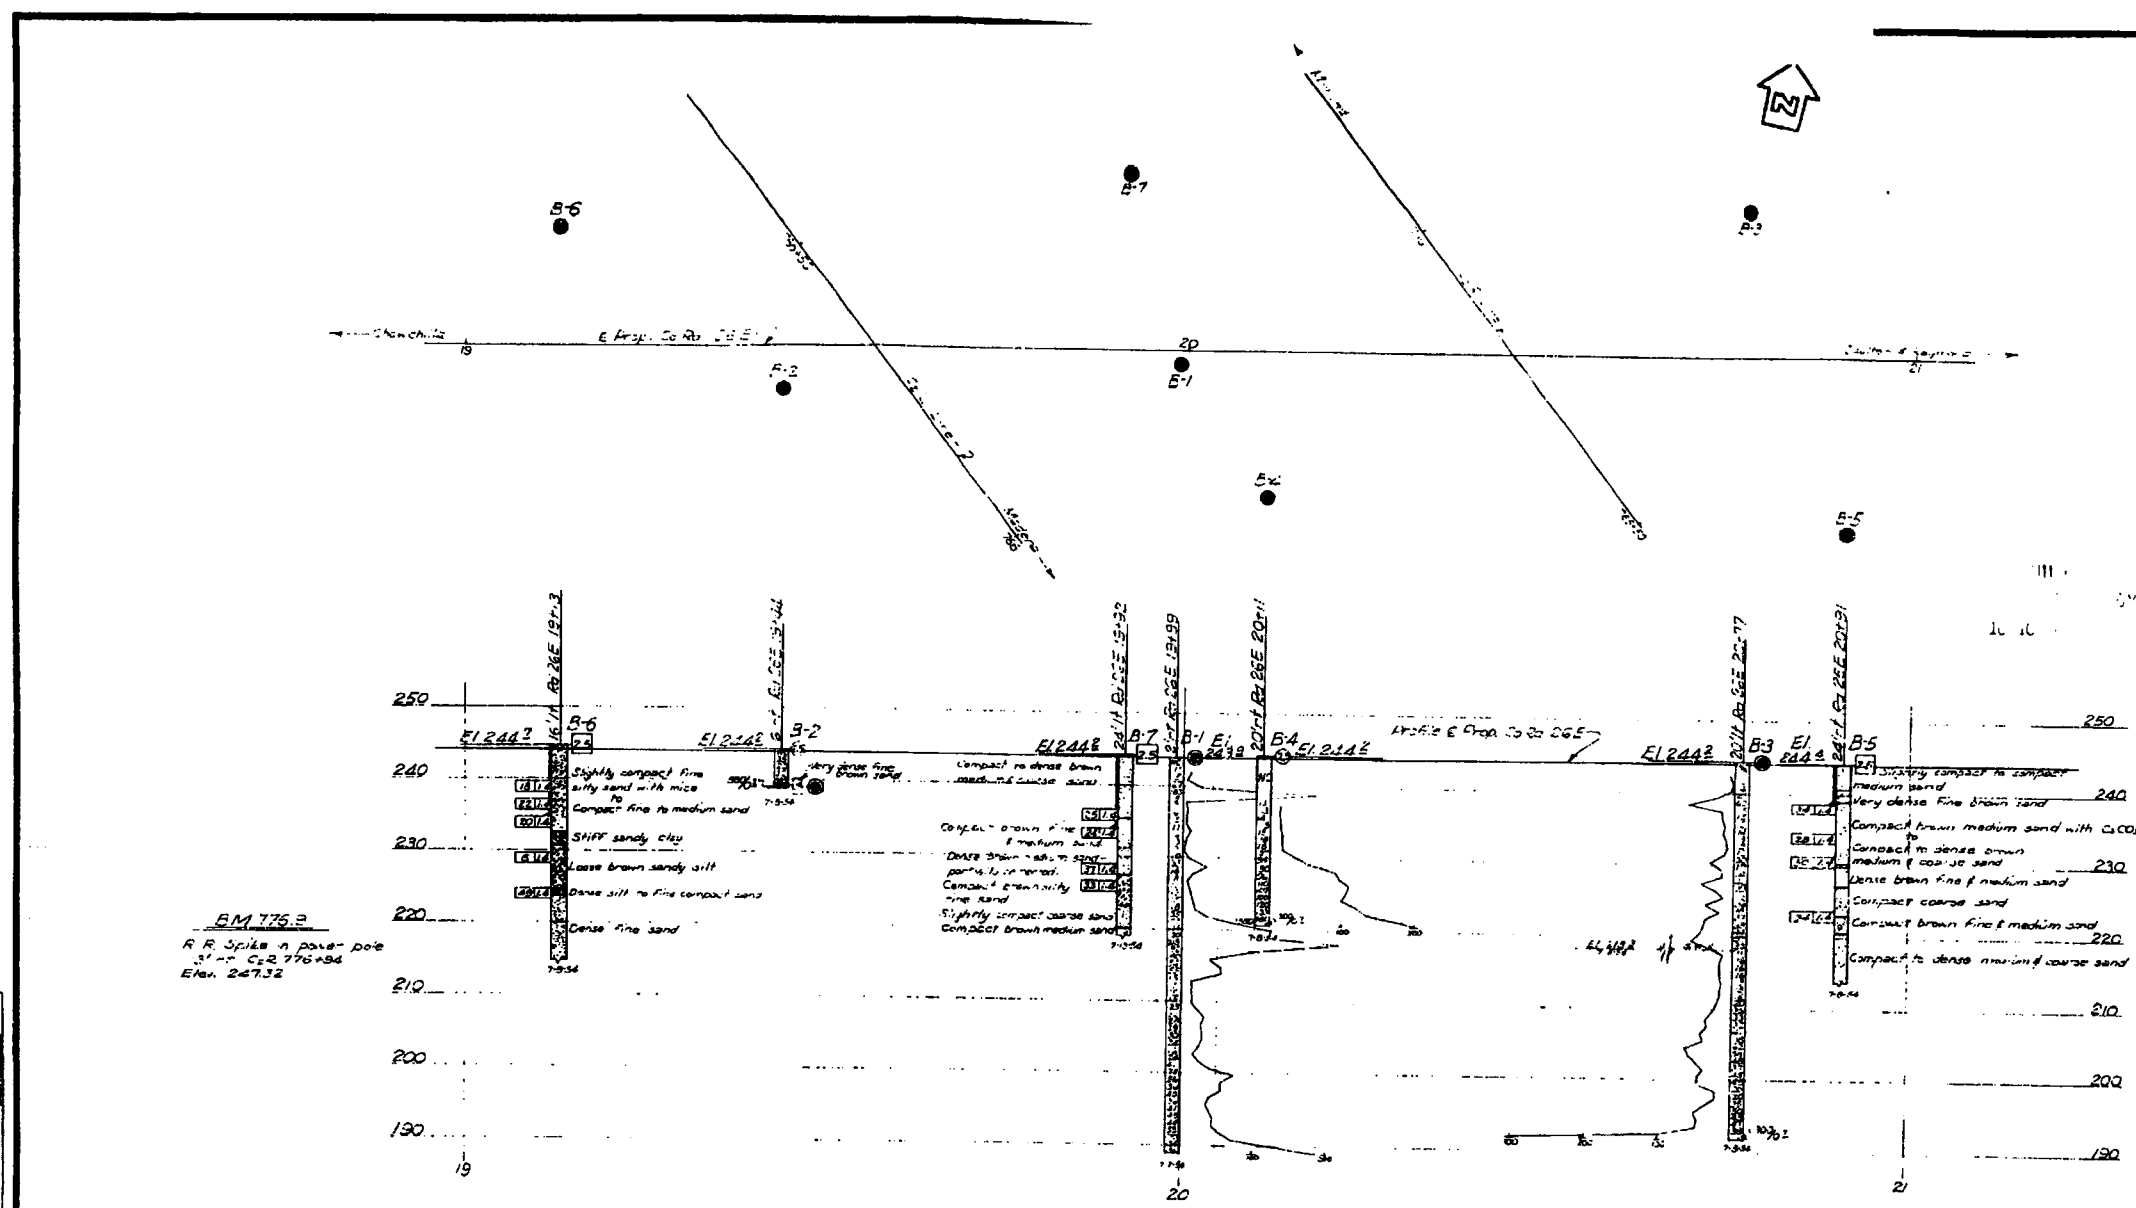

No changes  
J. D. Norberg


**AS BUILT PLANS**  
Contract No. 57-6763  
Date Completed  
Document No. 60000-993

FIELD ENGINEER	J. H. [Signature]
CHECKED	J. H. [Signature]
APPROVED	J. H. [Signature]

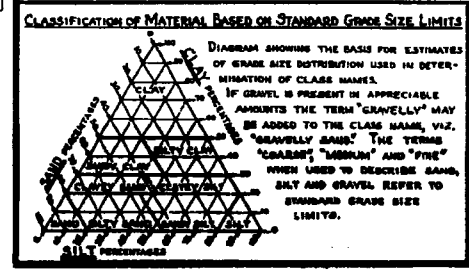

**LEGEND OF EARTH MATERIALS**

GRAVEL	SILTY CLAY OR CLAYEY SILT
SAND	PEAT AND/OR ORGANIC MATTER
SILT	FILL MATERIAL
CLAY	IGNEOUS ROCK
SANDY CLAY OR CLAYEY SAND	SEDIMENTARY ROCK
SANDY SILT OR SILTY SAND	METAMORPHIC ROCK

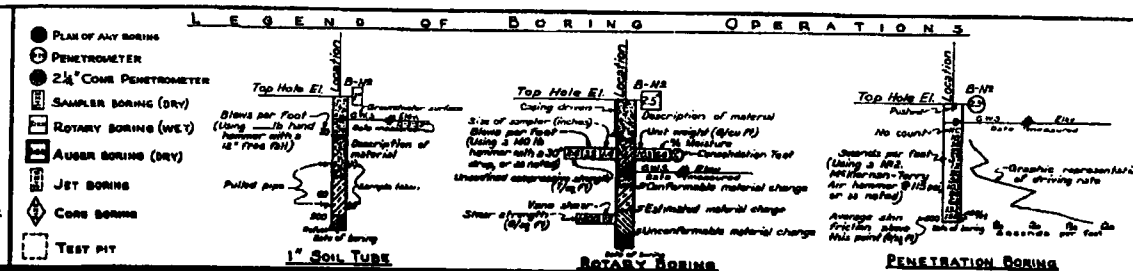

**NOTES**

The contractor's attention is directed to Section 2, Article (1) of the Standard Specifications and to the Special Provisions accompanying this set of plans. Classification of earth material as shown on this sheet is based upon field inspection and is not to be construed to imply mechanical analysis.

STATE OF CALIFORNIA  
DEPARTMENT OF PUBLIC WORKS  
DIVISION OF HIGHWAYS

**ROAD 26E OVERCROSSING**

**LOG OF TEST BORINGS**




SCALE 1" = 10'

DRILLS 41-55

FILES E-44

DRILLING 67-478-12



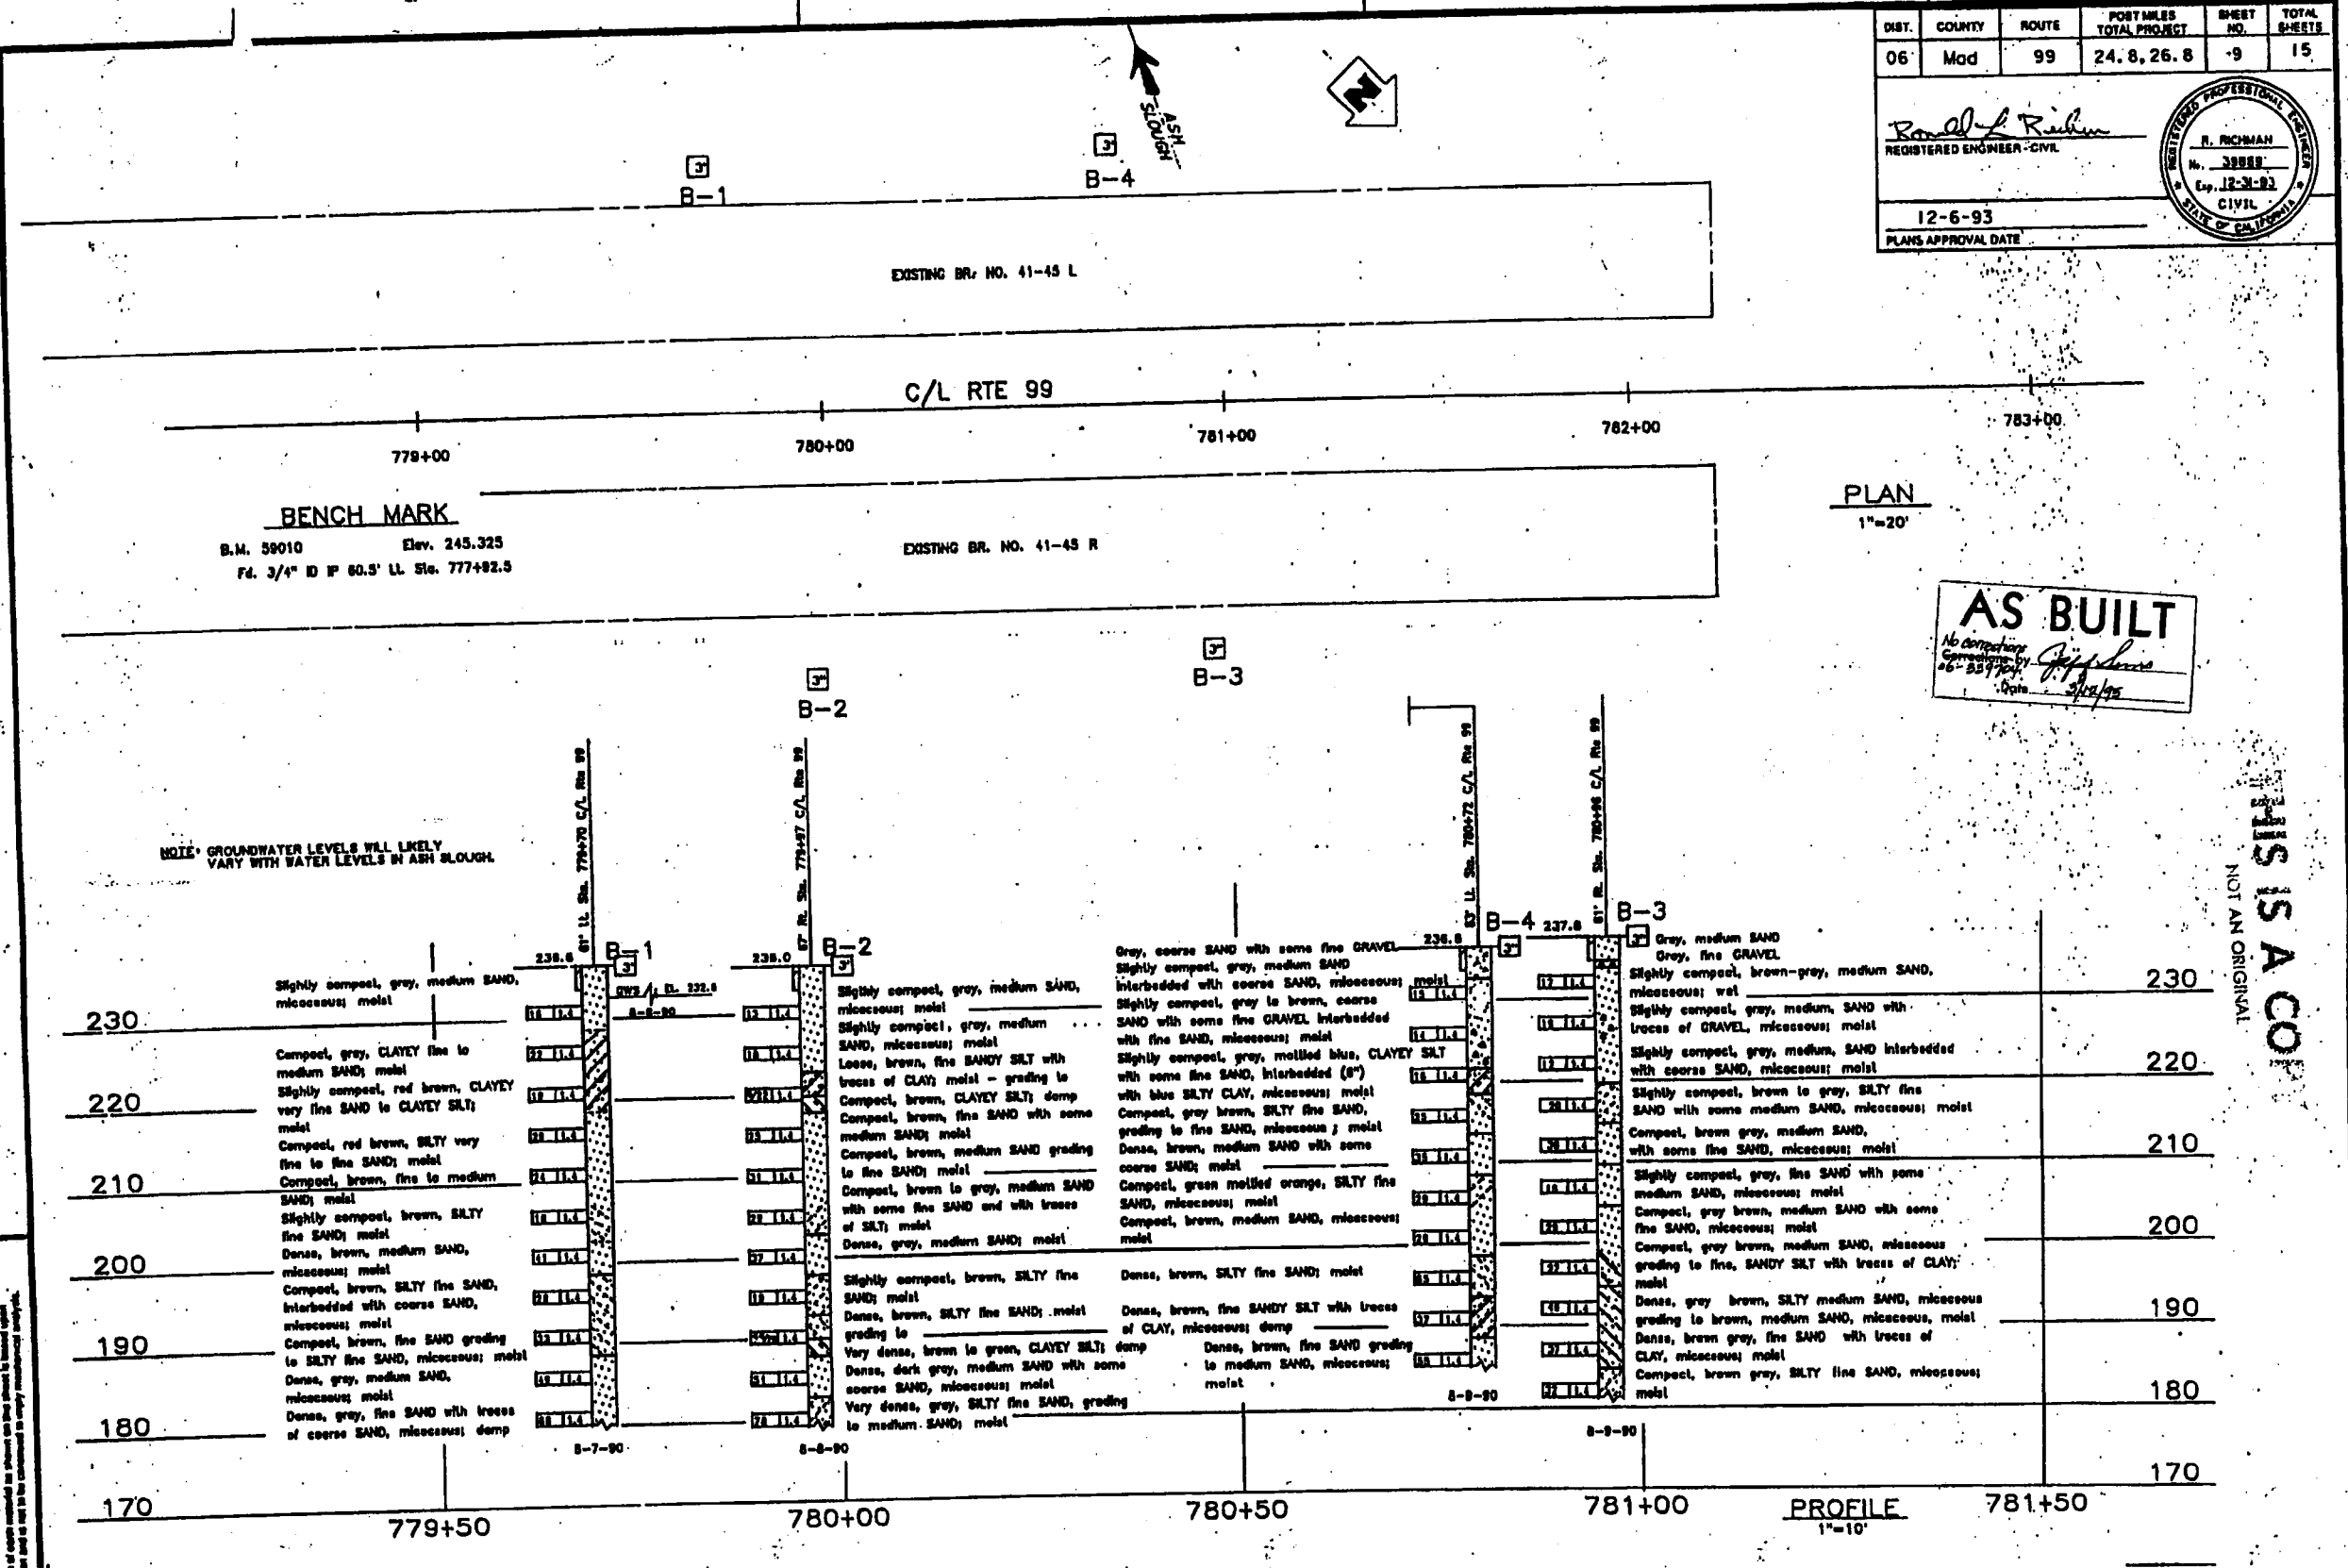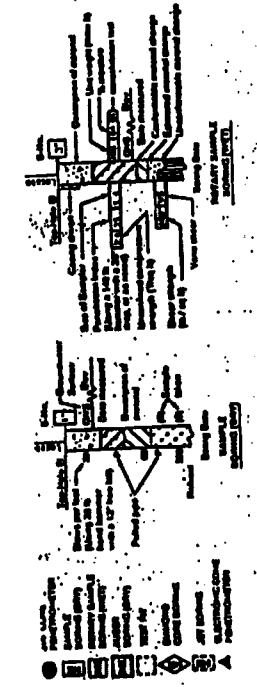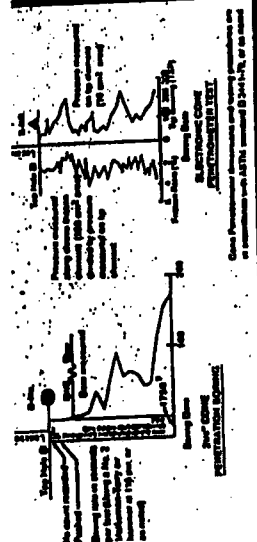

DIST.	COUNTY	ROUTE	POST MILES TOTAL PROJECT	SHEET NO.	TOTAL SHEETS
06	Mad	99	24.8, 26.8	9	15

*Ronald L. Richman*  
REGISTERED ENGINEER - CIVIL  
No. 39888  
Exp. 12-31-93  
CIVIL  
STATE OF CALIFORNIA


12-6-93  
PLANS APPROVAL DATE


**AS BUILT**  
No corrections  
06-23-93  
Date: 2/2/93

THIS IS A COPY  
NOT AN ORIGINAL

ENGINEERING GEOLOGY BRANCH - TRANSPORTATION LABORATORY			State of CALIFORNIA DEPARTMENT OF TRANSPORTATION		DIVISION OF STRUCTURES STRUCTURE DESIGN 9		BRIDGE NO. 41-45R/L POST MILE 26.8		ASH SLOUGH BRIDGE (STRENGTHEN) LOG OF TEST BORINGS 1 OF 2	
DRAWN BY	ED FONG	8/90	PROJECT ENGINEER	<i>[Signature]</i>	CU 08100	EA 225101	PREPARED BY	REVISION DATES	PRELIMINARY DATES	SHEET
CHECKED BY	RLR	9/90								2

ORIGINAL SCALE IN INCHES FOR REDUCED PLANS

DIST	COUNTY	ROUTE	POST MILES TOTAL PROJECT	SHEET NO. TOTAL SHEET
06	Mad	99	24.8, 26.8	10 15
ENGINEERING GEOLOGY BRANCH - TRANSPORTATION LABORATORY				
 RONALD J. RUSHIN - CIVIL				
ASH SLOUGH				
12-6-93		LOG OF TEST BORINGS - 2 & 2		
PLANS APPROVAL DATE		CH: 00 EA: 282401		RMDS: 15 41-45, PA.

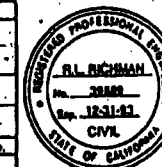


**NOTE**  
THIS LOG OF TEST BORINGS IS AVAILABLE ON  
MICROFILM AT OFFICE OF STRUCTURES DESIGN  
SACRAMENTO, CALIFORNIA

BUILT BY W. Chang  
RECEIVED BY J. D. Norberg  
J-10-57


**AS BUILT**  
No corrections  
Corrections by J. J. Jones  
06-339704  
Date 3/12/95

AS BUILT PLANS  
Contract No. 57-6763  
Date Completed \_\_\_\_\_  
Document No. 60000 PPS

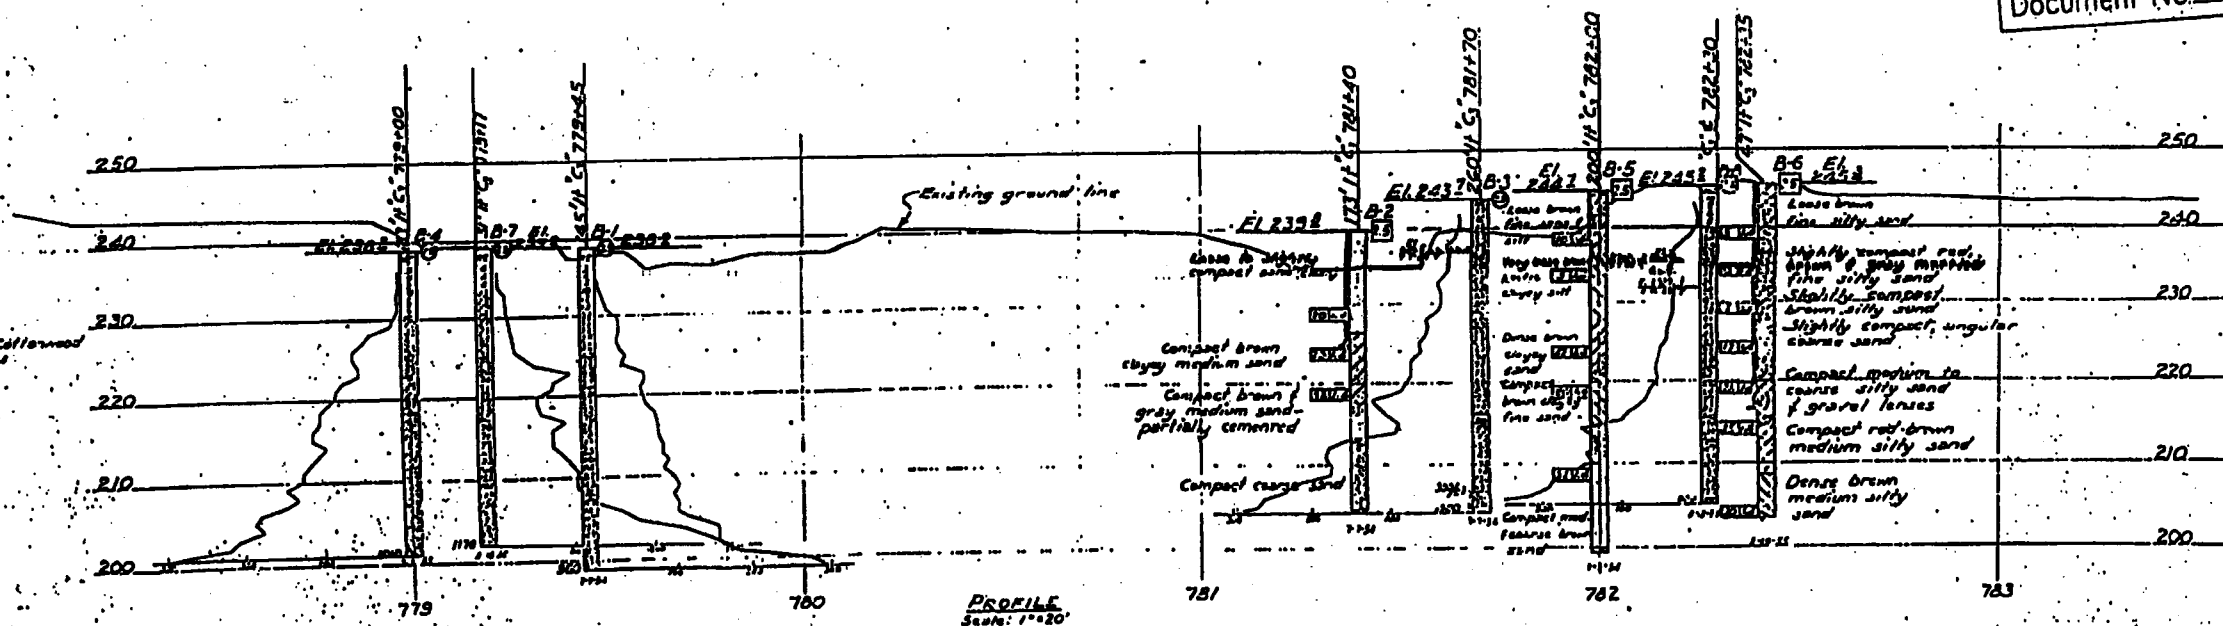





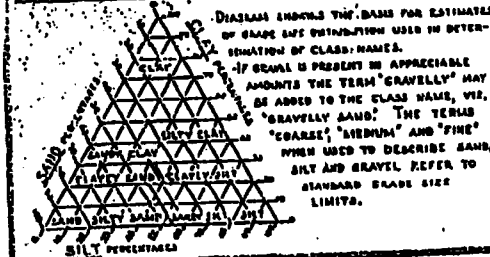







THIS IS A COPY  
NOT AN ORIGINAL


### CLASSIFICATION OF MATERIAL BASED ON STANDARD GRADE SIZE LIMITS



### LEGEND OF EARTH MATERIALS

 GRAVEL	 SILTY CLAY OR CLAYEY SILT
 SAND	 PEAT AND/OR ORGANIC MATTER
 SILT	 FILL MATERIAL
 CLAY	 IGNEOUS ROCK
 SANDY CLAY OR CLAYEY SAND	 SEDIMENTARY ROCK
 SANDY SILT OR SILTY SAND	 METAMORPHIC ROCK

# LEGEND OF BORING OPERATION

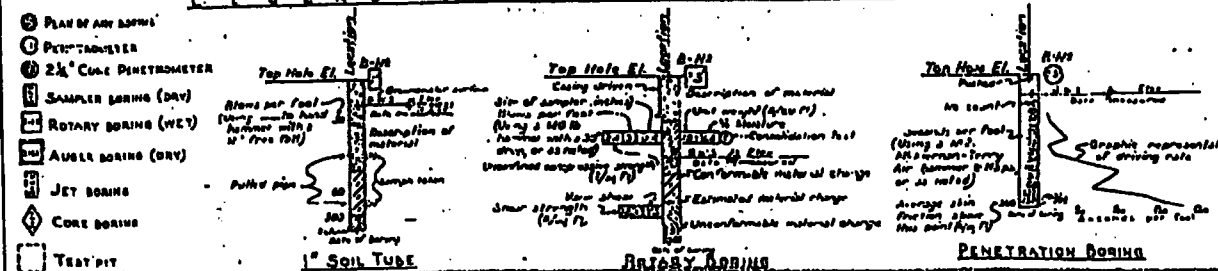

## NOTES

The contractor's attention is directed to Section 2, Article (c) of the Standard Specifications and to the Special Provisions accompanying this set of plans.

**ASH SLOUGH BRIDGE (STRENGTHEN)**

LOG OF TEST BORINGS 2 of 2


SCALE As shown	BIDGE 41-45%	FILE E-1	DRAWING 3396-2
----------------	--------------	----------	----------------

Street No. 5 of 5


PR-3398-5



DIST.	COUNTY	ROUTE	POST MILES TOTAL PROJECT	SHEET NO.	TOTAL SHEETS
06	Mad	99	23.1/26.9	54	55
REGISTERED ENGINEER - CIVIL			R. RICHMAN No. 39869 Exp. 12-31-93 CIVIL STATE OF CALIFORNIA		
4-29-91			PLANS APPROVAL DATE		


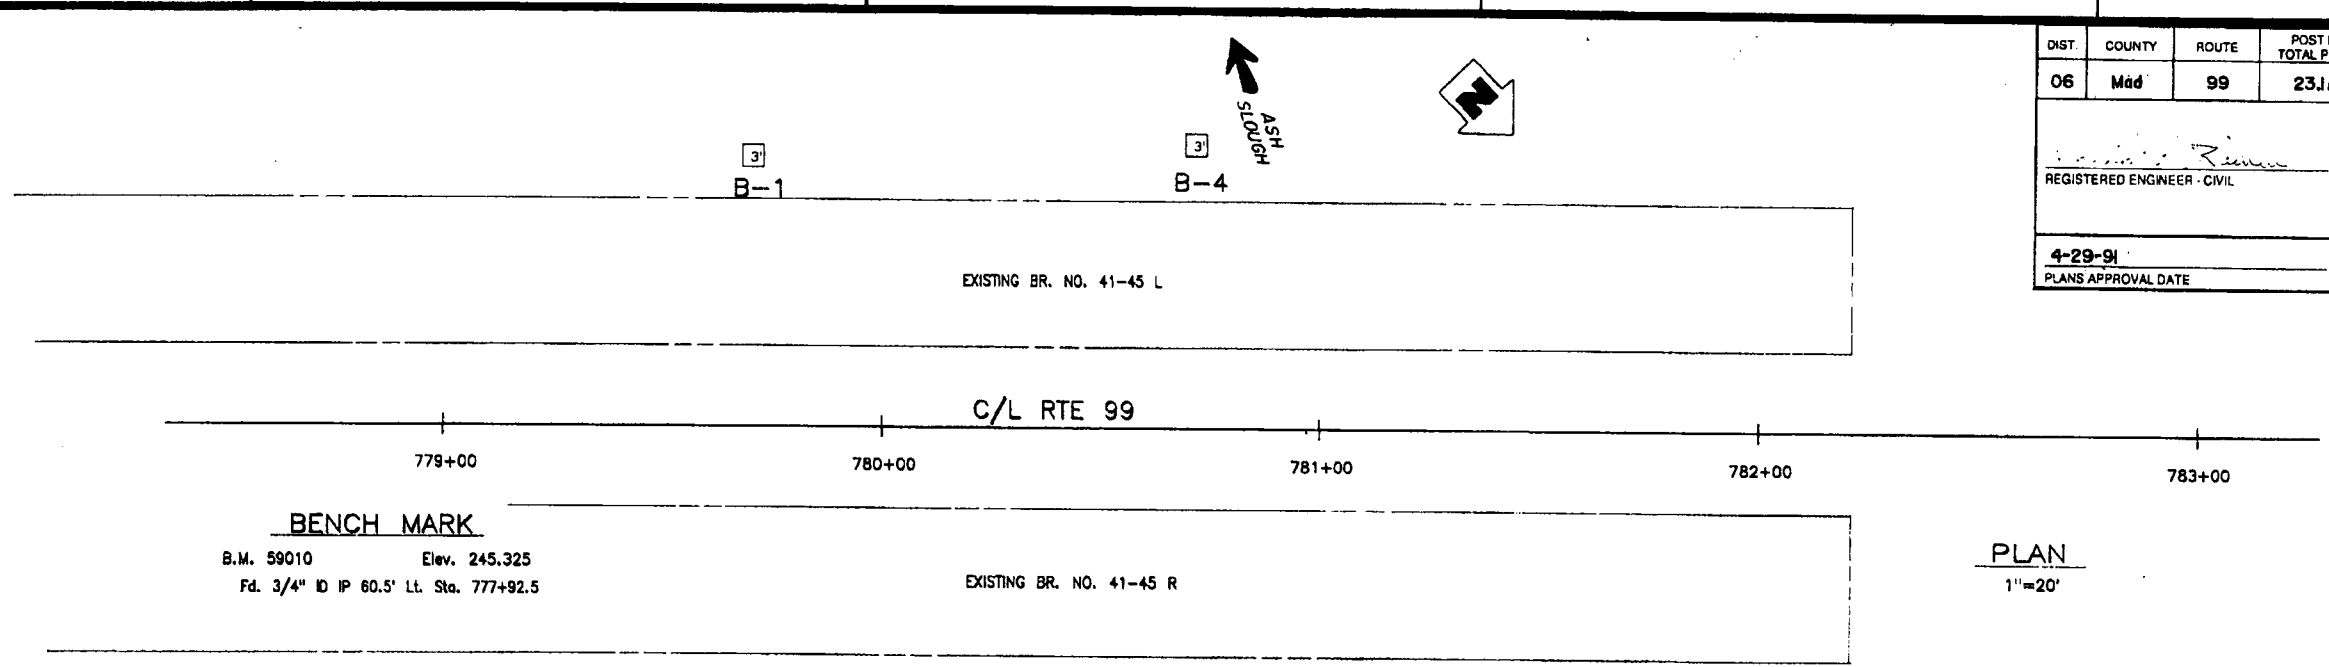


NOTE: GROUNDWATER LEVELS WILL LIKELY VARY WITH WATER LEVELS IN ASH SLOUGH.

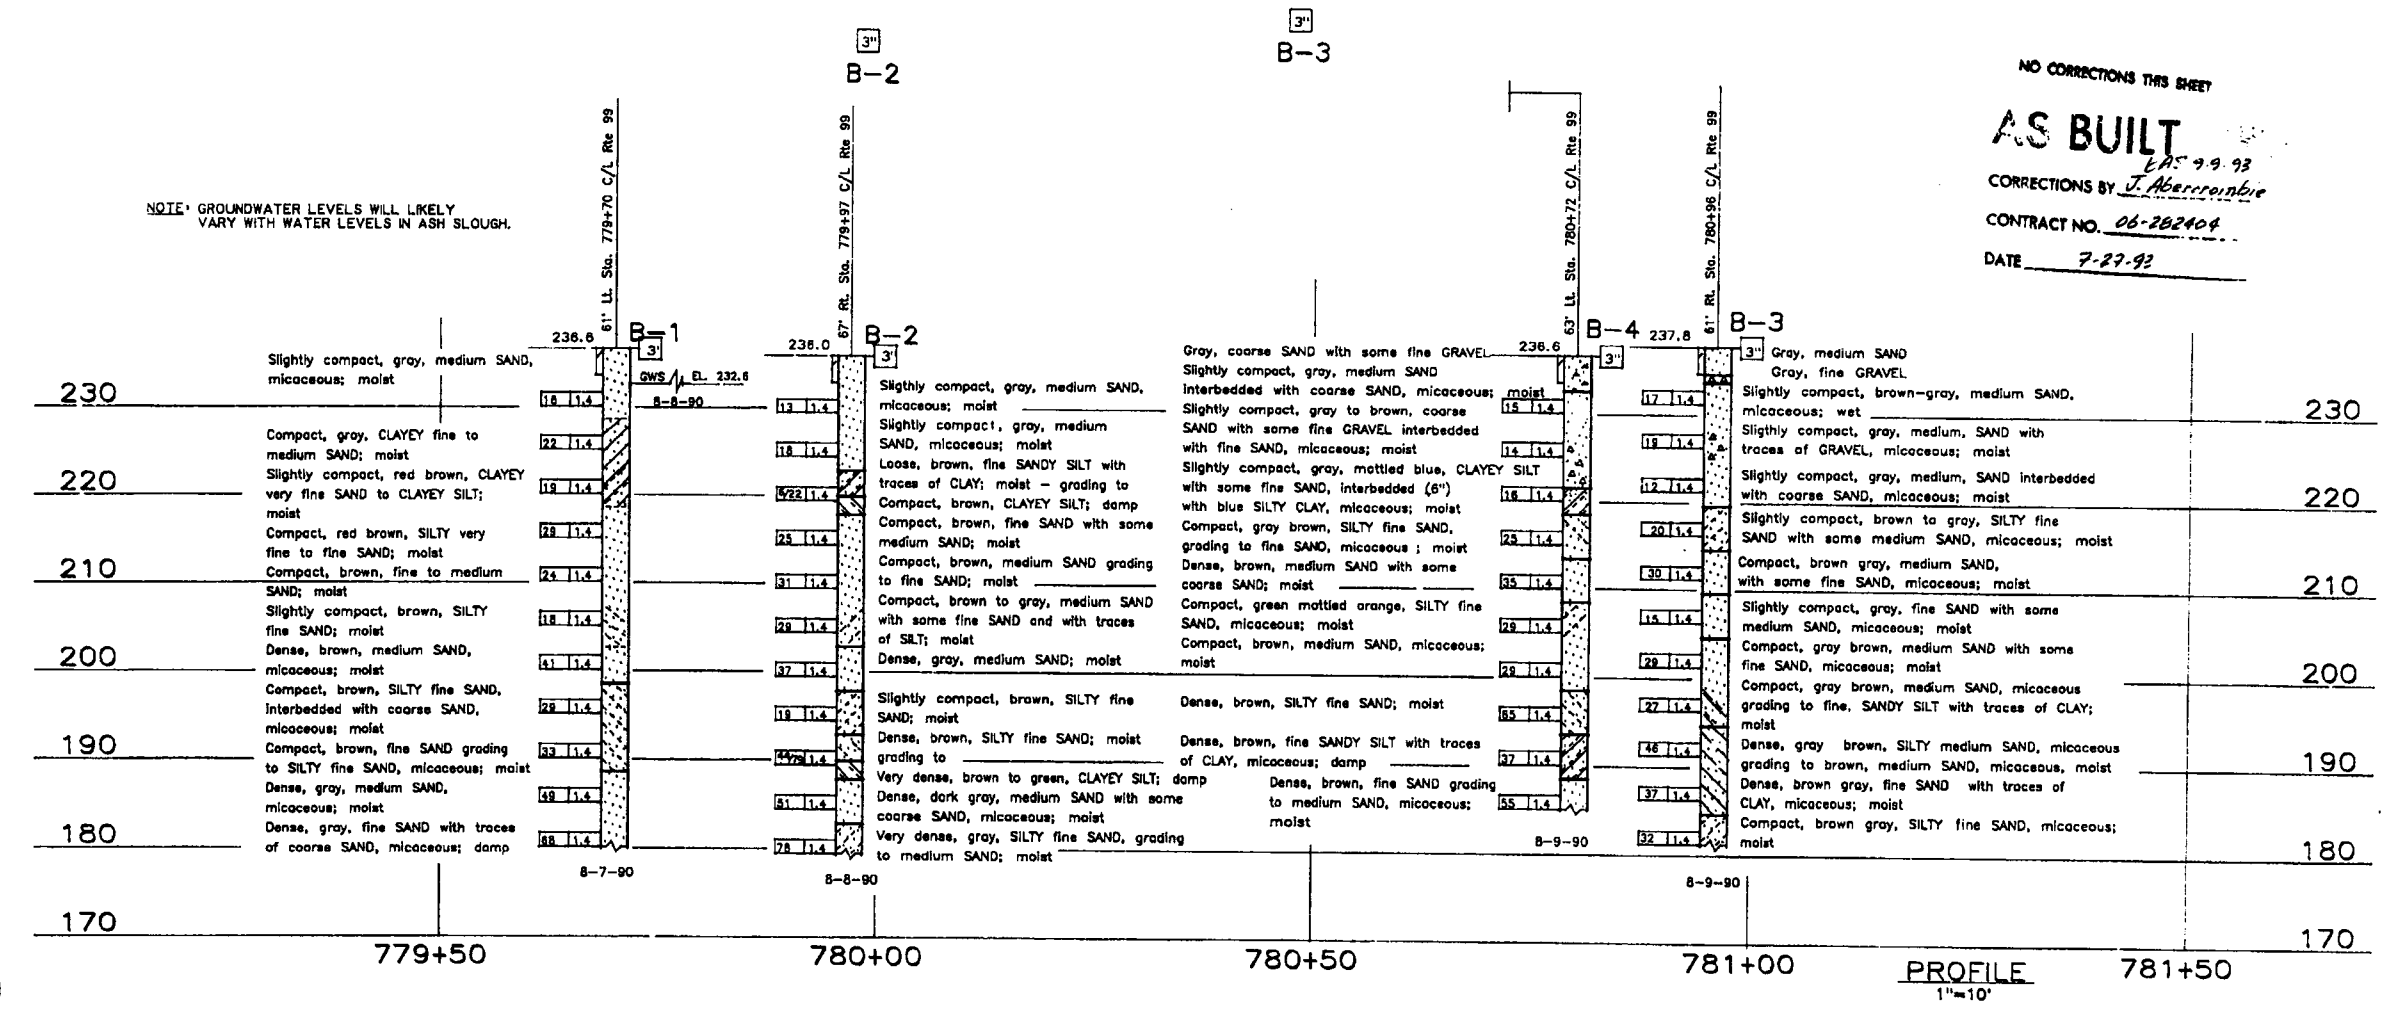

NO CORRECTIONS THIS SHEET  
**AS BUILT**  
CORRECTIONS BY *J. Abernethy*  
CONTRACT NO. 06-282404  
DATE 7-27-92

LEGEND OF BORING OPERATIONS

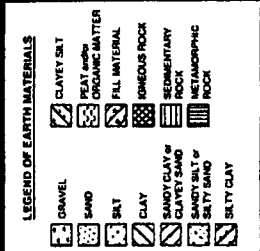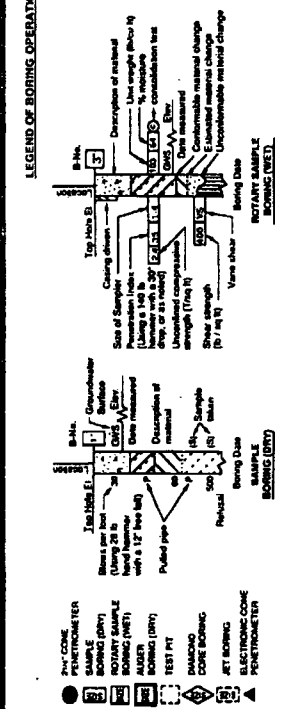

CONSISTENCY CLASSIFICATION FOR SOILS	
According to the Standard Penetration Test	
Penetration Index (Blows / ft)	Consistency
0-4	Very soft
5-9	Soft
10-19	Slightly compact
20-29	Compact
30-39	Very compact
>40	Very dense

NOTE: Classification of earth material as shown on this sheet is based upon field inspection and is not to be construed to imply mechanical analysis.


ENGINEERING GEOLOGY BRANCH - TRANSPORTATION LABORATORY			State of CALIFORNIA DEPARTMENT OF TRANSPORTATION		DIVISION OF STRUCTURES STRUCTURE DESIGN		BRIDGE NO. 41-45R/L		ASH SLOUGH BRIDGE (WIDEN)	
DRAWN BY ED FONG 8/90			PROJECT ENGINEER				POST MILE		LOG OF TEST BORINGS 1 OF 2	
CHECKED BY [Signature]										
ORIGINAL SCALE IN INCHES FOR REDUCED PLANS					CU 06 EA 282401		DISREGARD PRINTS BEARING EARLIER REVISION DATES		REVISION DATES (PRELIMINARY STAGE ONLY)	

DIST.	COUNTY	ROUTE	POST MILE-TOTAL PROJECT	SHEET NO.	TOTAL SHEETS
06	Mad	99	23.1/26.9	55	55

Date Approved 4-29-91

NO.	DATE	BY	REVISION
1	4-29-91	J. D. Norberg	Initial


ENGINEERING GEOLOGY BRANCH - TRANSPORTATION LABORATORY  
REGISTERED ENGINEER - CIVIL  
ASH SLOUGH  
LOG OF TEST BORINGS 2-2  
CU: 06  
EA: 282401  
BRIDGE No.  
41-45 RA.

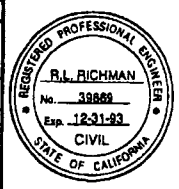



NOTE  
THIS LOG OF TEST BORINGS IS AVAILABLE ON MICROFILM AT OFFICE OF STRUCTURES DESIGN SACRAMENTO, CALIFORNIA

BUILT No changes  
DESIGNED BY J. D. Norberg  
10-77

AS BUILT PLANS  
Contract No. 57-67C3  
Date Completed  
Document No. 600009P3

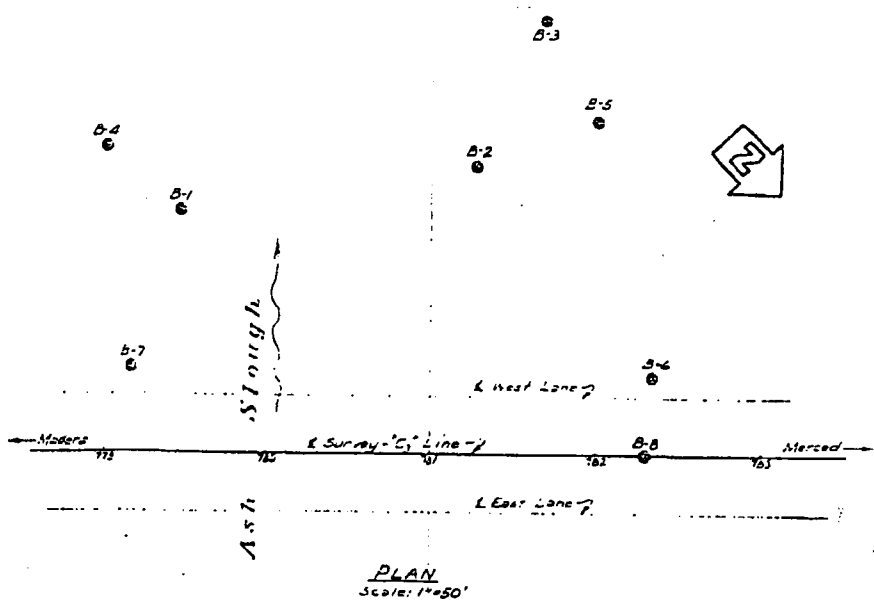

NO CORRECTIONS THIS SHEET  
AS BUILT  
BAS 9-9-93  
CORRECTIONS BY J. Abernethy  
CONTRACT NO. 06-282404  
DATE 7-27-93

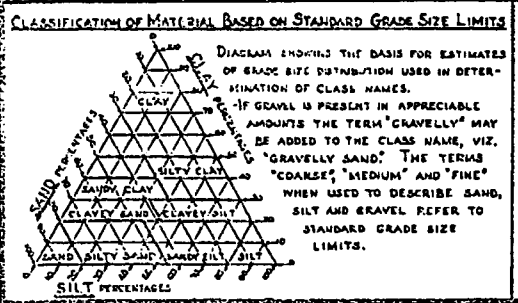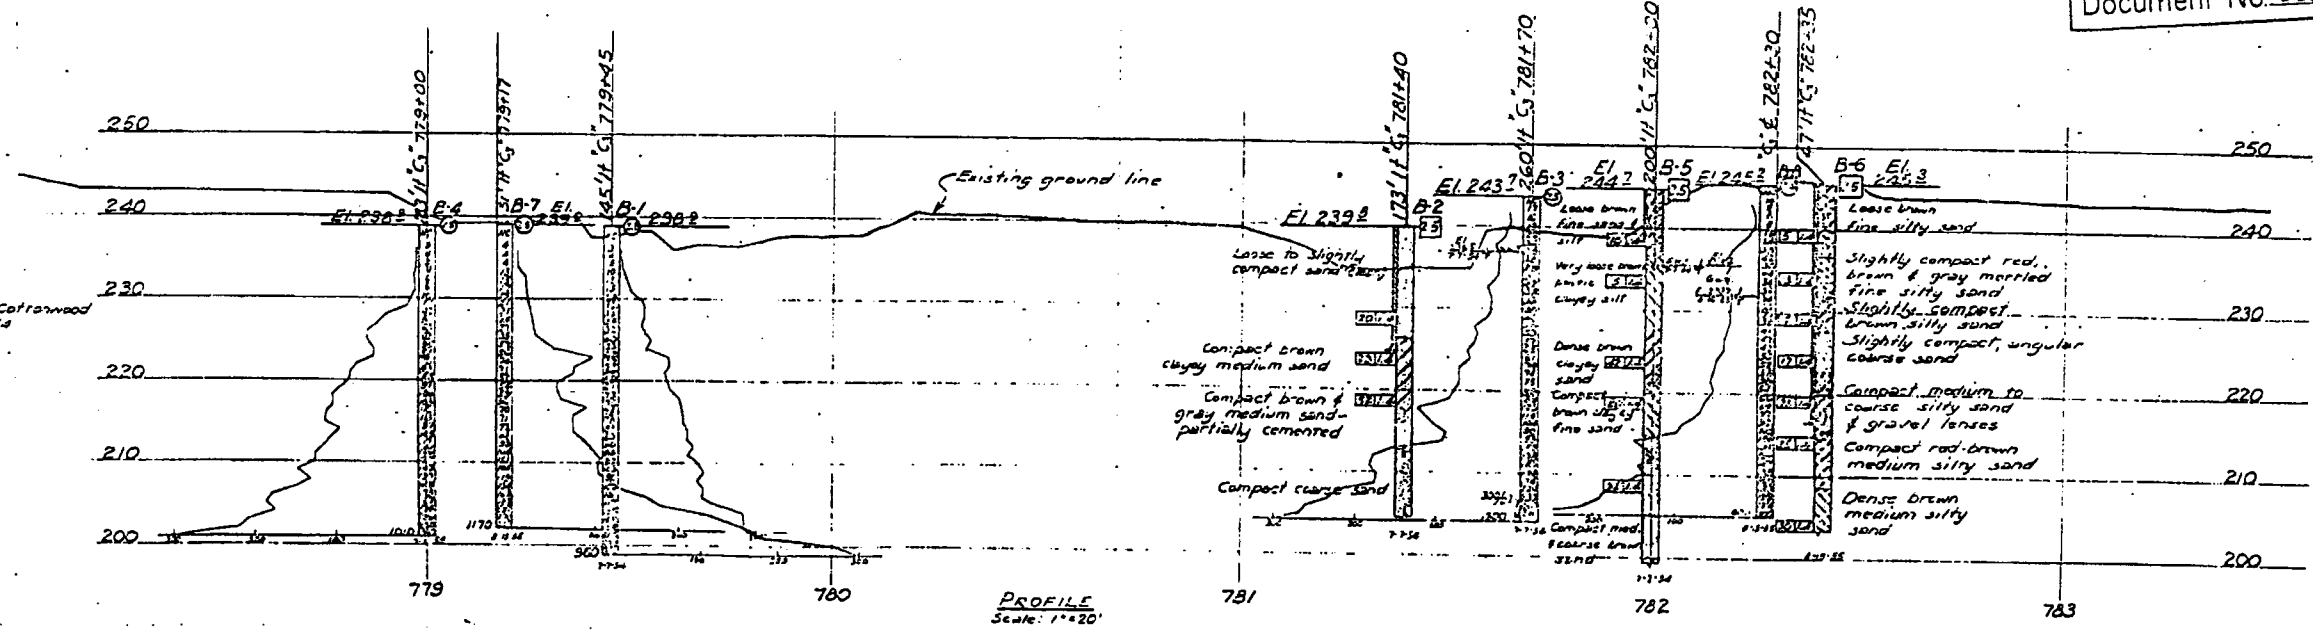

LEGEND OF EARTH MATERIALS

GRAVEL	SILTY CLAY OR CLAYEY SILT
SAND	PEAT AND/OR ORGANIC MATTER
SILT	FILL MATERIAL
CLAY	IGNEOUS ROCK
SANDY CLAY OR CLAYEY SAND	SEDIMENTARY ROCK
SANDY SILT OR SILTY SAND	METAMORPHIC ROCK

LEGEND OF BORING OPERATIONS

PLAN OF ANY BORING  
PENTAMETER  
2 1/2" CONC. PENETROMETER  
SAMPLER BORING (DRY)  
ROTARY BORING (WET)  
AUGER BORING (DRY)  
JET BORING  
CORE BORING  
TEST PIT

1" SOIL TUBE

ROTARY BORING

PENETRATION BORING

NOTES  
The contractor's attention is directed to Section 2, Article (c) of the Standard Specifications and to the Special Provisions accompanying this set of plans.  
Classification of soil, material as shown on this sheet is based upon field inspection and is not to be construed to imply mechanical analysis.

STATE OF CALIFORNIA  
DEPARTMENT OF PUBLIC WORKS  
DIVISION OF HIGHWAYS

ASH SLOUGH BRIDGE (WIDEN)


LOG OF TEST BORINGS 2-2

SCALE AS SHOWN BRIDGE 41-45% FILE E-4 DRAWING C-3396-e

Sheet No. 1 of 11





I HEREBY CERTIFY THAT THIS IS A TRUE AND ACCURATE COPY OF THE ABOVE AND WAS TAKEN UNDER MY SUPERVISION AND CONTROL ON THIS DATE IN SACRAMENTO, CALIFORNIA.



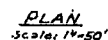

BUILT BY no changes  
CORRECTIONS BY J. D. Norberg  
JUL-10-57

**AS BUILT PLANS**  
Contract No. 57-67C3  
Date Completed \_\_\_\_\_  
Document No. 60000993

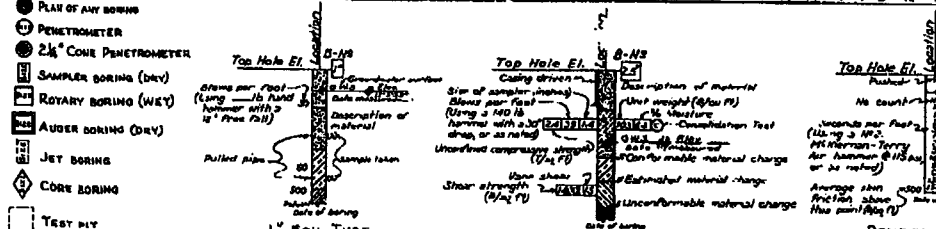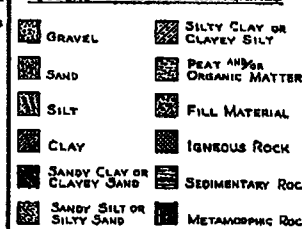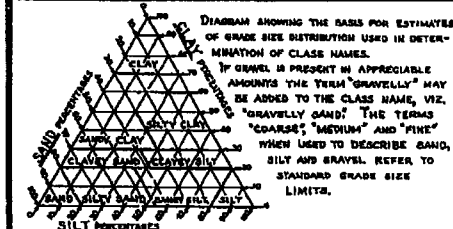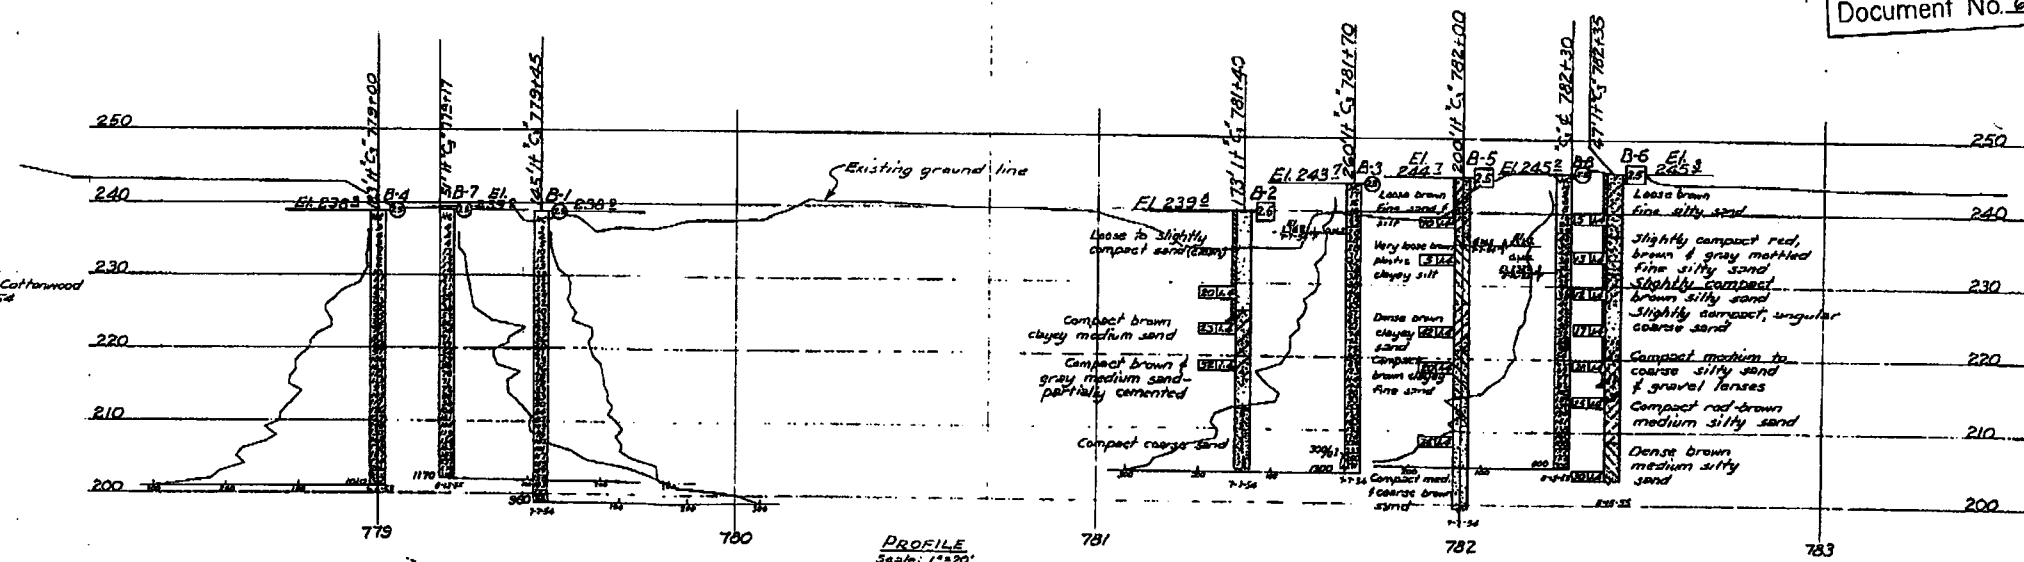

**NOTES**

The contractor's attention is directed to Section 2, Article (c) of the Standard Specifications and to the Special Provisions accompanying this set of plans.

Classification of earth material as shown on this sheet is based upon field inspection and is not to be construed to imply mechanical analysis.

BRIDGE ACROSS ASH SLOUGH

## LOG OF TEST BORINGS


SCALE As shown	BRIDGE 41-45 1/2	FILE F-4	DRAWING C-3-201
----------------	------------------	----------	-----------------

I HEREBY CERTIFY THAT THIS IS A TRUE AND ACCURATE COPY OF THE ABOVE EXHIBIT TAKEN UNDER MY DIRECTION AND CONTROL ON THIS DATE IN SACRAMENTO, CALIFORNIA PURSUANT TO AUTHORIZATION BY THE DIRECTOR OF THE FBI.









DATE 10/1/68 SIGNATURE [Signature] TITLE [Title]


FIELD STUDY	to P 1020-	8-53
DRAWN	to L 1011-	8-53
CHECKED	to R 1010-	9-16-53

Approved & Recommended by: Paul J. Kennedy  
 Special Agent in Charge  
U.S. Dept. of Justice

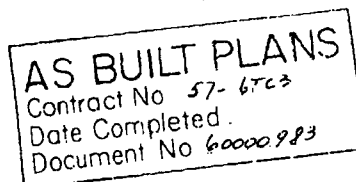




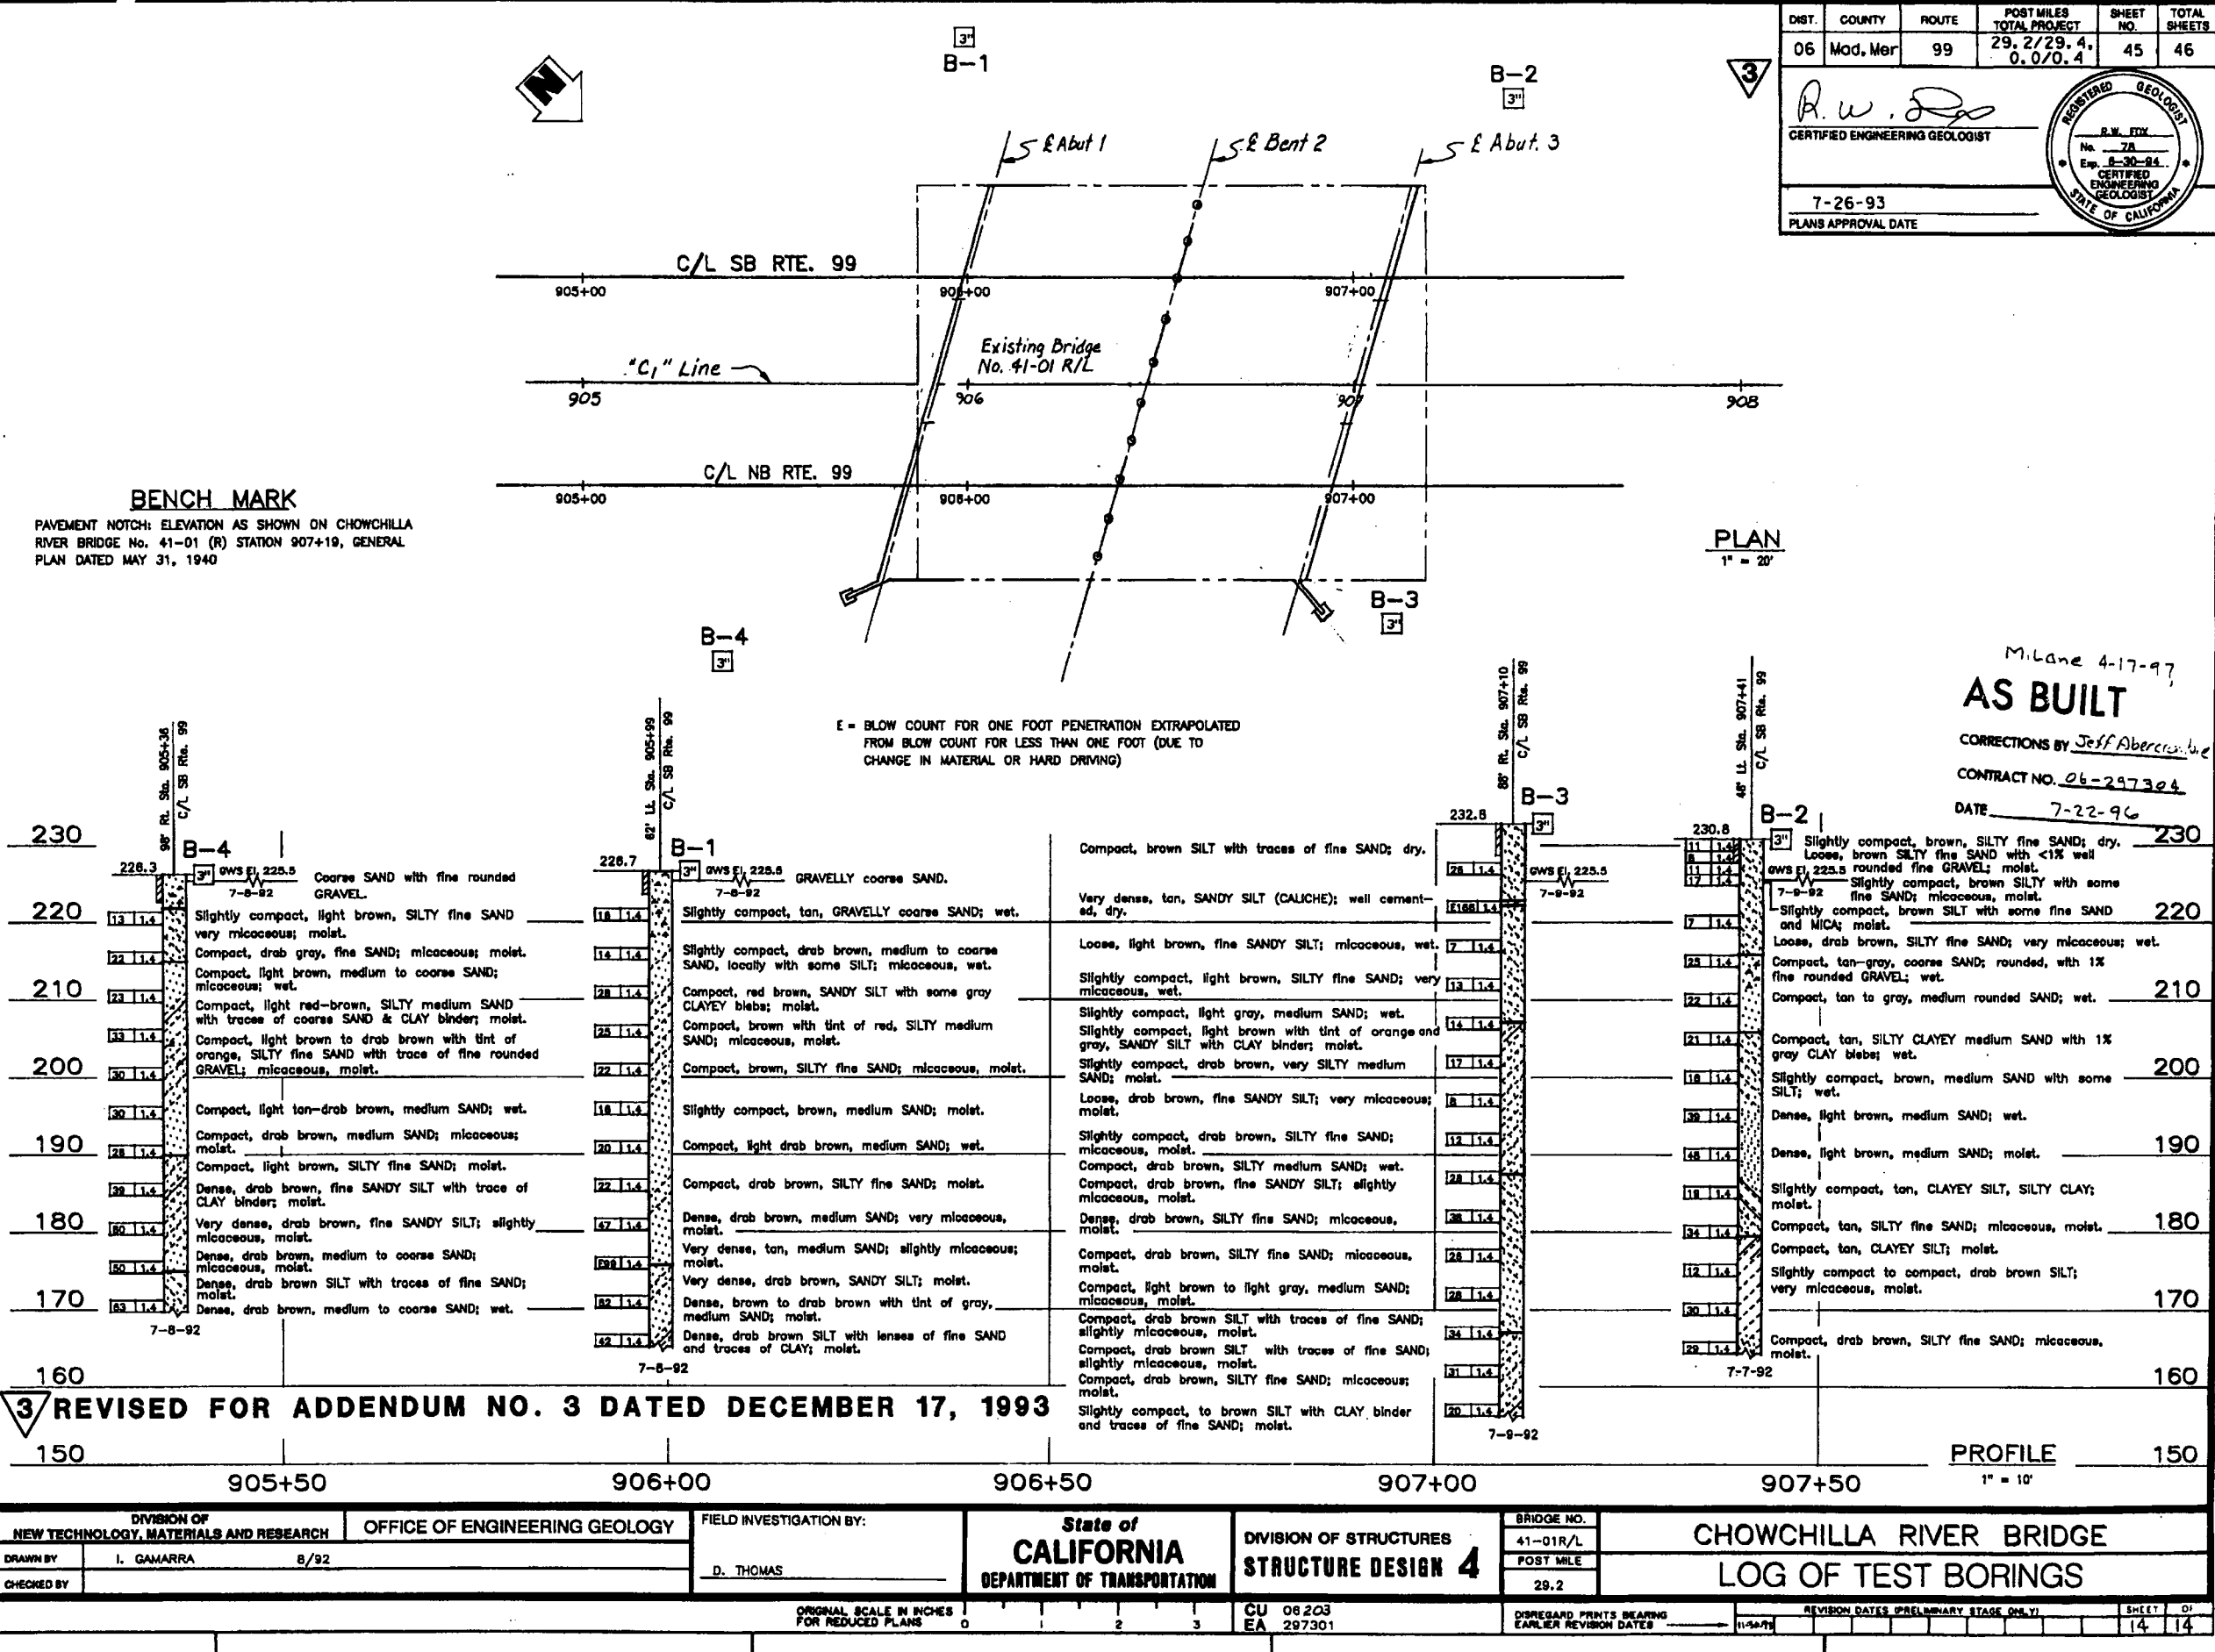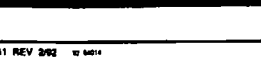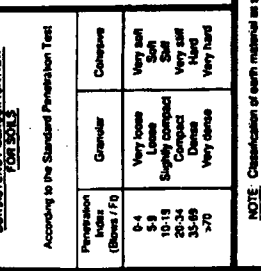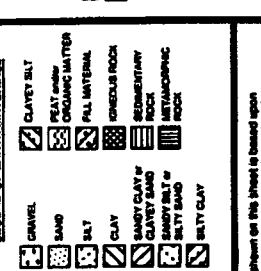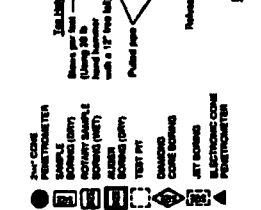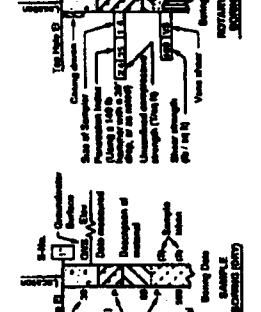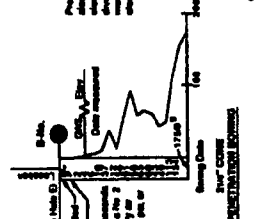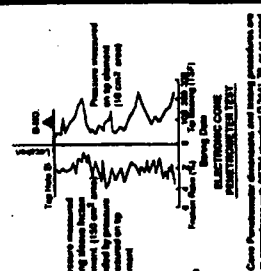

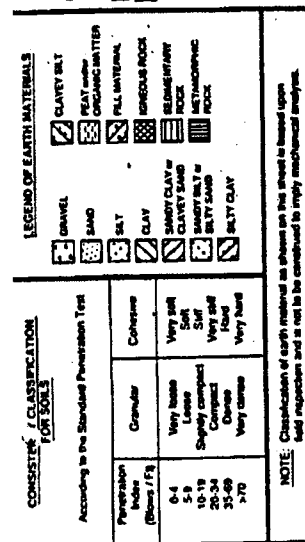

**PLAN**  
**1"=10'-0"**

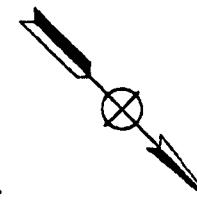

**PROFILE**  
**HOR. 1"=10'-0"**  
**VER. 1"=10'**





<u>Brandon Danks</u> SIGN OVERSTIGHT <u>11-14-91</u> SIGN OFF DATE	DRAWN BY <u>[Signature]</u>	<u>E. Blum</u> FIELD INVESTIGATOR
	CHECKED BY <u>[Signature]</u>	DATE _____

DISREGARD PRINTS BEARING EARLIER REVISION DATES →	REVISION DATES (PRELIMINARY STAGE ONLY)					SHEET	OF
						5	6

PLATE 1



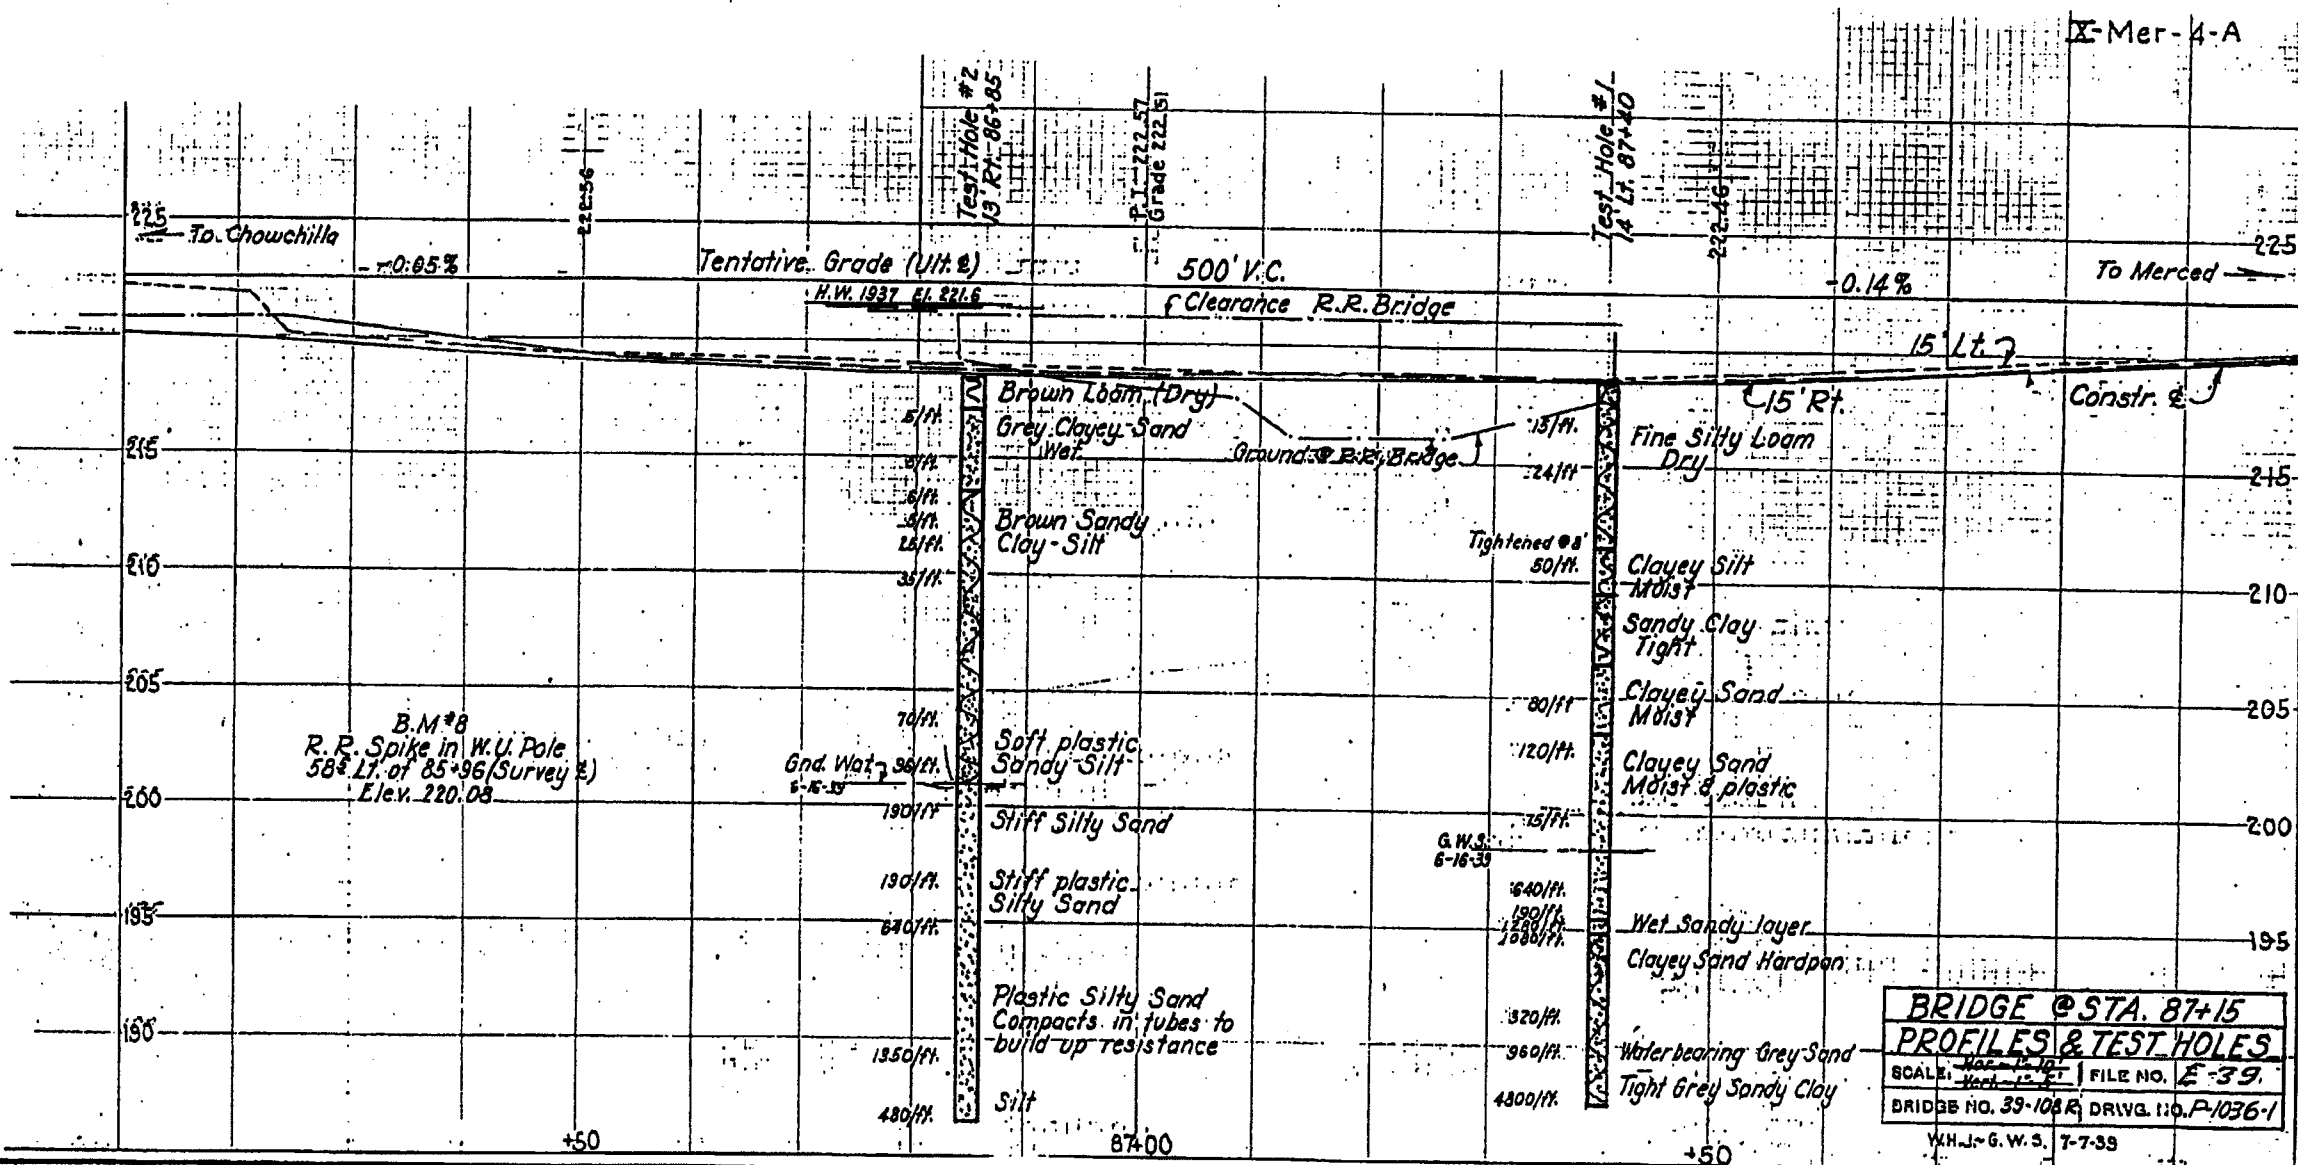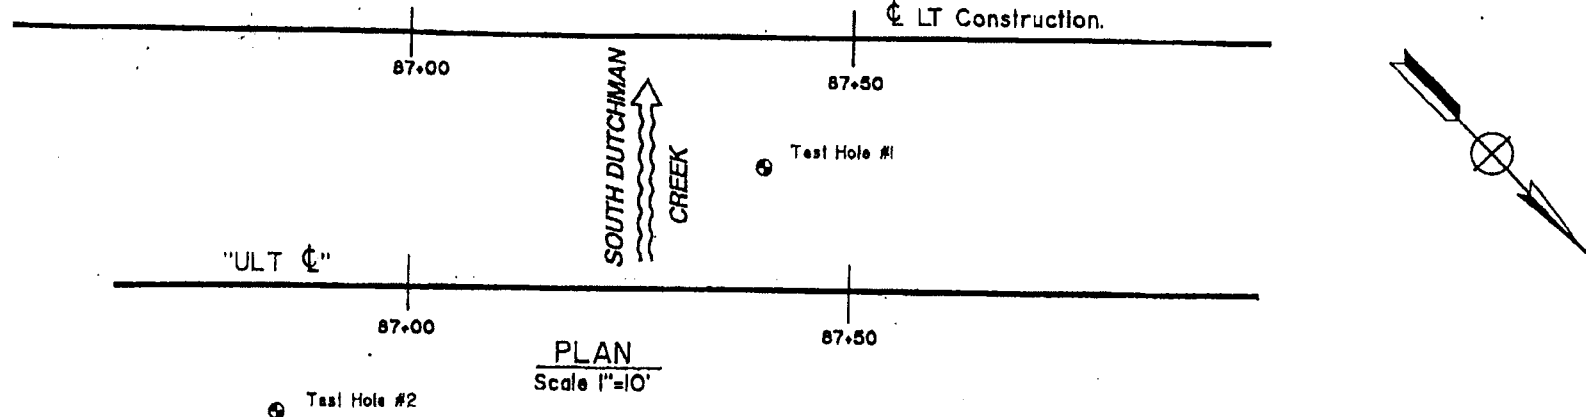


NO AS BUILT CHANGES  
AS BUILT


C.A. MALONEY  
10-380404  
9-9-93

BRIDGE @ STA. 87+15  
PROFILES & TEST HOLES  
SCALE: 1" = 10' FILE NO. E-39  
BRIDGE NO. 39-108L DRIVE 110.P-1036-1  
W.H.J. - G.W.S. 7-7-39

<b>NOTE:</b> ADDITIONAL AS-BUILT FOUNDATION DATA MAY BE AVAILABLE AT THE DIVISION OF NEW TECHNOLOGY, MATERIALS AND RESEARCH 5900 FOLSOM BOULEVARD, SACRAMENTO, CALIFORNIA 95819	DESIGN	BY	CHECKED	PREPARED FOR THE <b>STATE OF CALIFORNIA</b> DEPARTMENT OF TRANSPORTATION	Jeffrey C. Dove PROJECT ENGINEER	BRIDGE NO.	39-108L	SO. DUTCHMAN CREEK - LT BRIDGE (WIDEN)	
	DETAILS	BY	CHECKED			POST MILE	1.85		AS-BUILT LOG OF TEST BORINGS
	QUANTITIES	BY	CHECKED			185			
ORIGINAL SCALE IN INCHES FOR REDUCED PLANS				0 1 2 3	CU 10200 EA 380401	DISREGARD PRINTS BEARING EARLIER REVISION DATES		REVISION DATES (PRELIMINARY STAGE ONLY)	SHEET 6 OF 6

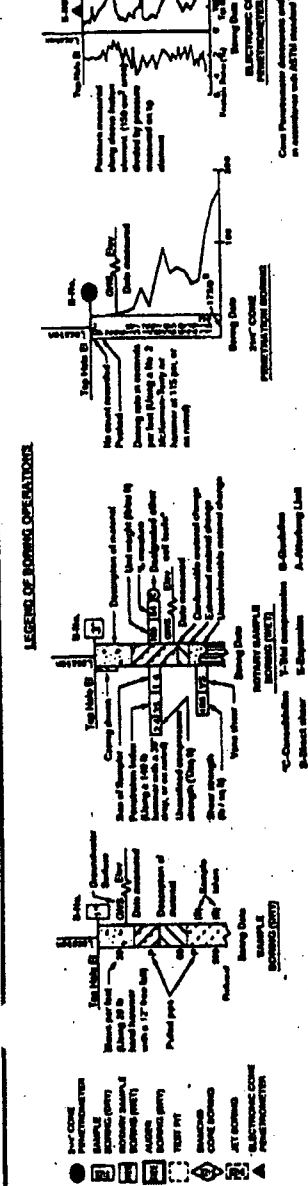


**BENCH MARK**  
ELEV. 222.903  
4.3 miles northwest along the Southern Pacific Company railroad from the station at Chowchilla, in R16E T8S boundary of S10 and S11, 0.2 mile northwest of milepost 164, at U.S. Highway 99 concrete bridge 38-108-R, in the top of the northwest end of the northeast concrete curb, 13 1/2 feet northeast of the center line of the northeast lanes, and about 3 1/2 feet higher than the northeast Highway lanes.

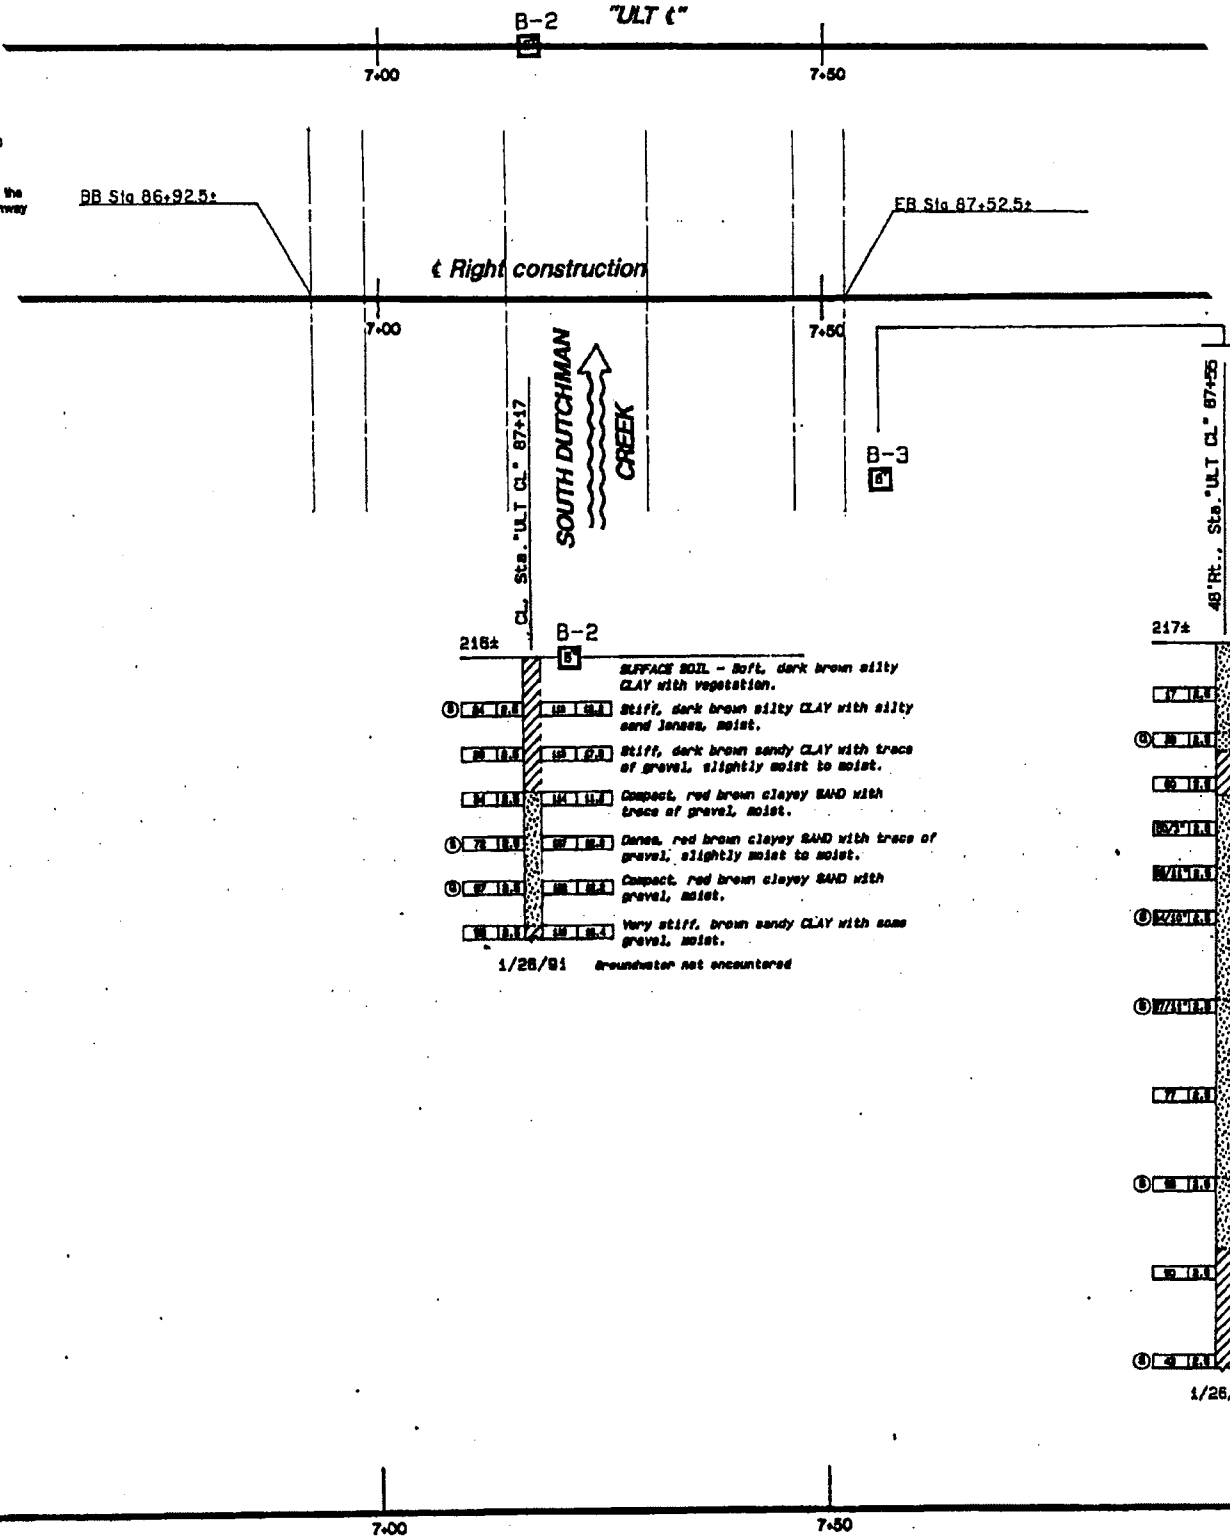

GEOTECHNICAL PROFESSIONAL  
4-20-92  
PLANS APPROVAL DATE  
GARY PAPER  
C.E. 008  
12-3-92  
STATE OF CALIFORNIA  
GEOTECHNICAL

PROFILE  
HOR. 1"=10'-0"  
VER. 1"=10'

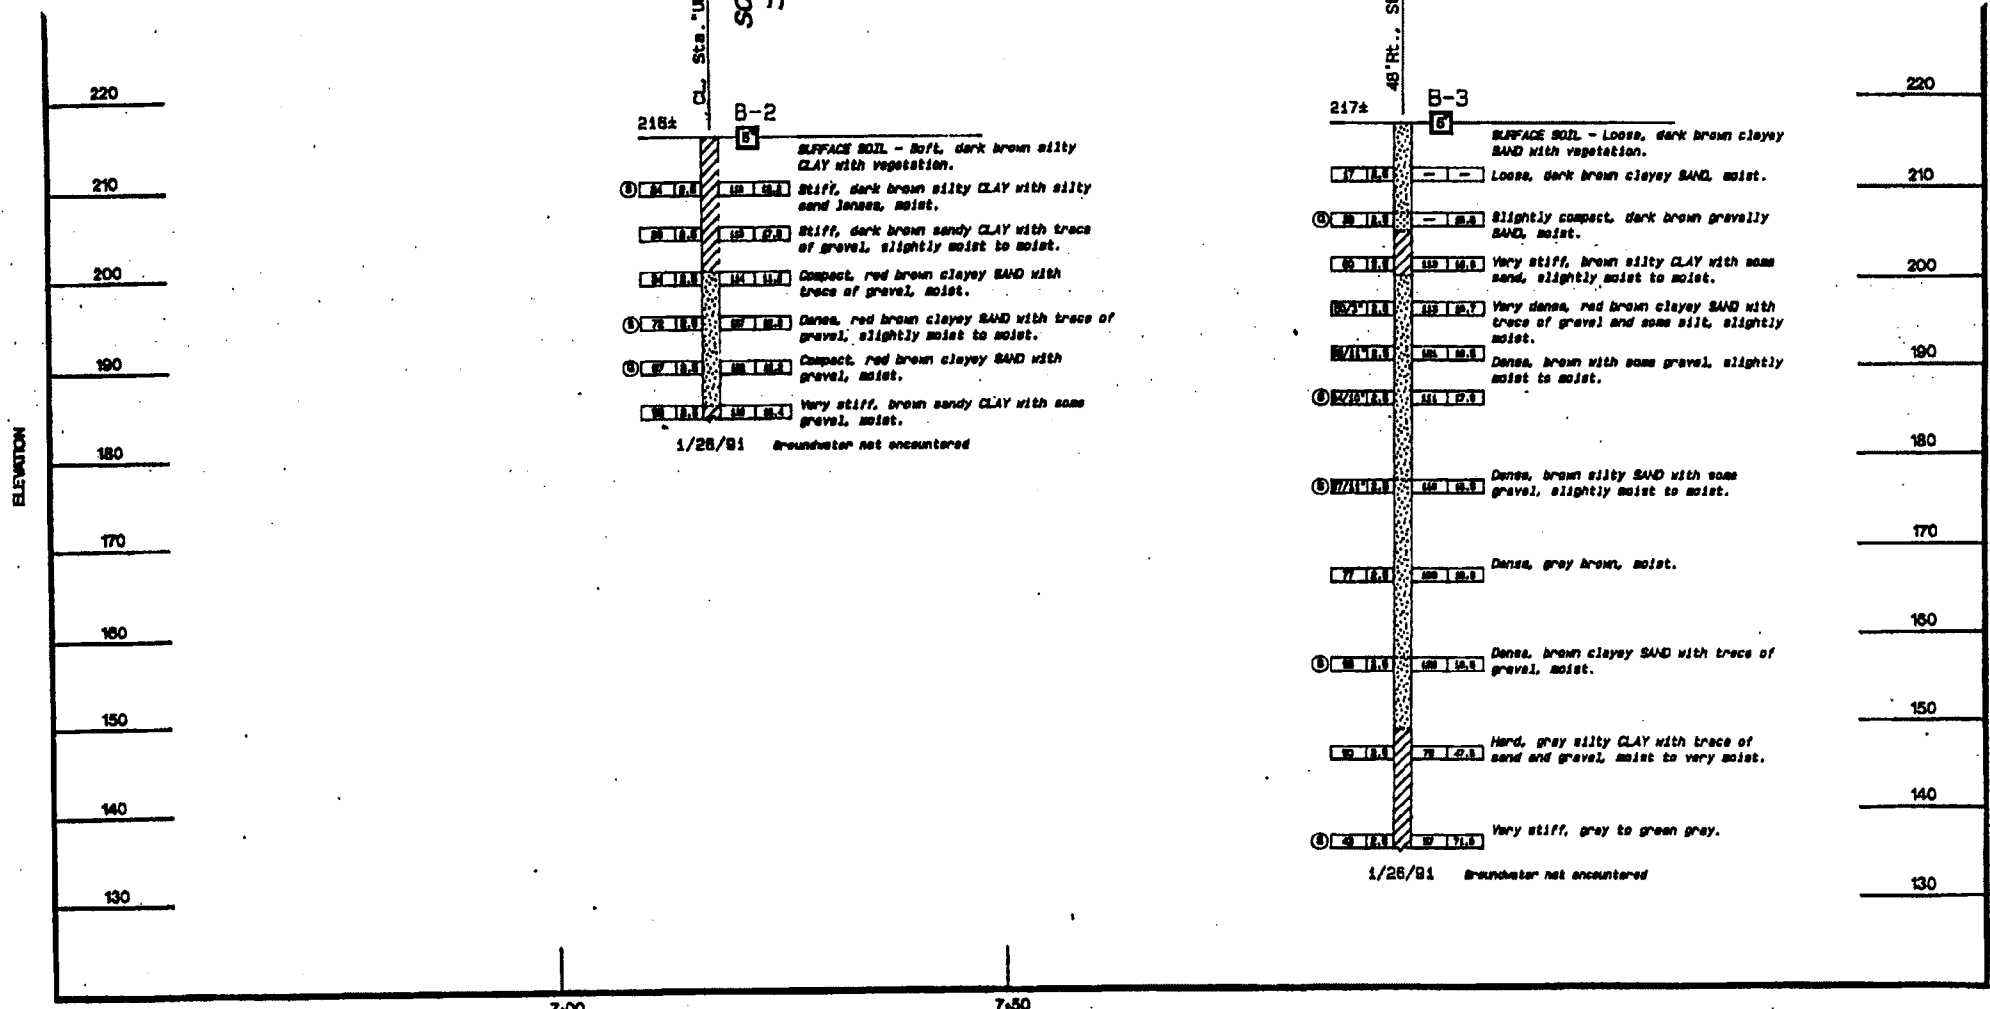

NO AS BUILT CHANGES  
**AS BUILT**



CORRECTIONS BY C.A. MALONEY  
PROJECT NO. 10-380404  
DATE 9-9-93

**LEGEND OF EARTH MATERIALS**  
GRAVEL, SAND, SILT, CLAY, etc.  
**CONSISTENCY CLASSIFICATION**  
According to the Standard Penetration Test  
Cohesion, Penetration, etc.

NOTE: Classification of earth material as shown on this sheet is based upon field inspection and is not to be construed to imply mechanical analysis.

PREPARED FOR THE  
**STATE OF CALIFORNIA**  
DEPARTMENT OF TRANSPORTATION  
BRIDGE NO. 38-108R  
POST MILE 165  
SO. DUTCHMAN CREEK - RT BRIDGE (WIDEN)  
**LOG OF TEST BORINGS**  
CU 10200  
EA 380401  
DISREGARD PRINTS BEARING EARLIER REVISION DATES  
REVISION DATES (PRELIMINARY STAGE ONLY)  
SHEET 6 OF 7



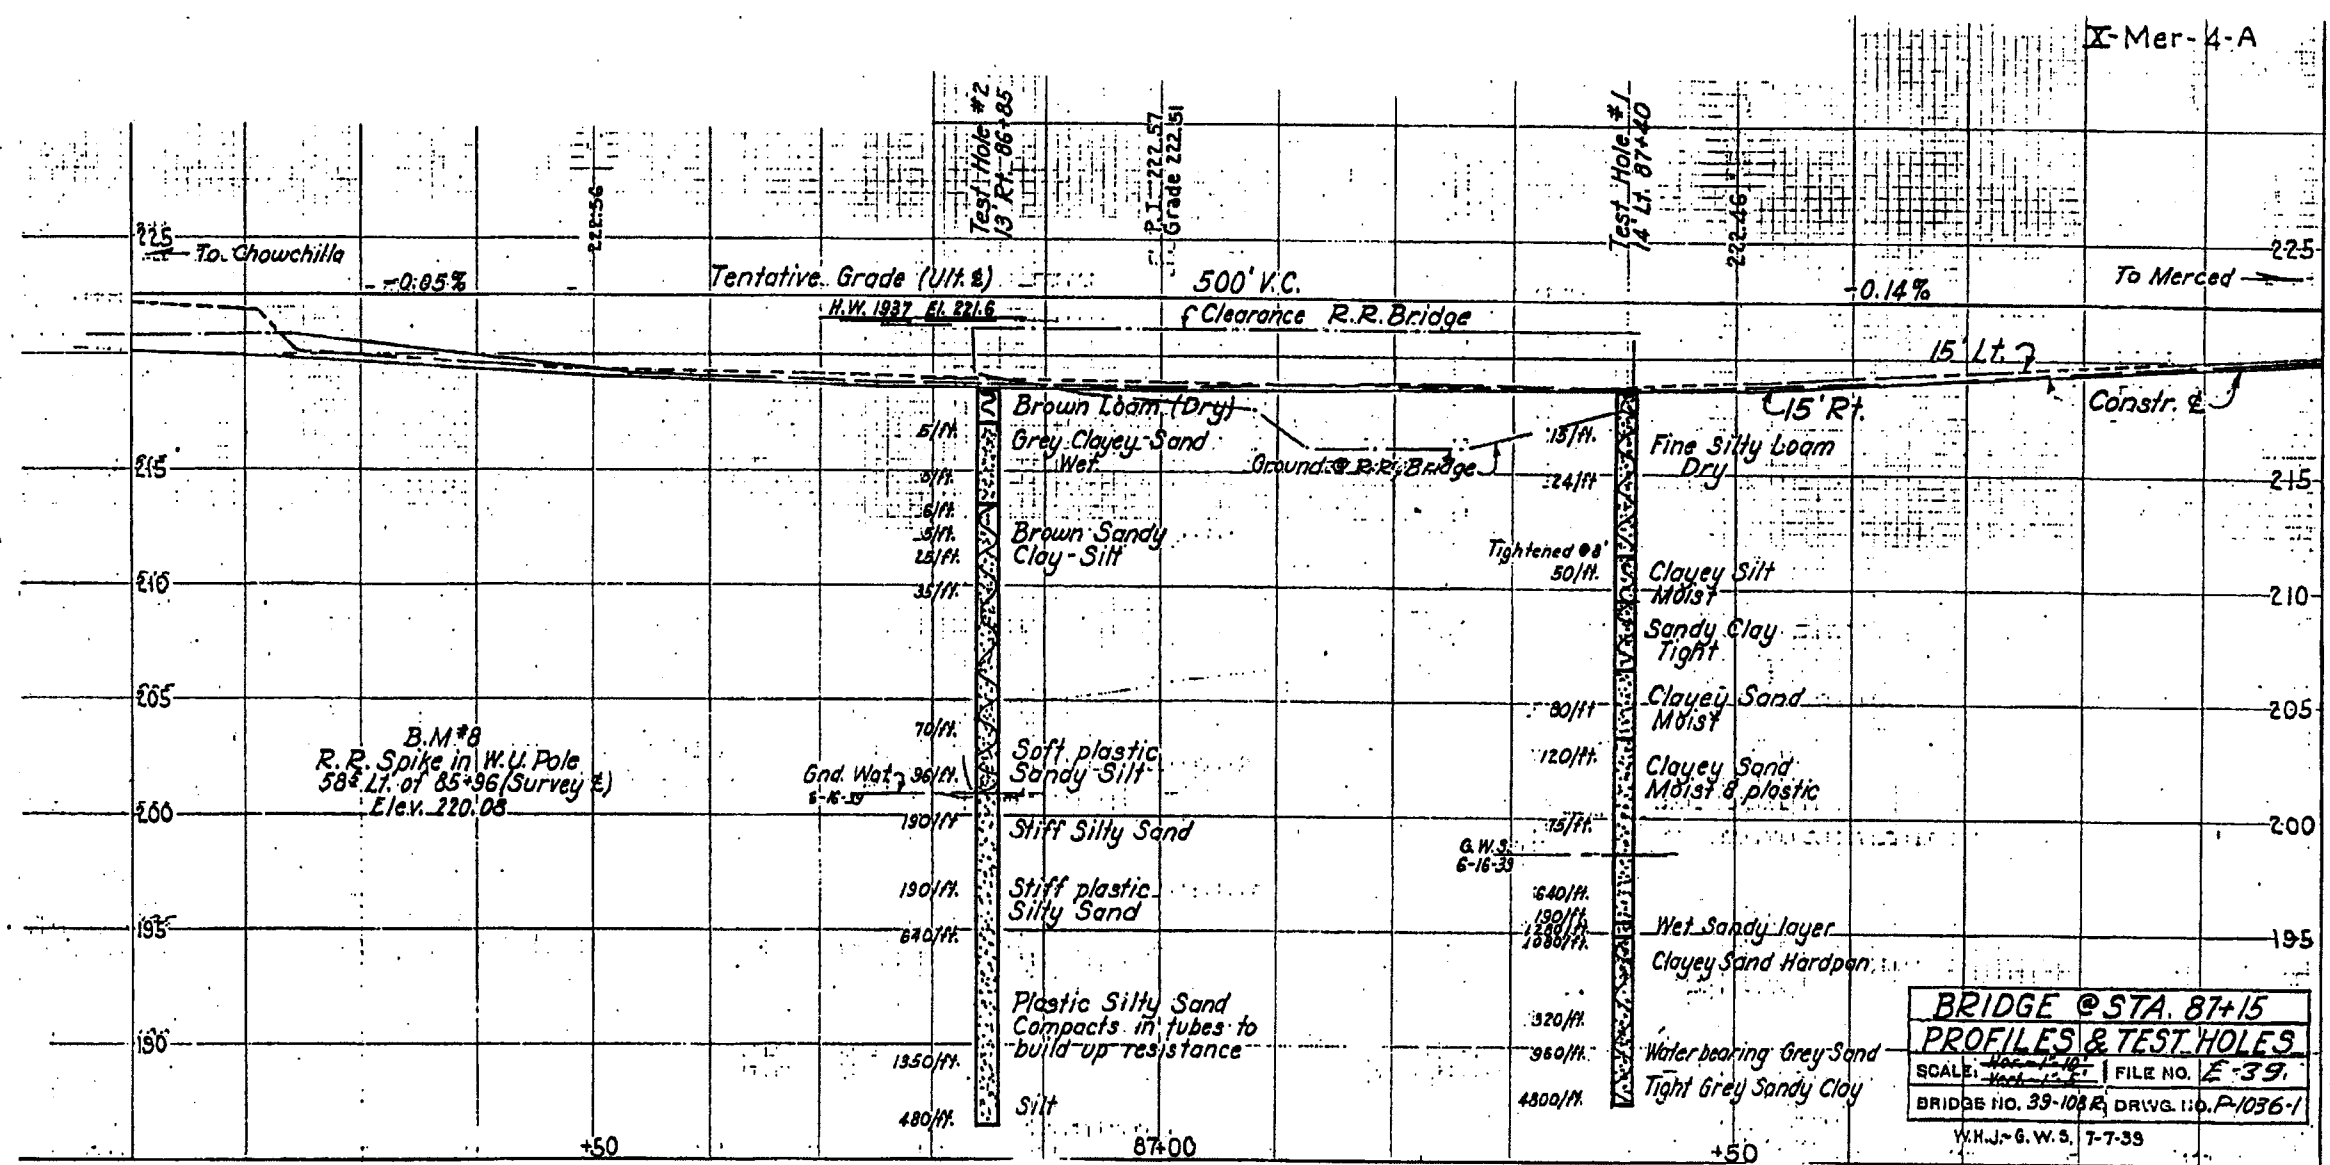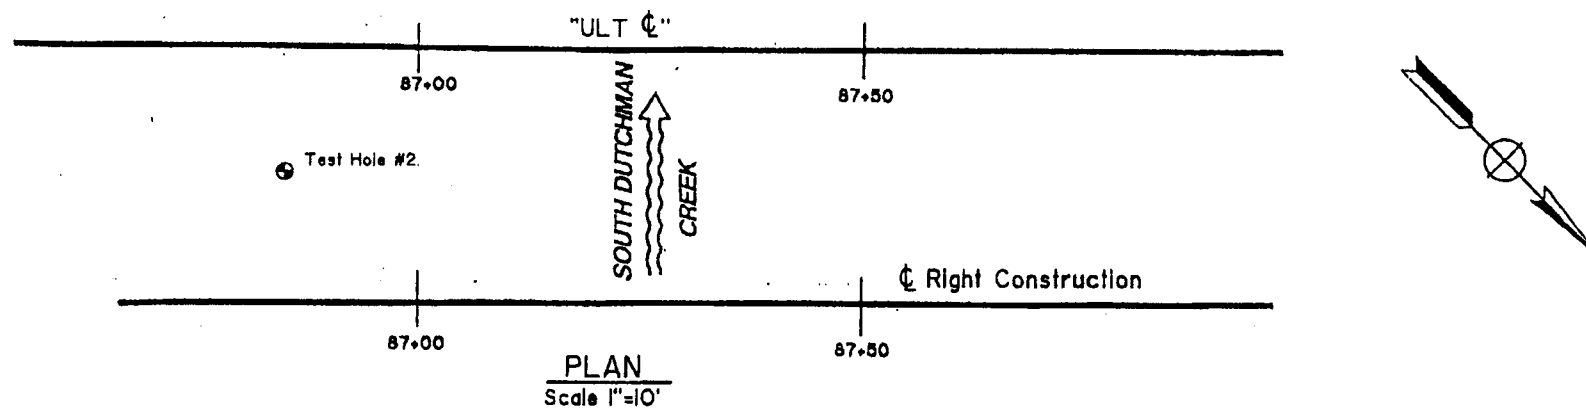

NO AS BUILT CHANGES  
**AS BUILT**  
 CORRECTIONS BY C.A. MALONEY  
 PROJECT NO. 10-380404  
 DATE 9-9-93

**BRIDGE @ STA. 87+15**  
**PROFILES & TEST HOLES**  
 SCALE: 1"=10' FILE NO. E-39  
 BRIDGE NO. 39-108R DRWG. NO. P-1036-1  
 W.H.J. & G.W.S. 7-7-39

NOTE: ADDITIONAL AS-BUILT FOUNDATION DATA MAY BE AVAILABLE AT THE DIVISION OF NEW TECHNOLOGY, MATERIALS AND RESEARCH 5900 FOLSOM BOULEVARD, SACRAMENTO, CALIFORNIA 95819 14-91 DATE	DESIGN BY	CHECKED	PREPARED FOR THE <b>STATE OF CALIFORNIA</b> DEPARTMENT OF TRANSPORTATION Jeffrey C. Davis PROJECT ENGINEER CU 10200 EA 380401	BRIDGE NO.	SO. DUTCHMAN CREEK - RT BRIDGE (WIDEN) <b>AS-BUILT LOG OF TEST BORINGS</b>
	DETAILS BY	CHECKED		39-108R	
	QUANTITIES BY	CHECKED		185	
FINAL SCALE IN INCHES REDUCED PLANS 0 1 2 3			DISREGARD PRINTS BEARING EARLIER REVISION DATES		






AS BUILT PLANS  
Contract No. 1-10T-61  
Date Completed  
Document No. 00000208

NOTES  
THE CONTRACTOR'S ATTENTION IS DIRECTED TO SECTION 2, ARTICLE (C) OF THE STANDARD SPECIFICATIONS AND TO THE SPECIAL PROVISIONS ACCOMPANYING THIS SET OF PLANS.  
CLASSIFICATION OF EARTH MATERIAL AS SHOWN ON THIS SHEET IS BASED UPON FIELD INSPECTION AND IS NOT TO BE CONSTRUED TO IMPLY MECHANICAL ANALYSIS.  
THIS SET OF PLANS HAS BEEN CORRECTED TO CORRESPOND TO THE "AS BUILT" PRINT, DATED 12-20-61, AS SUBMITTED BY RESIDENT ENGINEER, DUTCHMAN CREEK.  
TRAINING "FRE" BY JSC DATE 12-20-61


DUTCHMAN CREEK  
LOG OF TEST BORINGS.  
As Shown  
39-01R  
DRAWING NO. C-2407-51

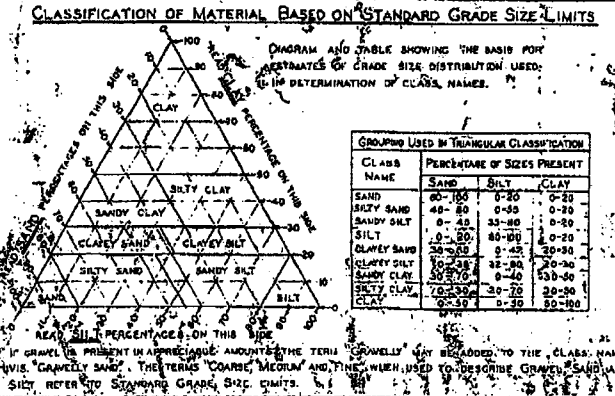


- LEGEND OF BORING OPERATIONS
- PLAN OF ANY BORING
  - 1" SAMPLER BORING
  - ROTARY WASH BORING
  - 1" CLOSED SAMPLER DRIVEN
  - CORE BORING
  - 2 1/2" PENETROMETER DRIVEN
  - 2" SAMPLER BORING
  - 2" NO. 20 AUGER BORING
  - 2" NO. 20 AUGER BORING
- THE APPROPRIATE BORING SYMBOLS DESIGNATING THE METHOD OF OPERATION ARE SHOWN AT THE UPPER RIGHT HAND CORNER OF THE RESPECTIVE BORING. WHERE TOOL CHANGES WERE MADE DURING THE BORING OPERATION, SYMBOLS ARE SHOWN AT THE POINT OF CHANGE.

- LEGEND OF EARTH MATERIALS
- GRAVEL - G
  - SAND - S
  - SILT - SI
  - CLAY - C
  - SILTY SAND - Si S
  - CLAYEY SAND - C S
  - SANDY SILT - S Si
  - CLAYEY SILT - C Si
  - SANDY CLAY - S C
  - CLAYEY CLAY - C C
  - PEAT AND ORGANIC CLAY - O
  - SANDSTONE - SS
  - SHALE - SH
  - BROKEN ROCK (FRAGMENTS) - BR
  - ROCK - R

- ABBREVIATIONS
- EL. 69.1 ELEVATION OF GROUND AT TEST HOLE
  - h.p. BLOWS PER FOOT - (SEE NOTE ABOVE)
  - P PULLED PIPE
  - M MOISTURE AS % DRY WEIGHT
  - EL. 59.2 ELEVATION OF GROUND WATER AND DATE

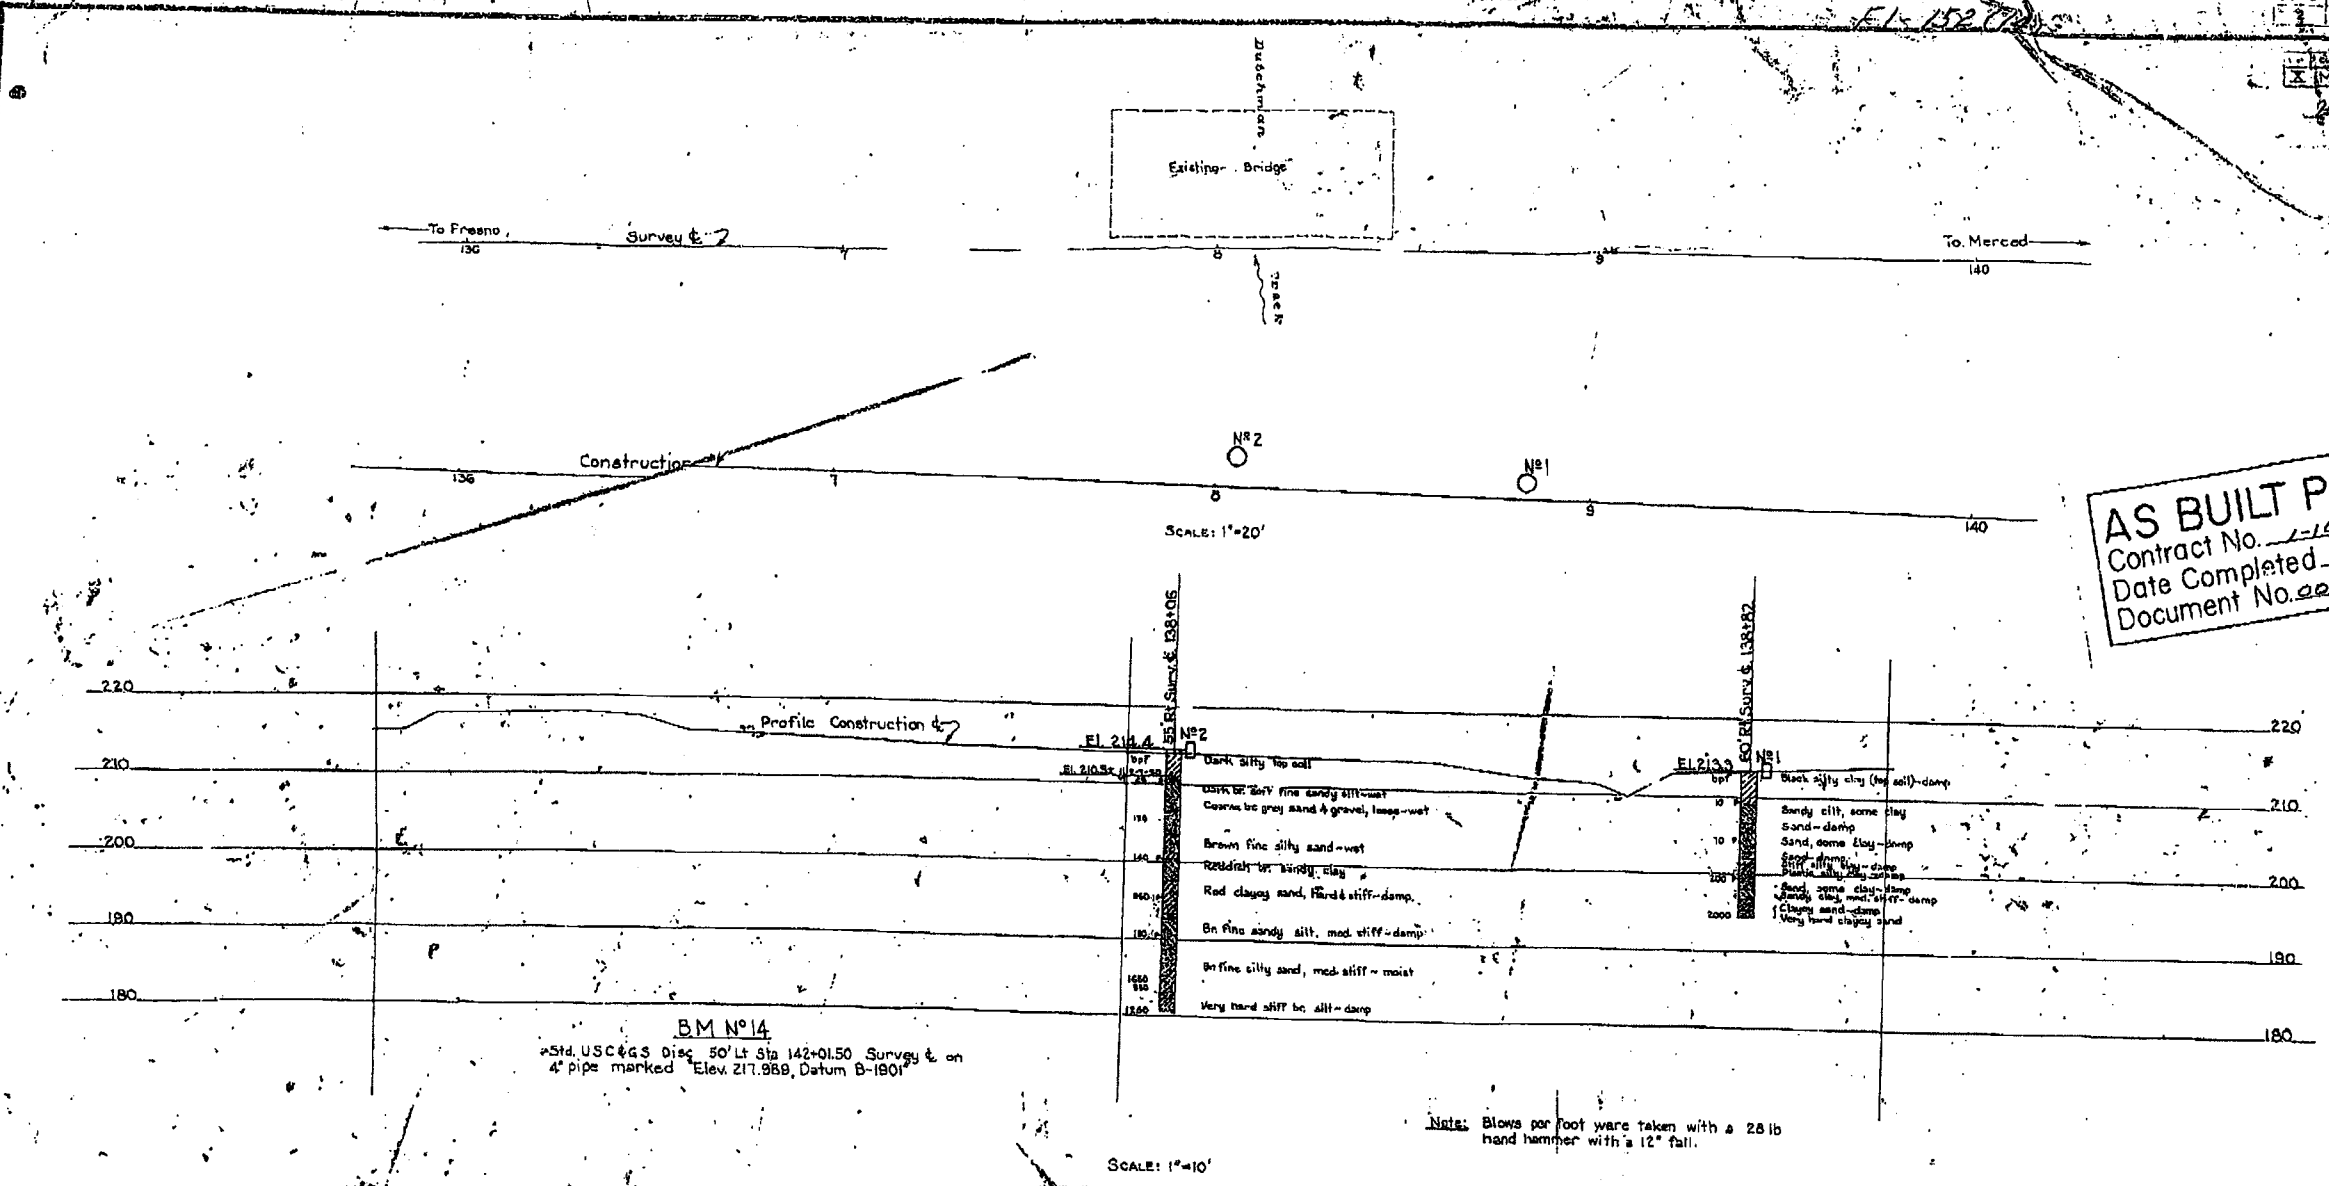


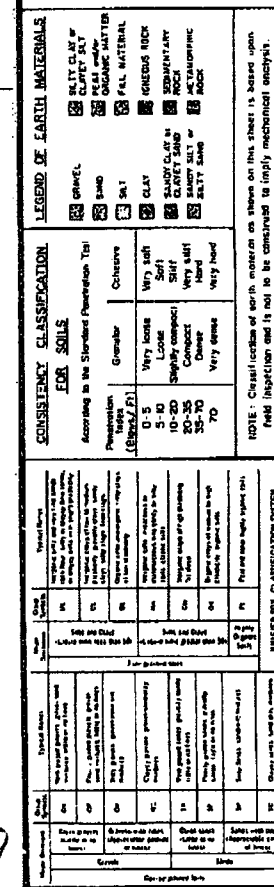

← TO MADERA

Q RTE.99 SB

DEADMAN  
CREEK

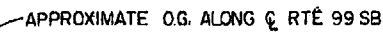



PROFILE

AS BUILT PLANS  
Contract No. 10-29-224  
Date Completed 12/25/72  
Drawing No.

12-90	RECEIVED	SUPERVISOR OF MICROFILM SERVICES
-------	----------	-------------------------------------





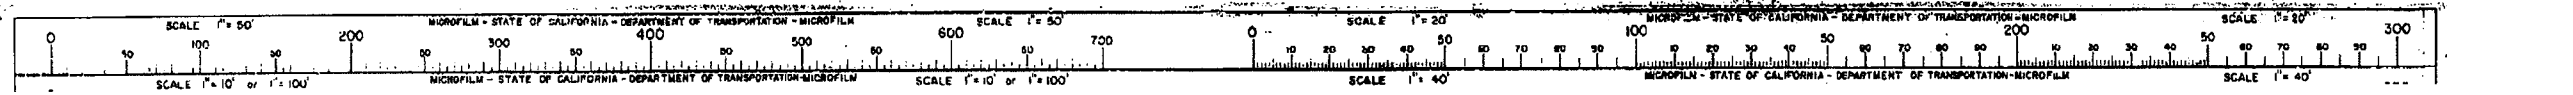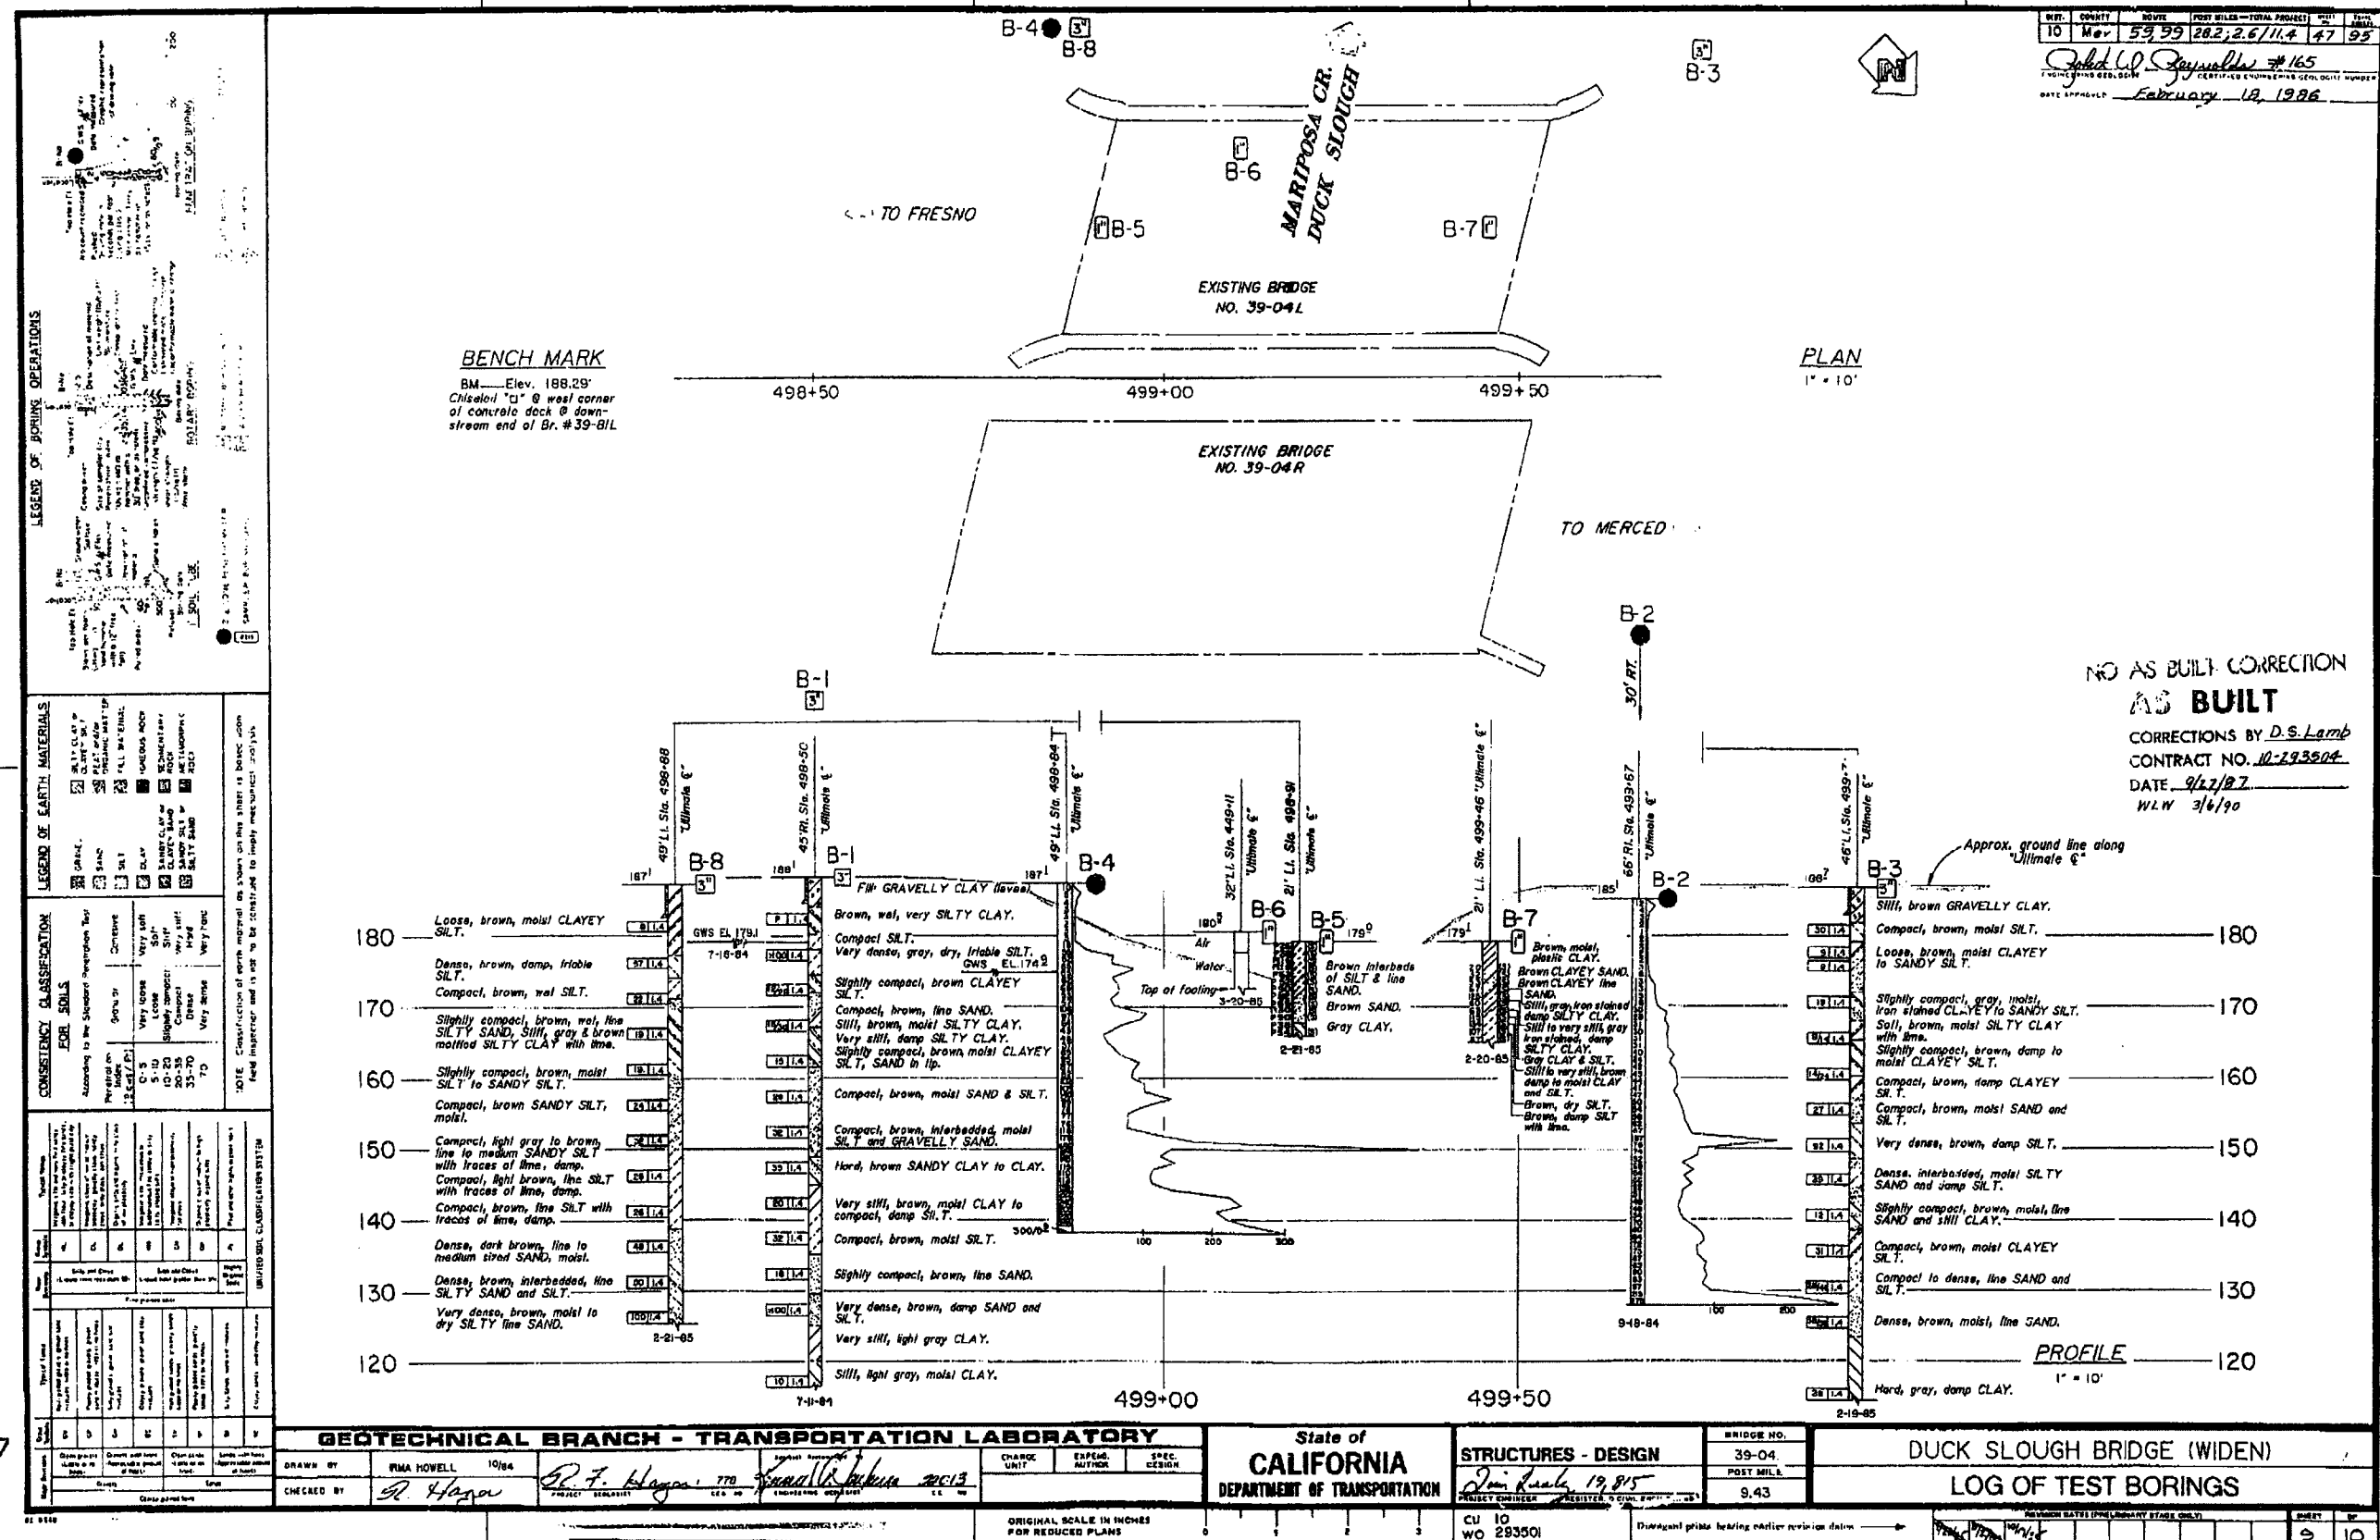



*Robert L. Reynolds*  
REGISTERED PROFESSIONAL ENGINEER  
No. 2208  
Exp. 9-30-03  
DIVISION OF ENGINEERING SERVICES - GEOTECHNICAL SERVICES


**DIVISION OF ENGINEERING SERVICES - GEOTECHNICAL SERVICES**  
As-Built Log of Test Borings shall be considered an informational document only. As such, the State of California registration seal with signature, license number and registration certificate expiration date certifies that this is a true and accurate copy of the original document. This drawing is available and presented only for the convenience of any bidder, contractor or other interested party.

DIST.	COUNTY	ROUTE	KILOMETER POST-TOTAL PROJECT	Sheet No.	Total Sheets
10	Mer	99	16.4/20.6	644	656

CERTIFIED ENGINEERING GEOLOGIST  
OWENS CREEK BR @ HWY 99  
LOG OF TEST BORINGS 2 OF 2

NOTE: A COPY OF THIS LOG OF TEST BORINGS IS AVAILABLE AT OFFICE OF STRUCTURE MAINTENANCE AND INVESTIGATIONS, SACRAMENTO, CALIFORNIA

CU#	EA#	BRIDGE No.	Sheet of
10	EA# 363101	39-006R/L	15 15

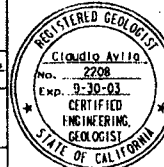

to accompany plans dated 8-20-05

**BENCH MARK**  
BM - Elev. 184.93  
White-pipe mark and the number "28" on outside of survey-rod near the S. abutment of bridge 39-06L

Revisions made to this Log of Test Borings from the original 1985 Log of Test Borings are the addition of the following table and notes:

Boring	Station	Offset from C/L Rte. 99
B-1	106+11	73.0 m Rt.
B-2	105+68.5	73.0 m Rt.
B-3	105+91	58.5 m Lt.
B-4	105+86	43.5 m Lt.
B-5	105+90	40.0 m Lt.
B-6	105+93.5	47.0 m Lt.
B-7	106+01	39.5 m Lt.
B-8	106+07	45.0 m Lt.

- Notes:
- See the General Plan and/or Foundation Plan for Metric Stationing.
  - Structure Design produced the data presented in the table above. The data are the metric locations for the As-Built Test Borings referenced to the proposed new structure location. This table is presented on the As-Built Log of Test Borings for the convenience of any bidder, contractor or other interested party.

TO FRESNO

ULTIMATE Q

557+00 558+00 559+00

B-2

OWENS CR.

EXISTING BRIDGE NO. 39-06L

EXISTING BRIDGE NO. 39-06R

TO MERCED

PLAN  
1" = 20'

180

170

160

150

140

130

120

110

Brown SANDY SILT.  
Brown, moist, fine SILTY SAND.  
Brown, moist SANDY CLAY.  
Gray-green, iron stained, damp CLAY.

B-2  
Slightly compact, dark brown, moist, micaceous SILT.

Very loose, brown, wet CLAYEY to SILTY SAND.

Silt, gray SANDY CLAY.

Very soft, red-brown, moist SANDY CLAY.

Slightly compact, brown, moist SILT.

Slightly compact, blue-gray CLAYEY SAND to wet clean SAND.

Slightly compact, brown, wet CLAYEY SAND.

Compact, brown, wet SILTY SAND.

Dense, to compact, brown SILTY SAND with GRAVEL stringers.

Hard, brown CLAY.

Hard, brown SANDY CLAY.

Dense, gray, fine SAND.

Very dense, gray, interbedded, fine SAND and SILT.

6-20-84

557+50

558+00

180

170

160

150

140

130

120

110

B-3  
Loose, light brown to dark brown, micaceous SANDY SILT.

Very loose, brown, wet, very SILTY fine SAND.

Slightly compact, gray wet, fine SAND & SILT.

Soft, gray, iron stained, moist SANDY CLAY.

Compact, gray, iron stained, lenses of wet SILT and moist CLAYEY SILT.

Compact, brown SANDY SILT.

Slightly compact, gray, iron stained CLAYEY SILT, damp.

Slightly compact, moist SILT.

Very dense, brown SAND & GRAVEL.

Dense, brown SAND & GRAVEL.

Very stiff, brown CLAY.

Dense, brown CLAYEY SILT.

Hard, light gray, dry CLAY.

2-14-85

558+50

180

170

160

150

140

130

120

110

B-6  
Very loose, brown, moist SILT to CLAYEY SILT with roots.

Very loose, brown, wet CLAYEY SAND with roots.

Silt, brown CLAY.

Very stiff, brown, damp SANDY CLAY.

Silt, gray, iron stained, moist SANDY CLAY.

Slightly compact, brown, moist SILT to CLAYEY SILT.

GRAVELLY SAND lenses.

Compact, gray, iron stained, damp SILT.

Slightly compact, brown, moist CLAYEY SILT.

Slightly compact, brown, wet, fine SAND and SILT.

Very dense, brown SAND & GRAVEL.

Compact to dense, gray, iron stained, damp CLAYEY SILT.

Compact, gray, moist to damp SILT to CLAYEY SILT.

Very stiff, gray-green, dry CLAY.

6-20-84

559+00

PROFILE  
1" = 10'

**GEOTECHNICAL BRANCH - TRANSPORTATION LABORATORY**

DRAWN BY	RMA HOWELL	DATE	10/04
CHECKED BY		PROJECT NO.	778
		ENGINEER'S NAME	Robert L. Reynolds

State of  
**CALIFORNIA**  
DEPARTMENT OF TRANSPORTATION

STRUCTURES - DESIGN  
*Jim R. Smith, 1985*

BRIDGE NO.	39-06R
POST MILE	10.6

**OWENS CREEK BRIDGE (WIDEN)  
LOG OF TEST BORINGS**

ORIGINAL SCALE IN INCHES FOR REDUCED PLANS

CU# 10  
WO# 293501

Discreet prints bearing uniform revision date

NO VISION DATA (PNEUMATIC STAMP ONLY)

3/5





CONSISTENCY CLASSIFICATION FOR SOILS			
LIQUIDITY INDEX (L.I.)	PLASTICITY INDEX (P.I.)	LIQUID LIMIT (LL)	PLASTIC LIMIT (PL)
0-10	0-10	0-100	0-100
11-20	11-20	101-120	101-120
21-30	21-30	121-140	121-140
31-40	31-40	141-160	141-160
41-50	41-50	161-180	161-180
51-60	51-60	181-200	181-200
61-70	61-70	201-220	201-220
71-80	71-80	221-240	221-240
81-90	81-90	241-260	241-260
91-100	91-100	261-280	261-280

LEGEND OF EARTH MATERIALS			
CLAY (CL)	CLAYEY SAND (SC)	LEAN CLAY (CL)	LEAN CLAYEY SAND (SC)
SANDY CLAY (CL)	SANDY CLAYEY SAND (SC)	SANDY LEAN CLAY (CL)	SANDY LEAN CLAYEY SAND (SC)
POORLY GRADED FINE SAND (SP-SM)	POORLY GRADED FINE SAND (SP-SM)	POORLY GRADED FINE SAND (SP-SM)	POORLY GRADED FINE SAND (SP-SM)
POORLY GRADED FINE SAND (SP-SM)	POORLY GRADED FINE SAND (SP-SM)	POORLY GRADED FINE SAND (SP-SM)	POORLY GRADED FINE SAND (SP-SM)


LEGEND OF BORING OPERATIONS			
ROTARY BORING	ROTARY BORING	ROTARY BORING	ROTARY BORING
ROTARY BORING	ROTARY BORING	ROTARY BORING	ROTARY BORING
ROTARY BORING	ROTARY BORING	ROTARY BORING	ROTARY BORING

**BENCH MARK**  
BM CM 105 Elev. 55.95 m  
1/4 inch rebar

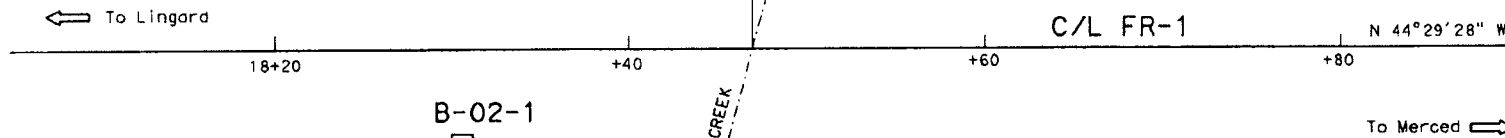

PLAN			
1:200			
54 m	55.06	B-02-1	54 m
51 m	51.70	SANDY SILT (ML), loose, very dark grayish brown, moist.	51 m
48 m	48.35	SILTY fine SAND (SM), loose, brown, moist.	48 m
45 m	45.35	CLAYEY SAND (SC), loose, olive gray.	45 m
42 m	42.35	Lean CLAY with SAND (CL), stiff, olive gray, moist. qu=215 kPa	42 m
39 m	39.35	Lean CLAY with fine SAND (CL), soft, pale olive.	39 m
36 m	36.35	SANDY lean CLAY (CL), soft, pale olive, moist to wet.	36 m
33 m	33.35	Lean CLAY with fine SAND (CL), soft, olive, wet. qu=24 kPa	33 m
30 m	30.35	SANDY lean CLAY (CL), soft, olive, wet. qu=0.0 kPa	30 m
27 m	27.35	152.4 mm layer of poorly graded fine to medium SAND at elev. 46.37 m.	27 m
24 m	24.35	Lean CLAY (CL), firm, olive, moist. qu=143 kPa	24 m
		Poorly graded fine SAND with SILT (SP-SM), medium dense, dark greenish gray, wet.	
		Poorly graded fine SAND (SP), dense, dark yellowish gray, wet.	
		Well graded fine to coarse GRAVEL with SILT and SAND (GW-GM), dense, very dark grayish brown and other various colors, wet, GRAVEL up to 50 mm, subrounded to subangular.	
		Poorly graded fine SAND with CLAY (SP-SC), dense, light olive brown, wet.	
		Some GRAVEL.	
		Poorly graded fine and medium SAND (SP), very dense, grayish brown, wet.	
		Fat CLAY (CH), hard, light yellowish brown, moist, weak cementation. qu=325 kPa	
		Fat CLAY (CH), very stiff, hard, yellowish gray, moist, weak cementation. qu=310 kPa	
		Lean CLAY (CL), very stiff, light olive gray, moist, some weak cementation.	
		Poorly graded SAND with SILT (SP-SM), dense, light olive gray, moist to wet, medium to coarse SAND with fine GRAVEL.	

Notes: qu=unconfined compressive strength using a pocket penetrometer.



10	Mer	99	16.4/20.6	643	656
<p><b>Claudio Avila</b> 6-5-03 CERTIFIED ENGINEERING GEOLOGIST</p> <p>6-20-05 PLANS APPROVAL DATE</p> <p>The State of California or its officers or agents shall not be responsible for the accuracy or completeness of electronic copies of this plan sheet.</p> <p>To verify the Caltrans web site for the latest version of the plan sheet.</p>					


**PROFILE**

HOR. 1:100  
VER. 1:100


ALL DIMENSIONS ARE IN METERS UNLESS OTHERWISE SHOWN

<b>ENGINEERING SERVICES</b>		<b>GEOTECHNICAL SERVICES</b>		FIELD INVESTIGATION BY: J. Kaump		STATE OF CALIFORNIA DEPARTMENT OF TRANSPORTATION		DIVISION OF STRUCTURES STRUCTURE DESIGN 6		BRIDGE NO. 39-0006R/L KILOMETER POST 16.98		<b>OWENS CREEK BRIDGE</b>	
DRAWN BY: W. Tang 05/03		CHECKED BY: C. Avila		CU 10 EA 363111		DISREGARD PRINTS BEARING EARLIER REVISION DATES		14		15		LOG OF TEST BORINGS 1 OF 2	

ORIGINAL SCALE IN MILLIMETERS FOR REDUCED PLANS

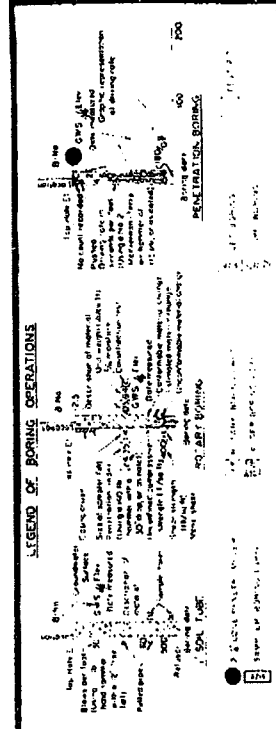


**BENCH MARK**  
BM Elev. 184.93  
White point mark and the number "28" on outside of westerly roll near the S. abutment of bridge 39-06L.

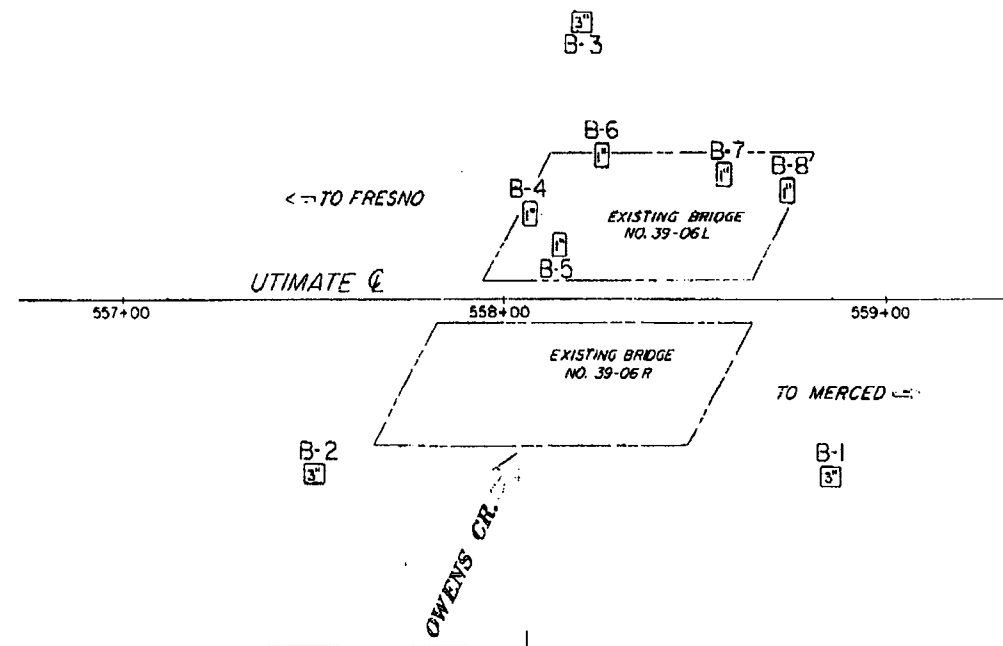


PLAN  
1" = 20'

NO AS BUILT CORRECTION  
AS BUILT  
CORRECTIONS BY D.S. Lamb  
CONTRACT NO. 10-293504  
DATE 9/21/87  
WLW 2/27/90

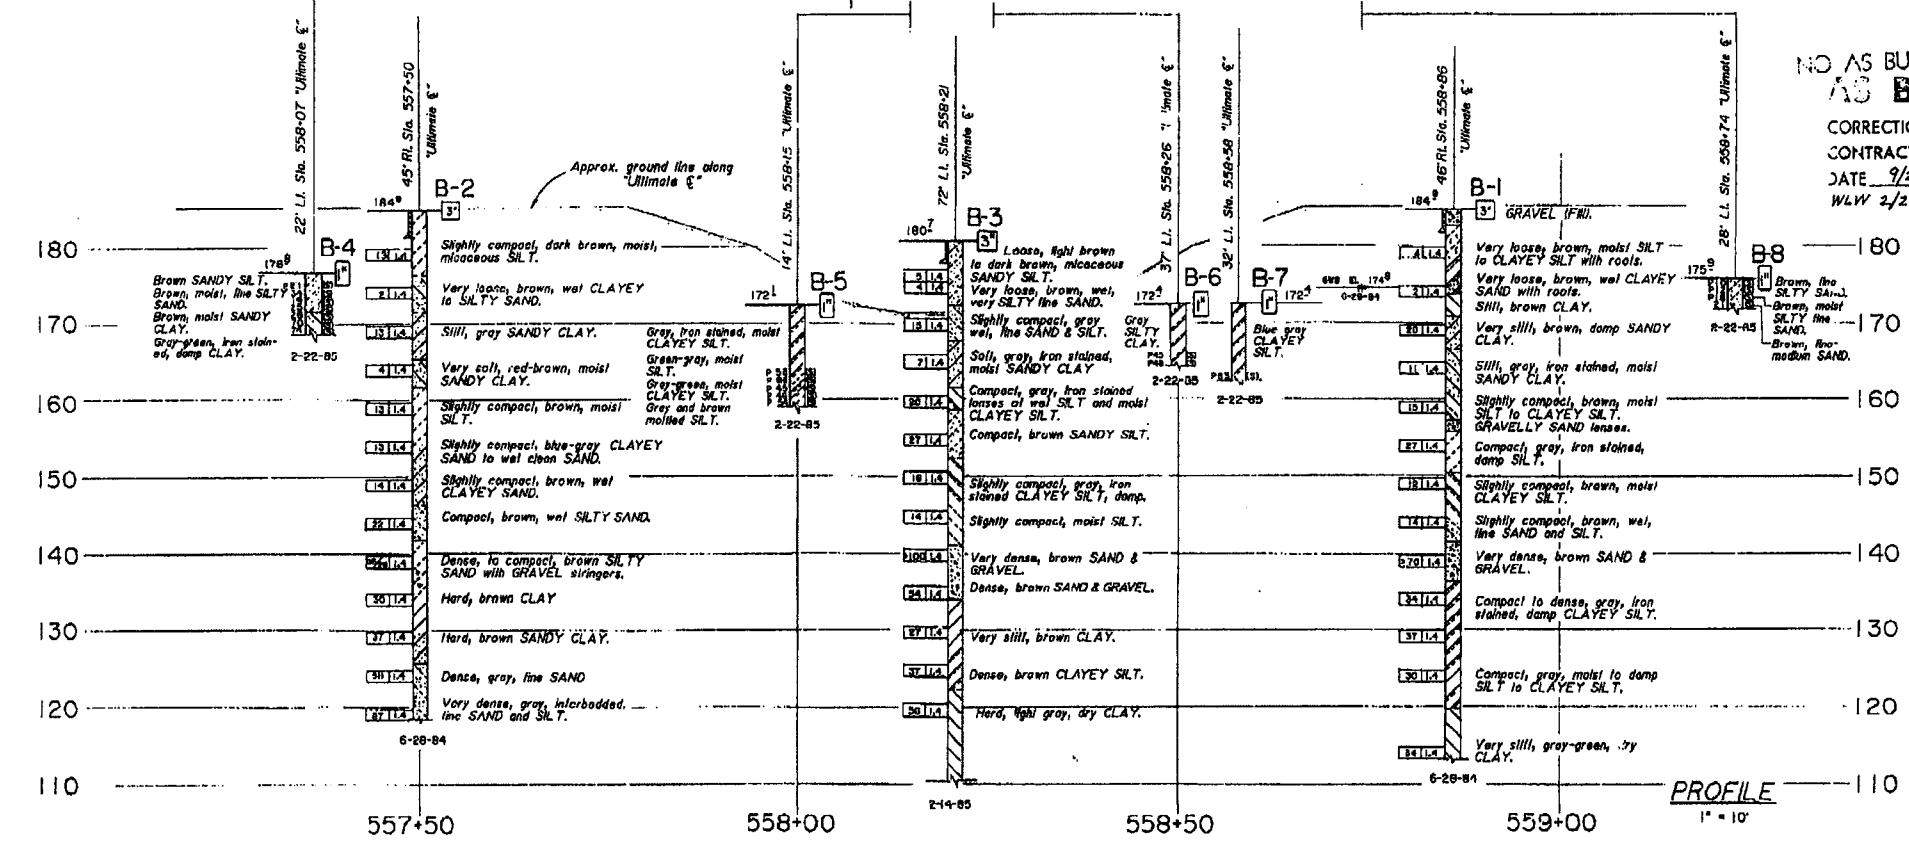

PROFILE  
1" = 10'

<b>GEOTECHNICAL BRANCH - TRANSPORTATION LABORATORY</b>				<b>State of CALIFORNIA</b>		<b>STRUCTURES - DESIGN 3</b>		<b>OWENS CREEK BRIDGE (WIDEN)</b>	
DRAWN BY JMA HOWELL 10/04				DEPARTMENT OF TRANSPORTATION		BRIDGE NO. 39-06 R		LOG OF TEST BORINGS	
CHECKED BY R. J. Hogan 778				PROJECT ENGINEER		1 POST MILE			
ORIGINAL SCALE IN INCHES FOR REDUCED PLANS				CU 10 WO 293501		Disregard prices bearing earlier revision dates		8 9	

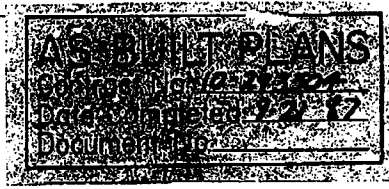

I HEREBY CERTIFY THAT THIS IS A TRUE AND ACCURATE COPY OF THE ABOVE DOCUMENT TAKEN UNDER MY DIRECTION AND CONTROL ON THIS DATE IN SACRAMENTO, CALIFORNIA PURSUANT TO AUTHORIZATION BY THE DIRECTOR OF TRANSPORTATION.  
7-12-90 Donald Blackford SUPERVISOR OF MICROFILM SERVICES



Robert W. Gammon  
DATE APPROVED

DIVISION OF ENGINEERING SERVICES - GEOTECHNICAL SERVICES  
As-Built Log of Test Borings sheet is considered an informational document only. As such, the State of California registration seal with signature, license number and registration certificate expiration date confirm that this is a true and accurate copy of the original document. This drawing is available and presented only for the convenience of any bidder, contractor or other interested party.

DIST.	COUNTY	ROUTE	KILOMETER POST-TOTAL PROJECT	Sheet No.	Total Sheets
10	Mer	99	16.4/20.6	644	656


CERTIFIED ENGINEERING GEOLOGIST  
OWENS CREEK BR @ HWY 99  
LOG OF TEST BORINGS 2 OF 2

NOTE: A COPY OF THIS LOG OF TEST BORINGS IS AVAILABLE AT OFFICE OF STRUCTURE MAINTENANCE AND INVESTIGATIONS, SACRAMENTO, CALIFORNIA

CUI 10  
EAT 363101

BRIDGE NO.  
39-006R/L

Sheet 15 of 15

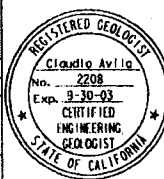


To accompany plans dated 6-20-05

**BENCH MARK**  
BM - Elev. 184.93  
White point mark and the number "28" on outside of weathered rail near the S. abutment of bridge 39-06L.


Revisions made to this Log of Test Borings from the original 1985 Log of Test Borings are the addition of the following table and notes:

Boring	Station	Offset from C/L Rte. 99
B-1	106+11	23.0 m Rt
B-2	105+68.5	23.0 m Rt
B-3	105+91	98.5 m Lt
B-4	105+86	43.5 m Lt
B-5	105+90	40.0 m Lt
B-6	105+93.5	47.0 m Lt
B-7	106+01	39.5 m Lt
B-8	106+07	45.0 m Lt

- Notes:
- See the General Plan and/or Foundation Plan for Metric Stationing.
  - Structure Design produced the data presented in the table above. The data are the metric locations for the As-Built Test Borings referenced to the proposed new structure location. This table is presented on the As-Built Log of Test Borings sheet for the convenience of any bidder, contractor or other interested party.

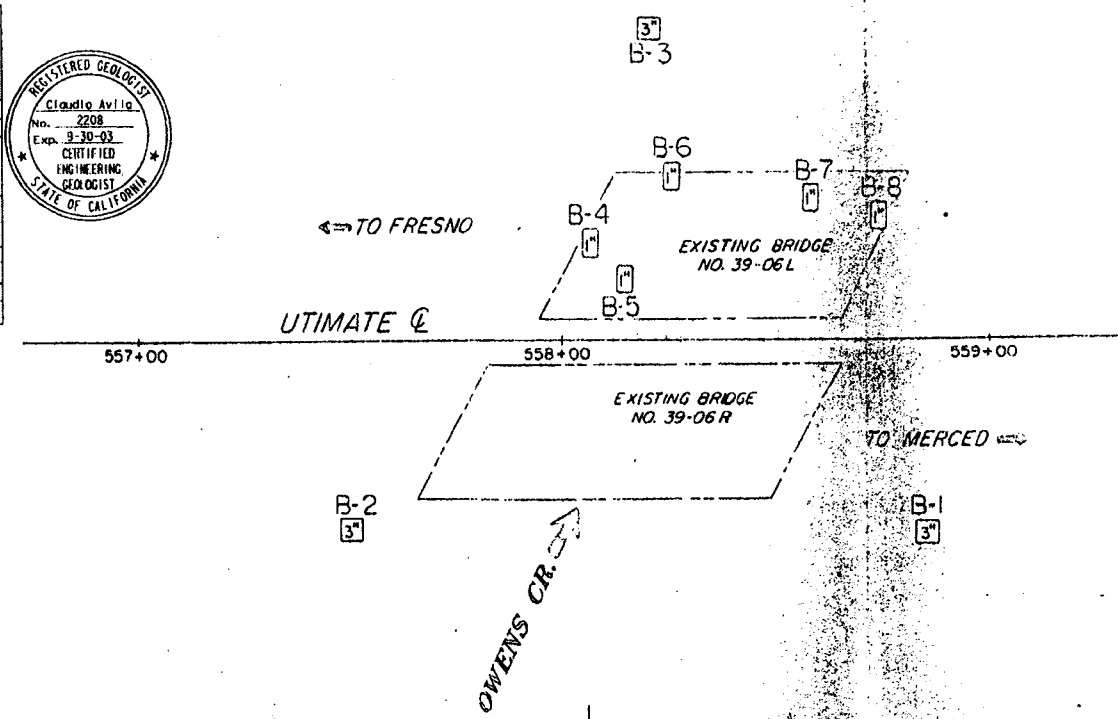

PLAN  
1" = 20'

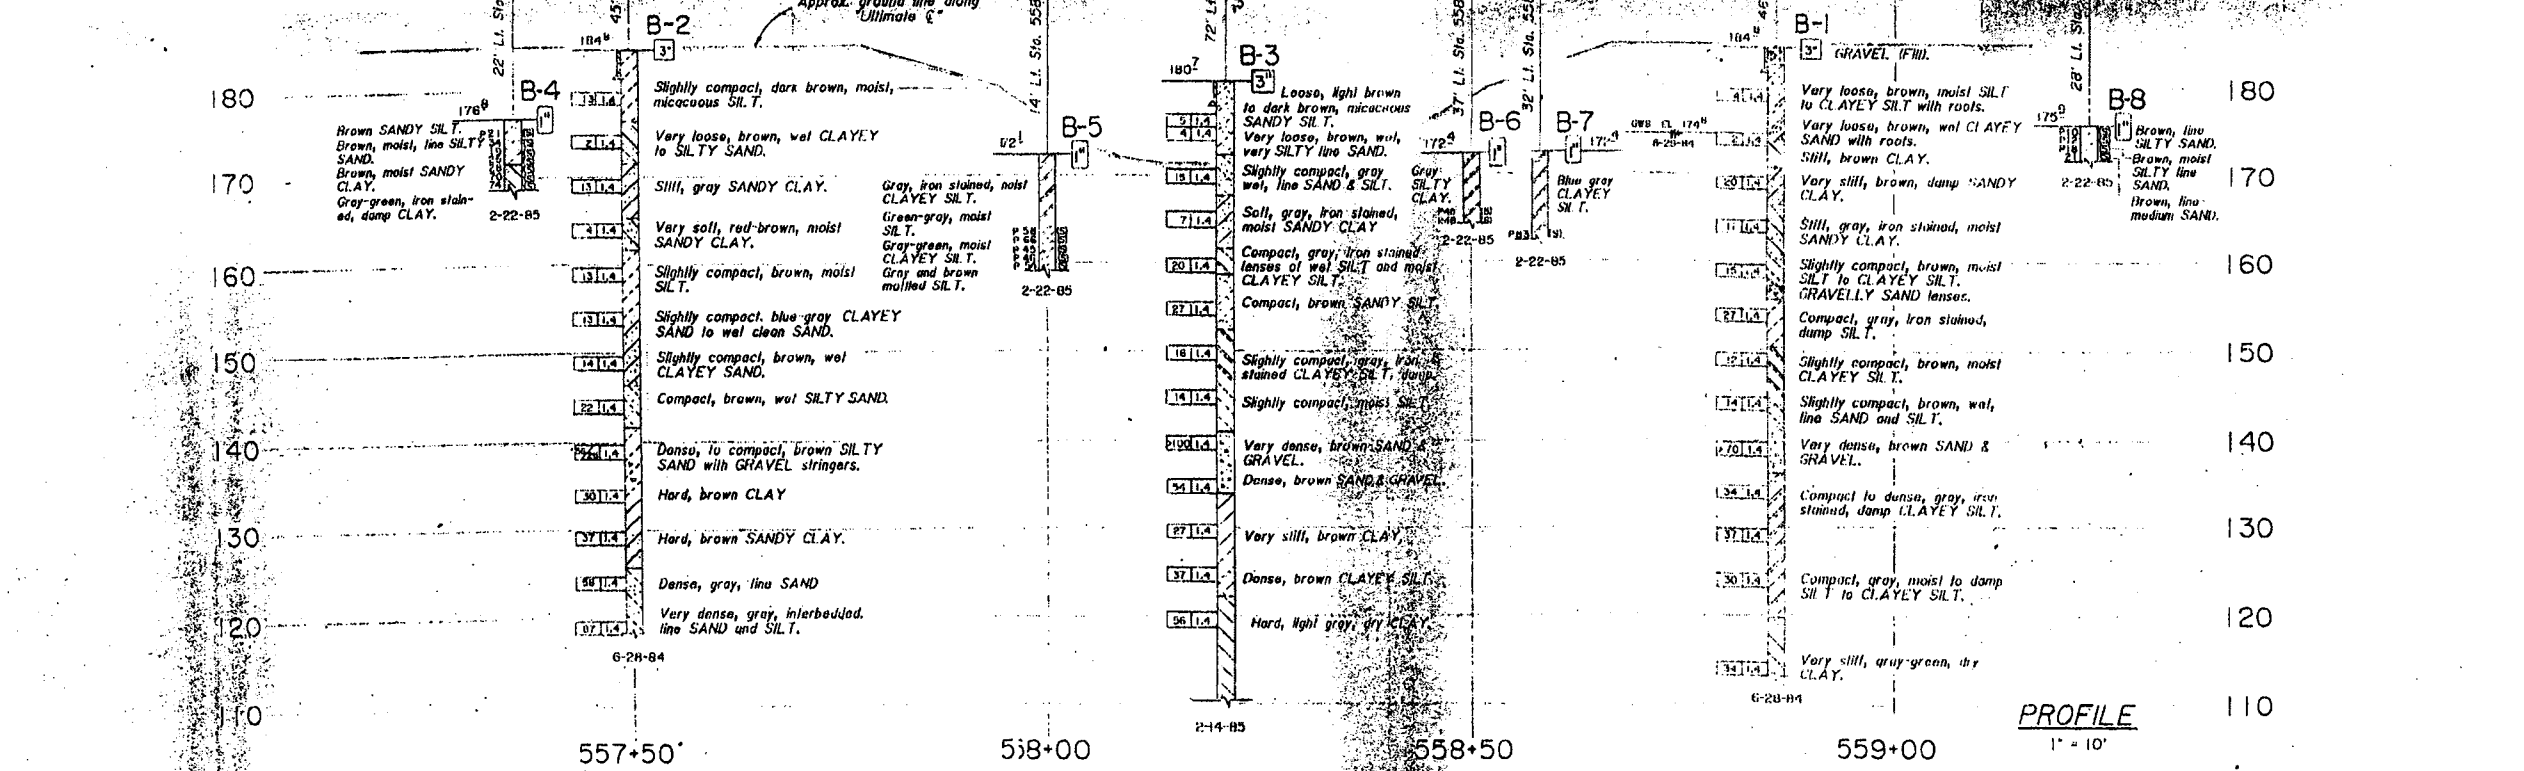


PROFILE  
1" = 10'

GEOTECHNICAL BRANCH - TRANSPORTATION LABORATORY				State of CALIFORNIA		STRUCTURES - DESIGN		OWENS CREEK BRIDGE (WIDEN)	
DRAWN BY	IRMA HOWELL	10/04	778	CHARGE UNIT	DESIGNED BY	DATE	BRIDGE NO.	POST MILE	LOG OF TEST BORINGS
ENGINEERED BY	7/7/05	PROJECT	778	UNIT	DESIGNED BY	DATE	39-06R	10.6	
ORIGINAL SCALE IN INCHES FOR REDUCED PLANS				CU 10		WQ 293501		REVISION DATA (PRELIMINARY STAGE ONLY)	
								SHEET 3 OF 5	

CONSISTENCY CLASSIFICATION FOR SOILS			
SP	SOFT	2-4	2-4
MP	MEDIUM PLASTIC	4-7	4-7
HP	HARD PLASTIC	7-10	7-10
U	UNCLASSIFIED	10-15	10-15
OC	OVERCONSISTENT	15-20	15-20
ST	STIFF	20-25	20-25
VS	VERY STIFF	25-30	25-30
HC	HARD CLAY	30-35	30-35
U	UNCLASSIFIED	35-40	35-40
ST	STIFF	40-45	40-45
VS	VERY STIFF	45-50	45-50
HC	HARD CLAY	50-55	50-55
U	UNCLASSIFIED	55-60	55-60
ST	STIFF	60-65	60-65
VS	VERY STIFF	65-70	65-70
HC	HARD CLAY	70-75	70-75
U	UNCLASSIFIED	75-80	75-80
ST	STIFF	80-85	80-85
VS	VERY STIFF	85-90	85-90
HC	HARD CLAY	90-95	90-95
U	UNCLASSIFIED	95-100	95-100

LEGEND OF EARTH MATERIALS			
GRAVEL	CLAYEY SILT	CLAYEY SAND	CLAYEY SILT
SAND	SILT	SANDY SILT	SANDY CLAY
CLAY	CLAYEY SAND	CLAYEY SILT	CLAYEY SILT
CLAYEY SAND	CLAYEY SILT	CLAYEY SILT	CLAYEY SILT
CLAYEY SILT	CLAYEY SILT	CLAYEY SILT	CLAYEY SILT
CLAYEY SILT	CLAYEY SILT	CLAYEY SILT	CLAYEY SILT
LEGEND OF BORING OPERATIONS			
STANDARD PENETRATION TEST	STANDARD PENETRATION TEST	STANDARD PENETRATION TEST	STANDARD PENETRATION TEST
STANDARD PENETRATION TEST	STANDARD PENETRATION TEST	STANDARD PENETRATION TEST	STANDARD PENETRATION TEST
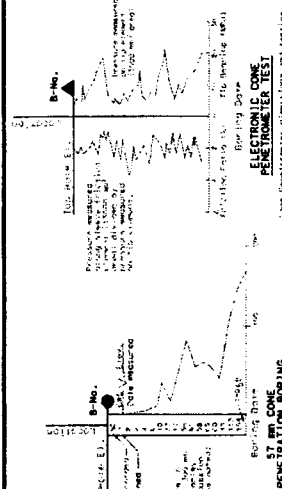

# BENCH MARK

BM 11611 Elev. 54.15 m  
3/4 inch rebar

To Fresno

C/L Rte. 99

122+00 122+20 N30°13'11"W 122+40 122+60

To Merced

PLAN  
1:250

54 m	53.87	02-1 94 mm	54 m
51 m	14 35	Lean CLAY (CL), very soft, very dark, grayish brown, dark to moist, rootlets. SILT (ML), medium dense, yellowish brown, dry to moist, weak to moderate cementation. SILT (ML), medium dense, dark yellowish brown, moist, weakly cemented, some CLAY. SILTY SAND (SM), medium dense, dark grayish brown, wet.	51 m
48 m	21 35	Lean CLAY with SAND (CL), very stiff, light yellowish brown, moist, wet, weak cementation, some SILT, some GRAVEL, CALICHE.	48 m
45 m	20 35	SANDY SILT (ML), medium dense, yellowish brown, moist to wet, some CLAY.	45 m
42 m	26 35	SILT with fine SAND (ML), medium dense, dark yellowish brown, moist to wet, weak cementation. SILT with fine SAND (ML), medium dense, dark yellowish brown, moist to wet.	42 m
39 m	29 35	Well graded medium to coarse SAND with SILT (SW-SM), medium dense, dark brown, wet, some fine GRAVEL. SILTY SAND (SM), medium dense, dark yellowish brown, moist to wet. Poorly graded medium SAND with CLAY (SP-SC), dense, yellowish brown, wet.	39 m
36 m	21 35	Poorly graded medium SAND with SILT (SP-SM), dense, brown, wet. Lean CLAY (CL), stiff, light yellowish brown, moist, weak cementation, blocky. Lean CLAY (CL), very stiff, light yellowish brown, moist, weak cementation, blocky. qu=430 kPa qu=215 kPa qu=335 kPa	36 m
33 m	16 35	Weak to moderate cementation. qu=382 kPa	33 m
30 m	11 35	Stiff. qu=239 kPa Lean CLAY (CL), very stiff, olive brown, moist, weak cementation, some SILT. qu=287 kPa	30 m
27 m	19 35	Lean CLAY (CL), very stiff, olive brown, moist, weak cementation. qu=382 kPa	27 m
24 m	39 35	SANDY SILT (ML), dense, strong brown, wet, some CLAY. Poorly graded medium SAND with SILT, medium dense, brown, wet. SILT with SAND (ML), medium dense, strong brown, wet, some CLAY.	24 m
	19 35	SILTY SAND (SM), medium dense, dark yellowish brown, wet, some CLAY.	
	24 35	Poorly graded medium SAND with SILT (SP-SM), dense, dark yellowish brown, wet.	
	41 35	SILT with SAND (ML), dense, dark yellowish brown, wet, some CLAY.	
	55 35		

## Notes:

- Groundwater elevation was not measured, but was observed at elev. ranging from 50.36 m to 51.94 m at the nearby proposed Mission Ave. OC (39-0228).
- Standard Penetration test were obtained using an Automatic Dietrich hammer.
- qu=unconfined compressive strength using a pocket penetrometer.

## PROFILE

HOR. 1:200  
VER. 1:100

ALL DIMENSIONS ARE IN METERS UNLESS OTHERWISE SHOWN

ENGINEERING SERVICES		GEOTECHNICAL SERVICES		FIELD INVESTIGATION BY:		STATE OF CALIFORNIA		DIVISION OF STRUCTURES		BRIDGE NO.		MILES CREEK OVERFLOW NO. 2	
DRAWN BY	W. Tang 05/03	CHECKED BY	C. Avila	J. Kaump		DEPARTMENT OF TRANSPORTATION		STRUCTURE DESIGN	6	39-0229L/R		LOG OF TEST BORINGS	1 OF 2
										KILOMETER POST	18.36		
										DISREGARD PRINTS BEARING EARLIER REVISION DATES		15 16	

ORIGINAL SCALE IN MILLIMETERS FOR REDUCED PLANS

CU 10  
EA 363111

FILE: 39-0229L-R-18.36-101.dgn

REVISION DATES

DIVISION OF ENGINEERING SERVICES - GEOTECHNICAL SERVICES  
As-Built Log of Test Borings sheet is considered an informational document only.  
As such, the State of California registration seal with signature, license number and registration expiration date confirm that this is a true and accurate copy of the original document. This drawing is available and presented only for the convenience of any bidder, contractor or other interested party.

DIST. COUNTY ROUTE KILOMETER POST-TOTAL PROJECT  
10 Mar 99 16.4/20.6

CERTIFIED ENGINEERING GEOLOGIST  
DATE

MILES CREEK OVERFLOW NO. 2

LOG OF TEST BORINGS 2 OF 2

NOTE: A COPY OF THIS LOG OF TEST BORINGS IS AVAILABLE AT OFFICE OF STRUCTURE MAINTENANCE AND INVESTIGATIONS, SACRAMENTO, CALIFORNIA  
CU: 10 39-0229L/R

Revisions made to this Log of Test Borings from the original 1984 Log of Test Borings are the addition of the following table and notes:




Boring	Station	Offset from C/L Rte. 99
B-1	119+25	155 m L
B-2	119+70	138 m L

Notes:

- See the General Plan and/or Foundation Plan for Metric Stationing.
- Structure Design produced the data presented in the table above. The data are the metric locations for the As-Built Test Borings referenced to the proposed new structure location. This table is presented on this As-Built Log of Test Borings sheet for the convenience of any bidder, contractor or other interested party.

**BENCH MARK**  
Bench mark "TBR"  
at N end of Ely Bridge sub.  
Br. # 39-38R Elev. 179.9'

To accompany plans dated 6-20-05

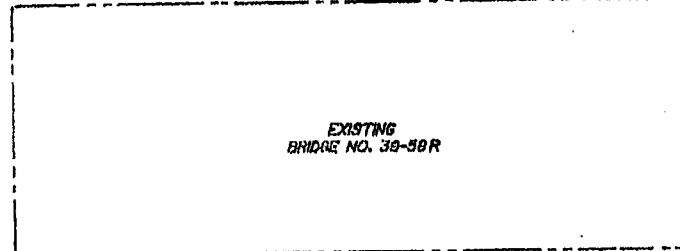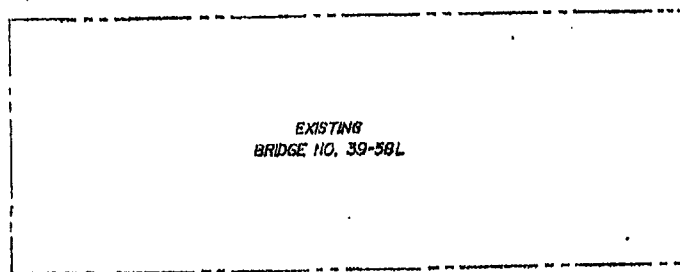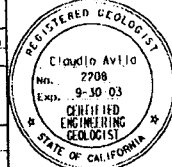


ULTIMATE C


PLAN  
1" = 10'

To Merced →

NO AS BUILT CORRECTIONS  
**AS BUILT**  
CORRECTIONS BY D.S. Lamb  
CONTRACT NO. 10-293504  
DATE 8/7/87  
N.W. 2/20/90

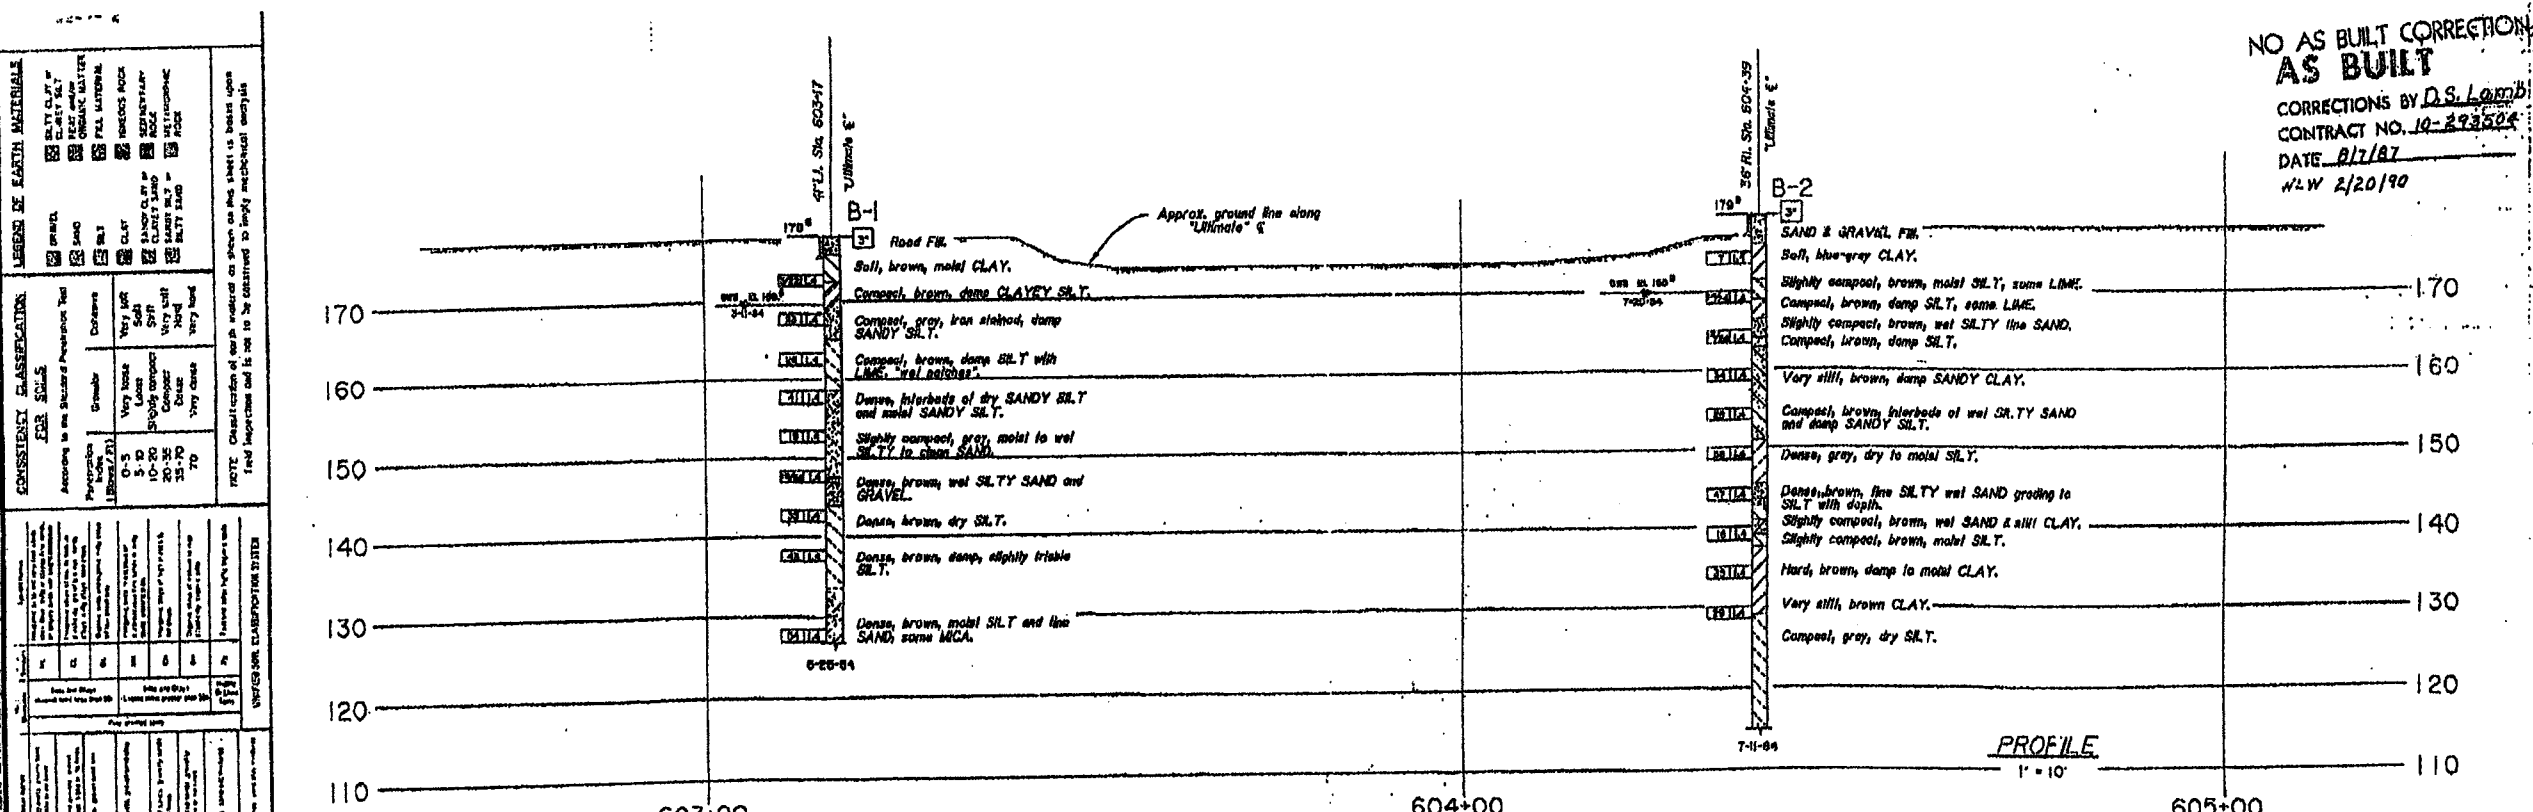


GEOTECHNICAL BRANCH - TRANSPORTATION LABORATORY				State of CALIFORNIA DEPARTMENT OF TRANSPORTATION		STRUCTURES - DESIGN 3		MILES CREEK OVERFLOW (WIDEN)	
DRAWN BY: KIM HOWELL B104				CHECKED BY: P. Hoyer		DATE: 12/15/85		LOG OF TEST BORINGS	
ORIGINAL SCALE IN INCHES FOR REDUCED PLANS				CU 10 WO 293501		DATE: 12/15/85		7 8	

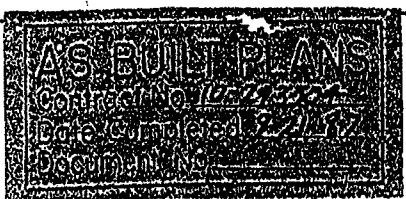


I HEREBY CERTIFY THAT THIS IS A TRUE AND ACCURATE COPY OF THE ABOVE DOCUMENT TAKEN UNDER MY DIRECTION AND CONTROL ON THIS DATE IN SACRAMENTO, CALIFORNIA PURSUANT TO AUTHORIZATION BY THE DIRECTOR OF TRANSPORTATION.

39-2291r-z1otb2.tif



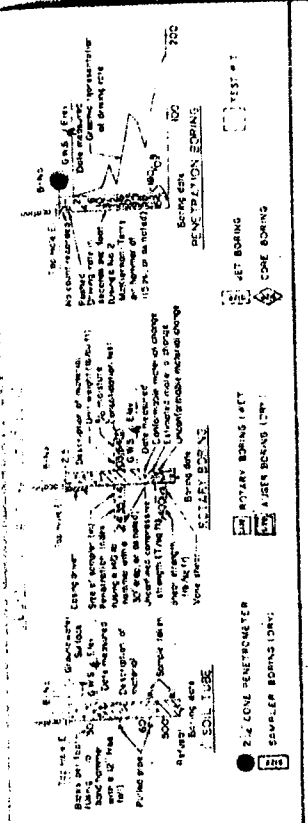

**BENCHMARK**  
BM E-938-1958 FOUND USC & GS BRASS  
CAP STAMPED E-938-1958 ON NORTHERLY  
END OF EAST CURB BR NO. 39 57R. ELEV.  
180.69 FT.

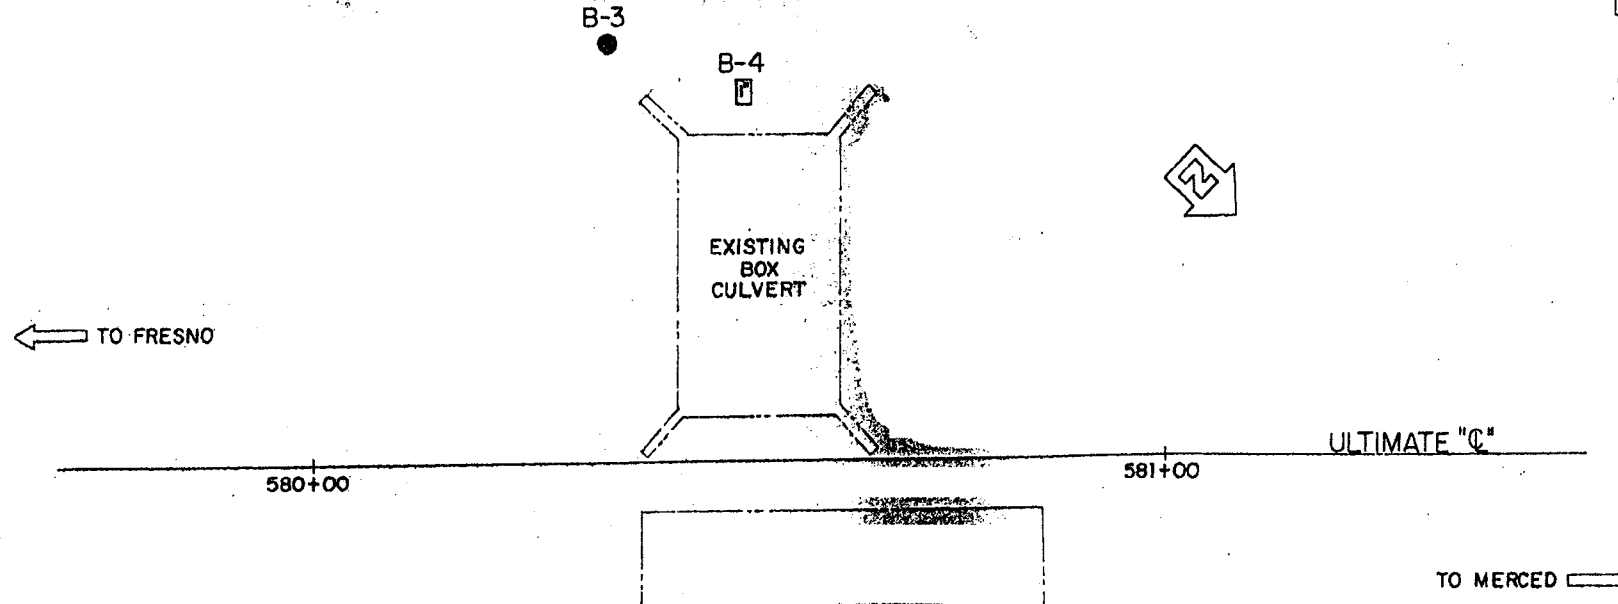

**PLAN**  
1" = 10'

To accompany plans dated 6-20-05

**DIVISION OF ENGINEERING SERVICES - GEOTECHNICAL SERVICES**  
As-Built Log of Test Borings sheet is considered an informational document only. As such, the State of California registration seal with signature, license number and registration certificate expiration date confirm that this is a true and accurate copy of the original document. This drawing is available and presented only for the convenience of any bidder, contractor or other interested party.

DIST.	COUNTY	ROUTE	KILOMETER POST-TOTAL PROJECT	Sheet No.	Total Sheets
10	Mer	99	16.4720.6	562	656

**CERTIFIED ENGINEERING GEOLOGIST**  
DATE: 12-14-85  
NAME: Claudio Ayala  
No. 2208  
Exp. 9-30-03  
STATE OF CALIFORNIA


**MILES CREEK OVERFLOW NO. 1**  
**LOG OF TEST BORINGS**

NOTE: A COPY OF THIS LOG OF TEST BORINGS IS AVAILABLE AT OFFICE OF STRUCTURE MAINTENANCE AND INVESTIGATIONS, SACRAMENTO, CALIFORNIA.

Boring	Station	Offset from C/L Rte. 99
B-1	112+84	21.0 m Rt.
B-2	112+68	24.0 m Rt.
B-3	112+65	52.5 m Lt.
B-4	112+70	50.5 m Lt.


Revisions made to this Log of Test Borings are the addition of the following table and notes:

Revision	Description
1	See the General Plan and/or Foundation Plan for Metric Stationing.
2	Structure Design produced the data presented in the table above. The data are the metric locations for the As-Built Test Borings referenced to the proposed new structure location. This table is presented on the As-Built Log of Test Borings sheet for the convenience of any bidder, contractor or other interested party.

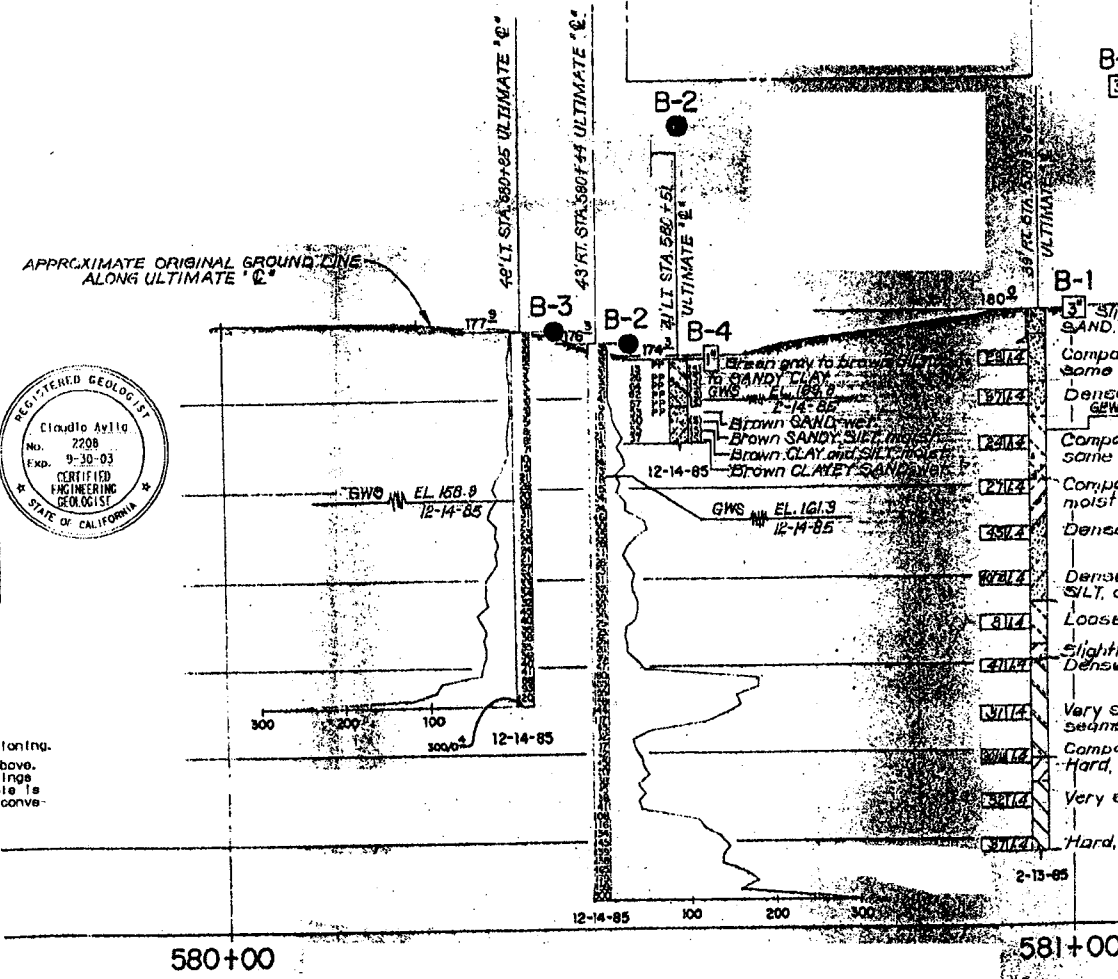


**PROFILE**  
1" = 10'

<b>GEOTECHNICAL BRANCH - TRANSPORTATION LABORATORY</b>				<b>State of CALIFORNIA</b>		<b>STRUCTURES - DESIGN</b>		<b>BRIDGE NO. 39-57</b>		<b>MILES CREEK OVERFLOW (WIDEN)</b>	
<b>DRAWN BY</b> LEON L. LOPKOV				<b>EXPAND. AUTHOR</b> 22013		<b>POST MILE</b>		<b>LOG OF TEST BORINGS</b>			
<b>CHECKED BY</b> 778				<b>ENGINEER</b> 22013		<b>REVISION DATES (PRELIMINARY STAGE ONLY)</b>		<b>REVISION DATES (PRELIMINARY STAGE ONLY)</b>			
<b>ORIGINAL SCALE IN INCHES FOR REDUCED PLANS</b>				<b>NO. 2295501</b>		<b>Discard print bearing earlier revision date</b>		<b>1/22/85 1/28/85 1/2/85</b>			

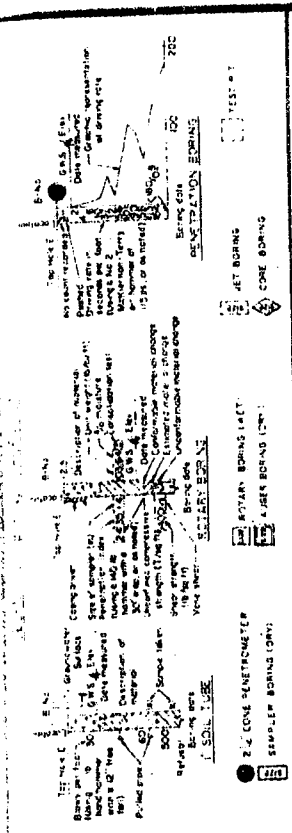

**BENCHMARK**  
BM E-938-1958 FOUND USC & GS BRASS  
CAP STAMPED E-938-1958 ON NORTHERLY  
END OF EAST CURB BRNO 39 57R. ELEV.  
180.69 FT.

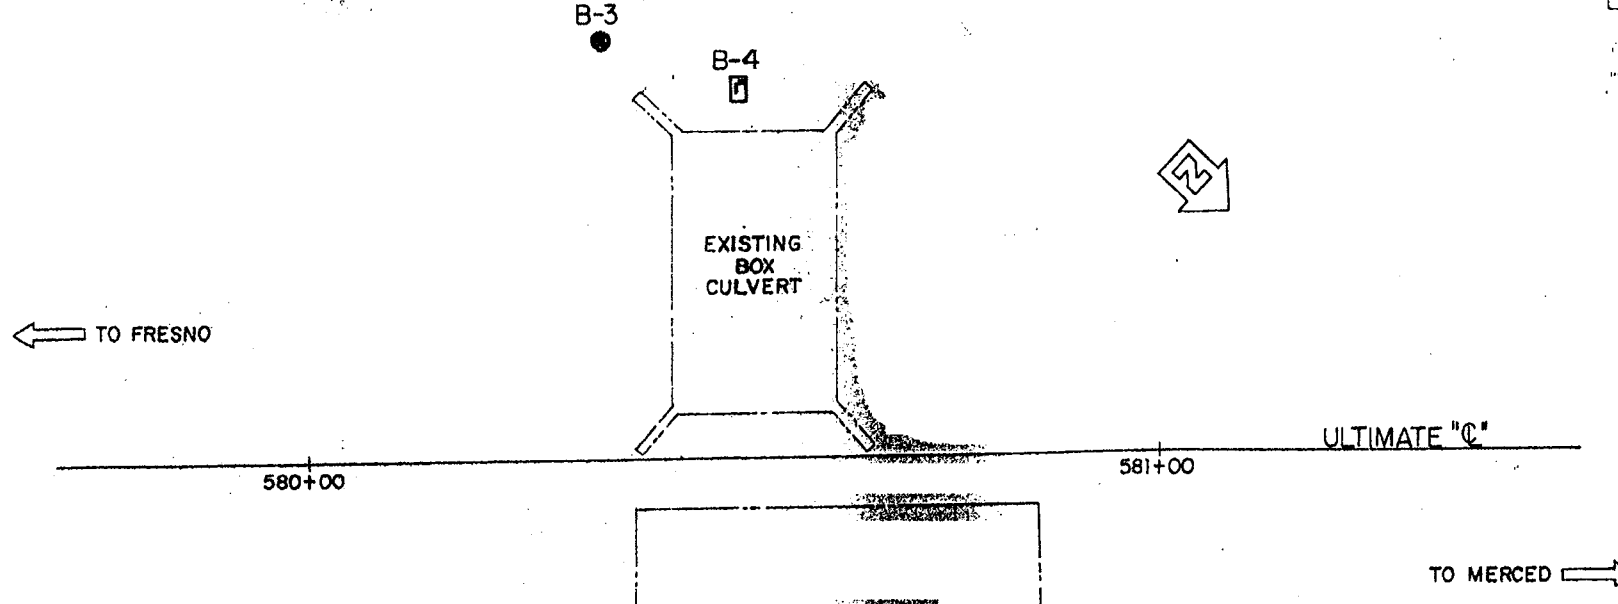

**PLAN**  
1" = 10'

To accompany plans dated 6-20-05

**DIVISION OF ENGINEERING SERVICES - GEOTECHNICAL SERVICES**  
As-Built Log of Test Borings shall be considered an informational document only. As such, the State of California registration seal with signature, license number and registration certificate expiration date confirm that this is a true and accurate copy of the original document. This drawing is available and presented only for the convenience of any bidder, contractor or other interested party.

DIST.	COUNTY	ROUTE	KILOMETER POST-TOTAL PROJECT	Sheet No.	Total Sheets
10	Mer	99	15.4720.6	562	656



**CERTIFIED ENGINEERING GEOLOGIST**  
DATE: \_\_\_\_\_  
**MILES CREEK OVERFLOW NO.1**  
**LOG OF TEST BORINGS**

NOTE: A COPY OF THIS LOG OF TEST BORINGS IS AVAILABLE AT OFFICE OF STRUCTURE MAINTENANCE AND INVESTIGATIONS, SACRAMENTO, CALIFORNIA

Boring	Station	Offset from C/L Rte. 99
B-1	112+84	21.0 m RT.
B-2	112+68	24.0 m RT.
B-3	112+65	52.5 m LT.
B-4	112+70	50.5 m LT.


Revisions made to this Log of Test Borings from the original 1985 Log of Test Borings are the addition of the following table and notes:

Revision	Description
1	Added Boring B-1
2	Added Boring B-2
3	Added Boring B-3
4	Added Boring B-4

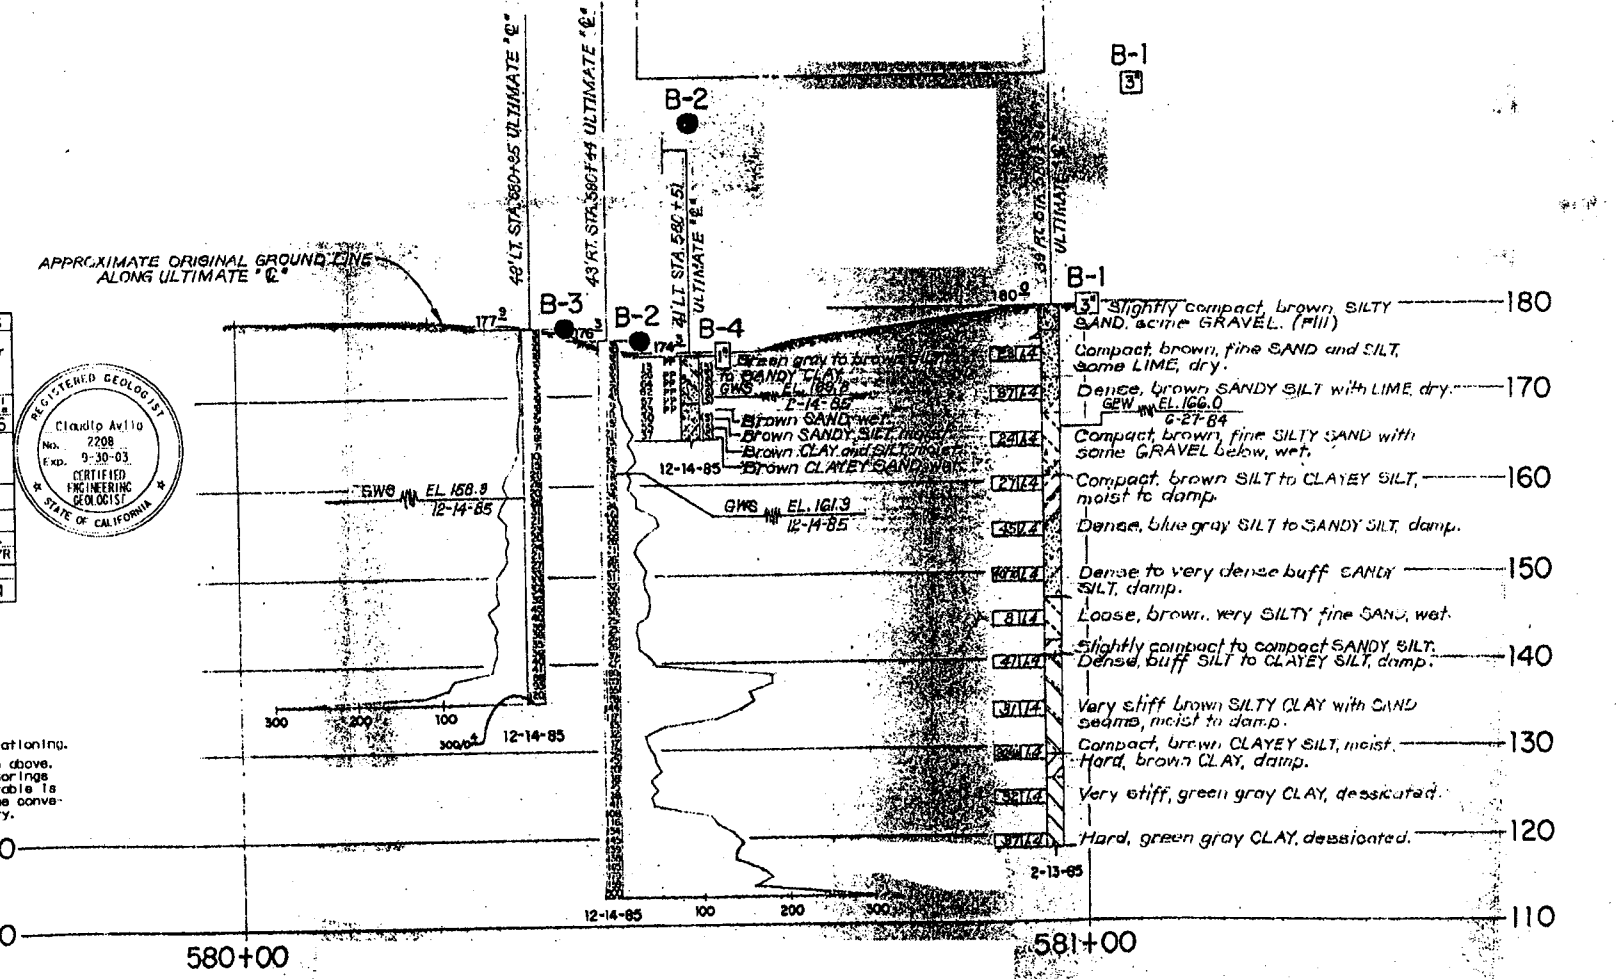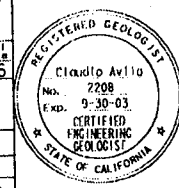


**PROFILE**  
1" = 10'

GEOTECHNICAL BRANCH - TRANSPORTATION LABORATORY				State of CALIFORNIA		STRUCTURES - DESIGN		MILES CREEK OVERFLOW (WIDEN)	
DRAWN BY: LEON L. LOPEZ		778		22015		BRIDGE NO. 39-57		LOG OF TEST BORINGS	
CHECKED BY: _____		PROJECT AGENT		ENGINEER		POST MILE			
ORIGINAL SCALE IN INCHES FOR REDUCED PLANS				SCALING		NO. 295501		REVISION DATES (PRELIMINARY STAGE ONLY)	
								1/22/05 1/23/05 1/24/05	

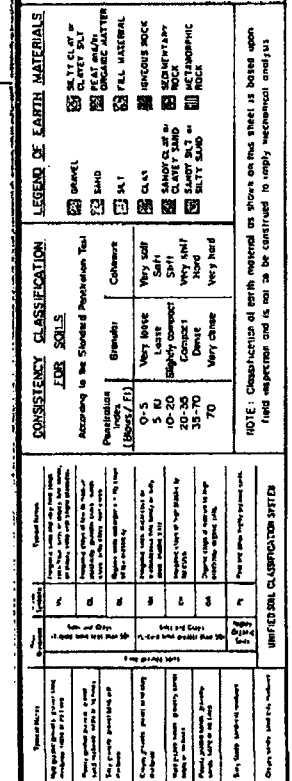

AG BULLETINS  
Contract No. 12-1-1  
Date Completed 12-1-1  
Document No. 12-1-1

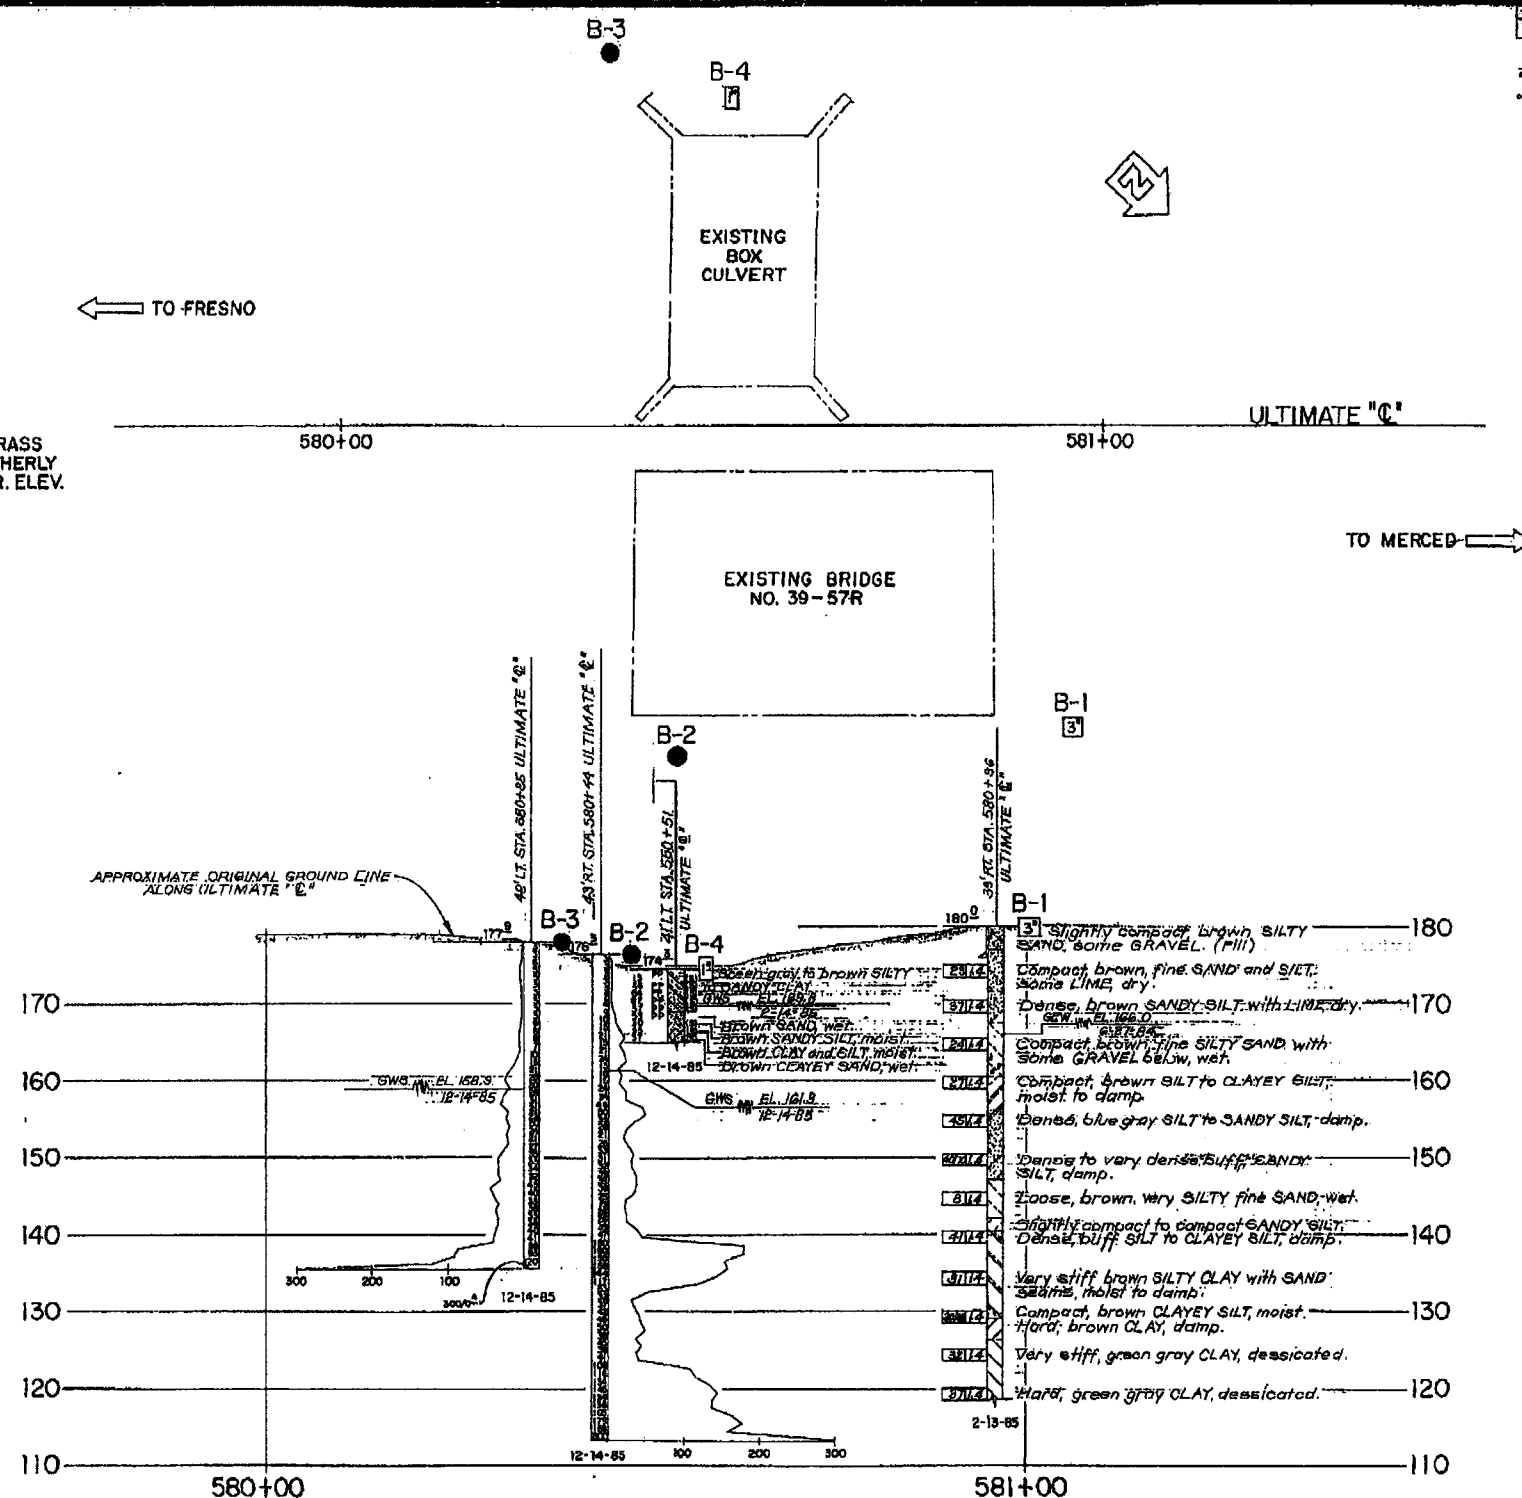



NO AS BUILT CORRECTION  
**AS BUILT**  
CORRECTIONS BY D.S. Lamb  
CONTRACT NO. 10-293504  
DATE 10/12/97  
WLW 2/21/90

<b>GEOTECHNICAL BRANCH - TRANSPORTATION LABORATORY</b>				State of <b>CALIFORNIA</b>			<b>STRUCTURES - DESIGN</b>		BRIDGE NO. <b>39-57</b>		<b>MILES CREEK OVERFLOW (WIDEN)</b>		
DRAWN BY <b>LEORY L. LOPEZ</b>		3/85		778		22013		CHARGE UNIT		EXPEND. AUTHOR		SPEC. DESIGN	
CHECKED BY		PROJECT: REDESIGN		CEC 9A		TIMBER		CEC 9A		PROJECT ENGINEER <i>Jim Leary</i>		19.815	
										REVISION DATE (PRELIMINARY STAGE ONLY)		7/85	
										CU 10		7	
										WO 293501		8	

I HEREBY CERTIFY THAT THIS IS A TRUE AND ACCURATE COPY OF THE ABOVE DOCUMENT TAKEN  
UNDER MY DIRECTION AND CONTROL ON THIS DATE IN SACRAMENTO, CALIFORNIA PURSUANT TO  
AUTHORIZATION BY THE DIRECTOR OF TRANSPORTATION.

Signature: Edward Clifford Title: SUPERVISOR OF  
MICROFILM SERVICES



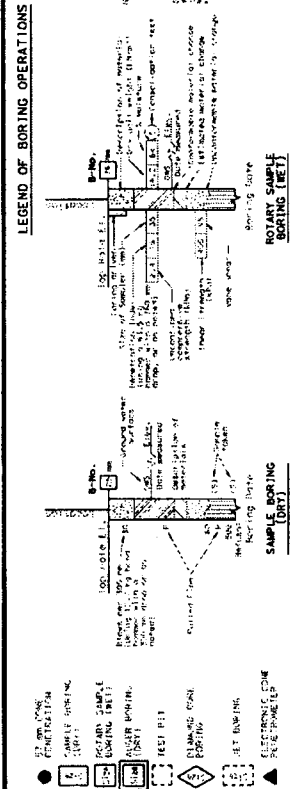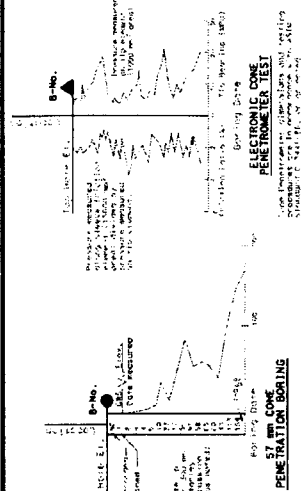

CONSISTENCY CLASSIFICATION FOR SOILS			
Very Loose	Loose	Medium Dense	Dense
Very Soft	Soft	Stiff	Very Stiff
Very Liquid	Liquid	Plastic	Very Plastic
Very Flowing	Flowing	Very Flowing	Very Flowing

# BENCH MARK

BM 1420 Elev. 55.07 m  
FND Rod in Monument Well

← To Fresno

C/L Rte. 99

N44°29'28"W  
110+00 +20 +40 +60 +80

To Merced →

02-1  
94 mm

PLAN  
1:400

53 m	53.92	02-1 94 mm	Lean CLAY (CL), stiff, very dark grayish brown, moist, rootlets. $qu \geq 431$ kPa, $Su > 48$ kPa	53 m
	15.95		SANDY lean CLAY (CL), stiff, grayish brown, moist. $Qu = 192$ kPa	
50 m	11.95		Lean CLAY with SAND (CL), stiff, grayish brown, wet. $Qu = 287$ kPa	50 m
	18.95		SILT with SAND (ML), medium dense, yellowish brown, moist, caliche.	
47 m	20.95		SANDY SILT (ML), medium dense, grayish brown, moist, coarse SAND to fine GRAVEL.	47 m
	20.95		SILTY SAND (SM), medium dense, strong brown, moist to wet, some fine GRAVEL layers, weak to moderate cementation.	
44 m	47.95		SILT (ML), medium dense, light yellowish brown, moist, caliche, weak to moderate cementation.	44 m
	12.95		Lean CLAY with SAND (CL), firm, light yellowish brown, moist to wet.	
41 m	21.95		25 mm thick layer of very soft CLAY at elev. 46.720m. $Su = 38$ kPa	41 m
	14.95		SANDY SILT (ML), medium dense, light yellowish brown, wet.	
38 m	21.95		Well graded fine to coarse SAND with SILT (SW-SM), dense, dark yellowish brown, wet.	38 m
	21.95		SANDY SILT (ML), dense, yellowish brown, moist to wet, weak to moderate cementation.	
35 m	15.95		SANDY fat CLAY (CH), stiff, yellowish brown, moist to wet, weak to moderate cementation. $Qu = 240 - 287$ kPa	35 m
	15.95		$Qu = 192 - 383$ kPa	
32 m	6.95		SILTY fine SAND (SM), medium dense, dark yellowish brown, moist to wet.	32 m
	27.95		Fat CLAY with SAND (CH), very stiff, light olive brown, moist to wet.	
29 m	24.95		$Qu = 263$ kPa	29 m
	24.95		Moderate cementation. $qu = 287 - 431$ kPa, $Su = 62$ kPa	
26 m	59.95		CLAYEY SAND (SC), medium dense, light yellowish brown, moist to wet, moderate cementation. $Qu = 192$ kPa	26 m
	40.95		Lean CLAY (CL), very stiff, light yellowish brown, moist to wet, moderate cementation. $Qu = 287 - 431$ kPa, $Su = 67$ kPa	
23 m	45.95		$Qu = 311$ kPa	23 m
			$Qu = 287$ kPa, $Su = 43$ kPa	
			$Qu = 353$ kPa	
			$Qu = 96$ kPa	
			Poorly graded fine to medium SAND with SILT, medium dense, grayish brown, moist to wet.	
			Well graded fine to coarse SAND (SW), medium dense, yellowish brown, wet, some fine GRAVEL.	
			SANDY lean CLAY (CL), soft, grayish brown, wet.	
			Poorly graded medium SAND with SILT (SP-SM), medium dense, dark grayish brown, wet.	
			SILT (ML), dense, grayish brown, moist to wet, some CLAY.	
			Poorly graded fine to medium SAND with SILT (SP-SM), dense, dark grayish brown, wet.	
			SILTY SAND (SM), dense, grayish brown, wet.	

## Notes:

1. Groundwater elevation was not measured. However, groundwater was measured at an elev. 51.70 m at the nearby proposed Owen Creek Bridge (39-0006)
2. Standard Penetration test were obtained using an Automatic Dietrich hammer.
3.  $qu$ =unconfined compressive strength using a pocket penetrometer.
4.  $Su$ =undrained shear strength using a torvane.

## PROFILE

HOR. 1:100  
VER. 1:100

ALL DIMENSIONS ARE IN METERS UNLESS OTHERWISE SHOWN

ENGINEERING SERVICES		GEOTECHNICAL SERVICES		FIELD INVESTIGATION BY:		STATE OF CALIFORNIA DEPARTMENT OF TRANSPORTATION		DIVISION OF STRUCTURES STRUCTURE DESIGN 6		BRIDGE NO. 39-0007R/L		MILES CREEK BRIDGE	
DRAWN BY	F. Nguyen 5/03	CHECKED BY	C. Avila	J. Kaump		CU 10 EA 363111		KILOMETER POST 17.43		LOG OF TEST BORINGS 1 of 2		SHEET NO. 14	
ORIGINAL SCALE IN MILLIMETERS FOR REDUCED PLANS										DISREGARD PRINTS BEARING EARLIER REVISION DATES		DATE PLOTTED: 11-13-04	

TO FRESNO ←

EXISTING BRIDGE  
No. 39-07 L

EXISTING BRIDGE  
No. 39-07 R

TO MERCED →

PLAN  
1" = 10'

**BENCH MARK**  
BM# 1 Elev. 101.88  
Point shot marked "20"  
on west curb near E  
Bridge # 39-07 L

BM# 2 Elev. 100.12  
Brass cap on west end  
of north curb Bridge  
# 39-07 R (BM 11.0)

To accompany plans dated 6-20-05

**DIVISION OF ENGINEERING SERVICES - GEOTECHNICAL SERVICES**

As-Built Log of Test Borings sheet is considered an informational document only. As such, the State of California registration seal with signature, license number and registration certificate expiration date confirm that this is a true and accurate copy of the original document. This drawing is available and presented only for the convenience of any bidder, contractor or other interested party.

DIST.	COUNTY	ROUTE	KILOMETER POST-TOTAL PROJECT	Sheet No.	Total Sheets
10	Mer	99	16.4/20.6	548	656

CERTIFIED ENGINEERING GEOLOGIST

**MILES CREEK BRIDGE**  
**LOG OF TEST BORINGS 2 OF 2**


NOTE: A COPY OF THIS LOG OF TEST BORINGS IS AVAILABLE AT OFFICE OF STRUCTURE MAINTENANCE AND INVESTIGATIONS, SACRAMENTO, CALIFORNIA

CU I.D.	BRIDGE NO.
EA 363101	39-0007R/L

Revisions made to this Log of Test Borings from the original 1984 Log of Test Borings are the addition of the following table and notes:


Boring	Station	Offset from C/L Rte. 99
B-1	110+28	18.0 m. Lt.
B-2	110+60	22.5 m. Lt.

Notes:  
1. See the General Plan and/or Foundation Plan for Metric Stationing.  
2. Structure Design produced the data presented in the table above. The data are the metric locations for the As-Built Test Borings referenced to the proposed new structure location. This table is presented on the As-Built Log of Test Boring sheet for the convenience of any bidder, contractor or other interested party.

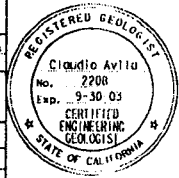

180  
170  
160  
150  
140  
130  
120  
110  
100

Original ground line along Rte 99

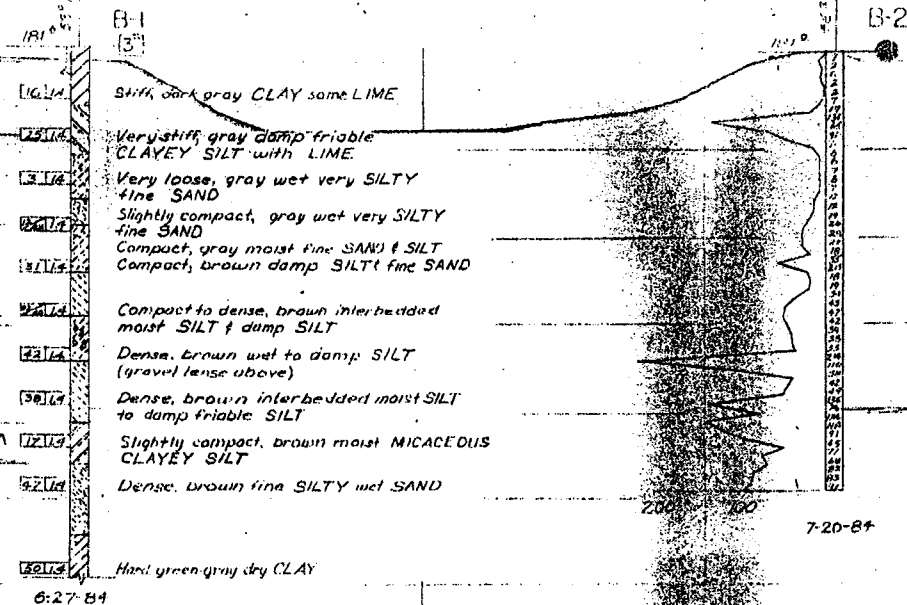

**PROFILE**  
1" = 10'

**GEOTECHNICAL BRANCH - TRANSPORTATION LABORATORY**

DRAWN BY: J. DONALDSON  
CHECKED BY: [Signature]  
PROJECT: [Blank]  
DATE: 7/13

State of CALIFORNIA  
DEPARTMENT OF TRANSPORTATION

STRUCTURES - DESIGN  
BRIDGE NO. 39-07R/L  
POST MILE 10.83








MILES CREEK BRIDGE (WIDEN)  
LOG OF TEST BORINGS

ORIGINAL SCALE IN INCHES FOR REDUCED PLANS  
CU 10200  
WO 293501

REVISION DATES (PER LHM 7-1)

NO.	DATE	DESCRIPTION

TRANSFER DATE: 4-5-2007  
FIELD CORRECTION DATE: 6-4-2007  
CORRECTIONS TRANSFERRED BY: SP  
FIELD CORRECTIONS BY: P.M.O.S.  
AS BUILT CORRECTIONS

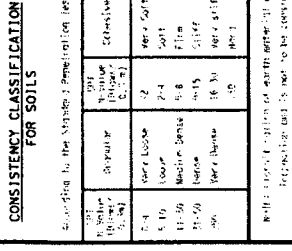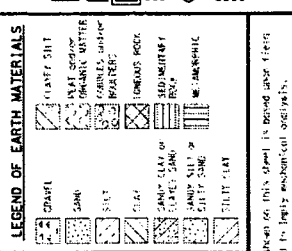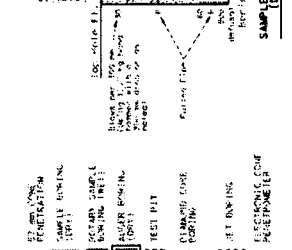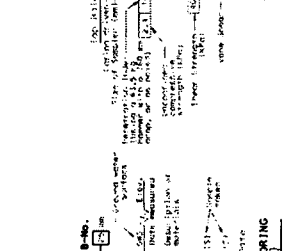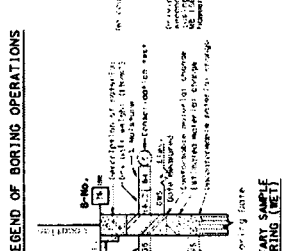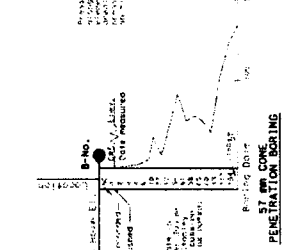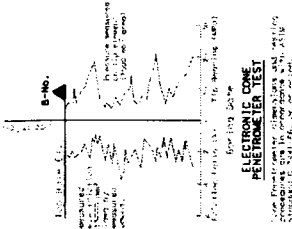

BENCH MARK

BM 1420 Elev. 55.07 m  
FND Rod in Monument Well

To Fresno

C/L Rte. 99

N44°29'28"W

To Merced



DIST	COUNTY	ROUTE	KILOMETER POST TOTAL PROJECT	SHEET No	TOTAL SHEETS
10	Mer	99	16.4/20.6	547	656

6-20-05  
PLANS APPROVAL DATE

6-4-03  
REGISTERED GEOLOGIST

6-20-05  
PLANS APPROVAL DATE

6-4-03  
REGISTERED GEOLOGIST

6-20-05  
PLANS APPROVAL DATE

6-4-03  
REGISTERED GEOLOGIST

02-1  
94 mm

PLAN  
1:400

53 m	53.92	94 mm	Lean CLAY (CL), stiff, very dark grayish brown, moist, rootlets. qu > 431 kPa, Su > 48 kPa	53 m
	15 35		SANDY lean CLAY (CL), stiff, grayish brown, moist. Qu = 192 kPa	
50 m	41 35		Lean CLAY with SAND (CL), stiff, grayish brown, wet. Qu = 287 kPa	50 m
	18 35		SILT with SAND (ML), medium dense, yellowish brown, moist, caliche.	
	20 35		SANDY SILT (ML), medium dense, grayish brown, moist, coarse SAND to fine GRAVEL.	
47 m	20 35		SILTY SAND (SM), medium dense, strong brown, moist to wet, some fine GRAVEL layers, weak to moderate cementation.	47 m
	20 35		SILT (ML), medium dense, light yellowish brown, moist, caliche, weak to moderate cementation.	
	20 35		Lean CLAY with SAND (CL), firm, light yellowish brown, moist to wet.	
44 m	47 35		25 mm thick layer of very soft CLAY at elev. 46.720m. Su = 38 kPa	44 m
	12 35		SANDY SILT (ML), medium dense, light yellowish brown, wet.	
	12 35		Well graded fine to coarse SAND with SILT (SW-SM), dense, dark yellowish brown, wet.	
41 m	21 35		SANDY SILT (ML), dense, yellowish brown, moist to wet, weak to moderate cementation.	41 m
	14 35		SANDY fat CLAY (CH), stiff, yellowish brown, moist to wet, weak to moderate cementation. Qu = 240 - 287 kPa	
	14 35		Qu = 192 - 383 kPa	
38 m	21 35		SILTY fine SAND (SM), medium dense, dark yellowish brown, moist to wet.	38 m
	21 35		Fat CLAY with SAND (CH), very stiff, light olive brown, moist to wet.	
	14 35		Qu = 263 kPa	
	14 35		Moderate cementation. qu = 287 - 431 kPa, Su = 62 kPa	
35 m	15 35		CLAYEY SAND (SC), medium dense, light yellowish brown, moist to wet, moderate cementation. Qu = 192 kPa	35 m
	15 35		Lean CLAY (CL), very stiff, light yellowish brown, moist to wet, moderate cementation. Qu = 287 - 431 kPa, Su = 67 kPa	
	15 35		Qu = 311 kPa	
	15 35		Qu = 287 kPa, Su = 43 kPa	
32 m	6 35		Qu = 353 kPa	32 m
	27 35		Qu = 96 kPa	
	27 35		Poorly graded fine to medium SAND with SILT, medium dense, grayish brown, moist to wet.	
29 m	24 35		Well graded fine to coarse SAND (SW), medium dense, yellowish brown, wet, some fine GRAVEL.	29 m
	24 35		SANDY lean CLAY (CL), soft, grayish brown, wet.	
26 m	39 35		Poorly graded medium SAND with SILT (SP-SM), medium dense, dark grayish brown, wet.	26 m
	40 35		SILT (ML), dense, grayish brown, moist to wet, some CLAY.	
	40 35		Poorly graded fine to medium SAND with SILT (SP-SM), dense, dark grayish brown, wet.	
23 m	45 35		SILTY SAND (SM), dense, grayish brown, wet.	23 m

Notes:

- Groundwater elevation was not measured. However, groundwater was measured at an elev. 51.70 m at the nearby proposed Owen Creek Bridge (39-0006).
- Standard Penetration test were obtained using an Automatic Dietrich hammer.
- qu=unconfined compressive strength using a pocket penetrometer.
- Su=undrained shear strength using a torvane.

PROFILE

HOR. 1:100  
VER. 1:100

ALL DIMENSIONS ARE IN METERS UNLESS OTHERWISE SHOWN


ENGINEERING SERVICES		GEOTECHNICAL SERVICES		FIELD INVESTIGATION BY:		STATE OF CALIFORNIA		DIVISION OF STRUCTURES		BRIDGE NO.		MILES CREEK BRIDGE	
DRAWN BY: F. Nguyen 5/03		CHECKED BY: C. Avila		J. Kaump		DEPARTMENT OF TRANSPORTATION		STRUCTURE DESIGN 6		39-0007R/L		LOG OF TEST BORINGS 1 of 2	
KILOMETER POST		17.43		CU 10		EA 363111		DISREGARD PRINTS BEARING		EARLIER REVISION DATES		14 15	



10 Mar 59 99 282,257/11.4 79 95  
Robert L. Gagnier #165  
February 18, 1986

LEGEND OF BORING OPERATIONS  
...  
LEGEND OF EARTH MATERIALS  
...  
CONSISTENCY CLASSIFICATION  
...  
UNIFIED SOIL CLASSIFICATION SYSTEM  
...


**BENCH MARK**  
6.4' Elev 104.38  
Point just marked "20"  
on west curb near E  
Bridge # 39-07L  
BM # E-79B Elev 150.12  
Bench cap @ west end  
of north curb. Bridge  
# 39-57R (PM 11.0)

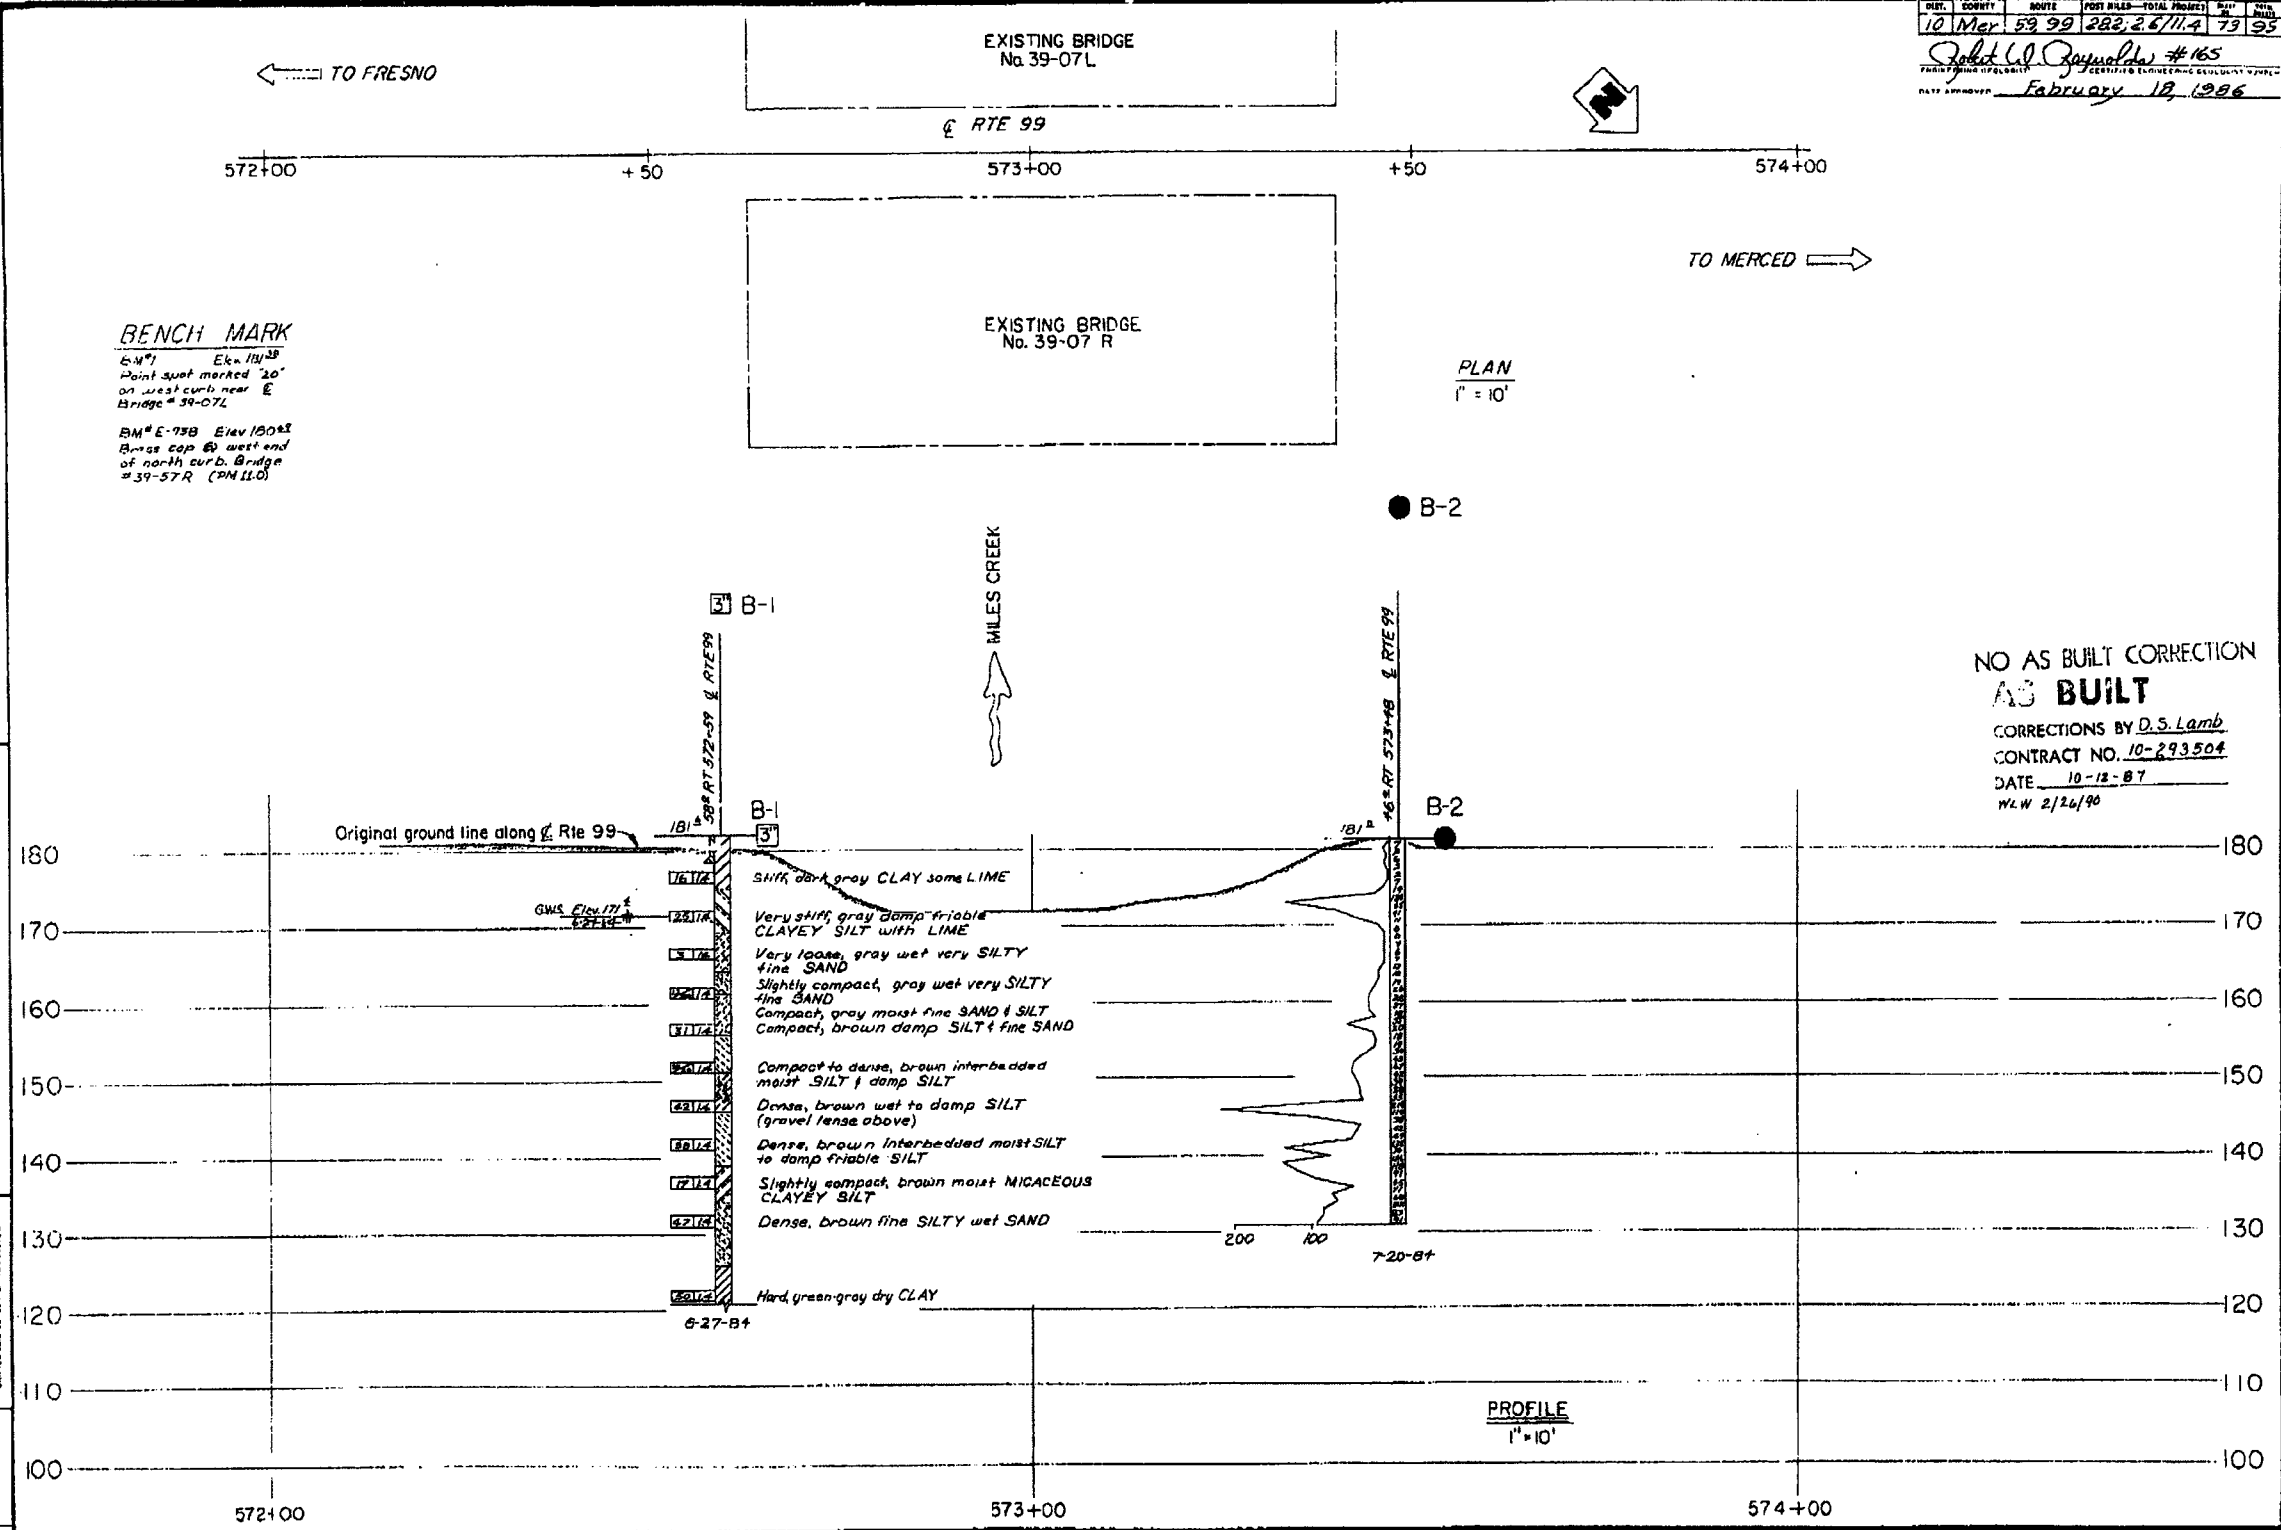

NO AS BUILT CORRECTION  
**AS BUILT**  
CORRECTIONS BY D.S. Lamb  
CONTRACT NO. 10-293504  
DATE 10-18-87  
W/LW 2/26/90

<b>GEOTECHNICAL BRANCH - TRANSPORTATION LABORATORY</b>				<b>State of CALIFORNIA</b>		<b>STRUCTURES - DESIGN</b>		<b>BRIDGE NO. 39-07</b>		<b>MILES CREEK BRIDGE (WIDEN)</b>	
DRAWN BY: J. DONALDSON 4/84				DEPARTMENT OF TRANSPORTATION		DESIGNED BY: J. F. Hagan 7/78		POST MILE 10.83		<b>LOG OF TEST BORINGS</b>	
CHECKED BY: R. Hagan				PROJECT NO. 10-293504		DATE: 1-12-90		SUPERVISOR OF MICROFILM SERVICE		SHEET 7 OF 8	


I HEREBY CERTIFY THAT THIS IS A TRUE AND ACCURATE COPY OF THE ABOVE DOCUMENT TAKEN UNDER MY DIRECTION AND CONTROL ON THIS DATE IN SACRAMENTO, CALIFORNIA PURSUANT TO AUTHORIZATION BY THE DIRECTOR OF TRANSPORTATION.  
4-12-90 [Signature] SUPERVISOR OF MICROFILM SERVICE

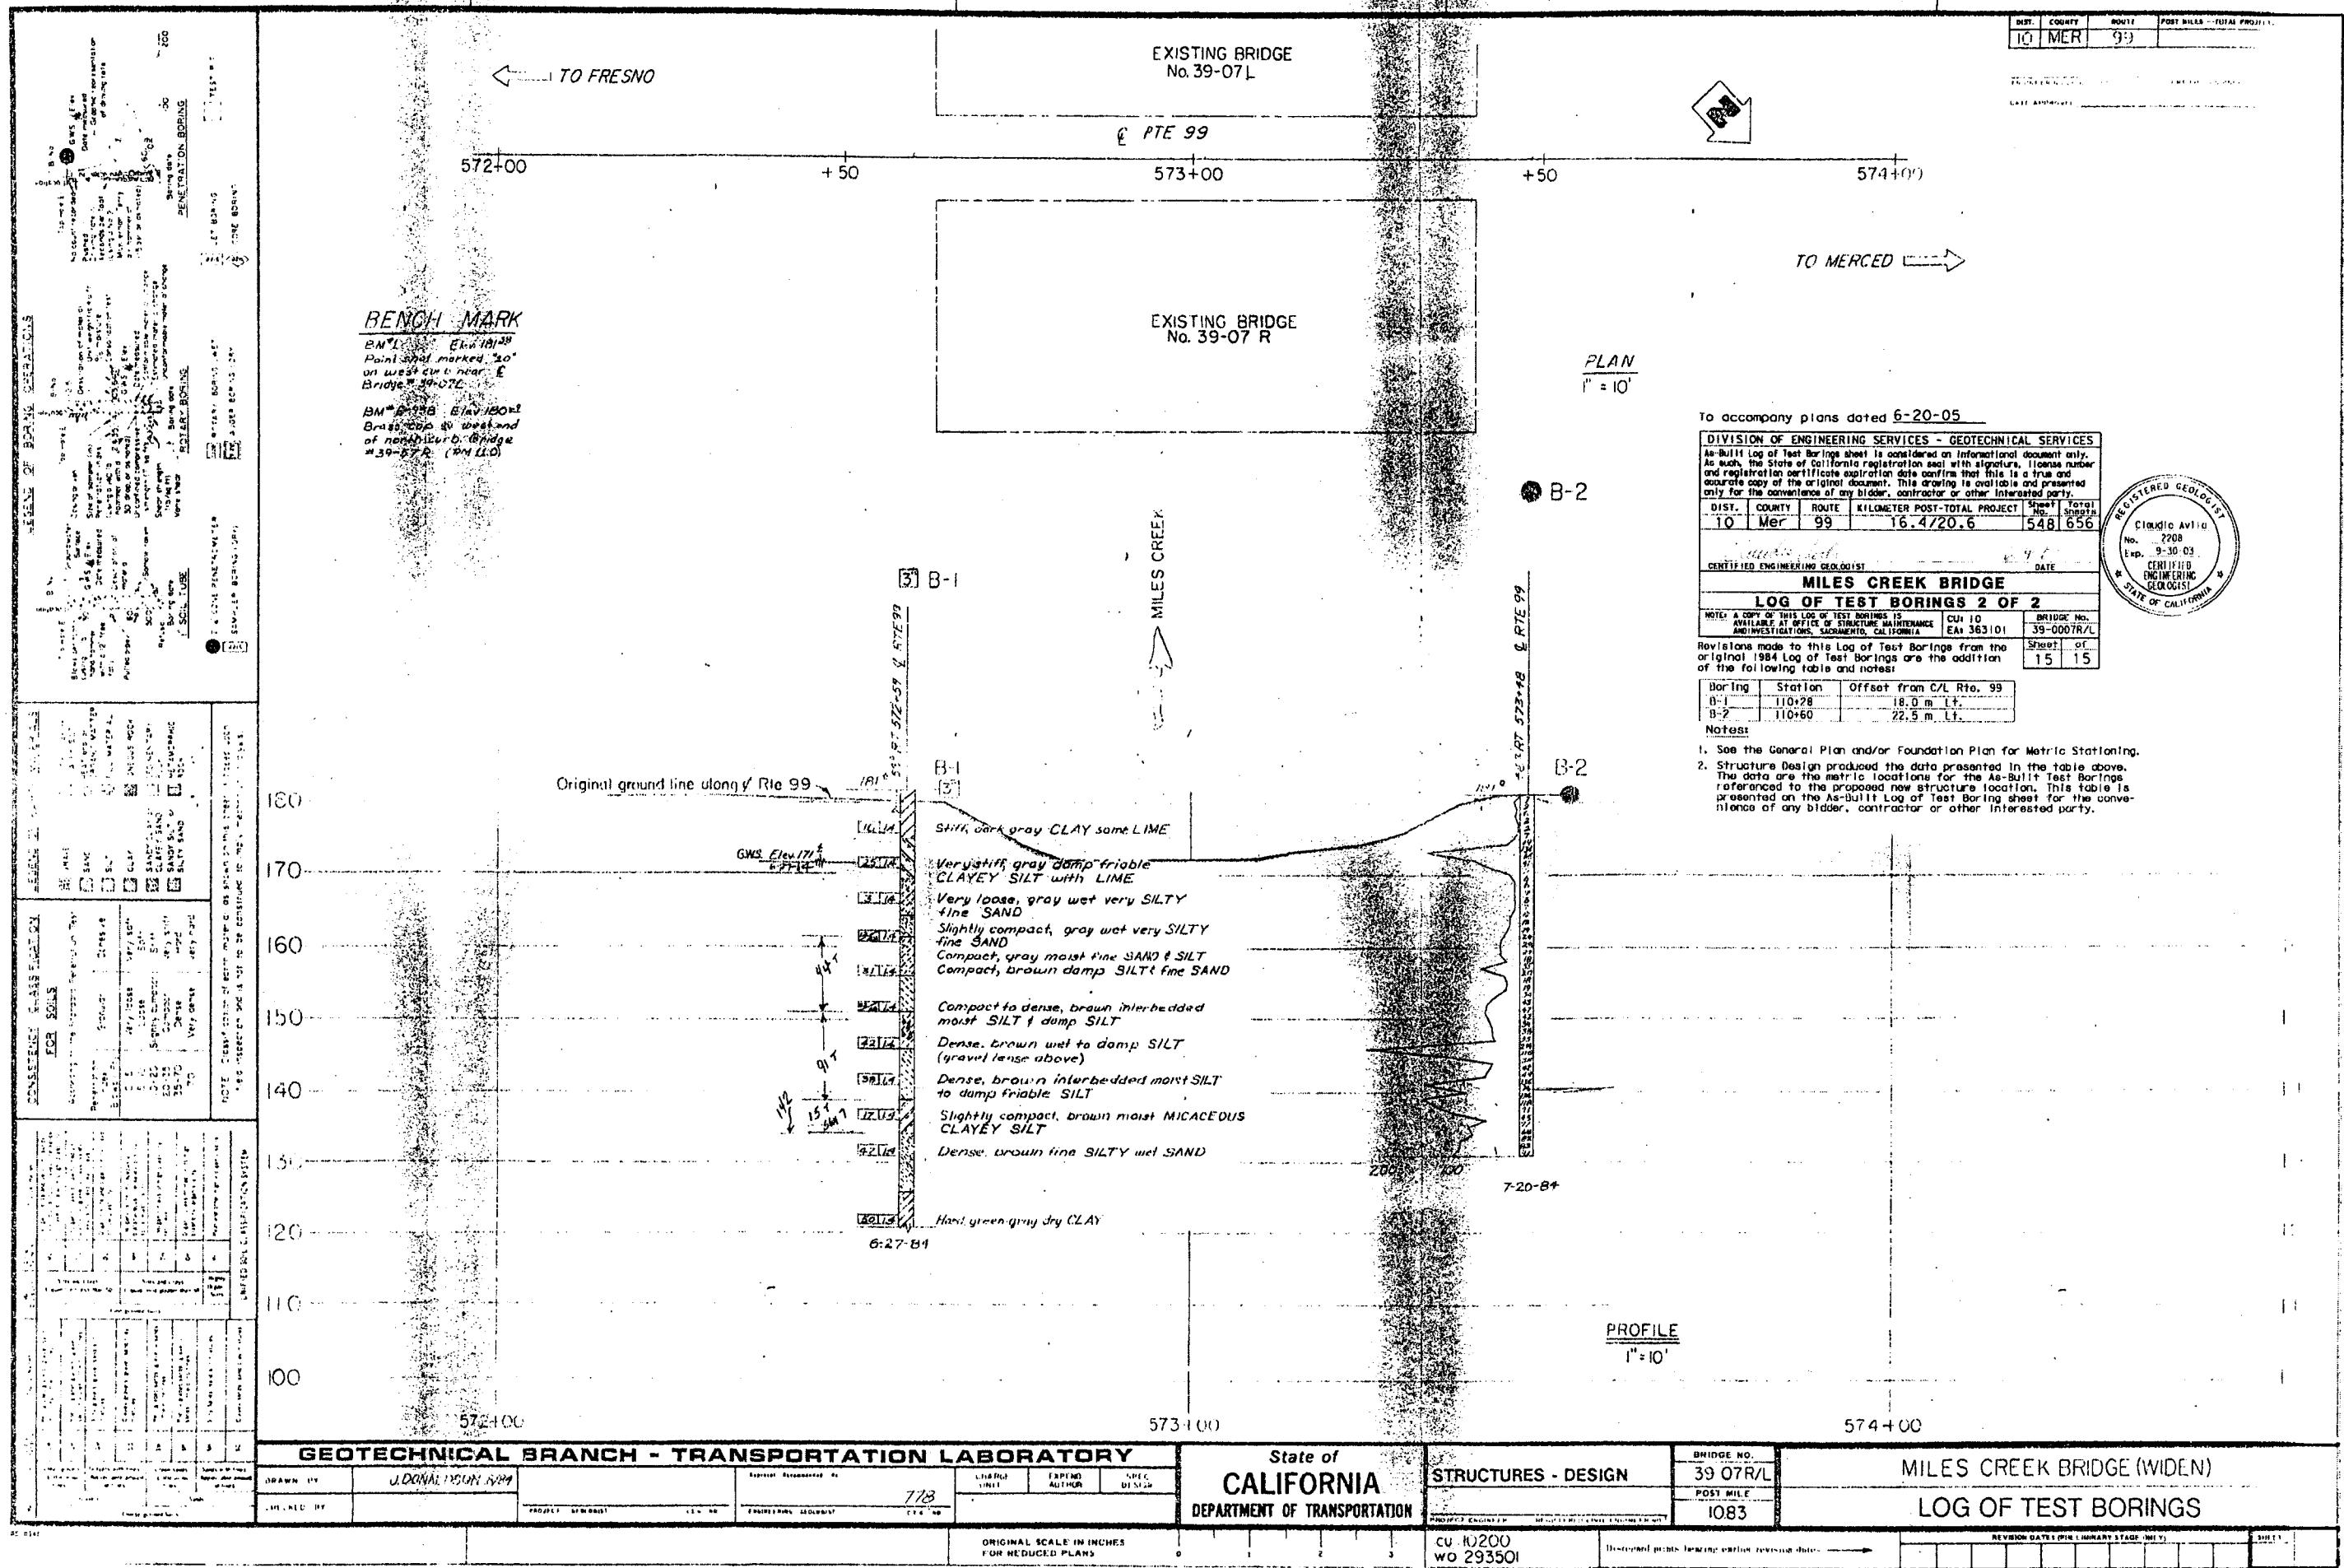

**BENCH MARK**  
BM 11148 Elev 111.48  
Point 30' marked 20'  
on west curb near E  
Bridge #39-072  
  
BM 11150 Elev 111.50  
Brass cap to west end  
of north curb Bridge  
#39-072 (BM 1110)

To accompany plans dated 6-20-05

DIVISION OF ENGINEERING SERVICES - GEOTECHNICAL SERVICES				
As-Built Log of Test Borings sheet is considered an informational document only. As such, the State of California registration seal with signature, license number and registration certificate expiration date confirm that this is a true and accurate copy of the original document. This drawing is available and presented only for the convenience of any bidder, contractor or other interested party.				
DIST.	COUNTY	ROUTE	KILOMETER POST-TOTAL PROJECT	Sheet No. of
10	Mer	99	16.47/20.6	548/656
DATE				
CERTIFIED ENGINEERING GEOLOGIST				
MILES CREEK BRIDGE				
LOG OF TEST BORINGS 2 OF 2				
NOTE: A COPY OF THIS LOG OF TEST BORINGS IS AVAILABLE AT OFFICE OF STRUCTURE MAINTENANCE AND INVESTIGATIONS, SACRAMENTO, CALIFORNIA				
Revisions made to this Log of Test Borings from the original 1984 Log of Test Borings are the addition of the following table and notes:				
Boring	Station	Offset from C/L Rto. 99		
B-1	110+28	18.0 m. L.		
B-2	110+60	22.5 m. L.		
Notes:				
1. See the General Plan and/or Foundation Plan for Metric Stationing.				
2. Structure Design produced the data presented in the table above. The data are the metric locations for the As-Built Test Borings referenced to the proposed new structure location. This table is presented on the As-Built Log of Test Boring sheet for the convenience of any bidder, contractor or other interested party.				

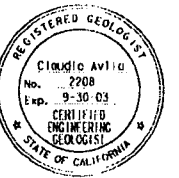

GEOTECHNICAL BRANCH - TRANSPORTATION LABORATORY				State of CALIFORNIA		STRUCTURES - DESIGN		MILES CREEK BRIDGE (WIDEN)	
DRAWN BY	J. DONALDSON 1/8/94	PROJECT	39-072	CHARLED UNIT	EXPEND AUTHOR	BRIDGE NO.	39 072/L	POST MILE	1083
DESIGNED BY		PROJECT	39-072	CHARLED UNIT	EXPEND AUTHOR	BRIDGE NO.	39 072/L	POST MILE	1083
ORIGINAL SCALE IN INCHES FOR REDUCED PLANS				CU 10200 WO 293501		REVISION DATES (PER LITERATURE STAGE - ONLY)			

REFERENCE: CALTRANS SOIL & ROCK LOGGING, CLASSIFICATION, AND PRESENTATION MANUAL (JUNE 2007)

GROUP SYMBOLS AND NAMES			
Graphic/Symbol	Group Names	Graphic/Symbol	Group Names
	Well-graded GRAVEL		Lean CLAY
	Well-graded GRAVEL with SAND		Lean CLAY with SAND
	Poorly graded GRAVEL		Lean CLAY with GRAVEL
	Poorly graded GRAVEL with SAND		SANDY lean CLAY
	Well-graded GRAVEL with SILT		GRAVELLY lean CLAY
	Well-graded GRAVEL with SILT and SAND		GRAVELLY lean CLAY with SAND
	Well-graded GRAVEL with CLAY		SILTY CLAY
	Well-graded GRAVEL with CLAY and SAND		SILTY CLAY with SAND
	Well-graded GRAVEL with CLAY and SAND		SILTY CLAY with GRAVEL
	Well-graded GRAVEL with CLAY and SAND		SANDY SILTY CLAY
	Poorly graded GRAVEL with SILT		GRAVELLY SILTY CLAY
	Poorly graded GRAVEL with SILT and SAND		GRAVELLY SILTY CLAY with SAND
	Poorly graded GRAVEL with CLAY		SANDY SILT
	Poorly graded GRAVEL with CLAY and SAND		SANDY SILT with GRAVEL
	SILTY GRAVEL		GRAVELLY SILT
	SILTY GRAVEL with SAND		GRAVELLY SILT with SAND
	CLAYEY GRAVEL		ORGANIC lean CLAY
	CLAYEY GRAVEL with SAND		ORGANIC lean CLAY with SAND
	SILTY, CLAYEY GRAVEL		ORGANIC lean CLAY with GRAVEL
	SILTY, CLAYEY GRAVEL with SAND		SANDY ORGANIC lean CLAY
	Well-graded SAND		SANDY ORGANIC lean CLAY with GRAVEL
	Well-graded SAND with GRAVEL		GRAVELLY ORGANIC lean CLAY
	Poorly graded SAND		GRAVELLY ORGANIC lean CLAY with SAND
	Poorly graded SAND with GRAVEL		ORGANIC SILT
	Well-graded SAND with SILT		ORGANIC SILT with SAND
	Well-graded SAND with SILT and GRAVEL		ORGANIC SILT with GRAVEL
	Well-graded SAND with CLAY		SANDY ORGANIC SILT
	Well-graded SAND with CLAY and GRAVEL		SANDY ORGANIC SILT with GRAVEL
	Well-graded SAND with CLAY and GRAVEL		GRAVELLY ORGANIC SILT
	Well-graded SAND with CLAY and GRAVEL		GRAVELLY ORGANIC SILT with SAND
	Poorly graded SAND with SILT		ORGANIC fat CLAY
	Poorly graded SAND with SILT and GRAVEL		ORGANIC fat CLAY with SAND
	Poorly graded SAND with CLAY		ORGANIC fat CLAY with GRAVEL
	Poorly graded SAND with CLAY and GRAVEL		SANDY ORGANIC fat CLAY
	Poorly graded SAND with CLAY and GRAVEL		SANDY ORGANIC fat CLAY with GRAVEL
	Poorly graded SAND with CLAY and GRAVEL		GRAVELLY ORGANIC fat CLAY
	SILTY SAND		GRAVELLY ORGANIC fat CLAY with SAND
	SILTY SAND with GRAVEL		ORGANIC elastic SILT
	CLAYEY SAND		ORGANIC elastic SILT with SAND
	CLAYEY SAND with GRAVEL		ORGANIC elastic SILT with GRAVEL
	SILTY, CLAYEY SAND		SANDY ORGANIC elastic SILT
	SILTY, CLAYEY SAND with GRAVEL		SANDY ORGANIC elastic SILT with GRAVEL
	PEAT		GRAVELLY ORGANIC elastic SILT
	PEAT		GRAVELLY ORGANIC elastic SILT with SAND
	COBBLES		ORGANIC SOIL
	BOULDERS		ORGANIC SOIL with SAND
	BOULDERS		ORGANIC SOIL with GRAVEL
	BOULDERS		SANDY ORGANIC SOIL
	BOULDERS		SANDY ORGANIC SOIL with GRAVEL
	BOULDERS		GRAVELLY ORGANIC SOIL
	BOULDERS		GRAVELLY ORGANIC SOIL with SAND
	BOULDERS		GRAVELLY ORGANIC SOIL with SAND

#### FIELD AND LABORATORY TESTING

- (C) Consolidation (ASTM D 2435)
- (CL) Collapse Potential (ASTM D 5333)
- (CP) Compaction Curve (CTM 216)
- (CR) Corrosivity Testing (CTM 643, CTM 422, CTM 417)
- (CU) Consolidated Undrained Triaxial (ASTM D 4767)
- (DS) Direct Shear (ASTM D 3080)
- (EI) Expansion Index (ASTM D 4829)
- (M) Moisture Content (ASTM D 2216)
- (OC) Organic Content-% (ASTM D 2974)
- (P) Permeability (CTM 220)
- (PA) Particle Size Analysis (ASTM D 422)
- (PI) Plasticity Index (AASHTO T 90)
- (PL) Liquid Limit (AASHTO T 89)
- (PL) Point Load Index (ASTM D 5731)
- (PM) Pressure Meter
- (PP) Pocket Penetrometer
- (R) R-Value (CTM 301)
- (SE) Sand Equivalent (CTM 217)
- (SG) Specific Gravity (AASHTO T 100)
- (SL) Shrinkage Limit (ASTM D 427)
- (SW) Swell Potential (ASTM D 4546)
- (TV) Pocket Torvane
- (UC) Unconfined Compression-Soil (ASTM D 2166)
- (UC) Unconfined Compression-Rock (ASTM D 2938)
- (UU) Unconsolidated Undrained Triaxial (ASTM D 2850)
- (UW) Unit Weight (ASTM D 4767)
- (VS) Vane Shear (AASHTO T 223)

#### APPARENT DENSITY OF COHESIONLESS SOILS

Description	SPT N <sub>60</sub> (Blows / 12 inches)
Very loose	0 - 4
Loose	5 - 10
Medium Dense	11 - 30
Dense	31 - 50
Very Dense	> 50

#### MOISTURE

Description	Criteria
Dry	Absence of moisture, dusty, dry to the touch
Moist	Damp but no visible water
Wet	Visible free water, usually soil is below water table

#### PERCENT OR PROPORTION OF SOILS

Description	Criteria
Trace	Particles are present but estimated to be less than 5%
Few	5 to 10%
Little	15 to 25%
Some	30 to 45%
Mostly	50 to 100%

#### PARTICLE SIZE

Description	Size
Boulder	> 12"
Cobble	3" to 12"
Gravel	Coarse 3/4" to 3"
	Fine No. 4 to 3/4"
Sand	Coarse No. 10 to No. 4
	Medium No. 40 to No. 10
	Fine No. 200 to No. 40

#### CEMENTATION

Description	Criteria
Weak	Crumbles or breaks with handling or little finger pressure.
Moderate	Crumbles or breaks with considerable finger pressure.
Strong	Will not crumble or break with finger pressure.

DIST	COUNTY	ROUTE	POST MILES TOTAL PROJECT	SHEET No	TOTAL SHEETS
10	MER	CAMPUS			

REGISTERED GEOTECHNICAL ENGINEER  
No. GE. 666  
Exp. 12/31/09  
PLANS APPROVAL DATE  
The State of California or its officers or agents shall not be responsible for the accuracy or completeness of electronic copies of this plan sheet.

GARY PARIKH  
PROFESSIONAL ENGINEER  
SPECIALTY: GEOTECHNICAL  
STATE OF CALIFORNIA

#### CONSISTENCY OF COHESIVE SOILS

Description	Unconfined Compressive Strength (tsf)	Pocket Penetrometer Measurement (tsf)	Torvane Measurement (tsf)	Field Approximation
Very Soft	< 0.25	< 0.25	< 0.12	Easily penetrated several inches by fist
Soft	0.25 to 0.50	0.25 to 0.50	0.12 to 0.25	Easily penetrated several inches by thumb
Medium Stiff	0.50 to 1.0	0.50 to 1.0	0.25 to 0.50	Penetrated several inches by thumb with moderate effort
Stiff	1 to 2	1 to 2	0.50 to 1.0	Readily indented by thumb but penetrated only with great effort
Very Stiff	2 to 4	2 to 4	1.0 to 2.0	Readily indented by thumbnail
Hard	> 4.0	> 4.0	> 2.0	Indented by thumbnail with difficulty


#### PLASTICITY OF FINE-GRAINED SOILS

Description	Criteria
Nonplastic	A 1/8-inch thread cannot be rolled at any water content.
Low	The thread can barely be rolled and the lump cannot be formed when drier than the plastic limit.
Medium	The thread is easy to roll and not much time is required to reach the plastic limit. The thread cannot be re-rolled after reaching the plastic limit. The lump crumbles when drier than the plastic limit.
High	It takes considerable time rolling and kneading to reach the plastic limit. The thread can be re-rolled several times after reaching the plastic limit. The lump can be formed without crumbling when drier than the plastic limit.


#### BOREHOLE IDENTIFICATION

Symbol	Hole Type	Description
	A	Auger Boring
	R	Rotary drilled boring
	P	Rotary percussion boring (air)
	R	Rotary drilled diamond core
	HD	Hand driven (1-inch soil tube)
	HA	Hand Auger
	D	Dynamic Cone Penetration Boring
	CPT	Cone Penetration Test (ASTM D 5778-95)
	O	Other


Note: Size in inches.

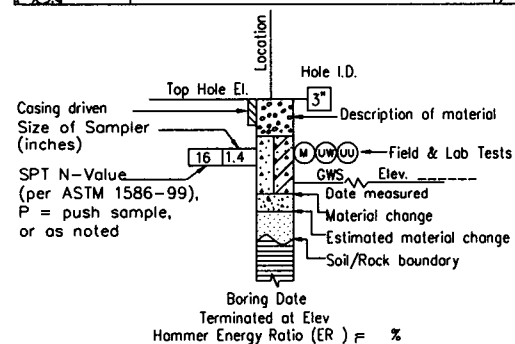


ROTARY BORING

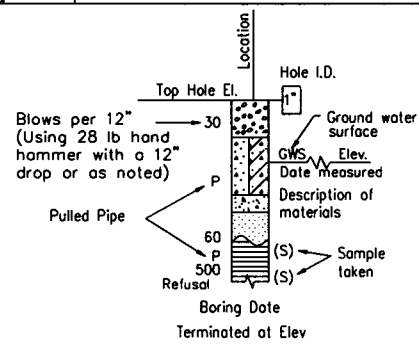

HAND BORING

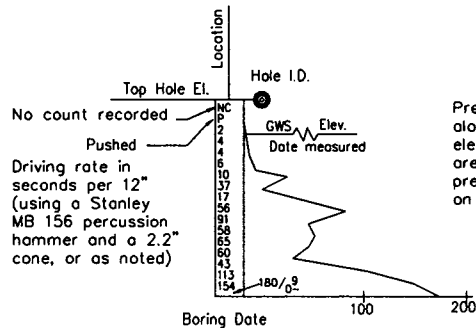

DYNAMIC CONE PENETRATION BORING

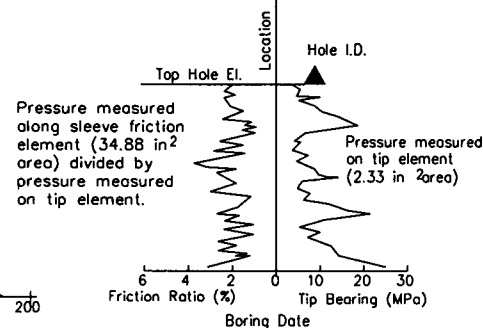

CONE PENETRATION TEST (CPT) SOUNDING

X DESIGN OVERSIGHT	DRAWN BY L. TRAN	L. Bhangoo FIELD INVESTIGATION BY:	STATE OF CALIFORNIA DEPARTMENT OF TRANSPORTATION	F. WANG PROJECT ENGINEER	BRIDGE NO. 39-0249L/R	SOIL LEGEND
X SIGN OFF DATE	CHECKED BY F. WANG	DATE: October 2007			POST MILE -	LOG OF TEST BORINGS
OSF GEOTECHNICAL LOG OF TEST BORINGS SHEET (ENGLISH) (REV. 2/25/05)						REVISION DATES (PRELIMINARY STAGE ONLY)
ORIGINAL SCALE IN INCHES FOR REDUCED PLANS						SHEET
CAMPUS PARKWAY OVERHEAD						OF
FILE => \$REQUEST						DISREGARD PRINTS BEARING EARLIER REVISION DATES
						P.M. 12.50



DIST	COUNTY	ROUTE	POST MILES TOTAL PROJECT	SHEET No	TOTAL SHEETS
10	MER	CAMPUS			
REGISTERED GEOTECHNICAL ENGINEER					
PLANS APPROVAL DATE					
The State of California or its officers or agents shall not be responsible for the accuracy or completeness of electronic copies of this plan sheet.					

REGISTERED PROFESSIONAL ENGINEER


GARY PARIKH

No. G.E. 666


Exp. 12/31/09

GEOTECHNICAL

STATE OF CALIFORNIA

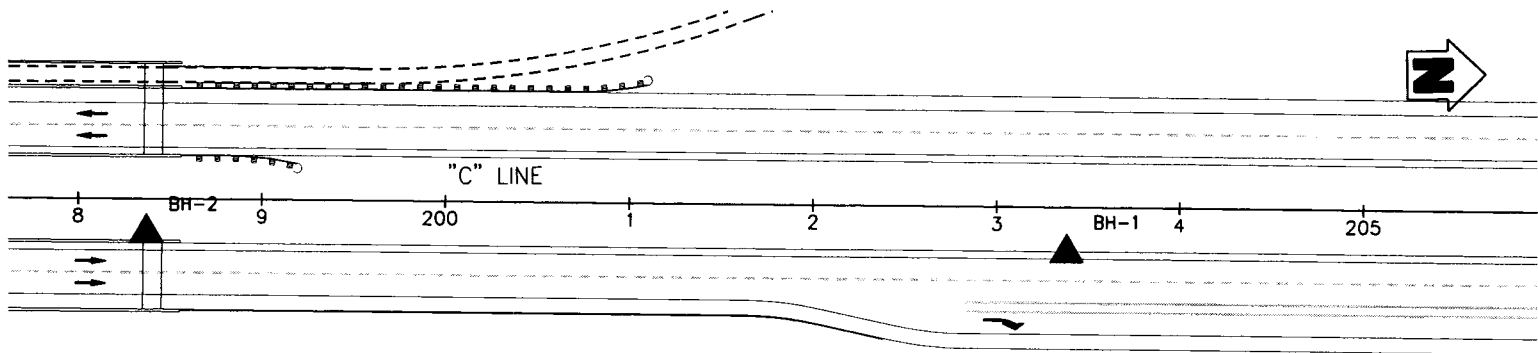

PLAN  
1" : 50'

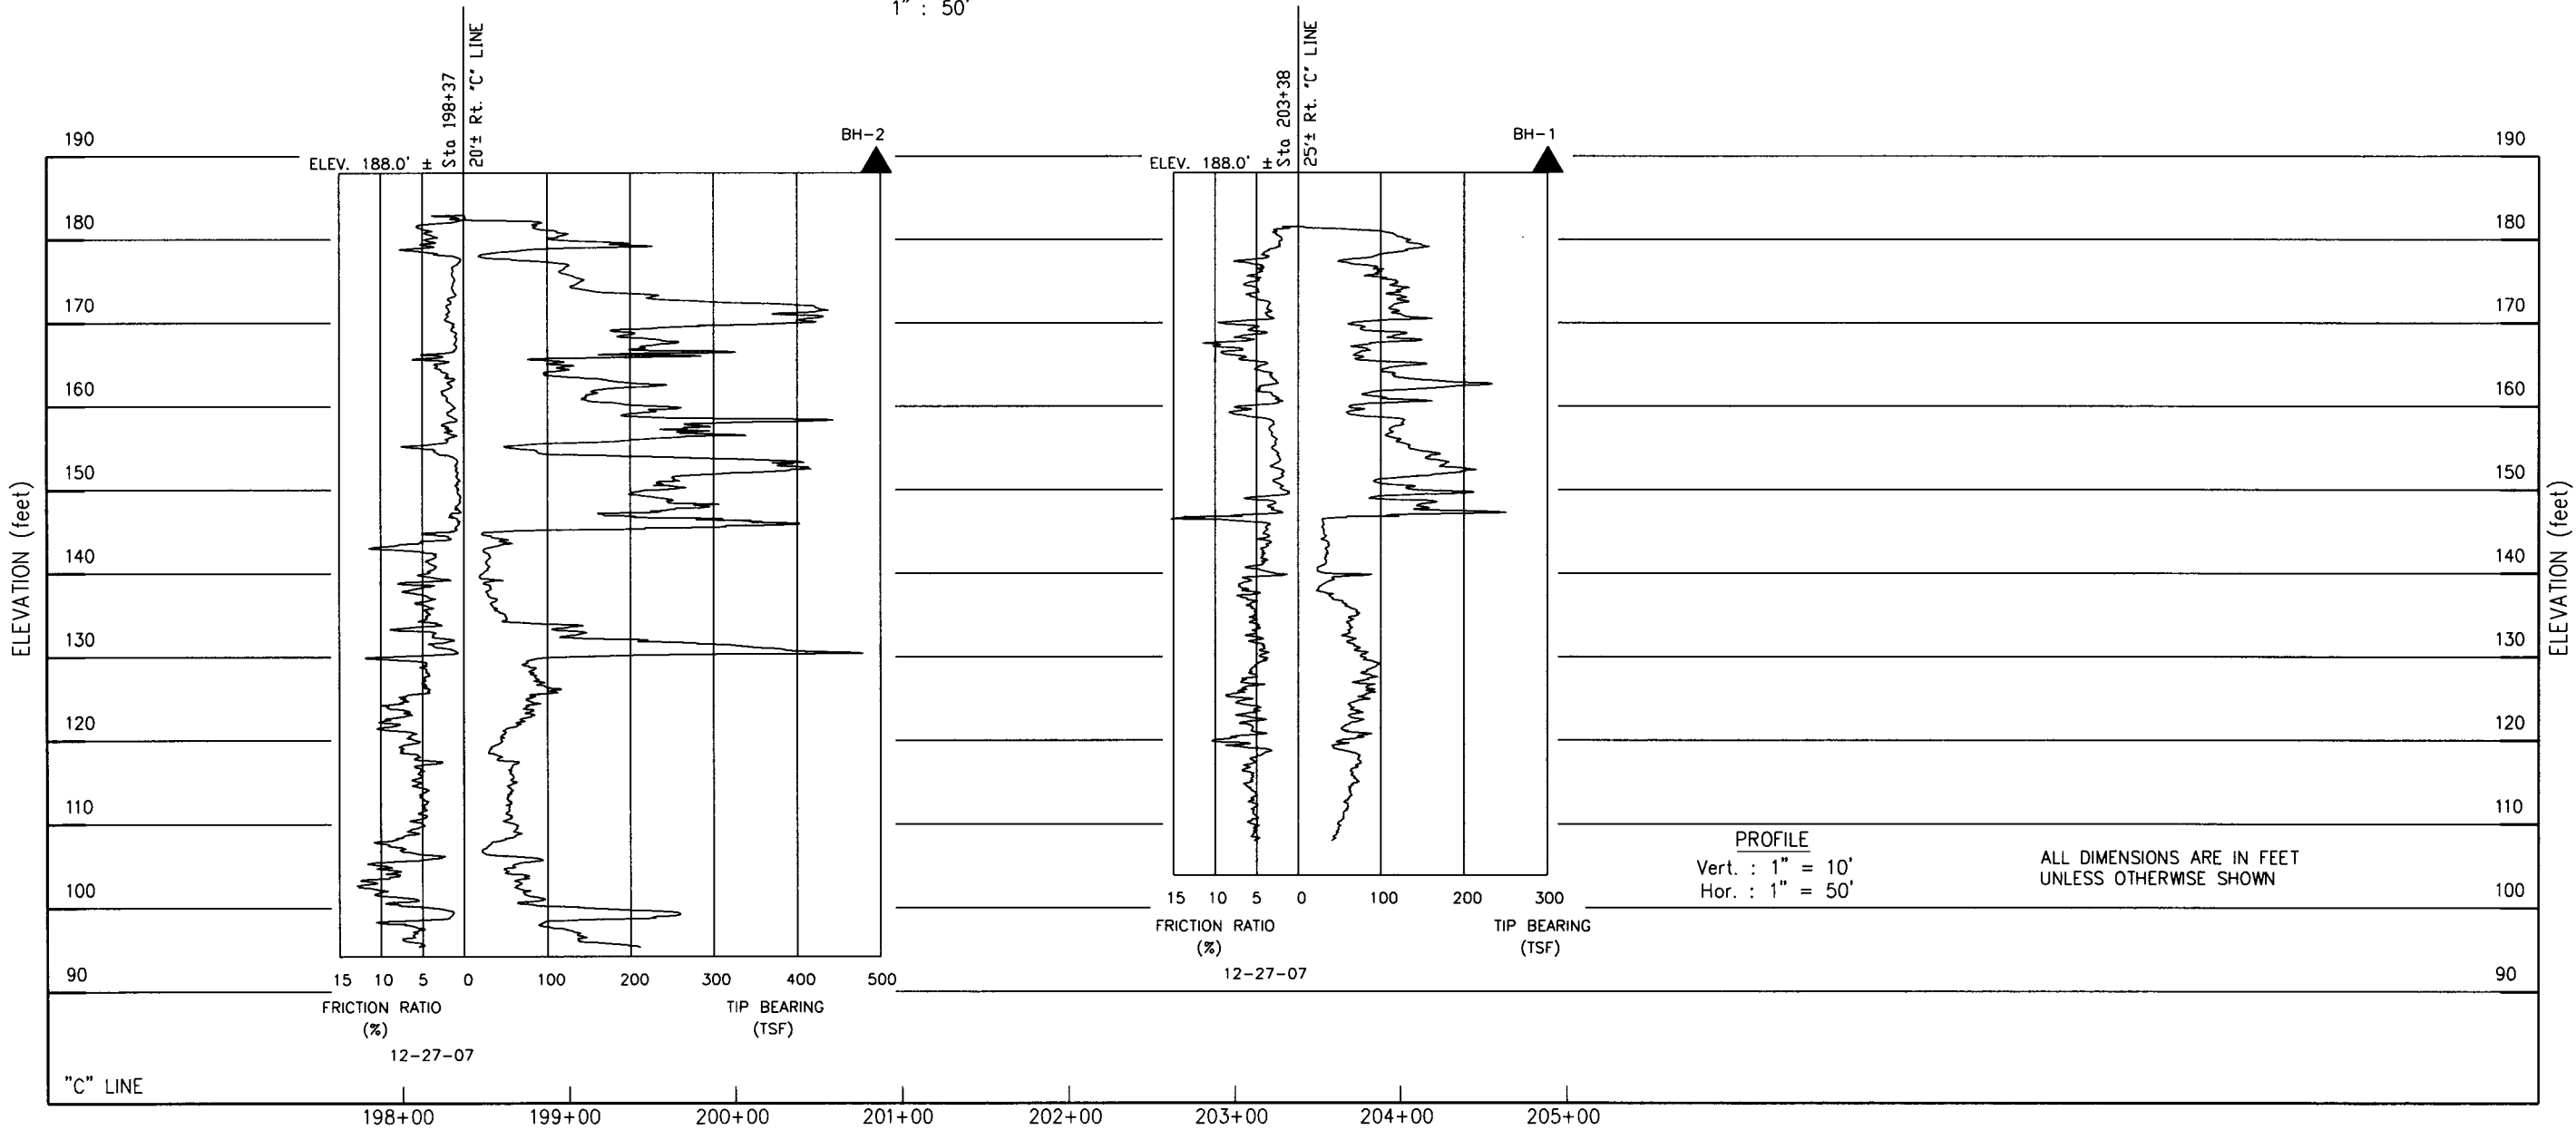


PROFILE

Vert. : 1" = 10'  
Hor. : 1" = 50'


ALL DIMENSIONS ARE IN FEET  
UNLESS OTHERWISE SHOWN

Jul 13, 2009 - 12:02pm S:\ACAD\207101\0\LOTB (Caltrans).dwg

ENGINEERING SERVICES		GEOTECHNICAL SERVICES		STATE OF CALIFORNIA DEPARTMENT OF TRANSPORTATION		DIVISION OF ENGINEERING SERVICES STRUCTURE DESIGN DESIGN BRANCH		BRIDGE NO. 39-0249L/R POST MILES		CAMPUS PARKWAY OVERHEAD LOG OF TEST BORINGS	
FUNCTIONAL SUPERVISOR NAME: G. PARIKH		DRAWN BY: L. TRAN CHECKED BY: F. WANG		FIELD INVESTIGATION BY: L. BHANGOO		CU EA		DISREGARD PRINTS BEARING EARLIER REVISION DATES		REVISION DATES P.M. 12.50	
OGS CIVIL LOG OF TEST BORINGS SHEET		ORIGINAL SCALE IN INCHES		CAMPUS PARKWAY OVERHEAD		FILE => \$REQUEST				SHEET OF	

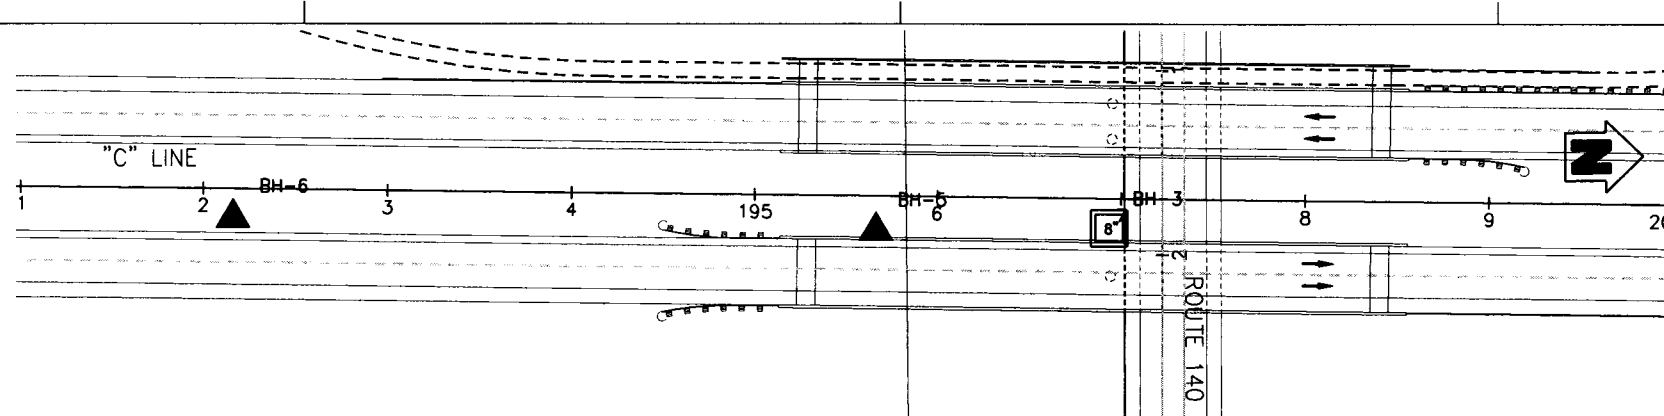

PLAN  
1" : 50'

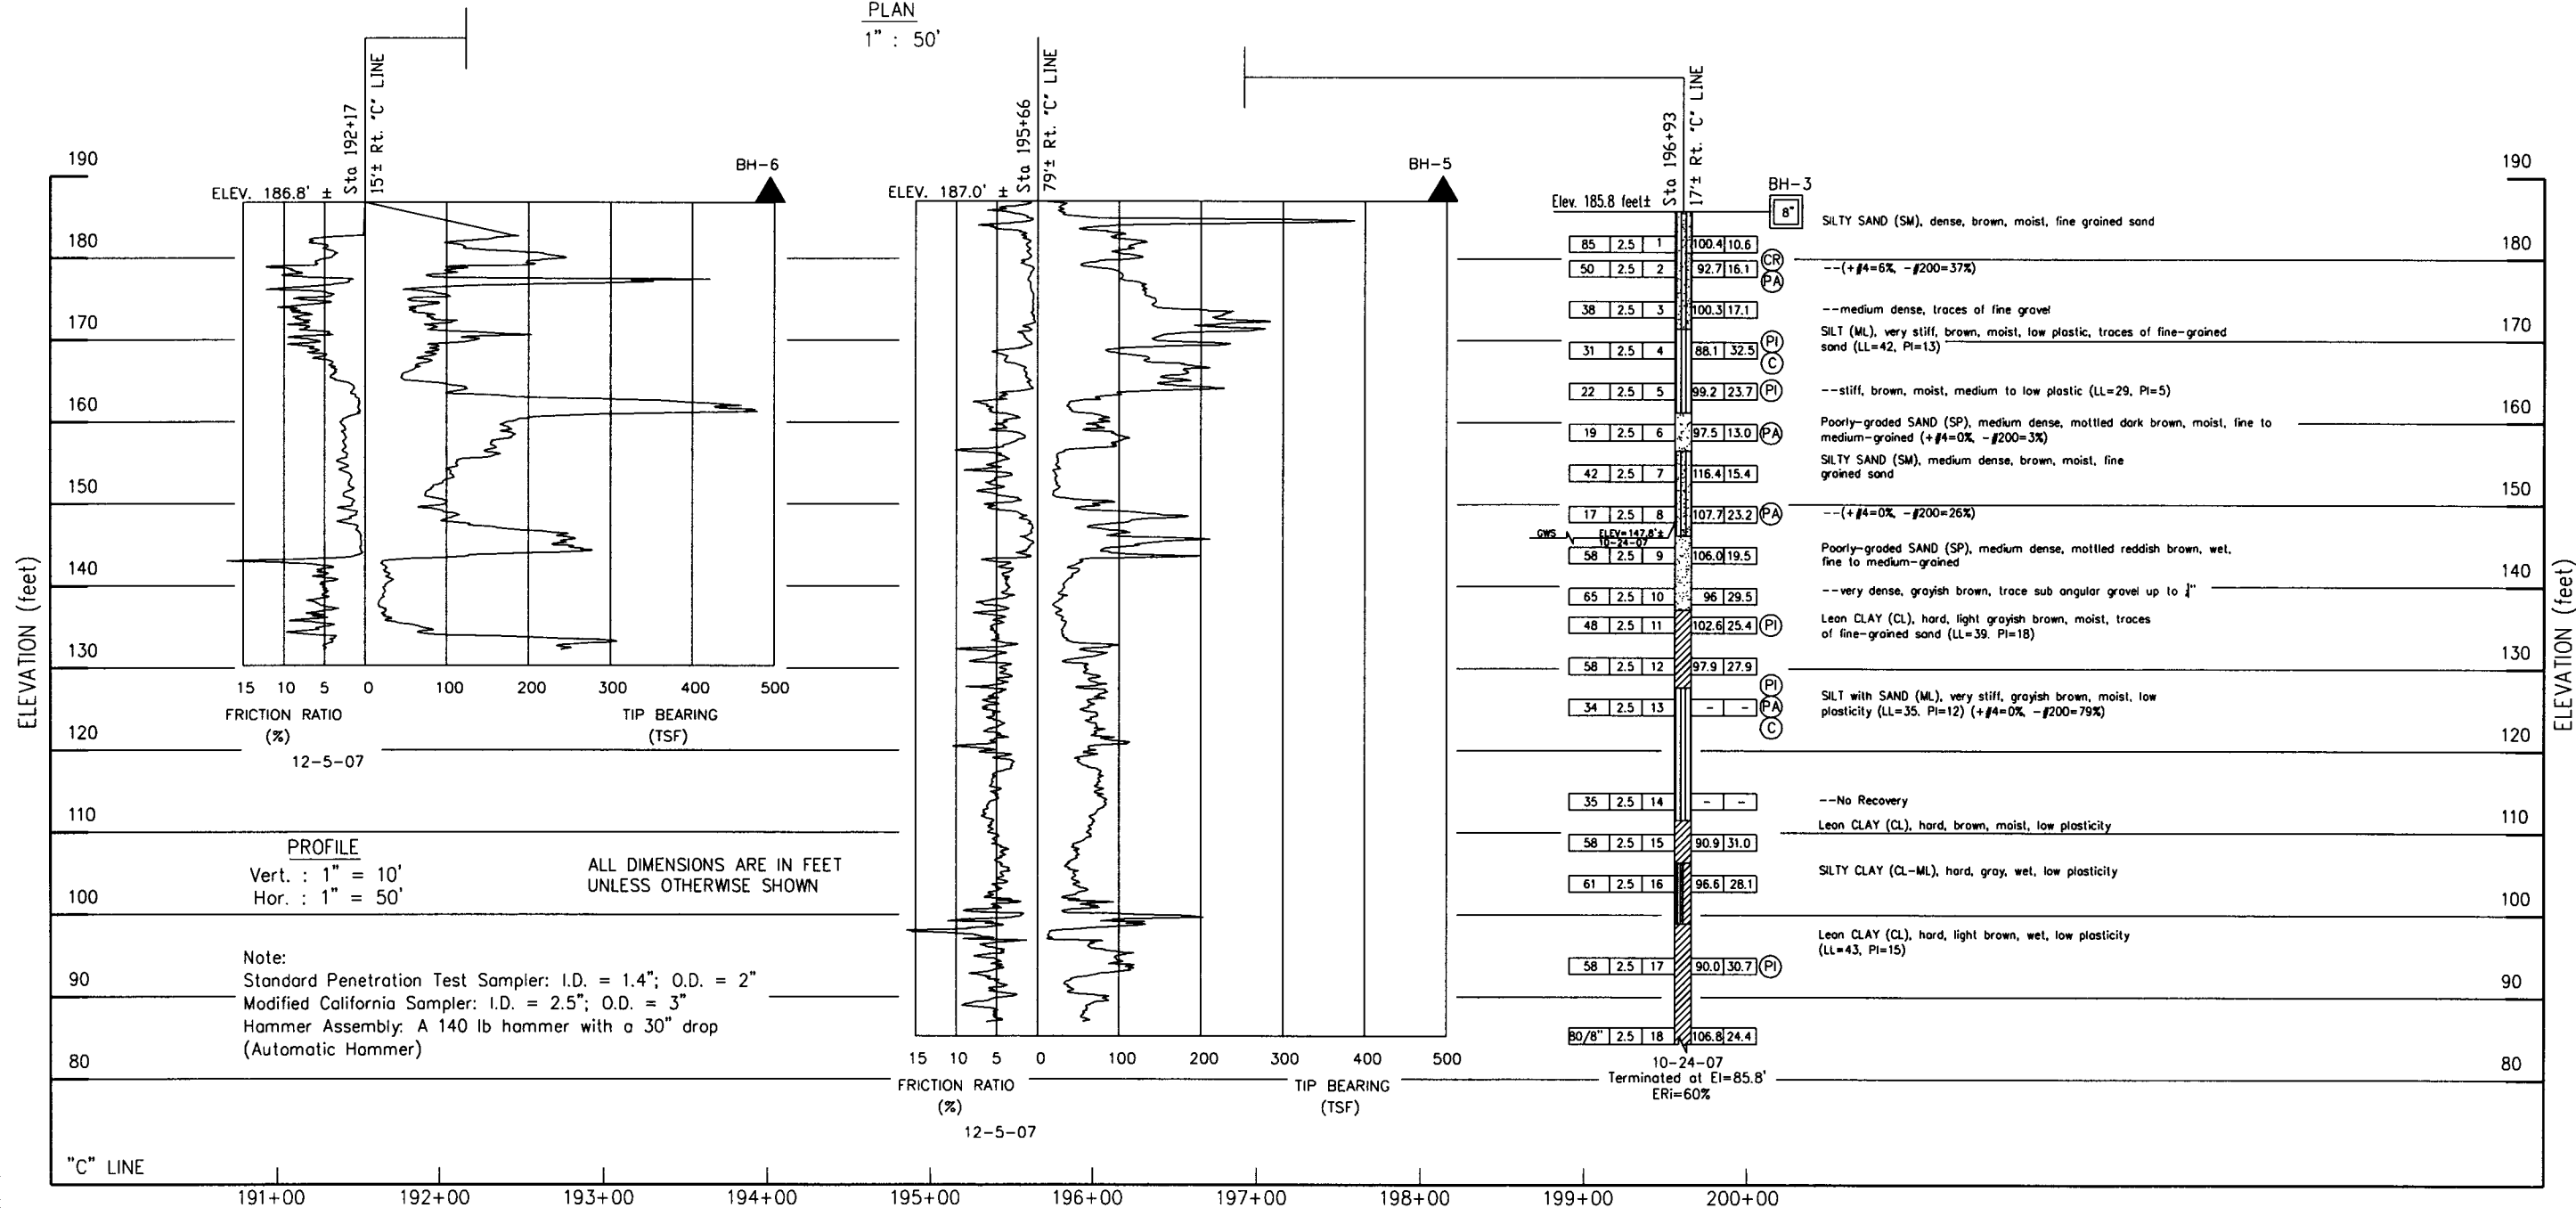

DIST	COUNTY	ROUTE	POST MILES TOTAL PROJECT	SHEET No	TOTAL SHEETS
10	MER	CAMPUS			

REGISTERED GEOTECHNICAL ENGINEER

PLANS APPROVAL DATE



The State of California or its officers or agents shall not be responsible for the accuracy or completeness of electronic copies of this plan sheet.

REGISTERED PROFESSIONAL ENGINEER  
GARY PARIKH  
No. G.E. 666  
Exp. 12/31/09  
STATE OF CALIFORNIA

Jul 13, 2009 - 12:01pm S:\ACAD\207101\10\LOTB (California).dwg

ENGINEERING SERVICES		GEOTECHNICAL SERVICES		STATE OF CALIFORNIA DEPARTMENT OF TRANSPORTATION		DIVISION OF ENGINEERING SERVICES STRUCTURE DESIGN DESIGN BRANCH		BRIDGE NO. 39-0249L/R POST MILES		CAMPUS PARKWAY OVERHEAD LOG OF TEST BORINGS	
FUNCTIONAL SUPERVISOR NAME: G. PARIKH		DRAWN BY: L. TRAN CHECKED BY: F. WANG		FIELD INVESTIGATION BY: L. BHANGOO		CU EA		DISREGARD PRINTS BEARING EARLIER REVISION DATES		REVISION DATES P.M. 12.50	
OOS CIVIL LOG OF TEST BORINGS SHEET		ORIGINAL SCALE IN INCHES		CAMPUS PARKWAY OVERHEAD		FILE => \$REQUEST				SHEET OF	

**Classification by  
Robertson 1986**

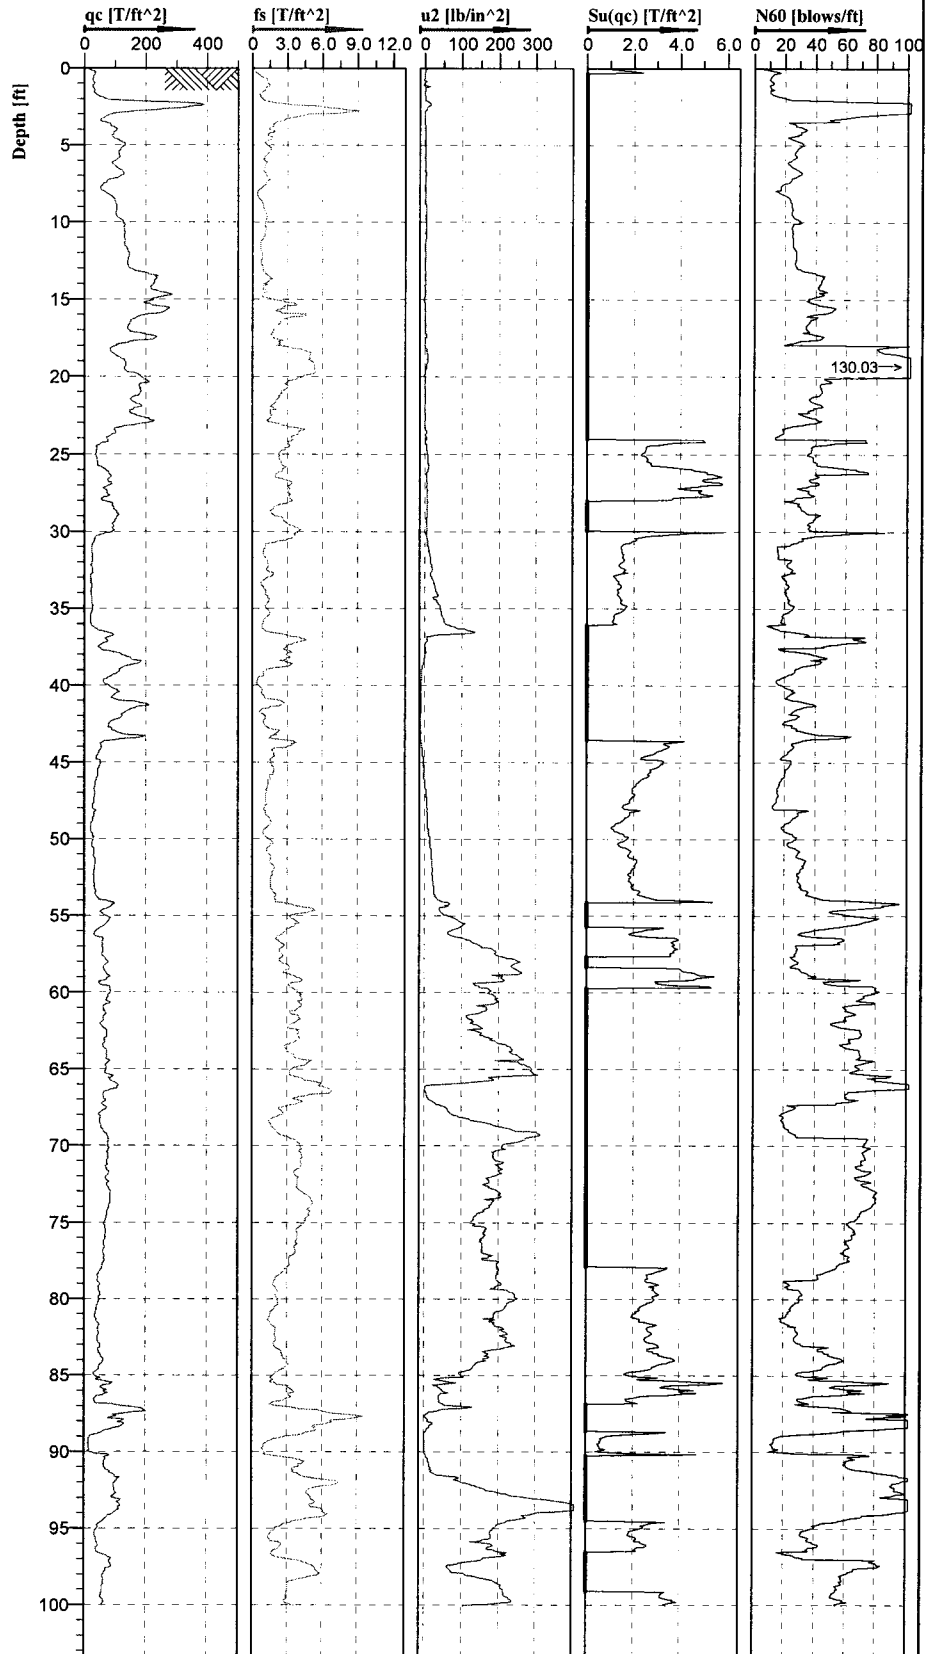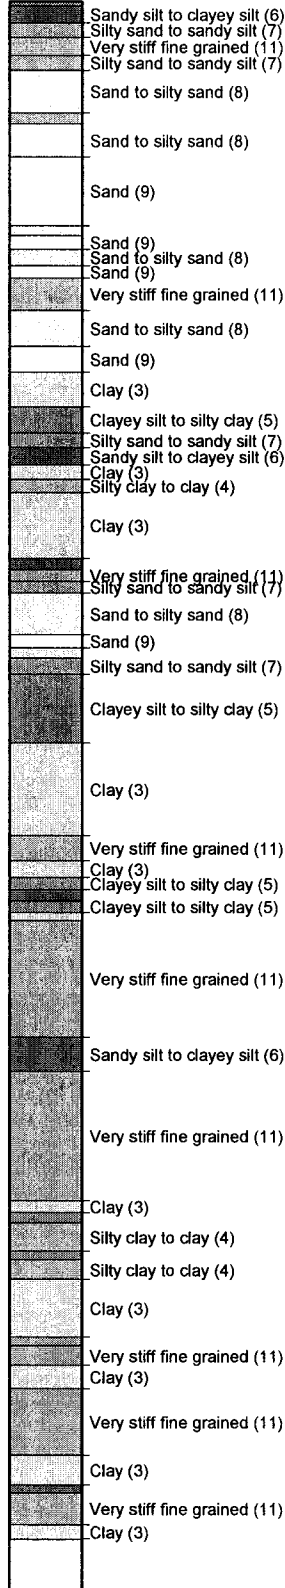

Cone No: 0  
 Tip area [cm2]: 10  
 Sleeve area [cm2]: 150



Location: <b>Merced, California</b>	Position:	Ground level:	Test no: <b>BH-5</b>
Project ID: <b>207101.10</b>	Client: <b>Parikh Consultants</b>	Date: <b>12/5/2007</b>	Scale: <b>1 : 145</b>
Project: <b>Campus Parkway Merced</b>	Page: <b>1/1</b>	File: <b>BH-5.cpd</b>	Fig:

**CAMPUS PARKWAY OVERHEAD**

**P.M. 12.50**



Classification by  
Robertson 1986

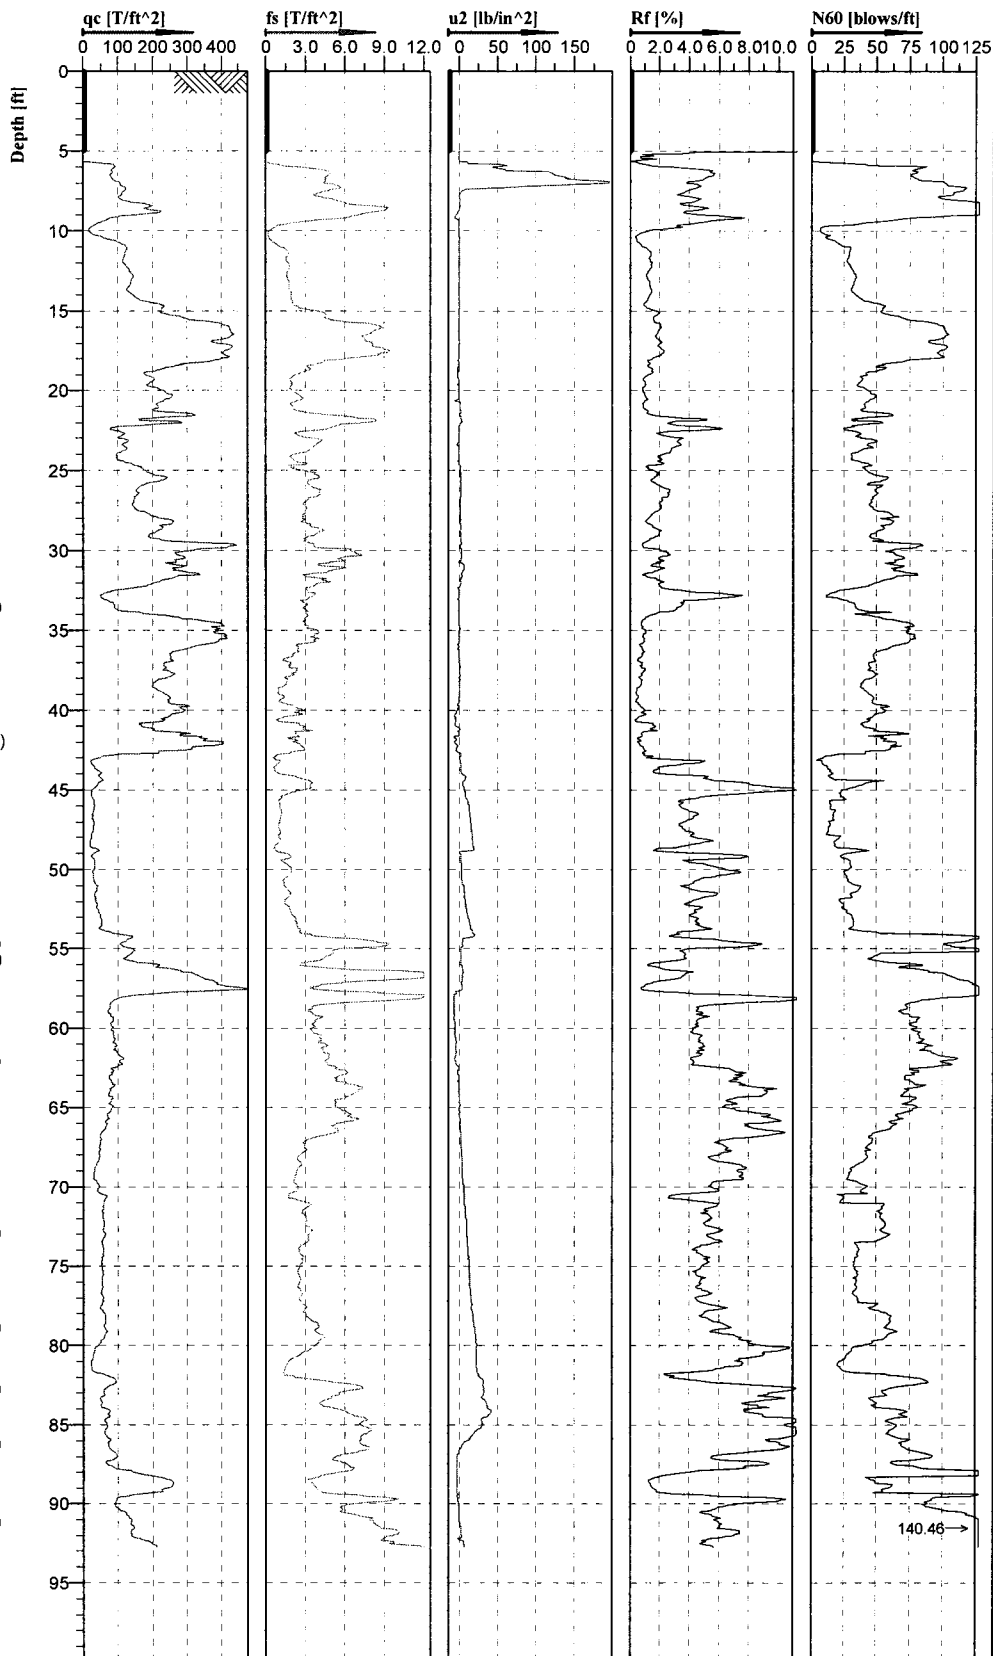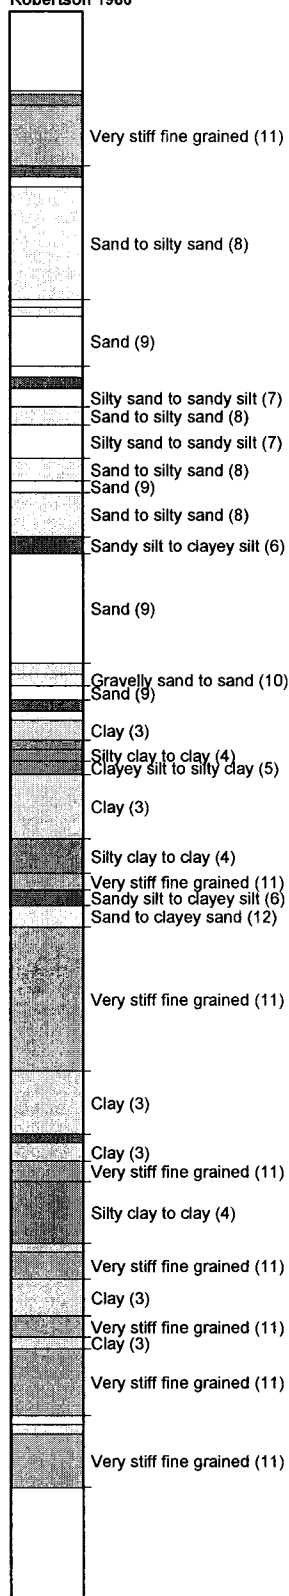



Cone No: 3789  
Tip area [cm2]: 10  
Sleeve area [cm2]: 150

Location: Merced, California	Position:	Ground level:	Test no: BH-2
Project ID: 207101.10	Client: Parikh Consultants	Date: 12/27/2007	Scale: 1 : 140
Project: Campus Parkway Merced		Page: 1/1	Fig:
		File: BH-2.cpd	

**CAMPUS PARKWAY OVERHEAD**

**P.M. 12.50**

Classification by  
Robertson 1986

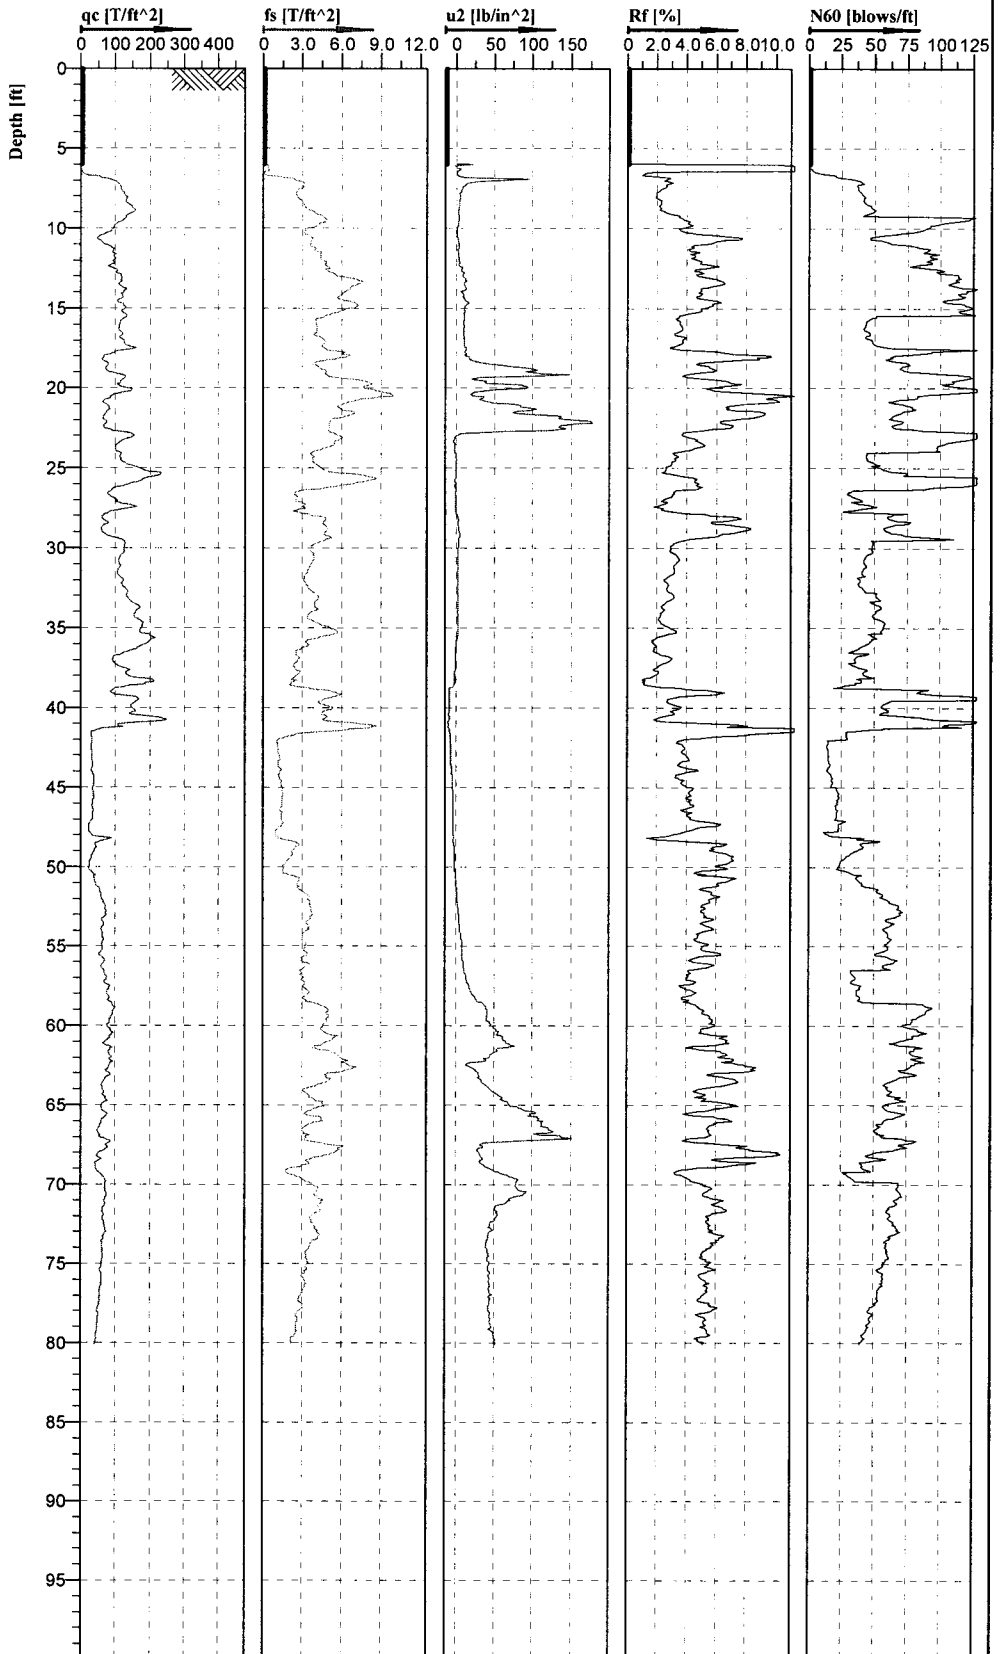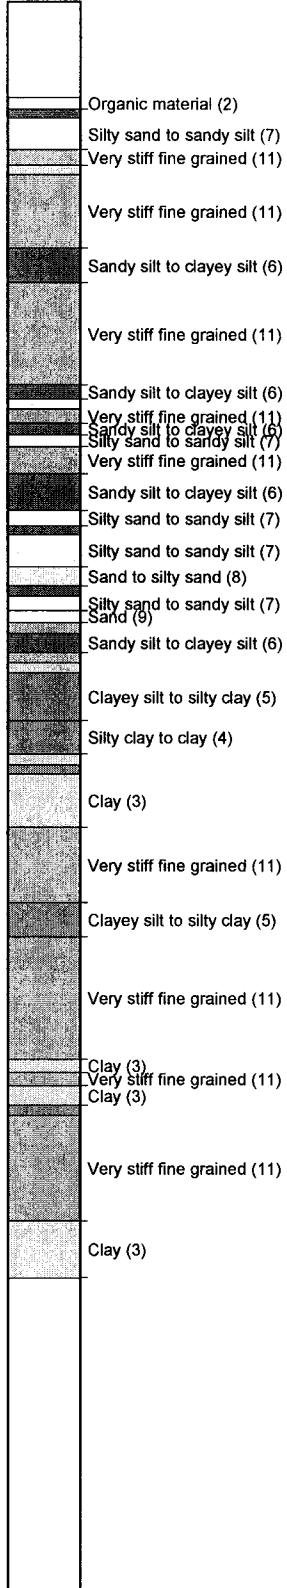

Cone No: 3789  
Tip area [cm2]: 10  
Sleeve area [cm2]: 150


Location: Merced, California	Position:	Ground level:	Test no: BH-1
Project ID: 207101.10	Client: Parikh Consultants	Date: 12/27/2007	Scale: 1 : 140
Project: Campus Parkway Merced		Page: 1/1	Fig:
		File: BH-1.cpd	

**CAMPUS PARKWAY OVERHEAD**

**P.M. 12.50**

Classification by  
Robertson 1986

Very stiff fine grained (11)  
Sand to clayey sand (12)  
Very stiff fine grained (11)  
  
Very stiff fine grained (11)  
  
Clayey silt to silty clay (5)  
Sand to silty sand (8)  
Gravelly sand to sand (10)  
Silty sand to sandy silt (7)  
Silty sand to sandy silt (7)  
Silty sand to sandy silt (7)  
Sand to silty sand (8)  
Sandy silt to clayey silt (6)  
Sand (9)  
Clay (3)  
Very stiff fine grained (11)  
Sand to clayey sand (12)  
Very stiff fine grained (11)

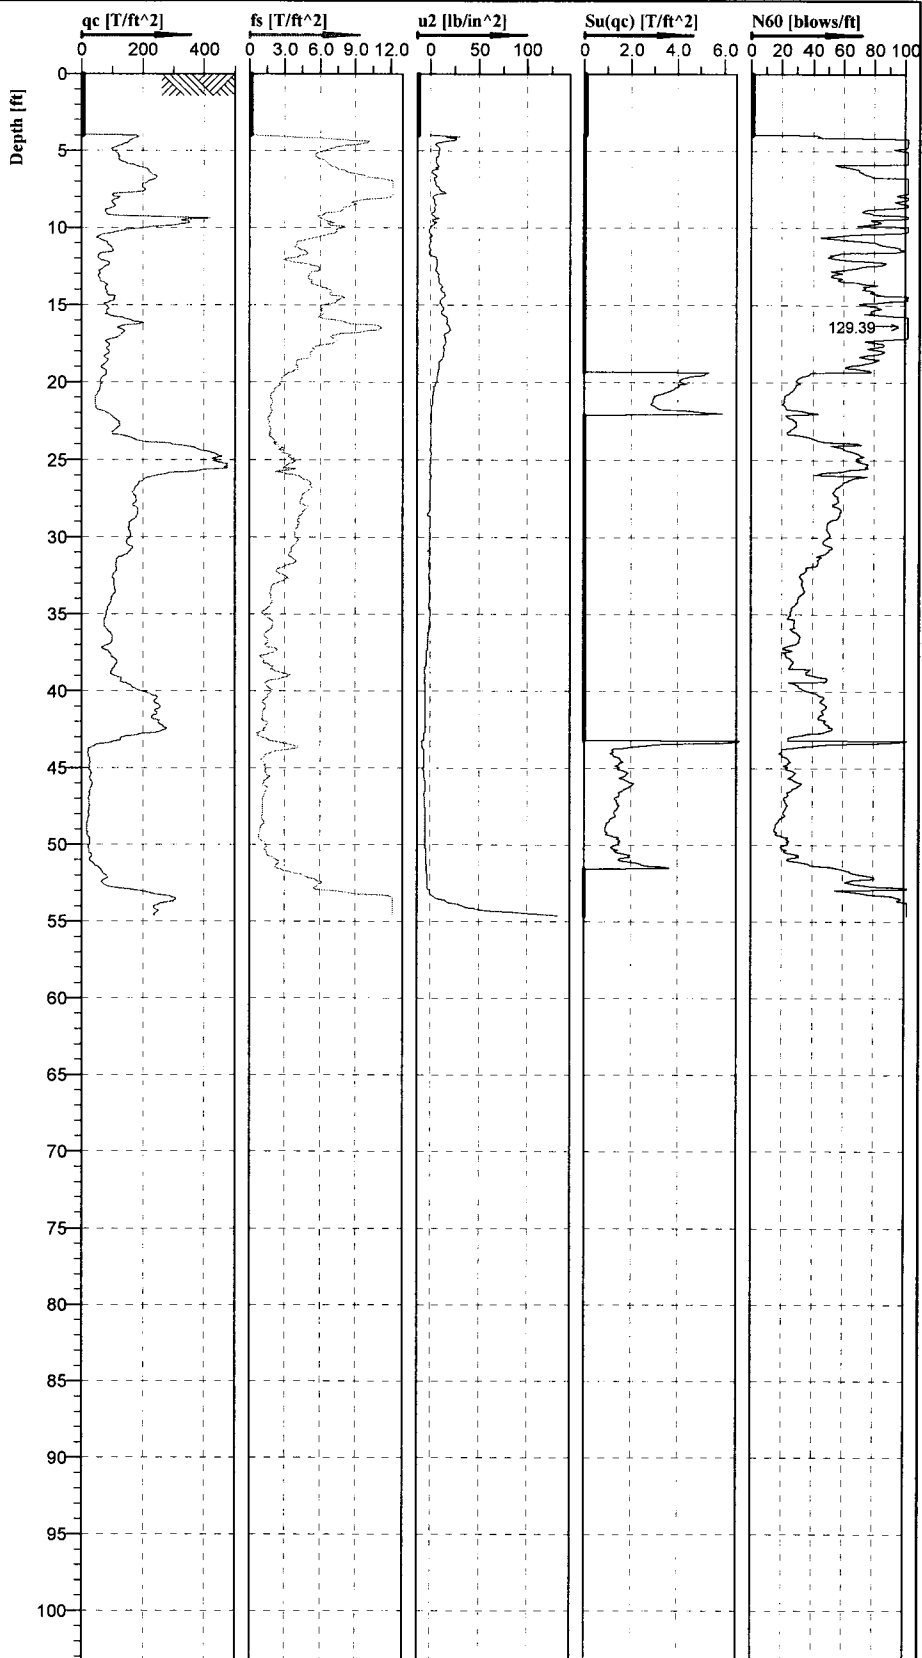

CALIFORNIA PUSH  
TECHNOLOGIES  
INCORPORATED



Cone No: 3789  
Tip area [cm<sup>2</sup>]: 10  
Sleeve area [cm<sup>2</sup>]: 150

Location: Merced, California	Position:	Ground level:	Test no: BH-6
Project ID: 207101.10	Client: Parikh Consultants	Date: 12/5/2007	Scale: 1 : 145
Project: Campus Parkway Merced		Page: 1/1	Fig:
		File: BH-6.cpd	

**CAMPUS PARKWAY OVERHEAD**

**P.M. 12.50**



# AS BUILT PLANS

Contract No. 63-10713C9


Date Completed

Document No. 00001193


DESIGN PILE LOADING 45 TONS  
TYPE PILE - CLASS I & CLASS II  
RAYMOND STEP TAPER  
DIAMETER - CLASS I - TIP 10", BUTT 16"  
CLASS II - TIP 11", BUTT 12"  
TOTAL NO. OF PILES - CLASS I - 17  
CLASS II - 54  
L.F. OF PILES - CLASS I - 750 L.F. 782.48 L.F.  
CLASS II - 1,060 L.F. 1,354.01 L.F.  
HAMMER - MODIFIED 65C

BM Men # Brass Highway disc.  
at SW corner Highway 88  
& Childs Ave.  
Elev. 175.58


BRIDGE DEPARTMENT

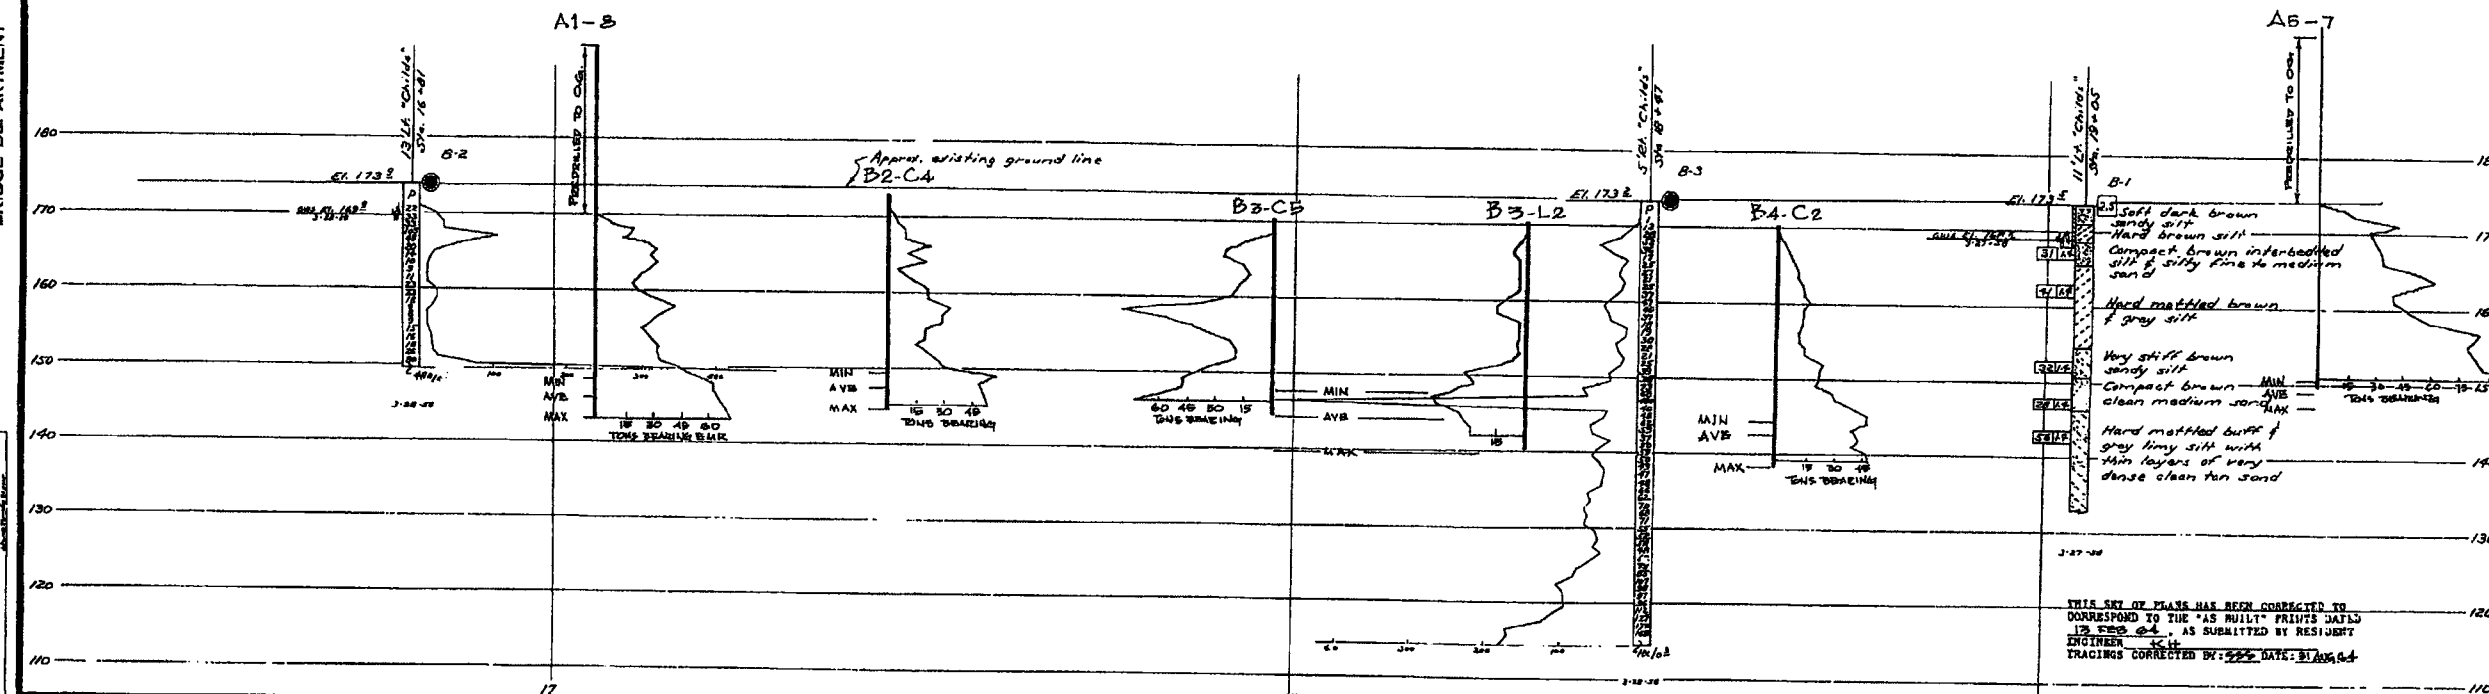


## CLASSIFICATION OF MATERIAL BASED ON STANDARD GRADE SIZE LIMITS

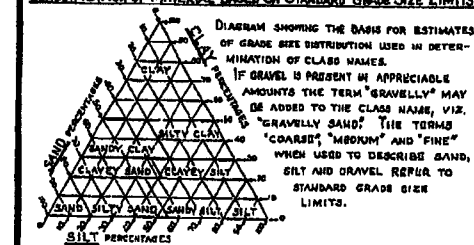

## LEGEND OF EARTH MATERIALS

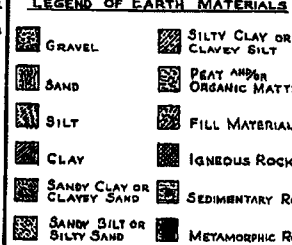

## LEGEND OF BORING OPERATIONS

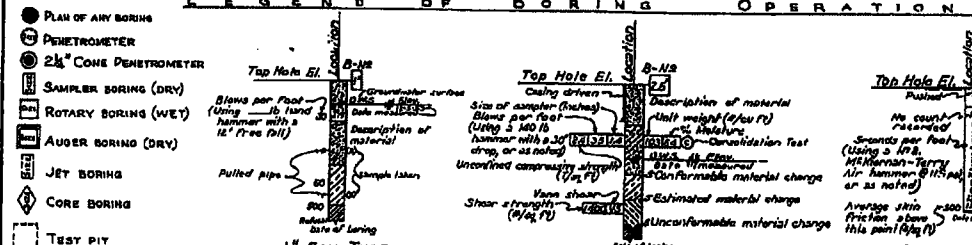

## NOTES

Classification of earth material as shown on this sheet is based upon field inspection and is not to be construed to imply mechanical analysis.

STATE OF CALIFORNIA  
DEPARTMENT OF PUBLIC WORKS  
DIVISION OF HIGHWAYS

CHILDS AVENUE OVERCROSSING


LOG OF TEST BORINGS

SCALE 1" = 10' BRIDGE 33-143 FILE DRAWING 103-13

PREL. DRAWING NO. 103-13-1

I HEREBY CERTIFY THAT THIS IS A TRUE AND ACCURATE COPY OF THE ABOVE DOCUMENT TAKEN UNDER MY DIRECTION AND CONTROL ON THIS DATE IN SACRAMENTO, CALIFORNIA PURSUANT TO AUTHORIZATION BY THE DIRECTOR OF PUBLIC WORKS.

DATE SIGNATURE TITLE

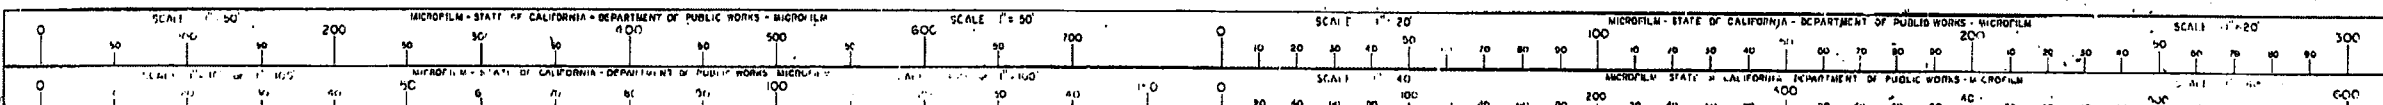

## SOIL BORING REPORT

Project <u>Anderson-Polzine</u>						Project Number _____	
Location <u>1375 Brantley Street, Merced</u>						Start Date/Time <u>06/14/2006-0815</u> Finish Date/Time <u>06/14/2006-1245</u>	
Drilled By <u>Earthtec Ltd</u>						Logged By <u>SGM</u> Reviewed By _____	
Drilling Method <u>10" diameter continuous hollow stem</u>						Weather/Temp(°F) <u>Clear / Hot</u>	
Bit Type <u>Auger</u> Bit Size <u>10"</u>						Field Monitor <u>PID - Mini-Rae 2000 #4132</u>	
Sampling <u>18x2" California modified split spoon</u>						Surface Conditions <u>Dirt/Asphalt/Rock</u>	
Ground Elevation <u>(Mean Sea Level) 169.0'</u>							

Time	Sampled Depth Interval and Number	Soil Boring Schematic	Depth (ft)	Laboratory Analysis	Graphic Log	Soil Group Symbol (USCS)	Water Level Information		
							Depth to Groundwater (ft)	Date - Time	Depth of Hole (ft)
							33.0'	06/14/2006	50.5'
							Soil Description		
0815						SM	FINE SILTY SAND (Artificial Fill): Dark green, moist, very strong petroleum hydrocarbon odor (350 ppmv) on PID. Lead (8.69 mg/kg).		
0830	AP-BH1-5.5			NA		SM	MEDIUM TO FINE SILTY SAND: Dark green to black, moist, micaceous, very strong petroleum hydrocarbon odor (9,000 ppmv on PID; analytical results: benzene (ND); toluene (3.7 mg/kg); ethylbenzene (10 mg/kg); xylene (59 mg/kg); TPH-g(880 mg/kg); lead (11 mg/kg); all others ND.		
0845	AP-BH1-10.5		10	See Side		SM	MEDIUM TO FINE SILTY SAND: Dark green to black, moist, micaceous, very strong petroleum hydrocarbon odor (5,500 ppmv on PID; analytical results: benzene (0.29 mg/kg); toluene (8.9 mg/kg); ethylbenzene (30 mg/kg); xylene (46 mg/kg); TPH-g(1800 mg/kg); lead (3.89 mg/kg); all others ND. Blow count to cut sample: 8/9/11.		
0900	AP-BH1-15.5			See Side		SM	MEDIUM TO FINE SILTY SAND: Dark green, moist, micaceous, very strong petroleum hydrocarbon odor (5,500 ppmv on PID; analytical results: benzene (0.097 mg/kg); toluene (2.9 mg/kg); ethylbenzene (12 mg/kg); xylene (45 mg/kg); TPH-g(700 mg/kg); all others ND. Lead (5.56 mg/kg); Blow count to cut sample: 8/10/13.		
0925	AP-BH1-20.5		20	See Side		SM	CLAYEY SILT: Dark green to brown, moist, micaceous, moderate petroleum hydrocarbon odor (5,500 ppmv on PID; analytical results: benzene (0.052 mg/kg); toluene (0.52 mg/kg); ethylbenzene (0.17 mg/kg); xylene (0.90 mg/kg); TPH-g(4.3 mg/kg); lead (4.86 mg/kg); all others ND. Blow count to cut sample: 9/11/12.		
0945	AP-BH1-25.5			See Side		ML	CLAYEY SILT: As above, moist, micaceous, no petroleum hydrocarbon odor (0 ppmv on PID; analytical results: benzene (ND); toluene (ND); ethylbenzene (0.0073 mg/kg); xylene (0.11 mg/kg); TPH-g(ND); lead (3.86 mg/kg); all others ND. Blow count to cut sample: 10/12/14.		
0955	AP-BH1-30.5		30	See Side		ML	Water table at 33.0 feet bgs		
1005	AP-BH1-33.0			See Side		SM	MEDIUM TO COARSE GRAINED SAND: Light brown, wet, iron stained, micaceous, no petroleum odor (0 ppmv on PID). Analytical results all ND except toluene (0.0058 mg/kg) and xylene (0.075 mg/kg); Lead (3.48 mg/kg) Blow count to cut sample: 8/9/12.		
1050	AP-BH1-38.0			See Side		SM	MEDIUM TO COARSE GRAINED SAND: As above; no petroleum odor (0 ppmv on PID). Analytical results all ND except for xylene (0.014 mg/kg).mg/kgk); Lead (2.74 mg/kg); Blow count to cut sample: 8/9/12.		
1115	AP-BH1-40.5		40	NA		SM	MEDIUM TO COARSE GRAINED SAND: As above; no petroleum odor (0 ppmv on PID). Analytical results all ND except for xylene (0.0079 mg/kg).mg/kgk); Lead (4.43 mg/kg); Blow count to cut sample: 8/9/12.		
1130	AP-BH1-45.5			See Side		SM	Total Depth: 50.5' bgs.		
1155	AP-BH1-50.5		50	NA		SM			
			60						

<b>WELL COMPLETION NOTES:</b> Solid 2" diameter schedule 40 PVC to 25 feet below ground surface; bentonite chip seal from 22.0 to 24.0 feet below ground surface; screen set from 25.0 to 45.0 feet below ground level with 0.010 screen; concrete slurry cement grout from 22.0 to 0.5 feet bgs; Monterey #212 filter sand pack; locking cap on top of case with manhole box set in ground. End cap is set at base of screened pipe.	<b>Well Casing Elevation</b> is 169.70 feet above mean sea level <b>Coordinates of well</b> are 2355642.04 feet north, 6136032.58 feet east, California State Plane Coordinate System Zone 4, NAD83. <b>Coordinates:</b> Latitude 37.28960347 degrees North, Longitude -120.4631322 degrees West Longitude and Latitude Horizontal coordinates tied to USC&GS Benchmark A85 (PID HSI152), WGS 1984 Spheroid, NAD83 Projection
---	--

## SOIL BORING REPORT

Project <u>Anderson-Polzine</u>						Project Number _____	
Location <u>1375 Brantley Street, Merced</u>						Start Date/Time <u>06/14/2006-1530</u> Finish Date/Time <u>06/14/2006-0935</u>	
Drilled By <u>Earthtec Ltd</u>						Logged By <u>SGM</u> Reviewed By _____	
Drilling Method <u>10" diameter continuous hollow stem</u>						Weather/Temp(°F) <u>Clear / Hot</u>	
Bit Type <u>Auger</u> Bit Size <u>10"</u>						Field Monitor <u>PID - Mini-Rae 2000 #4132</u>	
Sampling <u>18x2" California modified split spoon</u>						Surface Conditions <u>Dirt/Asphalt/Rock</u>	
						Ground Elevation <u>(Mean Sea Level) 169.0'</u>	

Time	Sampled Depth Interval and Number	Soil Boring Schematic	Depth (ft)	Laboratory Analysis	Graphic Log	Soil Group Symbol (USCS)	Water Level Information		
							Depth to Groundwater (ft)	Date - Time	Depth of Hole (ft)
							33.0'		
							06/14/2006		
							45.5'		
Soil Description									
0815							MEDIUM TO FINE SILTY SAND: Light brown, moist, micaceous, no petroleum hydrocarbon odor (0 ppmv on PID; Soil sample not analyzed. Blow count to cut sample 7/10/11.		
1541	AP-BH2-5.5			NA		SM	MEDIUM TO FINE SILTY SAND: Light brown, moist, micaceous, no petroleum hydrocarbon odor (0 ppmv on PID; Soil sample analytical results: All ND. Lead (21.4 mg/kg) Blow count to cut sample 7/12/13.		
1600	AP-BH2-10.5		10	All ND		SM	MEDIUM TO FINE SILTY SAND: Light brown, moist, micaceous, no petroleum hydrocarbon odor (0 ppmv on PID; Soil sample analytical results: All ND. Blow count to cut sample 6/10/12.		
1614	AP-BH2-15.5			All ND		SM	MEDIUM TO FINE SILTY SAND: Light brown, moist, micaceous, no petroleum hydrocarbon odor (0 ppmv on PID; Soil sample analytical results: All ND. Blow count to cut sample 7/11/13.		
0745	AP-BH2-20.5		20	NA		SM	MEDIUM TO FINE SILTY SAND: Light brown, moist, micaceous, no petroleum hydrocarbon odor (0 ppmv on PID; Soil sample analytical results: All ND. Blow count to cut sample 9/11/12.		
0815	AP-BH2-25.5			See Side		ML	CLAYEY SILT: Light brown, moist, micaceous, slight petroleum odor (15 ppmv on PID); analytical results: toluene (0.0067 mg/kg); ethylbenzene (0.014 mg/kg); xylene (0.08 mg/kg); lead (4.86 mg/kg); all others ND. Blow count to cut sample: 9/11/12.		
0840	AP-BH2-30.5		30	NA			Water table at 33.0 feet bgs		
0850	AP-BH2-35.0			All ND		SM	MEDIUM TO COARSE GRAINED SAND: Light brown, wet, iron stained, micaceous, no petroleum odor (0 ppmv on PID). Soil sample analytical results: All ND. Blow count to cut sample: 9/13/14.		
0915	AP-BH2-40.5		40	All ND		SM	MEDIUM TO COARSE GRAINED SAND: Light brown, wet, iron stained, micaceous, no petroleum odor (0 ppmv on PID). Soil sample not analyzed. Blow count to cut sample: 10/11/15.		
0935	AP-BH1-45.5			NA		SM	MEDIUM TO COARSE GRAINED SAND: Light brown, wet, iron stained, micaceous, no petroleum odor (0 ppmv on PID). Soil sample not analyzed. Blow count to cut sample: 11/12/14.		
			50				Total Depth: 45.5' bgs.		
			60						

**WELL COMPLETION NOTES:** Solid 2" diameter schedule 40 PVC to 25 feet below ground surface; bentonite chip seal from 22.0 to 24.0 feet below ground surface; screen set from 25.0 to 45.0 feet below ground level with 0.010 screen; concrete slurry cement grout from 22.0 to 0.5 feet bgs; Monterey #212 filter sand pack; locking cap on top of case with traffic box set in ground. End cap is set at base of screened pipe.

**Well Casing Elevation** is 169.78 feet above mean sea level  
**Coordinates** of well are 2355677.61 feet north, 6136016.13 feet east, California State Plane Coordinate System Zone 4, NAD83.  
**Coordinates:** Latitude 37.28910047 degrees North, Longitude -120.4631906 degrees West  
 Longitude and Elevation Horizontal coordinates tied to USC&GS Benchmark A85 (PID H51152), WGS 1984 Spheroid, NAD83 Projection



## SOIL BORING REPORT

Project	Anderson-Polzine		Project Number		
Location	1375 Brantley Street, Merced		Start Date/Time	06/27/2006-0730	Finish Date/Time 06/27/2006-1130
Drilled By	Earthtec Ltd		Logged By	SGM	Reviewed By
Drilling Method	10" diameter continuous hollow stem		Weather/Temp(°F)	Clear / Hot	
Bit Type	Auger	Bit Size 10"	Field Monitor	PID - Mini-Rae 2000 #4132	
Sampling	18x2" California modified split spoon		Surface Conditions	Dirt/Asphalt/Rock	
			Ground Elevation	(Mean Sea Level) 169.0'	

Time	Sampled Depth Interval and Number	Soil Boring Schematic	Depth (ft)	Laboratory Analysis	Graphic Log	Soil Group Symbol (USCS)	Water Level Information		
							Depth to Groundwater (ft)		
							33.0'		
							Date - Time	06/27/2006	
							Depth of Hole (ft)	45.5'	
							Soil Description		
0730							MEDIUM TO FINE SILTY SAND: Light brown, moist, micaceous, moderate petroleum hydrocarbon odor (250 ppmv on PID; Soil sample analytical results: toluene (0.61 mg/kg); ethylbenzene (14 mg/kg); xylene (79 mg/kg); TPH-g (2400 mg/kg); TPH-d(790 mg/kg); TPH-mo (46 mg/kg); Blow count to cut sample 6/8/10.		
0745	AP-BH3-5.5			See Side		SM	MEDIUM TO FINE SILTY SAND: Light brown, moist, micaceous, moderate petroleum hydrocarbon odor (50 ppmv on PID; Soil sample analytical results: toluene (0.017 mg/kg); ethylbenzene (0.37 mg/kg); xylene (1.2 mg/kg); TPH-g (17 mg/kg); TPH-d(140 mg/kg); TPH-mo (340 mg/kg); Blow count to cut sample 7/9/11.		
0810	AP-BH3-10.5		10	See Side		SM	MEDIUM TO FINE SILTY SAND: Light brown, moist, micaceous, slight petroleum hydrocarbon odor (5 ppmv on PID; Soil sample analytical results: xylene (0.0058 mg/kg); TPH-d (3.5 mg/kg); All others ND. Blow count to cut sample 9/10/12.		
0854	AP-BH3-15.5			See Side		SM	MEDIUM TO FINE SILTY SAND: Light brown, moist, micaceous, no petroleum hydrocarbon odor (0 ppmv on PID; Soil sample analytical results: xylene (0.023 mg/kg); TPH-d (4.6 mg/kg); All others ND. Blow count to cut sample 10/11/14.		
0910	AP-BH3-20.5		20	See Side		SM	CLAYEY SILT: Light brown, moist, micaceous, no petroleum odor (0 ppmv on PID); Soil sample not analyzed. Blow count to cut sample: 9/10/13.		
0921	AP-BH3-25.5			NA		ML	CLAYEY SILT: Light brown, moist, micaceous, no petroleum odor (0 ppmv on PID); Soil sample analytical results: All ND. Blow count to cut sample: 11/12/15.		
0932	AP-BH3-30.5		30	See Side		ML	Water table at 33.0 feet bgs		
1000	AP-BH3-35.0			See Side		SM	MEDIUM TO COARSE GRAINED SAND: Light brown, wet, iron stained, micaceous, no petroleum odor (0 ppmv on PID). Soil sample analytical results: All ND except TPH-d (1.2 mg/kg). Blow count to cut sample: 9/12/13.		
1015	AP-BH3-40.5		40	NA		SM	MEDIUM TO COARSE GRAINED SAND: Light brown, wet, iron stained, micaceous, no petroleum odor (0 ppmv on PID). Soil sample not analyzed. Blow count to cut sample: 10/12/15.		
1033	AP-BH3-45.5			See Side		SM	MEDIUM TO COARSE GRAINED SAND: Light brown, wet, iron stained, micaceous, no petroleum odor (0 ppmv on PID). Soil sample analytical results all ND except TPH-d (6.4 mg/kg) and TPH-mo (15 mg/kg). Blow count to cut sample: 11/12/14.		
			50				Total Depth: 45.5' bgs.		
			60						

WELL COMPLETION NOTES: Solid 2" diameter schedule 40 PVC to 25 feet below ground surface; bentonite chip seal from 22.0 to 24.0 feet below ground surface; screen set from 25.0 to 45.0 feet below ground level with 0.010 screen; concrete slurry cement grout from 22.0 to 0.5 feet bgs; Monterey #212 filter sand pack; locking cap on top of case with traffic box set in ground. End cap is set at base of screened pipe.

Well Casing Elevation is 169.65 feet above mean sea level  
Coordinates of well are 2355663.17 feet north, 6136046.80 feet east, California State Plane Coordinate System Zone 4, NAD83.  
Coordinates: Latitude 37.28906208 degrees North, Longitude -120.4630844 degrees West  
Longitude and Latitude Horizontal coordinates tied to US&GS Benchmark A85 (PID HS1152), WGS 1984 Spheroid, NAD83 Projection

## SOIL BORING REPORT

Project	Anderson-Polzine		Project Number		
Location	1375 Brantley Street, Merced		Start Date/Time	06/27/2006-0730	Finish Date/Time 06/27/2006-1130
Drilled By	Earthtec Ltd		Logged By	SGM	Reviewed By
Drilling Method	10" diameter continuous hollow stem		Weather/Temp(°F)	Clear / Hot	
Bit Type	Auger	Bit Size 10"	Field Monitor	PID - Mini-Rae 2000 #4132	
Sampling	18x2" California modified split spoon		Surface Conditions	Dirt/Asphalt/Rock	
			Ground Elevation	(Mean Sea Level) 169.0'	

Time	Sampled Depth Interval and Number	Soil Boring Schematic	Depth (ft)	Laboratory Analysis	Graphic Log	Soil Group Symbol (USCS)	Water Level Information		
							Depth to Groundwater (ft)		
							Date - Time	06/27/2006	
							Depth of Hole (ft)	45.5'	
Soil Description									
1430							MEDIUM TO FINE SILTY SAND: Light brown, moist, micaceous, no petroleum hydrocarbon odor (0 ppmv on PID; No soil samples analyzed. Blow count to cut sample 6/8/9.		
1435				NA		SM			
1445	AP-BH4-10.5		10	See Side		SM	MEDIUM TO FINE SILTY SAND: Light brown, moist, micaceous, slight petroleum hydrocarbon odor (5 ppmv on PID); Soil sample analytical results: All ND except for TPH-d (16 mg/kg) and TPH-mo (30 mg/kg); Blow count to cut sample 7/10/12.		
1455	AP-BH4-15.5			NA		SM	MEDIUM TO FINE SILTY SAND: Light brown, moist, micaceous, slight petroleum hydrocarbon odor (<5 ppmv on PID); No soil samples analyzed. Blow count to cut sample 10/11/12.		
1510	AP-BH4-20.5		20	See Side		SM	MEDIUM TO FINE SILTY SAND: Light brown, moist, micaceous, no petroleum hydrocarbon odor (0 ppmv on PID; Soil sample analytical results all ND except TPH-d (14 mg/kg) and TPH-mo(17 mg/kg); Blow count to cut sample 10/12/15.		
1525	AP-BH4-25.5			NA		ML	CLAYEY SILT: Light brown, moist, micaceous, no petroleum odor (0 ppmv on PID); Soil sample not analyzed. Blow count to cut sample: 11/12/14.		
1535	AP-BH4-30.5		30	See Side		ML	CLAYEY SILT: Light brown, moist, micaceous, no petroleum odor (0 ppmv on PID); Soil sample analytical results all ND except TPH-d (9.7 mg/kg) and TPH-mo(14 mg/kg). Blow count to cut sample: 11/12/14. Water table at 33.0 feet bgs		
1545	AP-BH4-35.0			NA		SM	MEDIUM TO FINE SILTY SAND: Light brown, moist, micaceous, no petroleum hydrocarbon odor (0 ppmv on PID; Soil sample not analyzed. Blow count to cut sample 12/13/14.		
1555	AP-BH4-40.5		40	See Side		SM	MEDIUM TO COARSE GRAINED SAND: Light brown, wet, iron stained, micaceous, no petroleum odor (0 ppmv on PID). Soil sample analytical results all ND except for TPH-d (6.8 mg/kg). Blow count to cut sample: 10/14/16.		
						SM	No sample recovered		
							Total Depth: 45.5' bgs.		
			50						
			60						

WELL COMPLETION NOTES: Solid 2" diameter schedule 40 PVC to 25 feet below ground surface; bentonite chip seal from 22.0 to 24.0 feet below ground surface; screen set from 25.0 to 45.0 feet below ground level with 0.010 screen; concrete slurry cement grout from 22.0 to 0.5 feet bgs; Monterey #212 filter sand pack; locking cap on top of case with traffic box set in ground. End cap is set at base of screened pipe.

Well Casing Elevation is 169.73 feet above mean sea level  
Coordinates of well are 2355604.56 feet north, 6136042.25 feet east, California State Plane Coordinate System Zone 4, NAD83.  
Coordinates: Latitude 37.28890097 degrees North, Longitude -120.463969 degrees West  
Longitude and Latitude Horizontal coordinates tied to USC&GS Benchmark A85 (PID HS1152), WGS 1984 Spheroid, NAD83 Projection

## SOIL BORING REPORT

Project <u>Anderson-Polzine</u>						Project Number _____	
Location <u>1375 Brantley Street, Merced</u>						Start Date/Time <u>08/11/2006-0940</u> Finish Date/Time <u>08/11/2006-1159</u>	
Drilled By <u>Woodward Drilling Inc.</u>						Logged By <u>SGM</u> Reviewed By _____	
Drilling Method <u>AGS 9030 Geoprobe (continuous core)</u>						Weather/Temp(°F) <u>Clear / Hot</u>	
Bit Type <u>Push</u> Bit Size <u>1"</u>						Field Monitor <u>PID - Mini-Rae 2000 #4132</u>	
Sampling <u>Continuous (48") plastic tubes</u>						Surface Conditions <u>Dirt/Asphalt/Rock</u>	
						Ground Elevation <u>(Mean Sea Level) 169.0'</u>	

Time	Sampled Depth Interval and Number	Soil Boring Schematic	Depth (ft)	Laboratory Analysis	Graphic Log	Soil Group Symbol (USCS)	Water Level Information		
							Depth to Groundwater (ft)		
							33.0'		
							08/11/2006		
							38.0'		
							Soil Description		
1430							MEDIUM TO FINE SILTY SAND: Light brown, moist, micaceous, slight petroleum hydrocarbon odor (10 ppmv on PID); Analytical results: benzene (0.44 mg/kg); toluene (0.034 mg/kg); ethylbenzene (0.014 mg/kg); xylene (0.078 mg/kg); TPH-g (ND); TPH-d (3.8 mg/kg).		
1435	AP-BH5-5.5			See Side		SM			
1445	AP-BH5-10.5		10	See Side		SM	MEDIUM TO FINE SILTY SAND: Light brown, moist, micaceous, slight petroleum hydrocarbon odor (15 ppmv on PID); Analytical results: benzene (0.46 mg/kg); toluene (1.5 mg/kg); ethylbenzene (3.4 mg/kg); xylene (18 mg/kg); TPH-g (250 mg/kg); TPH-d (760 mg/kg); TPH-mo (240 mg/kg).		
1455	AP-BH5-15.5			See Side		SM	MEDIUM TO FINE SILTY SAND: Light brown, moist, micaceous, slight petroleum hydrocarbon odor (<5 ppmv on PID); Analytical results: benzene (0.0083 mg/kg); toluene (0.017 mg/kg); ethylbenzene (0.13 mg/kg); xylene (0.63 mg/kg); TPH-g (13 mg/kg); TPH-d (240 mg/kg).		
1510	AP-BH5-20.5		20	See Side		SM	MEDIUM TO FINE SILTY SAND: Light brown, moist, micaceous, no petroleum hydrocarbon odor (0 ppmv on PID); Analytical results: benzene (0.006 mg/kg); ethylbenzene (0.013 mg/kg); xylene (0.056 mg/kg); TPH-d (1.1 mg/kg).		
1525	AP-BH5-25.5			All ND		ML	CLAYEY SILT: Light brown, moist, micaceous, no petroleum odor (0 ppmv on PID); All analytical results are ND.		
1535	AP-BH5-30.5		30	All ND		ML	CLAYEY SILT: Light brown, moist, micaceous, no petroleum odor (0 ppmv on PID); Soil sample analytical results all ND.		
1545	AP-BH5-35.0			All ND		SM	Water table at 33.0 feet bgs		
							MEDIUM TO FINE SILTY SAND: Light brown, moist, micaceous, no petroleum hydrocarbon odor (0 ppmv on PID). Soil sample analytical results all ND.		
			40				Total Depth: 45.5' bgs.		
			50						
			60						

BORE HOLE COMPLETION NOTES: Bore hole sampled to total depth with continuous core. Soil hole backfilled with neat cement grout as per MCDPH permit requirements using a tremie pipe from bottom of hole to ground surface.

D:\Environmental\AP\AP-BH5.ai

**GEO TRACKER ID: T0604713690**  
**P.M. 13.20**



## SOIL BORING REPORT

Project		Anderson-Polzine		Project Number			
Location		1375 Brantley Street, Merced		Start Date/Time		08/11/2006-1210 Finish Date/Time 08/11/2006-1450	
Drilled By		Woodward Drilling Inc.		Logged By		SGM Reviewed By	
Drilling Method		AGS 9030 Geoprobe (continuous core)		Weather/Temp(°F)		Clear / Hot	
Bit Type		Push Bit Size 1"		Field Monitor		PID - Mini-Rae 2000 #4132	
Sampling		Continuous (48") plastic tubes		Surface Conditions		Dirt/Asphalt/Rock	
				Ground Elevation		(Mean Sea Level) 169.0'	

Time	Sampled Depth Interval and Number	Soil Boring Schematic	Depth (ft)	Laboratory Analysis	Graphic Log	Soil Group Symbol (USCS)	Water Level Information		
							Depth to Groundwater (ft)		
							33.0'		
							08/11/2006		
							38.0'		
							Soil Description		
1210							MEDIUM TO FINE SILTY SAND: Light brown, moist, micaceous, slight petroleum hydrocarbon odor (5 ppmv on PID); Soil sample analytical results: benzene (0.15 mg/kg); toluene (0.28 mg/kg); ethylbenzene (0.19 mg/kg); xylene (1.1 mg/kg); TPH-g (20 mg/kg); TPH-d (46 mg/kg).		
1250	AP-BH6-5.5			See Side		SM	MEDIUM TO FINE SILTY SAND: Light brown, moist, micaceous, slight petroleum hydrocarbon odor (5 ppmv on PID); Soil sample analytical results: All ND except for TPH-d (1.2 mg/kg).		
1305	AP-BH6-10.5		10	See Side		SM	MEDIUM TO FINE SILTY SAND: Light brown, moist, micaceous, slight petroleum hydrocarbon odor (<5 ppmv on PID); No soil samples analyzed. Blow count to cut sample 10/11/12.		
1320	AP-BH6-15.5			See Side		SM	MEDIUM TO FINE SILTY SAND: Light brown, moist, micaceous, slight petroleum hydrocarbon odor (0 ppmv on PID); Soil sample analytical results all ND except TPH-d (14 mg/kg).		
1330	AP-BH6-20.5		20	See Side		SM	CLAYEY SILT: Light brown, moist, micaceous, no petroleum odor (0 ppmv on PID); Soil sample analytical results all ND.		
1345	AP-BH6-25.5			All ND		ML	CLAYEY SILT: Light brown, moist, micaceous, no petroleum odor (0 ppmv on PID); Soil sample analytical results all ND.		
1355	AP-BH6-30.5		30	All ND		ML	Water table at 33.0 feet bgs		
1405	AP-BH6-35.0			See Side		SM	MEDIUM TO FINE SILTY SAND: Light brown, moist, micaceous, no petroleum hydrocarbon odor (0 ppmv on PID); Soil sample analytical results all ND except TPH-d (2.5 mg/kg).		
			40				Total Depth: 38.0' bgs.		
			50						
			60						

BORE HOLE COMPLETION NOTES: Bore hole sampled to total depth with continuous core. Soil hole backfilled with neat cement grout as per MCDPH permit requirements using a tremie pipe from bottom of hole to ground surface.

## SOIL BORING REPORT

Project		Anderson-Polzine		Project Number			
Location		1375 Brantley Street, Merced		Start Date/Time		02/06/2007	
Drilled By		V&W Drilling Inc.		Finish Date/Time		02/06/2007	
Drilling Method		AGS 9030 Geoprobe (continuous core)		Logged By		SGM	
Bit Type		Push		Reviewed By			
Bit Size		1"		Weather/Temp(°F)		Clear / Cool	
Sampling		Continuous (48") plastic tubes		Field Monitor		PID - Mini-Rae 2000 #4132	
				Surface Conditions		Dirt/Asphalt/Rock	
				Ground Elevation		(Mean Sea Level) 169.0'	

Time	Sampled Depth Interval and Number	Soil Boring Schematic	Depth (ft)	Laboratory Analysis	Graphic Log	Soil Group Symbol (USCS)	Water Level Information		
							Depth to Groundwater (ft)	Date - Time	Depth of Hole (ft)
							Soil Description		
0825	AP-BH7-4.0-5.5			NA		SM	MEDIUM TO FINE SILTY SAND: Light brown, moist, micaceous, slight petroleum hydrocarbon odor (5 ppmv on PID).		
0845	AP-BH7-9.5-11.0		10	See Side		SM	MEDIUM TO FINE SILTY SAND: Light brown, moist, micaceous, slight petroleum hydrocarbon odor (5 ppmv on PID); Soil sample analytical results: benzene (0.34 mg/kg); TPH-g (1100 mg/kg). Total lead (245 mg/kg).		
0905	AP-BH7-13.5-15.0			NA		SM	MEDIUM TO FINE SILTY SAND: Light brown, moist, micaceous, slight petroleum hydrocarbon odor (<5 ppmv on PID).		
0920	AP-BH7-17.5-19.0		20	See Side		SM	MEDIUM TO FINE SILTY SAND: Light brown, moist, micaceous, slight petroleum hydrocarbon odor (10 ppmv on PID; Soil sample analytical results all ND except TPH-g (130 mg/kg). Total lead (2.89 mg/kg).		
0925	AP-BH7-23.0								
0936	AP-BH7-26.0			NA		ML	CLAYEY SILT: Light brown, moist, micaceous, no petroleum odor (0 ppmv on PID).		
							Total Depth: 26.0' bgs.		

BORE HOLE COMPLETION NOTES: Bore hole sampled to total depth with continuous core. Soil hole backfilled with neat cement grout as per MCDPH permit requirements using a tremie pipe from bottom of hole to ground surface.

D:\Environmental\AP\AP-BH7.ai

**GEO TRACKER ID: T0604713690**  
**P.M. 13.20**

## SOIL BORING REPORT

Project <u>Anderson-Polzine</u>						Project Number _____			
Location <u>1375 Brantley Street, Merced</u>						Start Date/Time <u>02/06/2007</u> Finish Date/Time <u>02/06/2007</u>			
Drilled By <u>V&amp;W Drilling Inc.</u>						Logged By <u>SGM</u> Reviewed By _____			
Drilling Method <u>AGS 9030 Geoprobe (continuous core)</u>						Weather/Temp(°F) <u>Clear / Cool</u>			
Bit Type <u>Push</u> Bit Size <u>1"</u>						Field Monitor <u>PID - Mini-Rae 2000 #4132</u>			
Sampling <u>Continuous (48") plastic tubes</u>						Surface Conditions <u>Dirt/Asphalt/Rock</u>			
						Ground Elevation <u>(Mean Sea Level) 169.0'</u>			
Time	Sampled Depth Interval and Number	Soil Boring Schematic	Depth (ft)	Laboratory Analysis	Graphic Log	Soil Group Symbol (USCS)	Water Level Information		
							Depth to Groundwater (ft)	Date - Time	Depth of Hole (ft)
							Soil Description		
1000	AP-BH8-4.0-5.5		10	NA		SM	MEDIUM TO FINE SILTY SAND: Light brown, moist, micaceous, slight petroleum hydrocarbon odor (5 ppmv on PID).		
1005	AP-BH8-13.0-14.0		See Side	SM		MEDIUM TO FINE SILTY SAND: Light brown, moist, micaceous, slight petroleum hydrocarbon odor (5 ppmv on PID); Soil sample analytical results: All ND. Total lead (3.64 mg/kg).			
				SM		MEDIUM TO FINE SILTY SAND: Light brown, moist, micaceous, slight petroleum hydrocarbon odor (<5 ppmv on PID).			
1015	AP-BH8-22.0-23.0		20	See Side		ML	CLAYEY SILT: Light brown, moist, micaceous, no petroleum odor (0 ppmv on PID). Soil sample analytical results: All ND. Total lead (6.31 mg/kg). Total Depth: 23.0' bgs.		
			30						
			40						
			50						
			60						

BORE HOLE COMPLETION NOTES: Bore hole sampled to total depth with continuous core. Soil hole backfilled with neat cement grout as per MCDPH permit requirements using a tremie pipe from bottom of hole to ground surface.

D:\Environmental\AP\AP-BH8.ai

**GEO TRACKER ID: T0604713690**  
**P.M. 13.20**



## SOIL BORING REPORT

Project		Anderson-Polzine		Project Number			
Location		1375 Brantley Street, Merced		Start Date/Time		02/06/2007	
Drilled By		V&W Drilling Inc.		Finish Date/Time		02/06/2007	
Drilling Method		AGS 9030 Geoprobe (continuous core)		Logged By		SGM	
Bit Type		Push		Weather/Temp(°F)		Clear / Cool	
Bit Size		1"		Field Monitor		PID - Mini-Rae 2000 #4132	
Sampling		Continuous (48") plastic tubes		Surface Conditions		Dirt/Asphalt/Rock	
Ground Elevation		(Mean Sea Level) 169.0'					

Time	Sampled Depth Interval and Number	Soil Boring Schematic	Depth (ft)	Laboratory Analysis	Graphic Log	Soil Group Symbol (USCS)	Water Level Information		
							Depth to Groundwater (ft)	Date - Time	Depth of Hole (ft)
							Soil Description		
1400						SM	<p>MEDIUM TO FINE SILTY SAND: Light brown, moist, micaceous, slight petroleum hydrocarbon odor (5 ppmv on PID). Boring halted when concrete footing hit at 3.5' bgs.</p> <p>Total Depth: 3.5' bgs.</p>		

BORE HOLE COMPLETION NOTES: Bore hole sampled to total depth with continuous core. Soil hole backfilled with neat cement grout as per MCDPH permit requirements using a tremie pipe from bottom of hole to ground surface.

D:\Environmental\AP\AP-BH9.ai

**GEO TRACKER ID: T0604713690**  
**P.M. 13.20**

## SOIL BORING REPORT

Project <u>Anderson-Polzine</u>							Project Number _____		
Location <u>1375 Brantley Street, Merced</u>							Start Date/Time <u>02/06/2007</u> Finish Date/Time <u>02/06/2007</u>		
Drilled By <u>V&amp;W Drilling Inc.</u>							Logged By <u>SGM</u> Reviewed By _____		
Drilling Method <u>AGS 9030 Geoprobe (continuous core)</u>							Weather/Temp(°F) <u>Clear / Hot</u>		
Bit Type <u>Push</u> Bit Size <u>1"</u>							Field Monitor <u>PID - Mini-Rae 2000 #4132</u>		
Sampling <u>Continuous (48") plastic tubes</u>							Surface Conditions <u>Dirt/Asphalt/Rock</u>		
							Ground Elevation <u>(Mean Sea Level) 169.0'</u>		
Time	Sampled Depth Interval and Number	Soil Boring Schematic	Depth (ft)	Laboratory Analysis	Graphic Log	Soil Group Symbol (USCS)	Water Level Information		
							Depth to Groundwater (ft)		
							Date - Time		
							Depth of Hole (ft)		
							Soil Description		
1305									
1315	AP-BH10-4.0-5.0			See Side		SM	FINE SILTY SAND (Artificial Fill): Dark green, moist, moderate petroleum hydrocarbon odor (50 ppmv) on PID. Analytical results: benzene (0.44 mg/kg); TPH-g (430), all others ND. Total lead (5.27 mg/kg).		
1320	AP-BH10-11.0-12.0		10	See Side		SM	MEDIUM TO FINE SILTY SAND: Dark green to black, moist, micaceous, slight petroleum hydrocarbon odor (5 ppmv on PID). Analytical results: all ND. Total lead (3.58 mg/kg)		
1325	AP-BH10-14.0-15.0			NA			MEDIUM TO FINE SILTY SAND: Dark green to black, moist, micaceous, slight petroleum hydrocarbon odor (5 ppmv on PID).		
1330	AP-BH10-18.0-19.0		20	See Side		SM	MEDIUM TO FINE SILTY SAND: Dark green to black, moist, micaceous, slight petroleum hydrocarbon odor (5 ppmv on PID). Analytical results: benzene (0.02 mg/kg); TPH-g (1.7 mg/kg). Total lead (4.41 mg/kg).		
1345	AP-BH10-25.0-26.0			See Side		ML	MEDIUM TO FINE SILTY SAND: Dark green, moist, micaceous, no petroleum hydrocarbon odor (0 ppmv on PID).		
			30				CLAYEY SILT: Dark green to brown, moist, micaceous, no petroleum hydrocarbon odor (0 ppmv on PID). Analytical results: All ND. Total lead (7.11 mg/kg).		
							Total Depth: 26' bgs.		
			40						
			50						
			60						

D:\Environmental\AP\AP-BH10

**GEO TRACKER ID: T0604713690**  
**P.M. 13.20**

## SOIL BORING REPORT

Project		Anderson-Polzine		Project Number			
Location		1375 Brantley Street, Merced		Start Date/Time		02/06/2007      Finish Date/Time 02/06/2007	
Drilled By		V&W Drilling Inc.		Logged By		SGM      Reviewed By	
Drilling Method		AGS 9030 Geoprobe (continuous core)		Weather/Temp(°F)		Clear / Hot	
Bit Type		Push      Bit Size 1"		Field Monitor		PID - Mini-Rae 2000 #4132	
Sampling		Continuous (48") plastic tubes		Surface Conditions		Dirt/Asphalt/Rock	
				Ground Elevation		(Mean Sea Level) 169.0'	

Time	Sampled Depth Interval and Number	Soil Boring Schematic	Depth (ft)	Laboratory Analysis	Graphic Log	Soil Group Symbol (USCS)	Water Level Information		
							Depth to Groundwater (ft)	Date - Time	Depth of Hole (ft)
							Soil Description		
1030									
1035	AP-BH11-3.0-4.0			See Side		SM	MEDIUM TO FINE SILTY SAND: Light brown, moist, micaceous, no petroleum hydrocarbon odor (0 ppmv on PID. Analytical results: benzene (0.01 mg/kg); TPH-g (1.8 mg/kg). Total lead (6.01 mg/kg).		
1040	AP-BH11-7.0-8.0		10	NA		SM	MEDIUM TO FINE SILTY SAND: Light brown, moist, micaceous, slight petroleum hydrocarbon odor (5 ppmv on PID).		
1055	AP-BH11-14.0-15.0			NA		SM	MEDIUM TO FINE SILTY SAND: Light brown, moist, micaceous, slight petroleum hydrocarbon odor (<5 ppmv on PID).		
1105	AP-BH11-19.5-20.0		20	NA					
1115	AP-BH11-22.5-23.5			See Side		ML	CLAYEY SILT: Light brown, moist, micaceous, no petroleum odor (0 ppmv on PID). Analytical results: All ND. Total lead (4.25 mg/kg).		
							Total Depth: 23.5' bgs.		
			30						
			40						
			50						
			60						

D:\Environmental\AP\AP-BH11

**GEO TRACKER ID: T0604713690**  
**P.M. 13.20**



## SOIL BORING REPORT


Project		Anderson-Polzine		Project Number			
Location		1375 Brantley Street, Merced		Start Date/Time		02/06/2007      Finish Date/Time 02/06/2007	
Drilled By		V&W Drilling Inc.		Logged By		SGM      Reviewed By	
Drilling Method		AGS 9030 Geoprobe (continuous core)		Weather/Temp(°F)		Clear / Hot	
Bit Type		Push      Bit Size 1"		Field Monitor		PID - Mini-Rae 2000 #4132	
Sampling		Continuous (48") plastic tubes		Surface Conditions		Dirt/Asphalt/Rock	
				Ground Elevation		(Mean Sea Level) 169.0'	

Time	Sampled Depth Interval and Number	Soil Boring Schematic	Depth (ft)	Laboratory Analysis	Graphic Log	Soil Group Symbol (USCS)	Water Level Information		
							Depth to Groundwater (ft)	Date - Time	Depth of Hole (ft)
							Soil Description		
1140	AP-BH12-4.0-5.0			NA		SM	MEDIUM TO FINE SILTY SAND: Light brown, moist, micaceous, no petroleum hydrocarbon odor (0 ppmv on PID).		
1150	AP-BH12-7.0-8.0		10	See Side		SM	MEDIUM TO FINE SILTY SAND: Light brown, moist, micaceous, no petroleum hydrocarbon odor (0 ppmv on PID). Analytical results: All ND. Total lead (4.45 mg/kg).		
1200	AP-BH12-13.0-14.0			See Side		SM	MEDIUM TO FINE SILTY SAND: Light brown, moist, micaceous, no petroleum hydrocarbon odor (0 ppmv on PID). Analytical results: All ND.		
1215	AP-BH12-20.0-21.0		20	NA		ML	CLAYEY SILT: Light brown, moist, micaceous, no petroleum odor (0 ppmv on PID).		
1230	AP-BH12-23.0-24.0			See Side		ML	CLAYEY SILT: Light brown, moist, micaceous, no petroleum odor (0 ppmv on PID). Analytical results: All ND. Total lead (5.52 mg/kg).		
							Total Depth: 24' bgs.		

D:\Environmental\AP\AP-BH12

**GEO TRACKER ID: T0604713690**  
**P.M. 13.20**

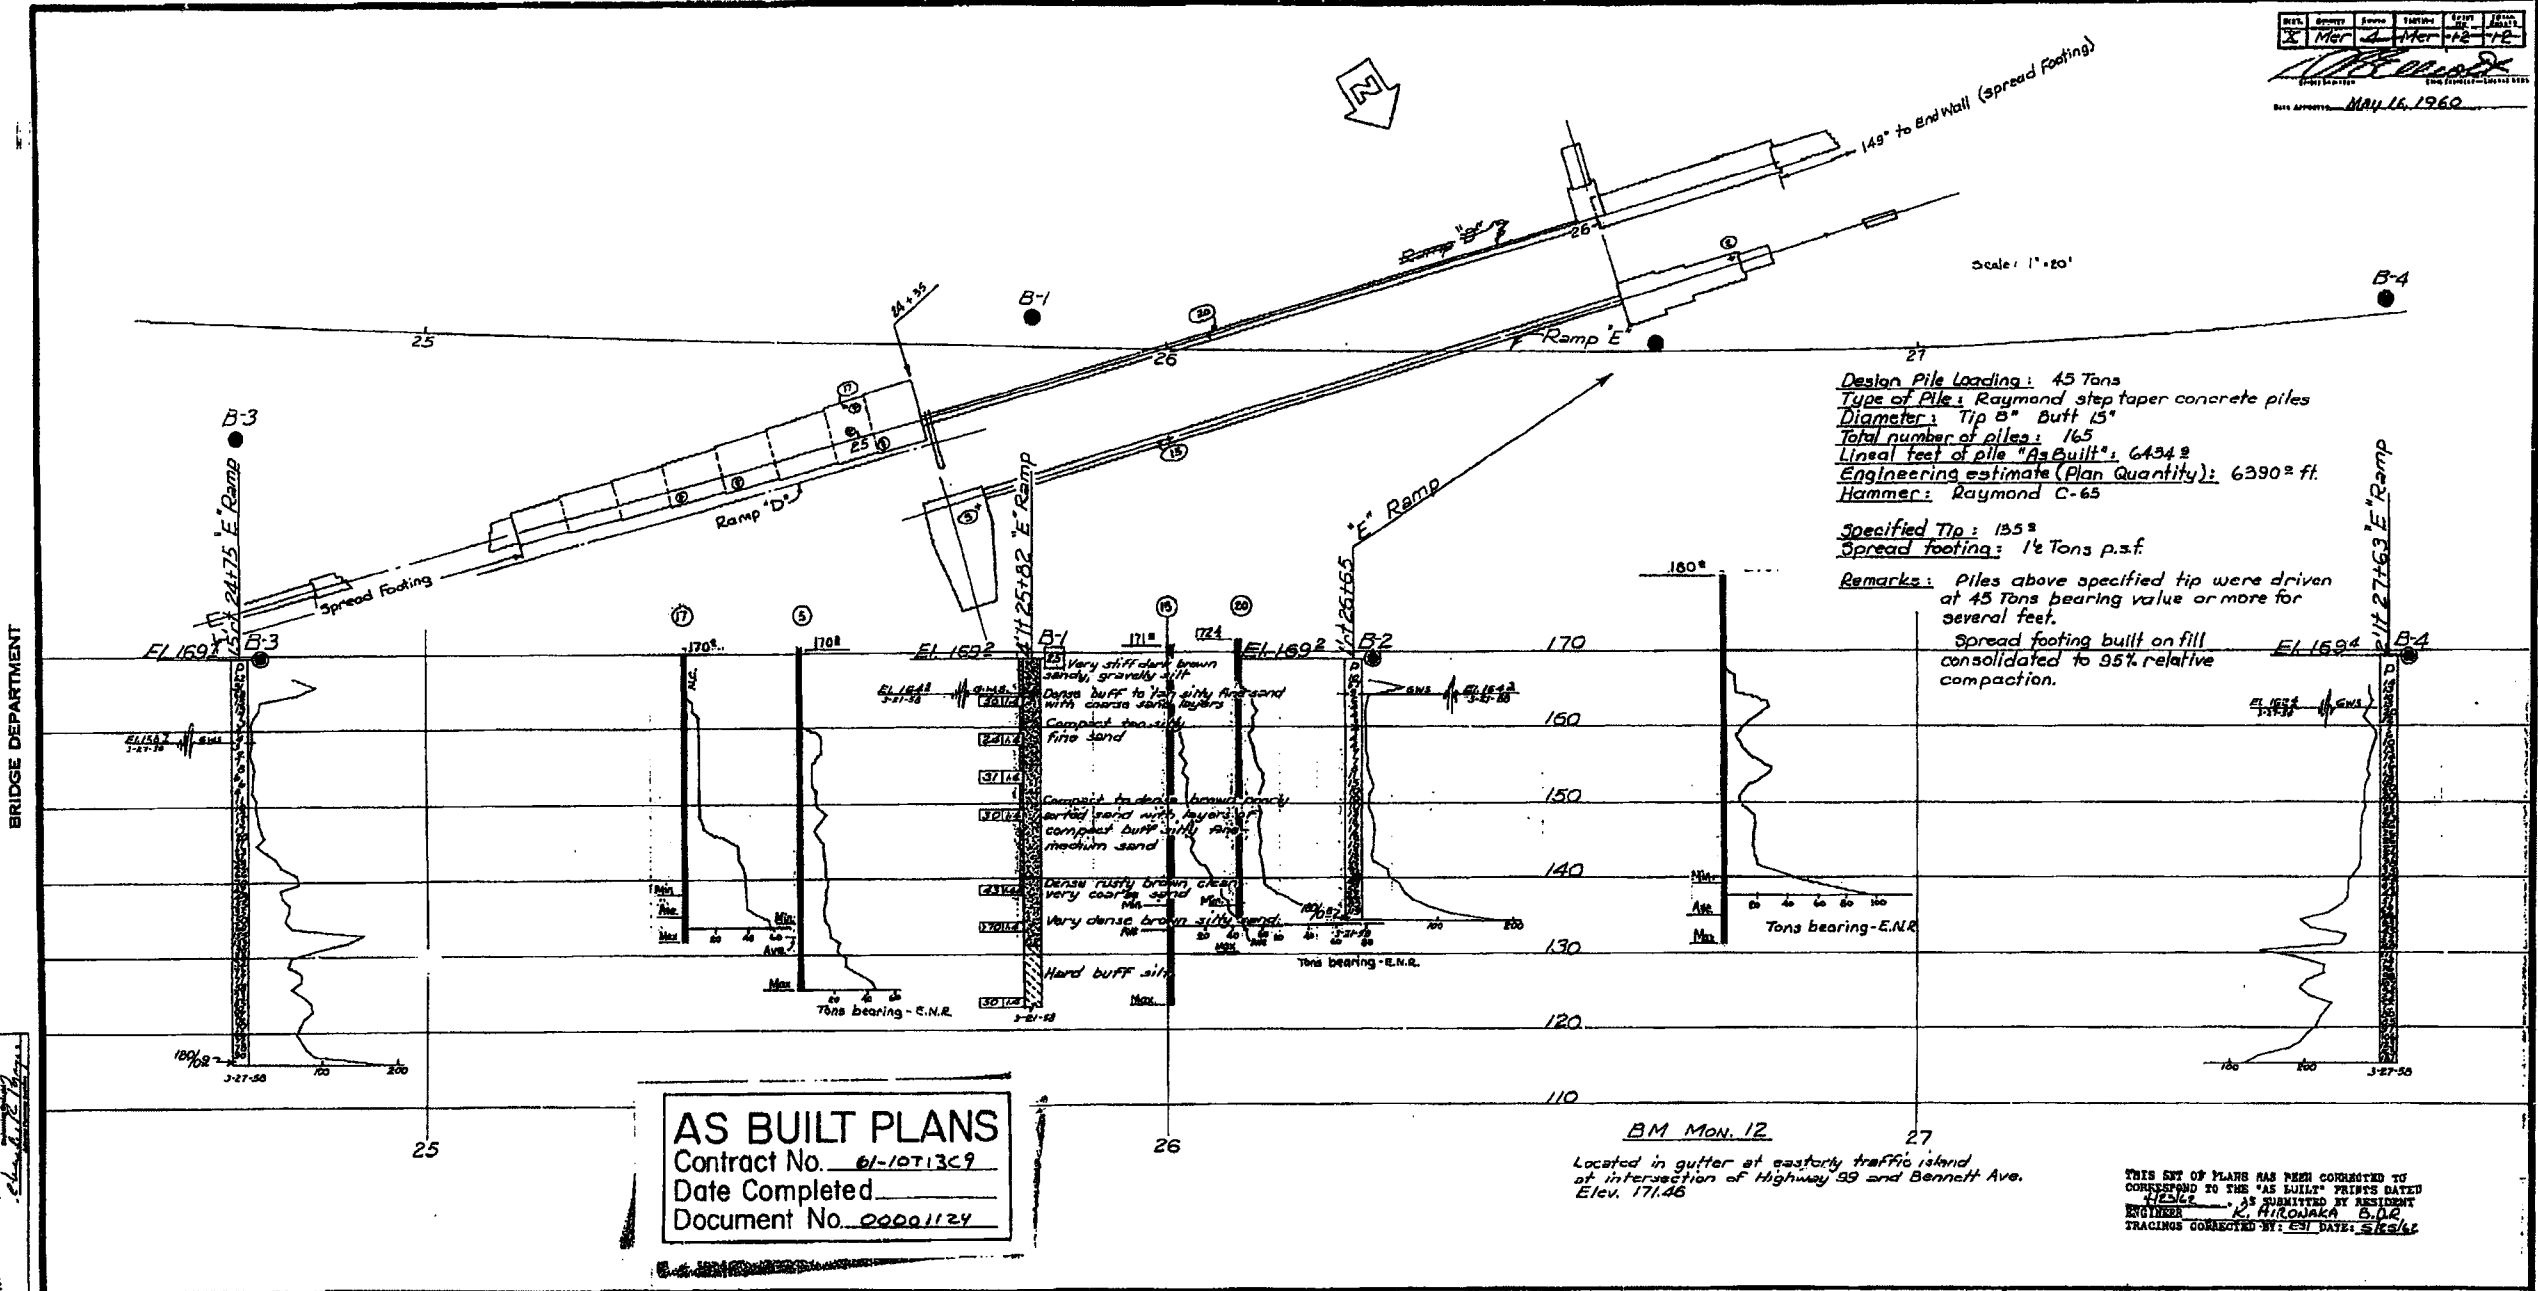

Design Pile Loading: 45 Tons  
Type of Pile: Raymond step taper concrete piles  
Diameter: Tip 8" Butt 15"  
Total number of piles: 165  
Lineal feet of pile "As Built": 6434'  
Engineering estimate (Plan Quantity): 6390' ft.  
Hammer: Raymond C-65


Specified Tip: 135'  
Spread footing: 1 1/2 Tons p.s.f.

Remarks: Piles above specified tip were driven at 45 tons bearing value or more for several feet.  
Spread footing built on fill consolidated to 95% relative compaction.

AS BUILT PLANS  
Contract No. 61-10T13C9  
Date Completed  
Document No. 00001124


B.M. MON. 12  
Located in gutter at easterly traffic island at intersection of Highway 99 and Bennett Ave. Elev. 171.46

THIS SET OF PLANS HAS BEEN CORRECTED TO CORRESPOND TO THE "AS BUILT" FIELD DATA. AS SUBMITTED BY RESIDENT ENGINEER K. HIROJAKA 5.12.60 TRACINGS CORRECTED BY: ESI DATE: 5/12/60

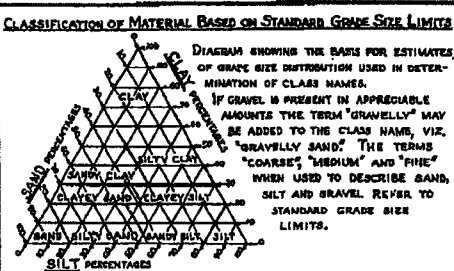

LEGEND OF EARTH MATERIALS

GRAVEL	SILTY CLAY OR CLAYEY SILT
SAND	PEAT AND/OR ORGANIC MATTER
SILT	FILL MATERIAL
CLAY	IGNEOUS ROCK
SANDY CLAY OR CLAYEY SAND	SEDIMENTARY ROCK
SANDY SILT OR SILTY SAND	METAMORPHIC ROCK

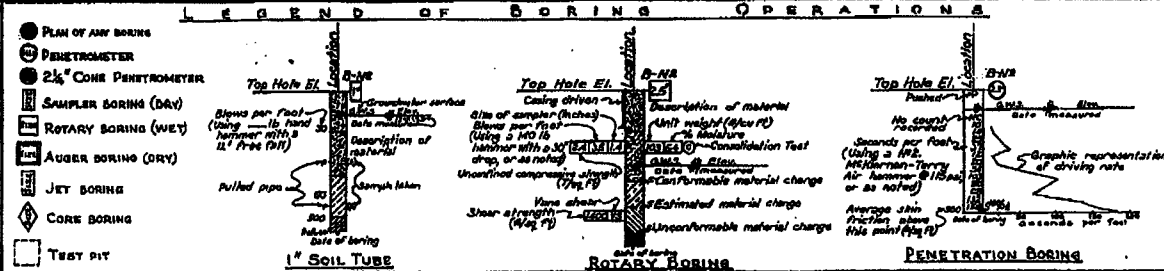

NOTES


STATE OF CALIFORNIA  
DEPARTMENT OF PUBLIC WORKS  
DIVISION OF HIGHWAYS

Yosemite Way On-Ramp Undercrossing


LOG OF TEST BORINGS

SCALE 1"=10' BRIDGE 39-141 FILE DRAWING C-6008-12

I HEREBY CERTIFY THAT THIS IS A TRUE AND ACCURATE COPY OF THE ABOVE DOCUMENT TAKEN UNDER MY DIRECTION AND CONTROL ON THIS DATE IN SACRAMENTO, CALIFORNIA PURSUANT TO AUTHORIZATION BY THE DIRECTOR OF PUBLIC WORKS.  
DATE 1/1/61 SIGNATURE [Signature] TITLE [Title]

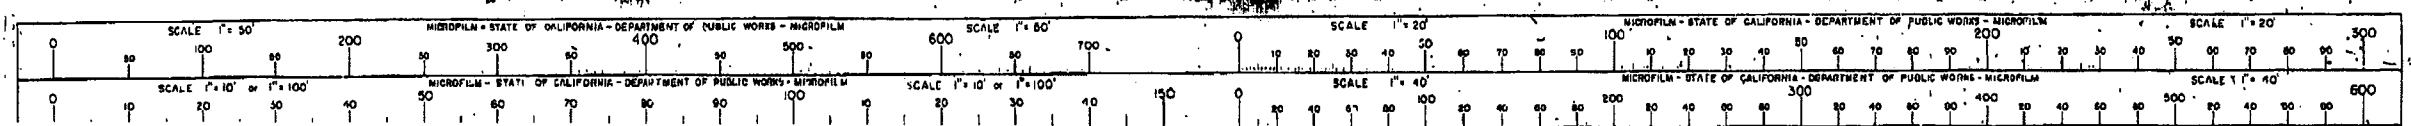


AS BUILT PLANS  
Contract No. 61-10T13C9  
Date Completed  
Document No. 00001124

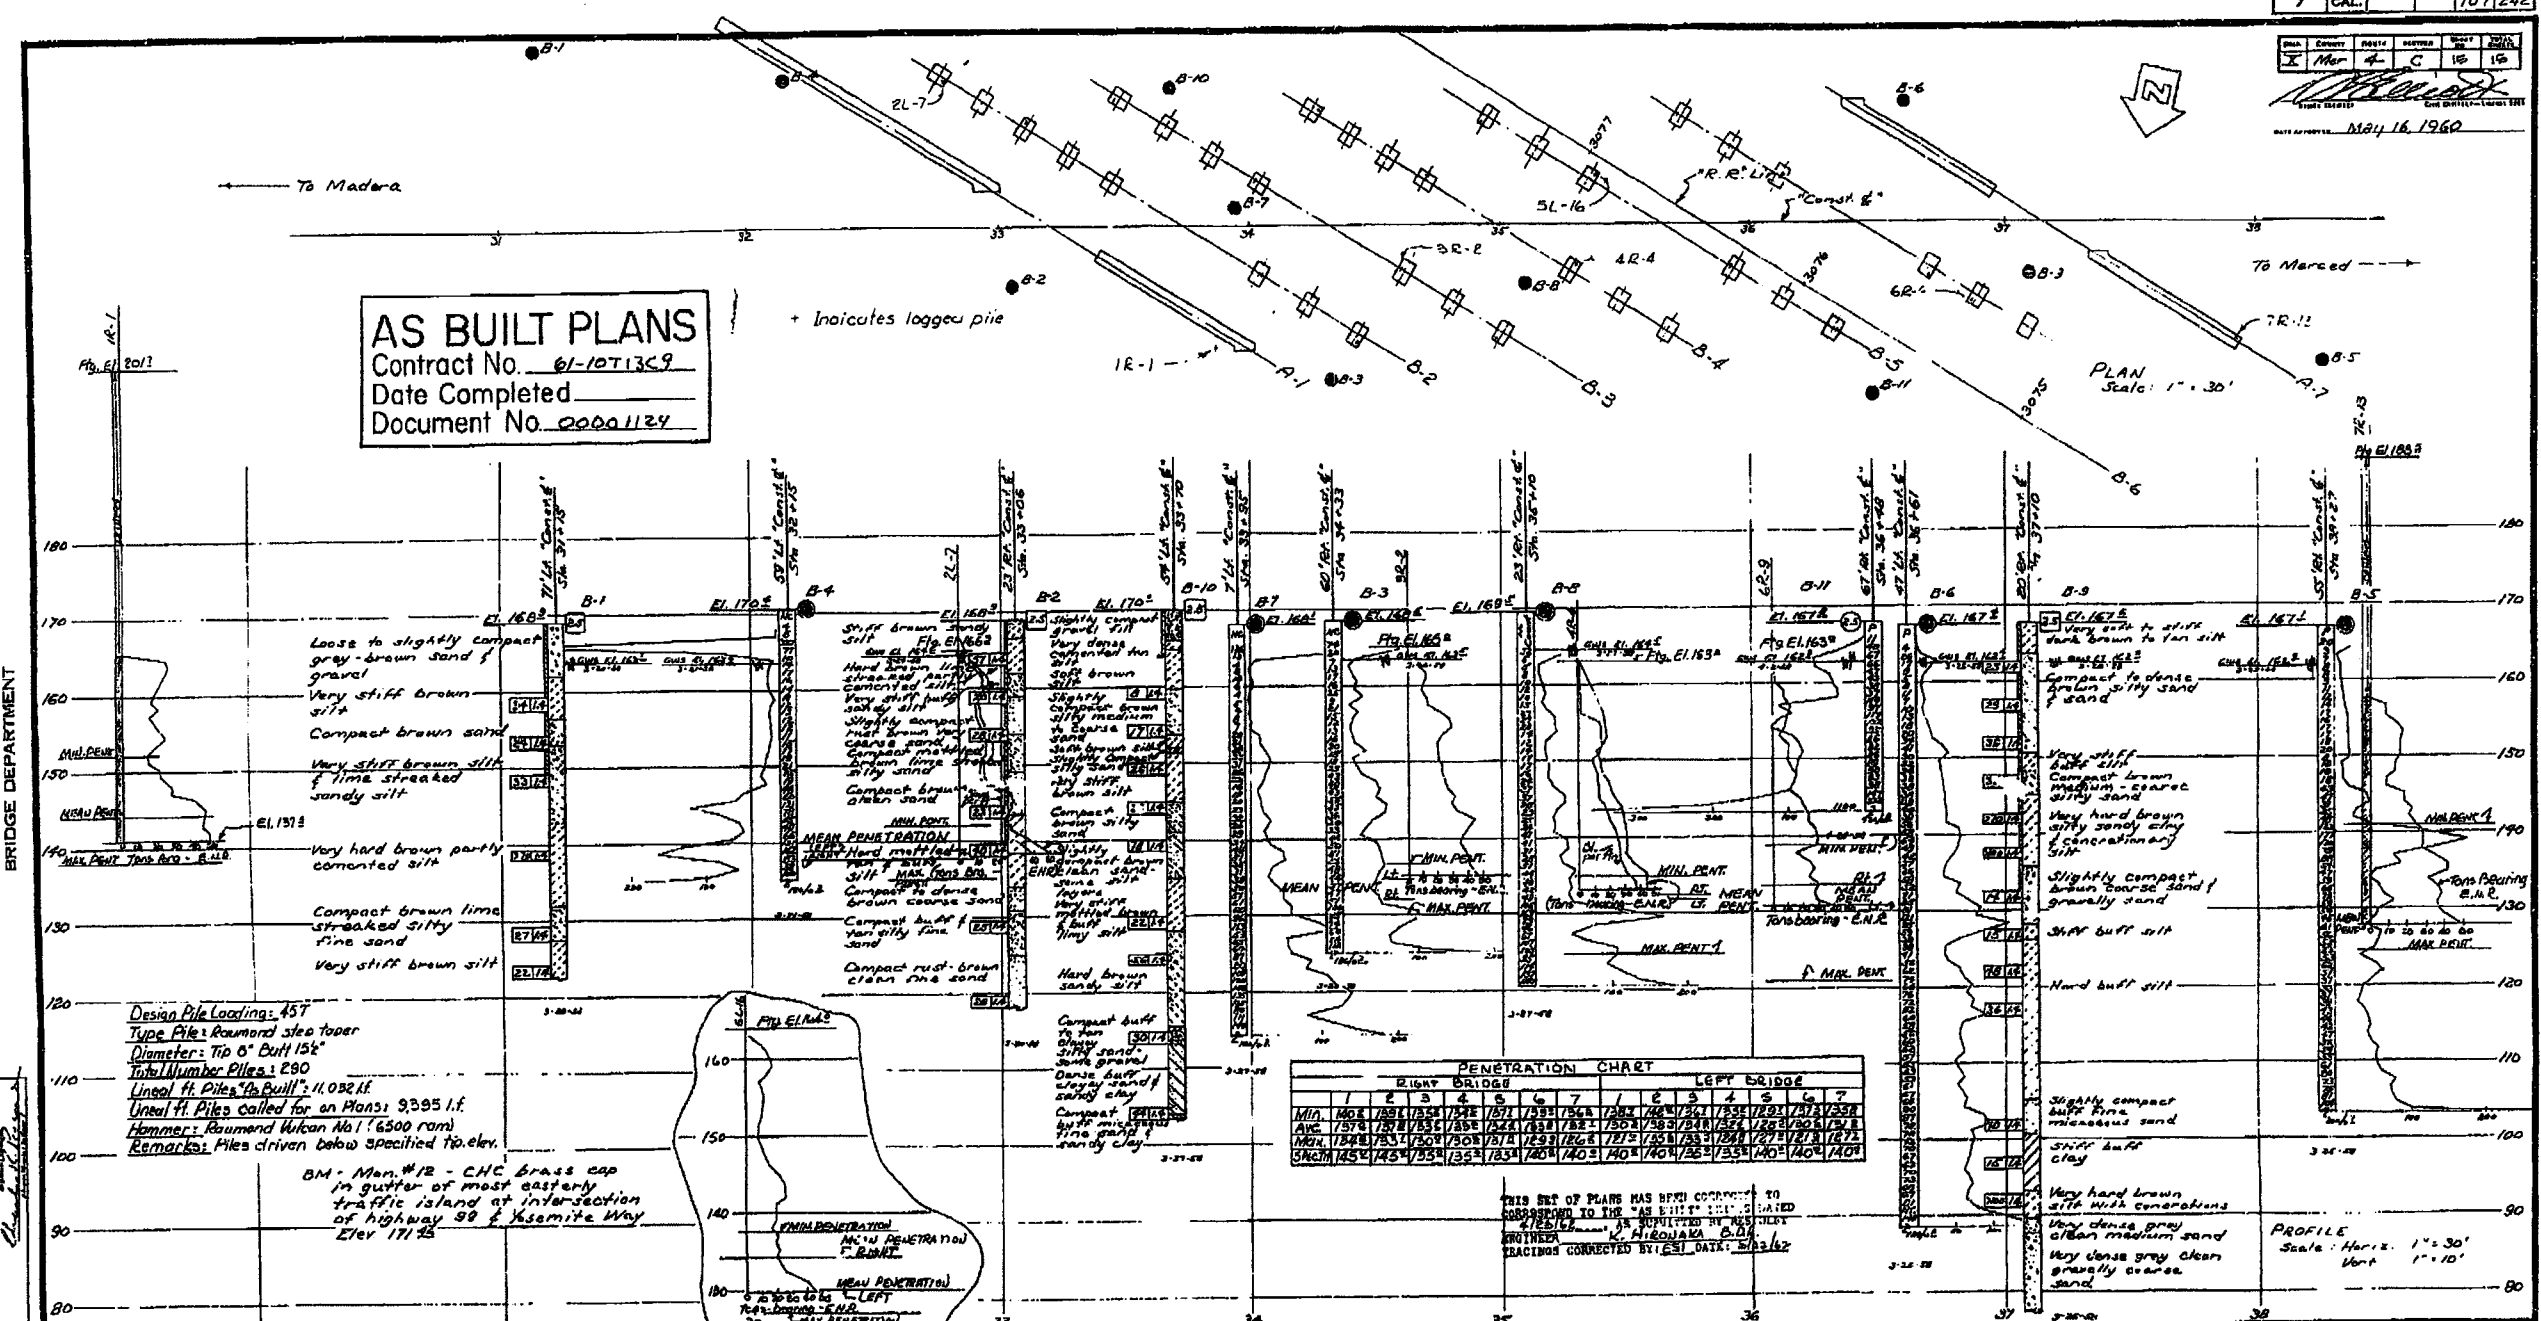


PENETRATION CHART

RIGHT BRIDGE							LEFT BRIDGE						
1	2	3	4	5	6	7	1	2	3	4	5	6	7
MIN. 1578	1578	1578	1578	1578	1578	1578	1578	1578	1578	1578	1578	1578	1578
MAX. 1578	1578	1578	1578	1578	1578	1578	1578	1578	1578	1578	1578	1578	1578

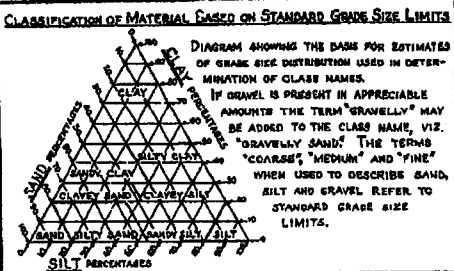

LEGEND OF EARTH MATERIALS

GRAVEL	SILTY CLAY OR CLAYEY SILT
SAND	PEAT AND/OR ORGANIC MATTER
SILT	FILL MATERIAL
CLAY	IGNEOUS ROCK
SANDY CLAY OR CLAYEY SAND	SEDIMENTARY ROCK
SANDY SILT OR SILTY SAND	METAMORPHIC ROCK

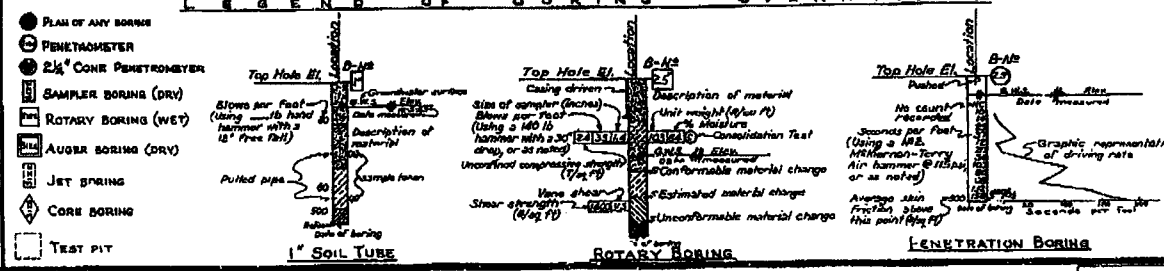

NOTES  
Classification of earth material as shown on this sheet is based upon field inspection and is not to be construed to imply mechanical analysis.

EAST MERCED OVERHEAD  
LOG OF TEST BORINGS




SCALE: As Noted  
BRIDGE 39-130  
DRAWING C-5030-15

I HEREBY CERTIFY THAT THIS IS A TRUE AND ACCURATE COPY OF THE ABOVE DOCUMENT TAKEN UNDER MY DIRECTION AND CONTROL ON THIS DATE IN SACRAMENTO, CALIFORNIA PURSUANT TO AUTHORIZATION BY THE DIRECTOR OF PUBLIC WORKS.

DATE: / / SIGNATURE: / TITLE: /




**AS BUILT PLANS**  
Contract No. 61-10713C9  
Date Completed \_\_\_\_\_  
Document No. 00001124

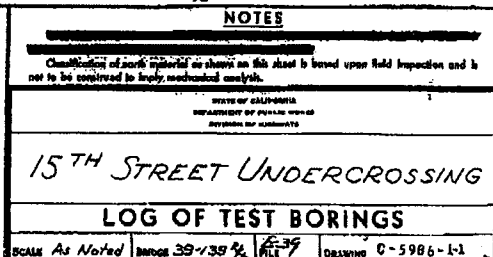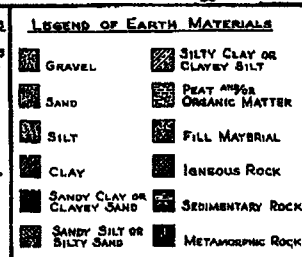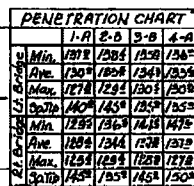

I HEREBY CERTIFY THAT THIS IS A TRUE AND ACCURATE COPY OF THE ABOVE DOCUMENT TAKEN  
UNDER MY DIRECTION AND CONTROL ON THIS DATE IN SACRAMENTO, CALIFORNIA PURSUANT TO  
AUTHORIZATION BY THE DIRECTOR OF PUBLIC WORKS.

DATE 12/1/78 SIGNATURE [Signature] TITLE Director

**AS BUILT PLANS**  
Contract No. 61-10T13C9  
Date Completed  
Document No. 00091124

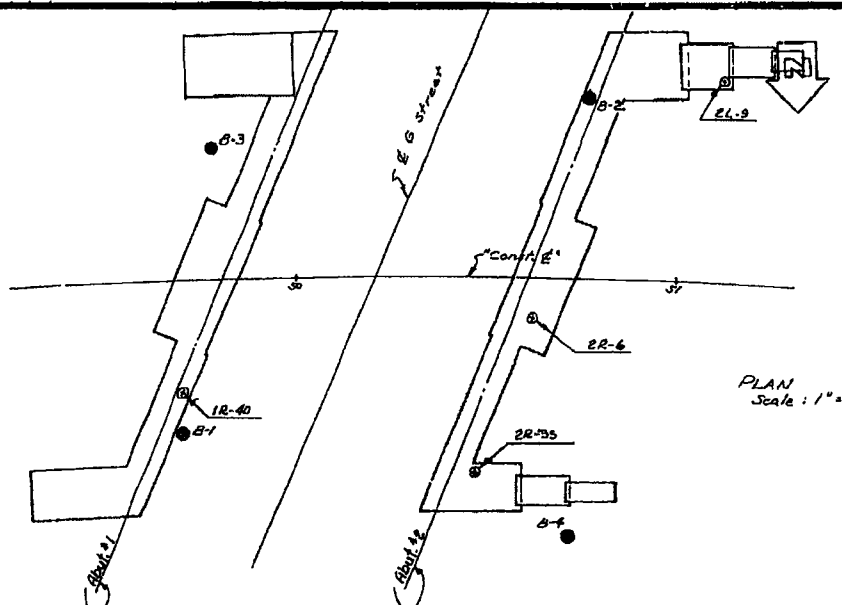


BM - Mgn. #20 - at G intersection  
13th Street & G Street in Merced.  
Elev. 166.91


**Abut. No. 1**  
Design Pile Loading: 45 T  
Type Pile: Cast-in-drilled-holes  
Diameter: 16"  
Total number of Piles: 126 "C.C.O." 13"  
Linear ft. Piles "As Built" C.C.O. 13: 2148  
Linear ft. Piles on Plans: C.C.O. 13  
Remarks: Driven and furnished piles were eliminated and cast-in-drilled-hole piles were constructed under C.C.O. 13 force account; because of 12 KV, P.E. & E, overhead wires.  
Drilled to specified Tip Elev. 145'

**Abut. No. 2**  
Design Pile Loading: 45 T  
Type Pile: Raymond step-taper  
Diameter: Tip 10" Built 15"  
Total Number Piles: 122  
Linear ft. Piles "As Built": 3290  
Linear ft. Piles called for on Plans: 4885  
Hammer: Raymond Vulcan #1 (2500 lb. Ram)  
Remarks: Specified Tip Elev. 145'

PENETRATION		
	Rt. Br.	Lt. Br.
Max.	150%	131%
Ave.	137%	159%
Min.	144%	146%

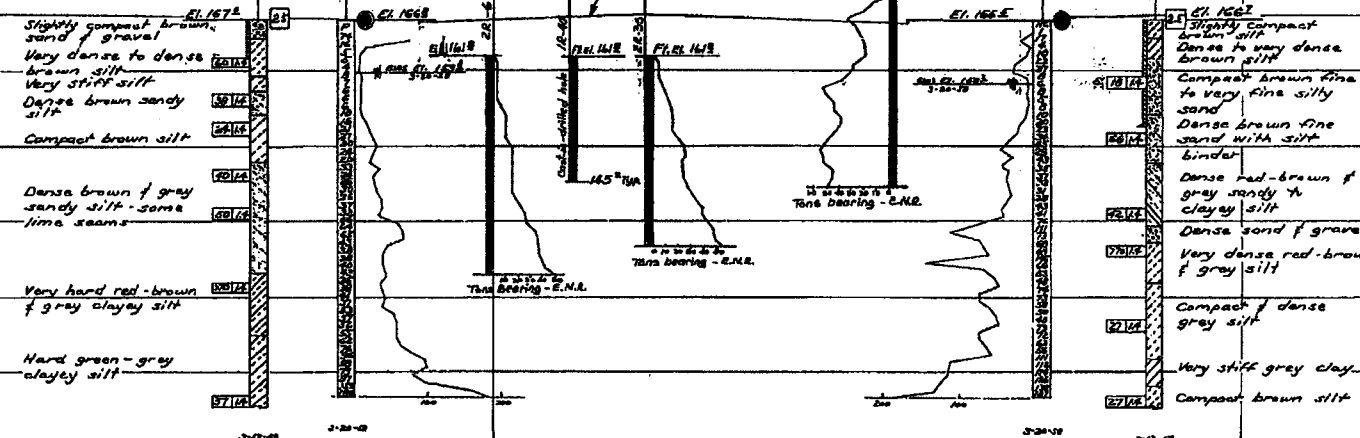


THIS SET OF PLANS HAS BEEN CORRECTED TO CORRESPOND TO THE "AS BUILT" PRINTS DATED 6/2/62, AS SUBMITTED BY ASSISTANT ENGINEER J. L. HANNAH, D.R.E.  
REVISIONS CORRECTED BY [Signature] DATE: 5/29/62

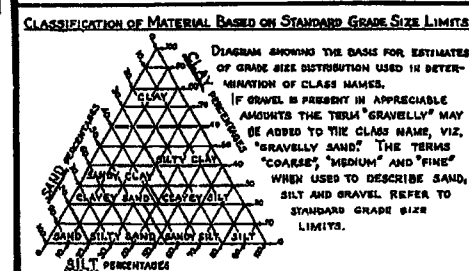

**LEGEND OF EARTH MATERIALS**

GRAVEL	SILTY CLAY OR CLAYEY SILT
SAND	PEAT AND/OR ORGANIC MATTER
SILT	FILL MATERIAL
CLAY	IGNEOUS ROCK
SANDY CLAY OR CLAYEY SAND	SEDIMENTARY ROCK
SANDY SILT OR SILTY SAND	METAMORPHIC ROCK

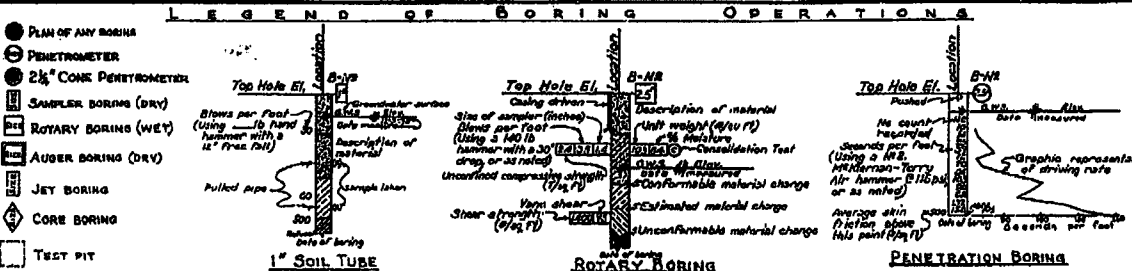

**NOTES**


Classification of earth materials as shown on this sheet is based upon field inspection and is not to be construed to imply mechanical analysis.

STATE OF CALIFORNIA  
DEPARTMENT OF PUBLIC WORKS  
DIVISION OF HIGHWAYS

**"G" STREET UNDERCROSSING**  
**LOG OF TEST BORINGS**


SCALE As Noted BRIDGE 35-142 1/2 P.L. DRAWING C-6009-12  
PR-6009-2

I HEREBY CERTIFY THAT THIS IS A TRUE AND ACCURATE COPY OF THE ABOVE DOCUMENT TAKEN UNDER MY DIRECTION AND CONTROL ON THIS DATE IN SACRAMENTO, CALIFORNIA PURSUANT TO AUTHORIZATION BY THE DIRECTOR OF PUBLIC WORKS.  
DATE 1/1/77 SIGNATURE [Signature] TITLE [Signature]

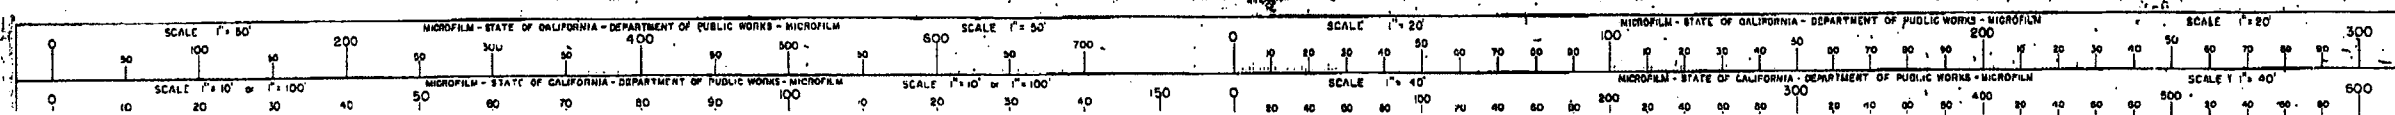


BRIDGE DEPARTMENT

AS BUILT PLANS  
Contract No. 61-1071369  
Date Completed  
Document No. 00001124

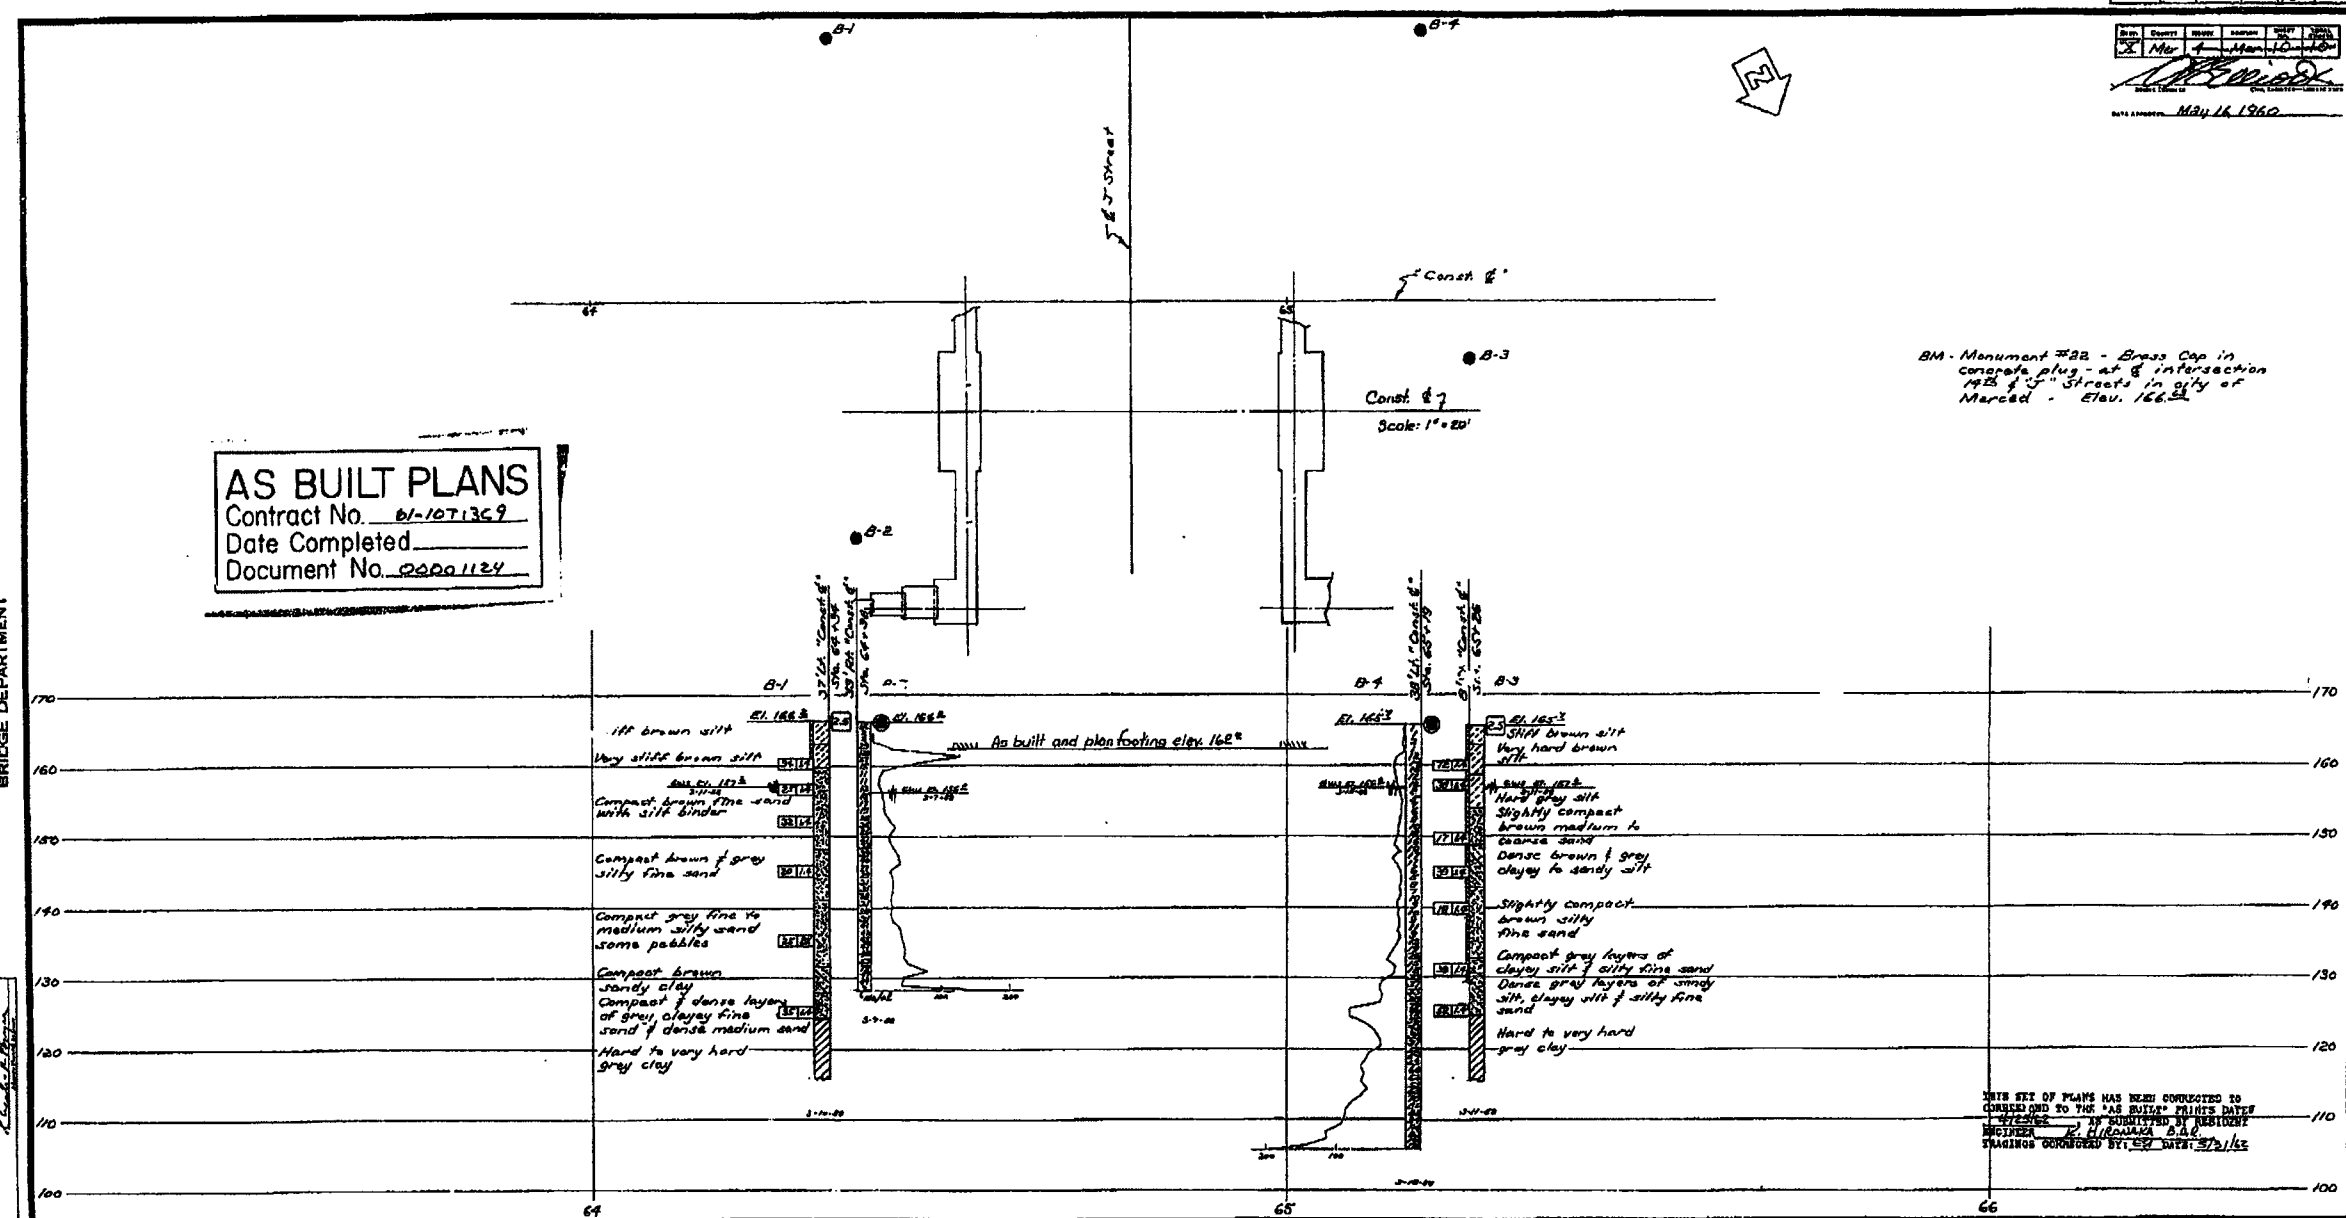


THIS SET OF PLANS HAS BEEN CONDUCTED TO CORRECT AND TO THE "AS BUILT" PRINTS DATE 1/25/60. IT IS SUBMITTED BY RESIDENT ENGINEER K. H. KANAKA, S.E.C. STAINING CONDUCTED BY [Signature] 5/25/60

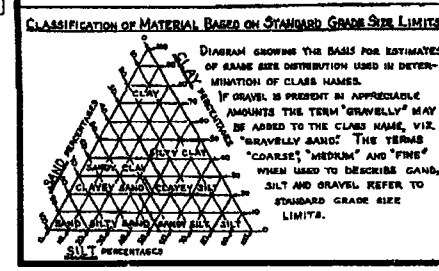

LEGEND OF EARTH MATERIALS

GRAVEL	SILTY CLAY OR CLAYEY SILT
SAND	PEAT OR/OR ORGANIC MATTER
SILT	FILL MATERIAL
CLAY	IGNEOUS ROCK
SANDY CLAY OR CLAYEY SAND	SEDIMENTARY ROCK
SANDY SILT OR SILTY SAND	METAMORPHIC ROCK

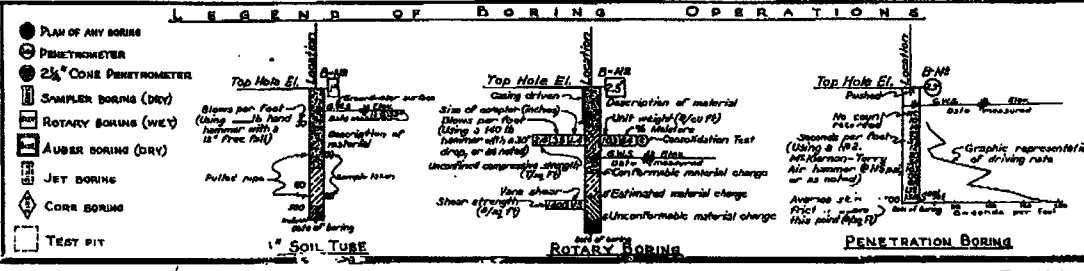

NOTES

Check of cone penetrometer on this sheet is based upon field inspection and it is not to be construed to imply mechanical analysis.

STATE OF CALIFORNIA  
DEPARTMENT OF PUBLIC WORKS  
DIVISION OF HIGHWAYS

ROUTE 4/123 SEPARATION

LOG OF TEST BORINGS

SCALE 1" = 10' BORING 38-136 1/2 FILE DRAWING C-5963-10


I HEREBY CERTIFY THAT THIS IS A TRUE AND ACCURATE COPY OF THE ABOVE DOCUMENT TAKEN UNDER MY DIRECTION AND CONTROL ON FIELD DATA IN SACRAMENTO, CALIFORNIA PURSUANT TO AUTHORIZATION BY THE DIRECTOR OF PUBLIC WORKS.  
DATE 12/2/60 SIGNATURE [Signature] TITLE [Signature]




FOR YEAR	STATE	PROJECT NO.	SECTION	DATE	BY
7	CAL.			174	262

DATE	BY	REVISION	DATE	BY
May 16, 1960				

**AS BUILT PLANS**  
 Contract No. 61-10T1369  
 Date Completed  
 Document No. 20001124

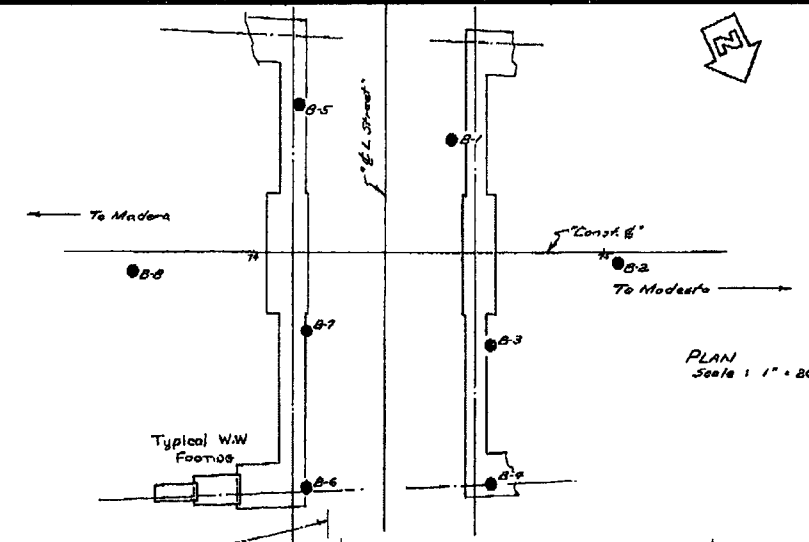


BM "B" R.R. Spike in power pole  
 111' RA Sta. 7+13 "Const. E"  
 Elev. 166.15

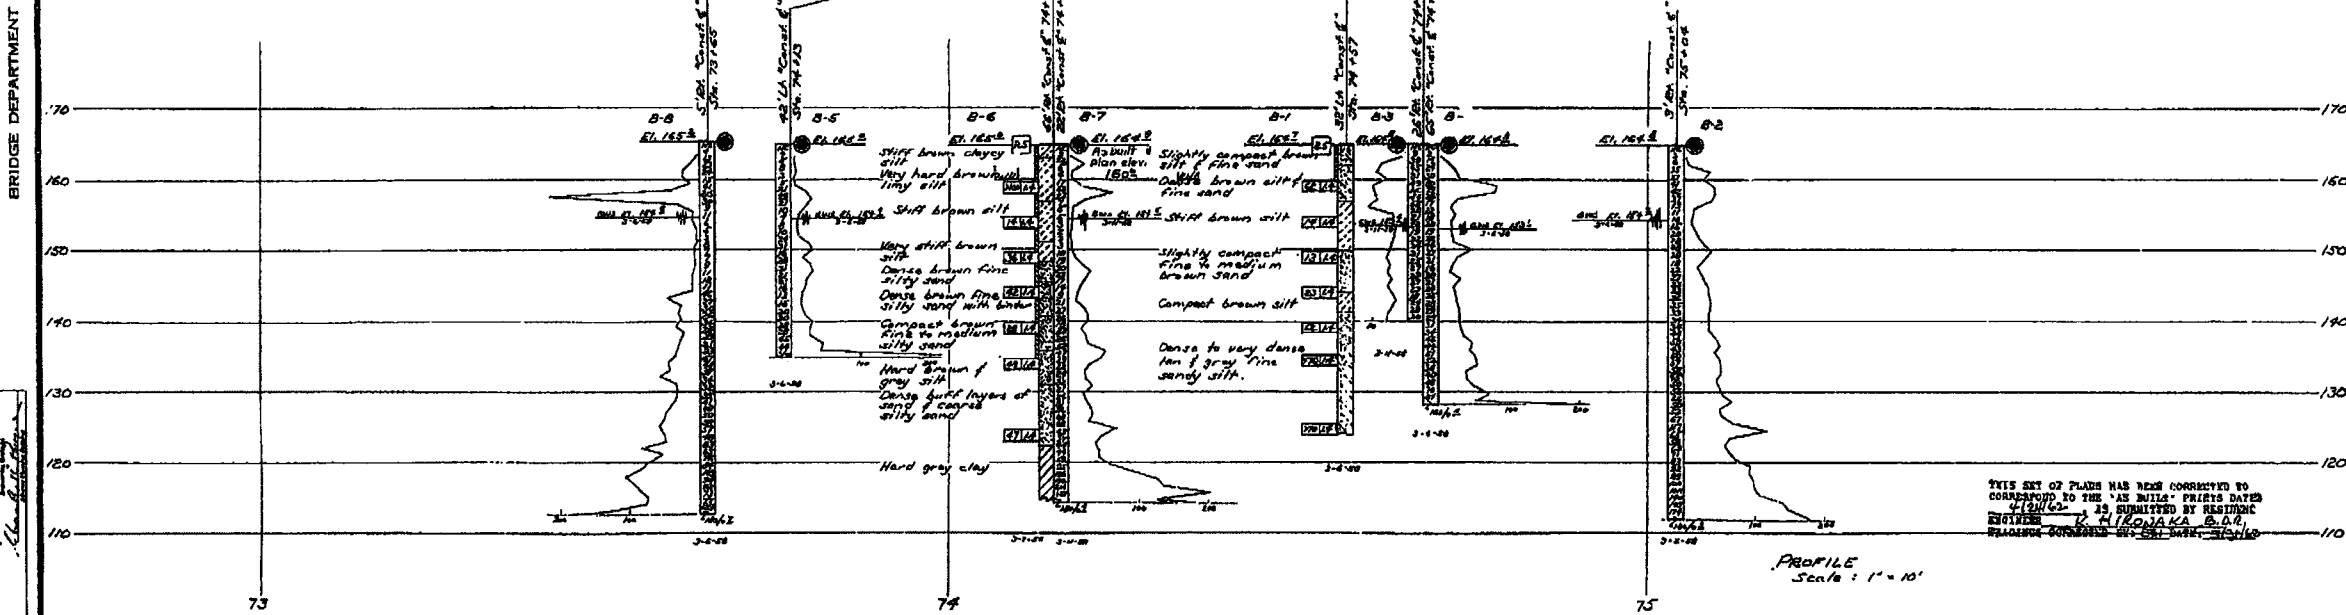

THIS SET OF PLANS HAS BEEN COMMITTED TO CORRESPOND TO THE "AS BUILT" PRIORS DATED 4/13/62. IS SUBMITTED BY RESIDENT ENGINEER R. H. KONAKA, S.D.E., RELIANCE CONSULTING - SAN JOSE, CALIF.


**CLASSIFICATION OF MATERIAL BASED ON STANDARD GRADE SIZE LIMITS**

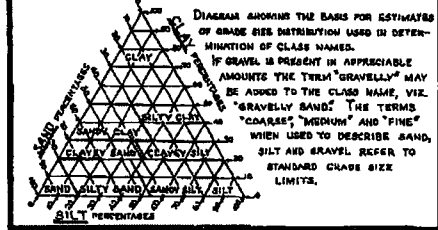

**LEGEND OF EARTH MATERIALS**

GRAVEL	SILT CLAY OR CLAYEY SILT
SAND	PEAT AND/OR ORGANIC MATTER
SILT	FILL MATERIAL
CLAY	IGNEOUS ROCK
SANDY CLAY OR CLAYEY SAND	SEDIMENTARY ROCK
SANDY SILT OR SILTY SAND	METAMORPHIC ROCK

**LEGEND OF BORING OPERATIONS**

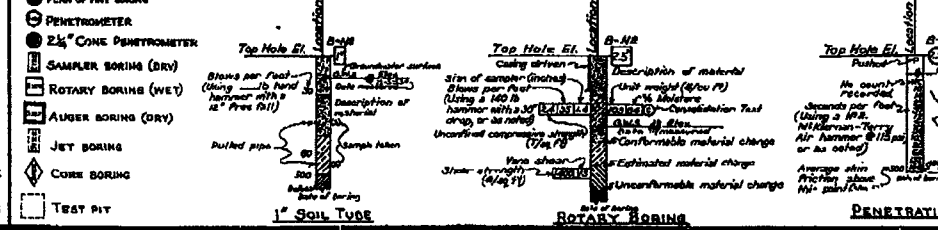

**NOTES**

Classification of earth material as shown on this sheet is based upon field inspection and is not to be construed to imply mechanical analysis.

STATE OF CALIFORNIA  
 DEPARTMENT OF PUBLIC WORKS  
 DIVISION OF HIGHWAYS

**"L" STREET UNDERCROSSING**

**LOG OF TEST BORINGS**

SCALE: As Shown BRIDGE 39-733 DRAWING C-5957-11

I HEREBY CERTIFY THAT THIS IS A TRUE AND ACCURATE COPY OF THE ABOVE DOCUMENT TAKEN UNDER MY DIRECTION AND CONTROL ON THIS DATE IN SACRAMENTO, CALIFORNIA PURSUANT TO AUTHORIZATION BY THE DIRECTOR OF PUBLIC WORKS.


DATE \_\_\_\_\_ SIGNATURE \_\_\_\_\_ TITLE \_\_\_\_\_

PROJECT NO.	STATE	FED. AID DIST. NO.	CONTRACT NO.	DATE
7	CAL.		184	242

DATE	BY	CHECKED	DATE
May 16, 1960			

BRIDGE DEPARTMENT

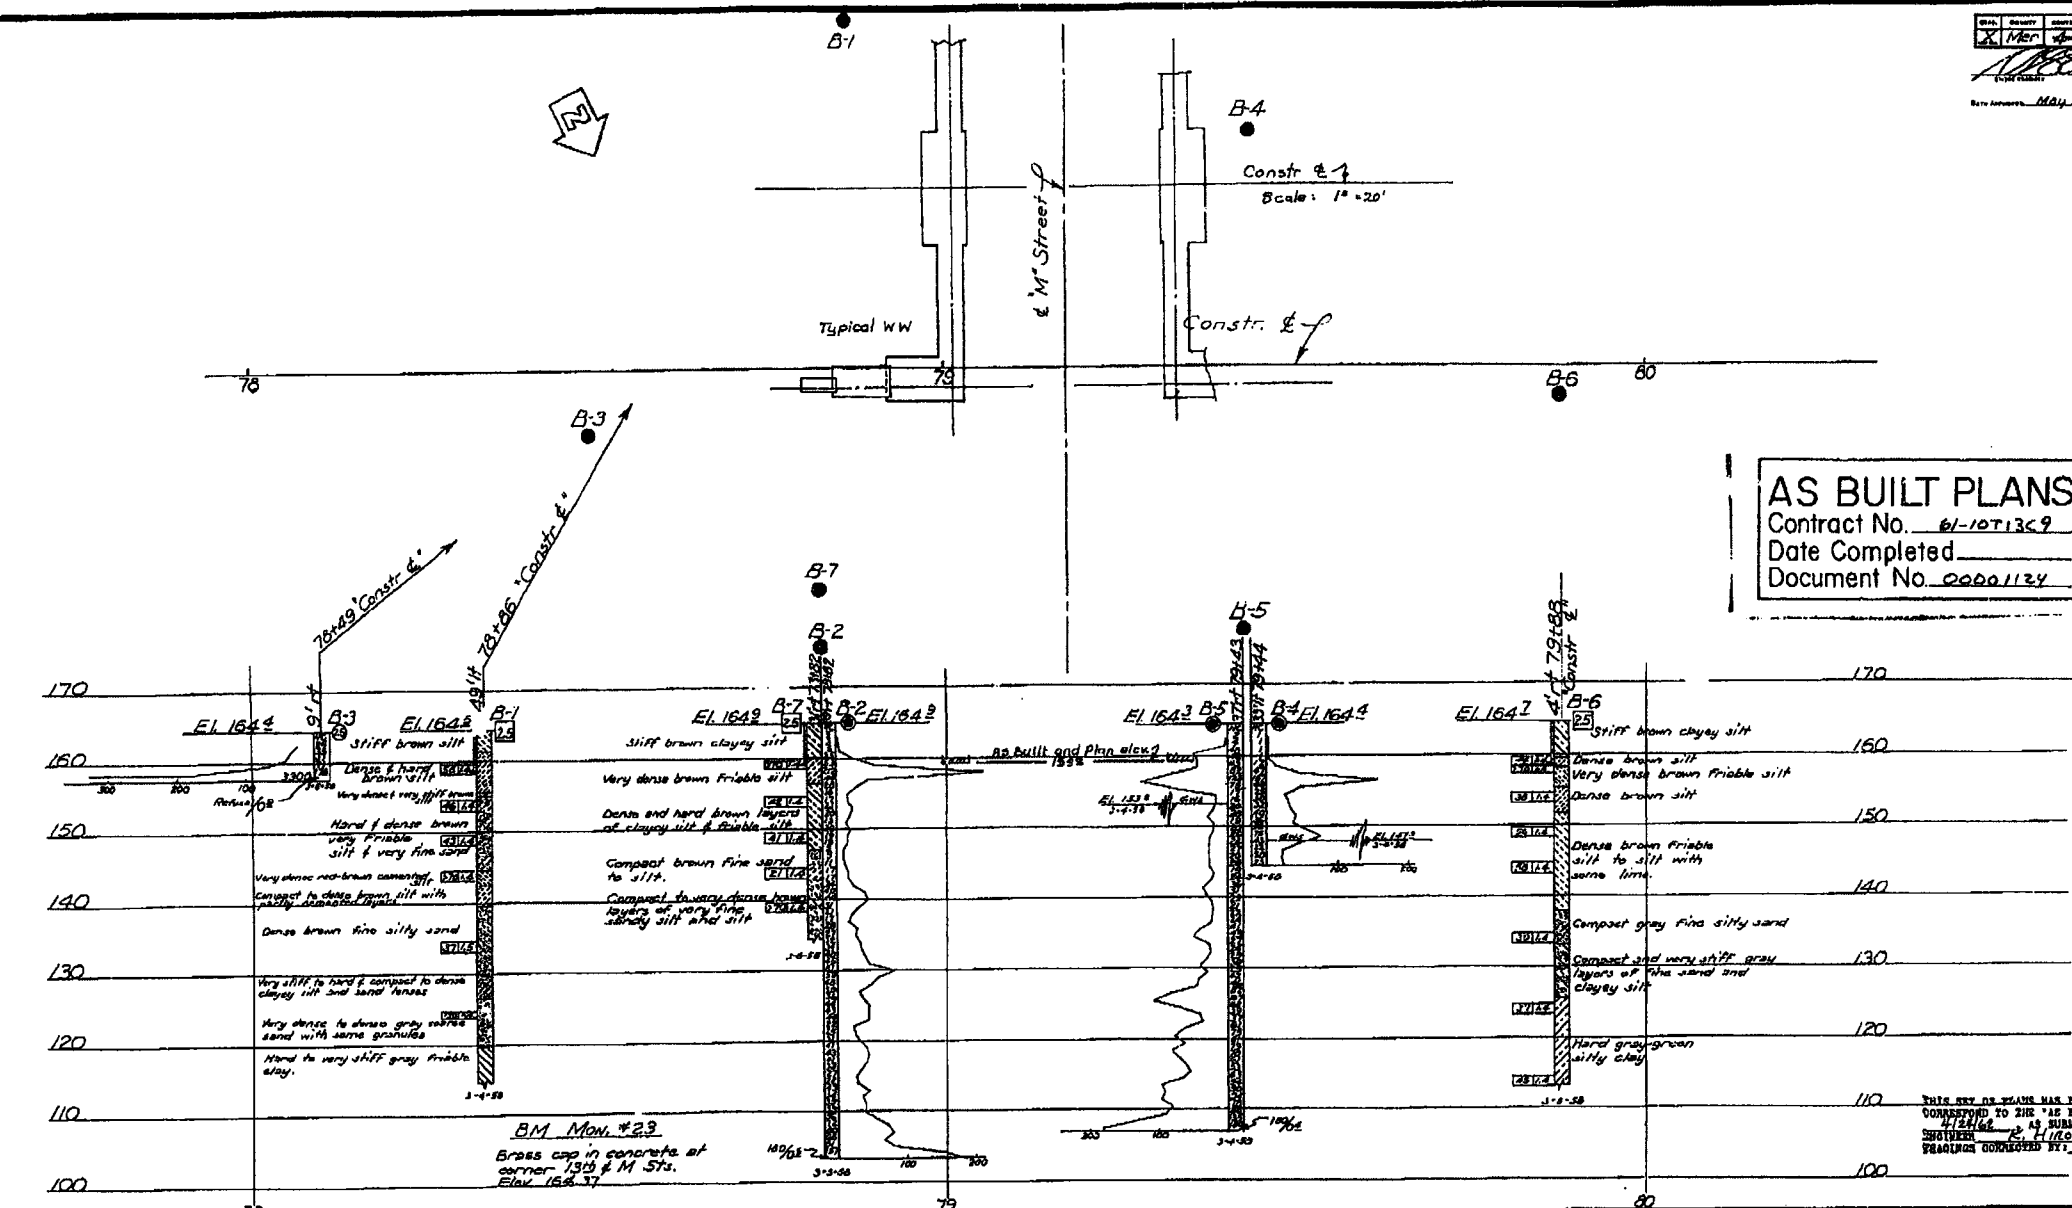

FIELD ENGINEER	DATE
DESIGNED	3-2-59
CHECKED	3-2-59
APPROVED	3-2-59

**CLASSIFICATION OF MATERIAL BASED ON STANDARD GRADE SIZE LIMITS**

DIAGRAM SHOWING THE BASIS FOR ESTIMATES OF GRADE SIZE DISTRIBUTION USED IN DETERMINATION OF CLASS NAMES. IF GRAVEL IS PRESENT IN APPRECIABLE AMOUNTS THE TERM "GRAVELLY" MAY BE ADDED TO THE CLASS NAME, VIZ. "GRAVELLY SAND". THE TERMS "COARSE", "MEDIUM" AND "FINE" WHEN USED TO DESCRIBE SAND, SILT AND GRAVEL REFER TO STANDARD GRADE SIZE LIMITS.

**LEGEND OF EARTH MATERIALS**

GRAVEL	SILTY CLAY OR CLAYEY SILT
SAND	PEAT AND/OR ORGANIC MATTER
SILT	FILL MATERIAL
CLAY	IGNEOUS ROCK
SANDY CLAY OR CLAYEY SAND	SEDIMENTARY ROCK
SANDY SILT OR SILTY SAND	METAMORPHIC ROCK

**LEGEND OF BORING OPERATIONS**

- PLAN OF ANY BORING
- PEIROMETER
- 2 1/2" CONE PEIROMETER
- SAMPLER BORING (DRY)
- ROTARY BORING (WET)
- AUGER BORING (DRY)
- JET BORING
- CORE BORING
- TEST PIT

**1" SOIL TUBE**

**ROTARY BORING**

**PENETRATION BORING**

**NOTES**

Classification of earth materials as shown on this sheet is based upon field inspection and is not to be construed to imply mechanical analysis.

STATE OF CALIFORNIA  
 DEPARTMENT OF PUBLIC WORKS  
 DIVISION OF HIGHWAYS

**M STREET UNDERCROSSING**

**LOG OF TEST BORINGS**

SCALE 1" = 10'    BRIDGE 39-134 1/2    DRAWING C-5958-10

FILE DRAWING NO. P-5958-3


I HEREBY CERTIFY THAT THIS IS A TRUE AND ACCURATE COPY OF THE ABOVE DOCUMENT TAKEN UNDER MY DIRECTION AND CONTROL ON THIS DATE IN SACRAMENTO, CALIFORNIA PURSUANT TO AUTHORIZATION BY THE DIRECTOR OF PUBLIC WORKS.

DATE \_\_\_\_\_ SIGNATURE \_\_\_\_\_

DATE APPROVED: May 16, 1960

BY: [Signature]

**AS BUILT PLANS**  
 Contract No. 61-107.13C9  
 Date Completed  
 Document No. 00001124

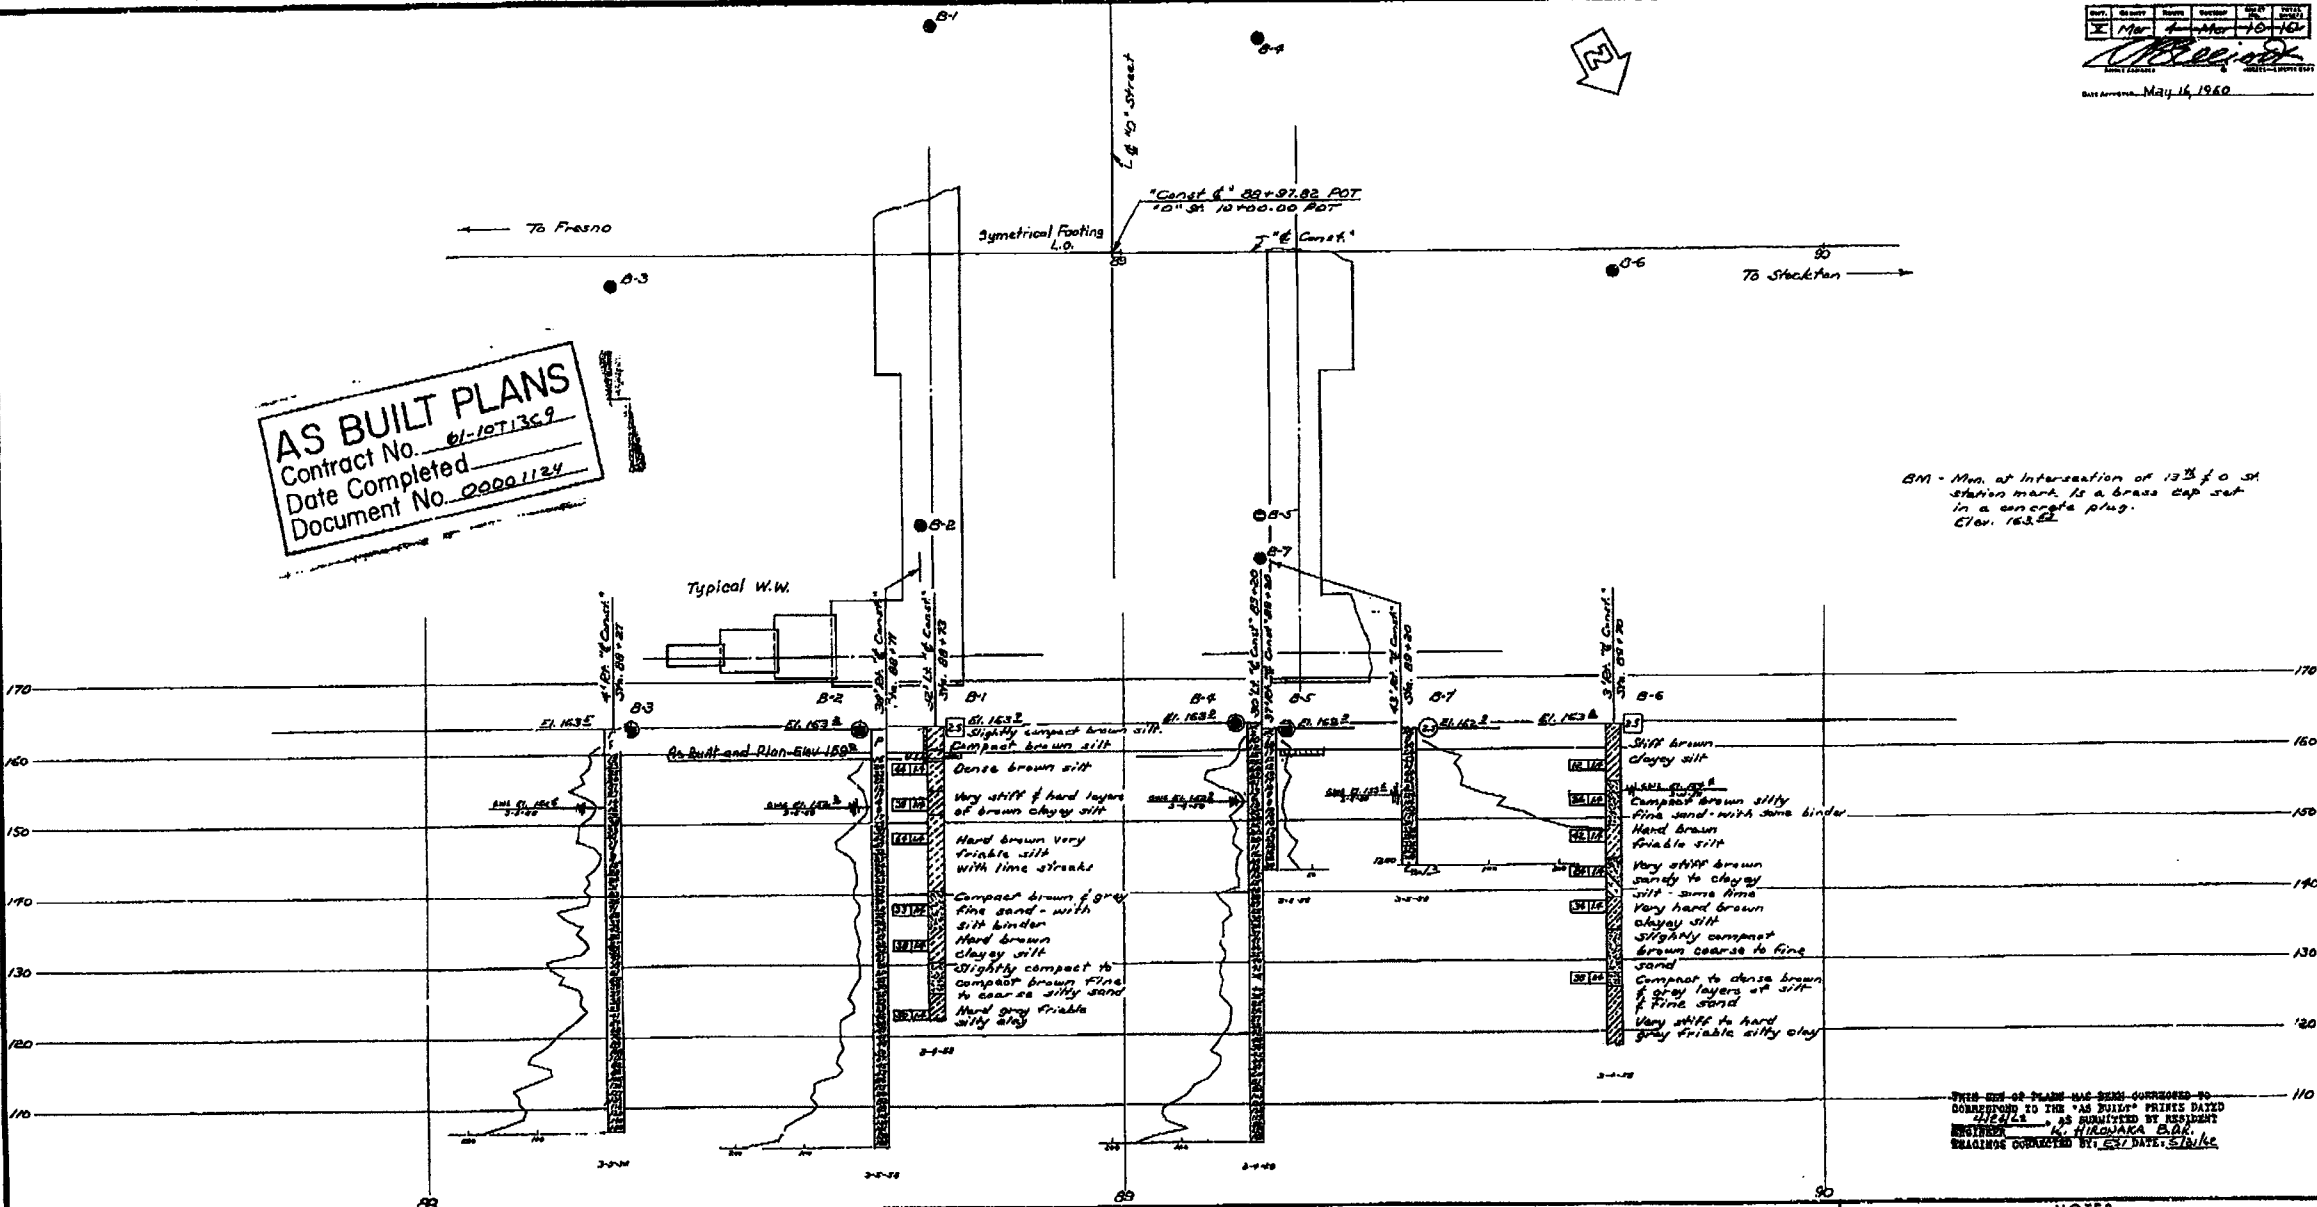

BM - Mm. at Intersection of 13th & O St.  
 station mark is a brass cap set  
 in a concrete plug.  
 Elev. 163.52

THIS SET OF PLANS HAS BEEN CORRECTED TO  
 CORRESPOND TO THE "AS BUILT" PRICES DATED  
 11/1/61 AS SUBMITTED BY RESIDENT  
 ENGINEER K. HIGASHI, E.B.C.  
 REVISIONS CORRECTED BY: GAT DATE: 5/1/62

**CLASSIFICATION OF MATERIAL BASED ON STANDARD GRADE SIZE LIMITS**

**LEGEND OF EARTH MATERIALS**

GRAVEL	SILTY CLAY OR CLAYEY SILT
SAND	PEAT AND/OR ORGANIC MATTER
SILT	FILL MATERIAL
CLAY	IGNEOUS ROCK
SANDY CLAY OR CLAYEY SAND	SEDIMENTARY ROCK
SANDY SILT OR SILTY SAND	METAMORPHIC ROCK

**LEGEND OF BORING OPERATIONS**

**NOTES**

Qualification of earth material as shown on this sheet is based upon field inspection and is not to be construed to imply mechanical analysis.

STATE OF CALIFORNIA  
 DEPARTMENT OF PUBLIC WORKS  
 DIVISION OF HIGHWAYS

**"O" STREET UNDERCROSSING**



**LOG OF TEST BORINGS**

SCALE 1" = 10' BRIDGE 39-135 FILE DRAWING C-5955-10 PR-5955-3

I HEREBY CERTIFY THAT THIS IS A TRUE AND ACCURATE COPY OF THE ABOVE DOCUMENT TAKEN UNDER MY DIRECTION AND CONTROL ON THIS DATE IN SACRAMENTO, CALIFORNIA PURSUANT TO AUTHORIZATION BY THE DIRECTOR OF PUBLIC WORKS.


DATE 11/1/61 SIGNATURE [Signature] TITLE [Title]



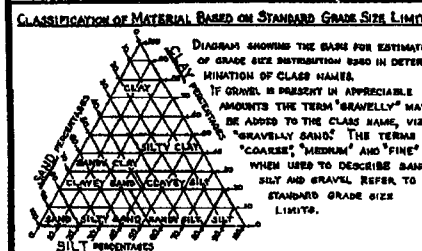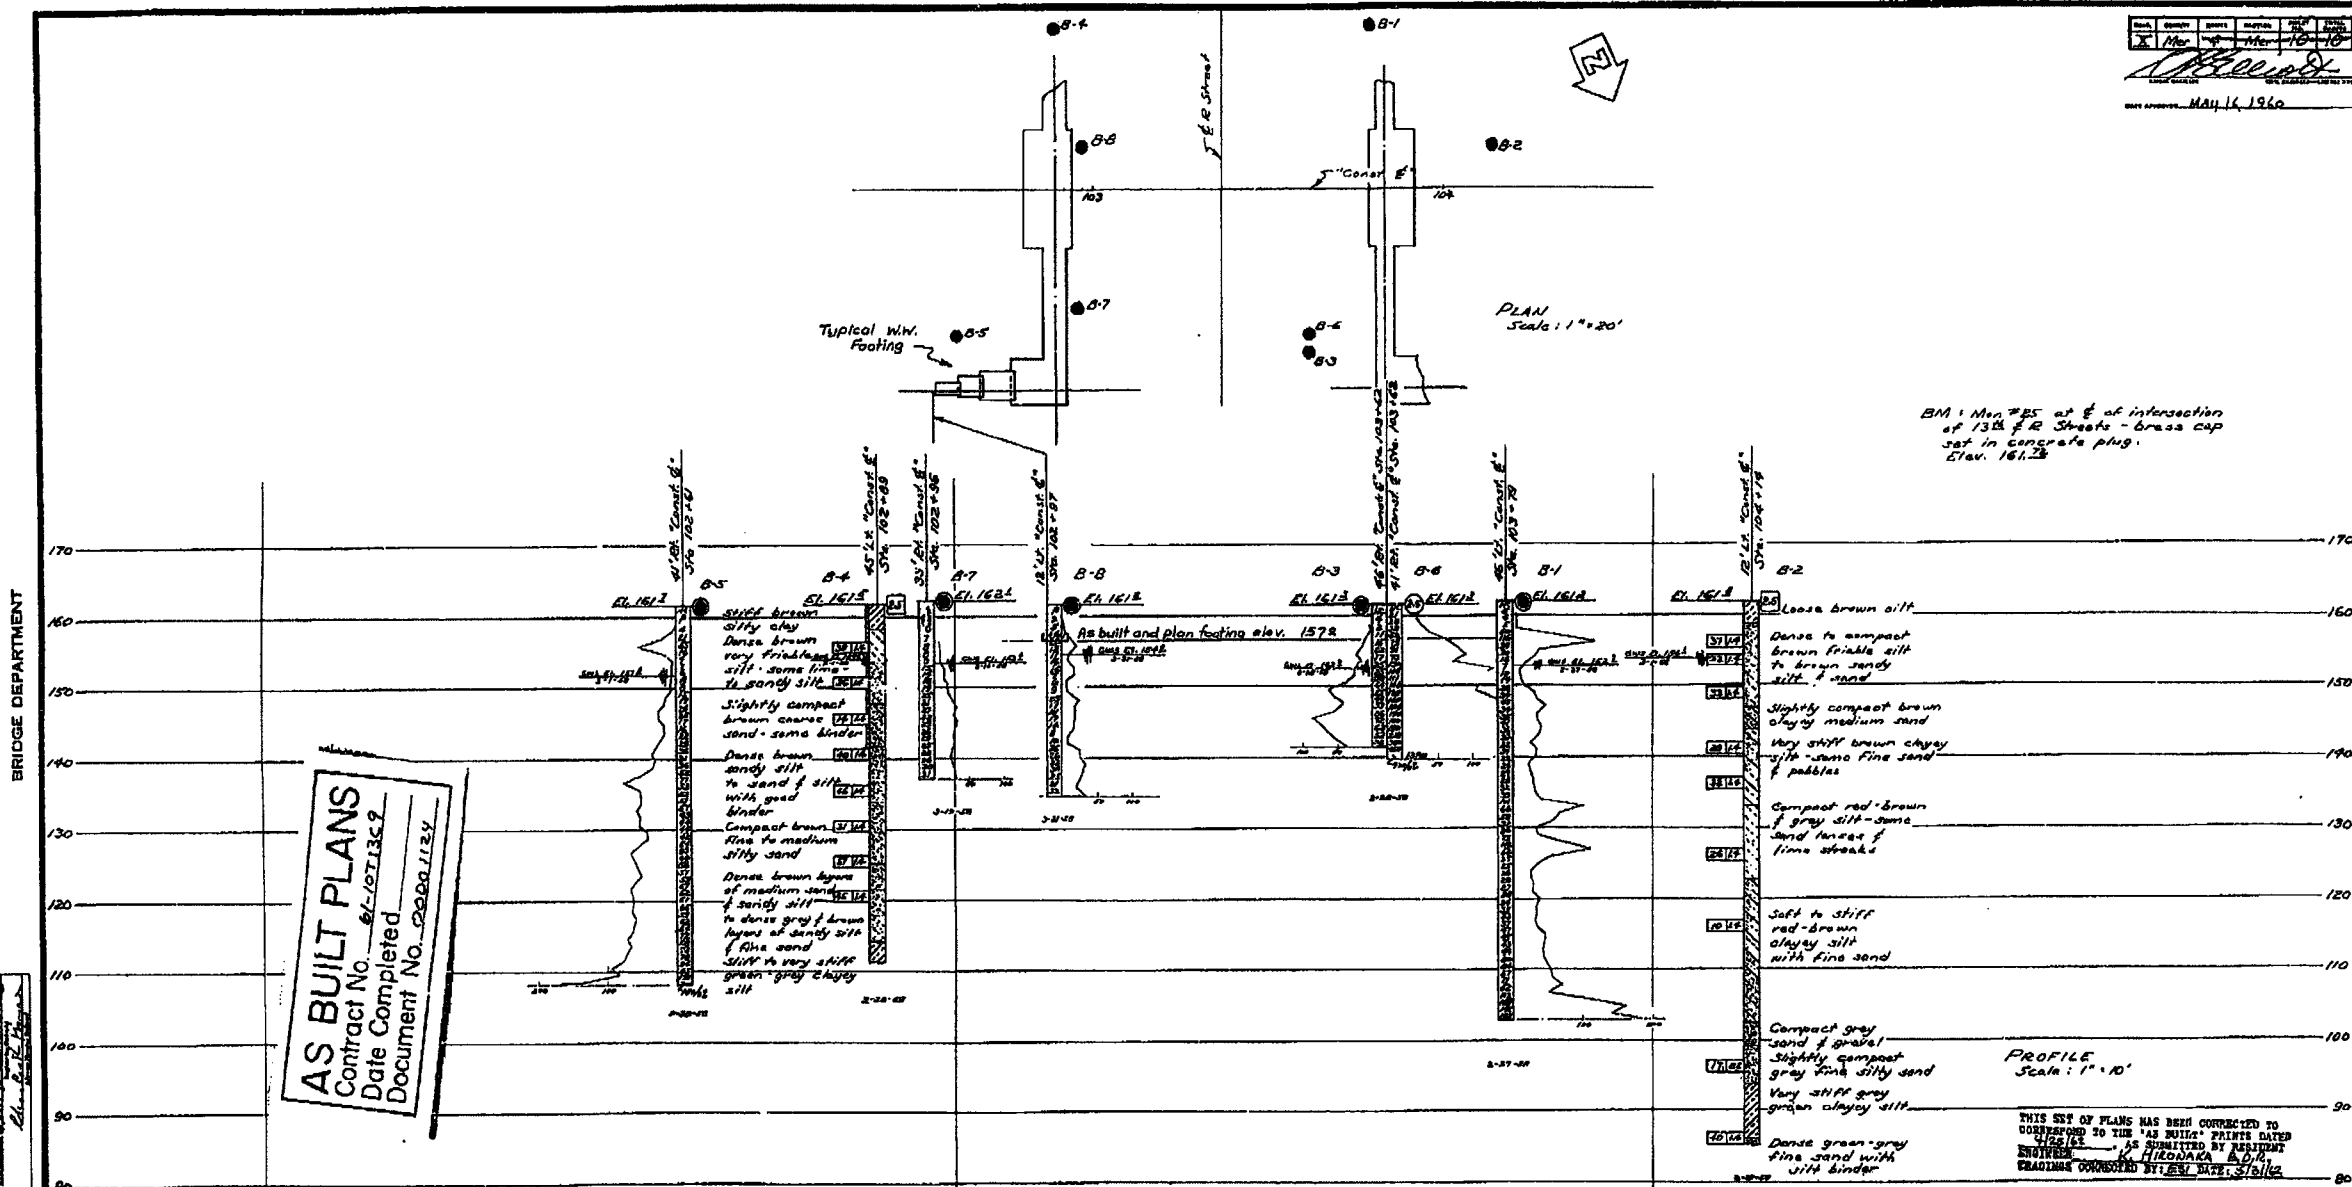

LEGEND OF EARTH MATERIALS

GRAVEL	SILTY CLAY OR CLAYEY SILT
SAND	PEAT AND/OR ORGANIC MATTER
SILT	FILL MATERIAL
CLAY	IGNEOUS ROCK
SANDY CLAY OR CLAYEY SAND	SEDIMENTARY ROCK
SANDY SILT OR SILTY SAND	METAMORPHIC ROCK

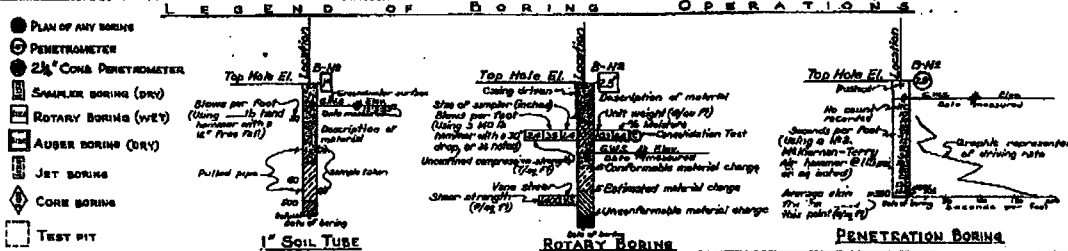

NOTES

THIS SET OF PLANS HAS BEEN CORRECTED TO CORRESPOND TO THE 'AS BUILT' PRINTS DATED 11/25/61. AS SUBMITTED BY RESIDENT ENGINEER K. HIRONAKA, A.D.C. CHAIRMAN CORRECTED BY: [Signature]



"R" STREET UNDERCROSSING

LOG OF TEST BORINGS



SCALE: As Noted BRIDGE 39-137 DRAWING 6-5974-10

I HEREBY CERTIFY THAT THIS IS A TRUE AND ACCURATE COPY OF THE ABOVE DOCUMENT TAKEN UNDER MY DIRECTION AND CONTROL ON THIS DATE IN SACRAMENTO, CALIFORNIA PURSUANT TO AUTHORIZATION BY THE DIRECTOR OF PUBLIC WORKS.

DATE: 12-11-61 SIGNATURE: [Signature] TITLE: [Title]

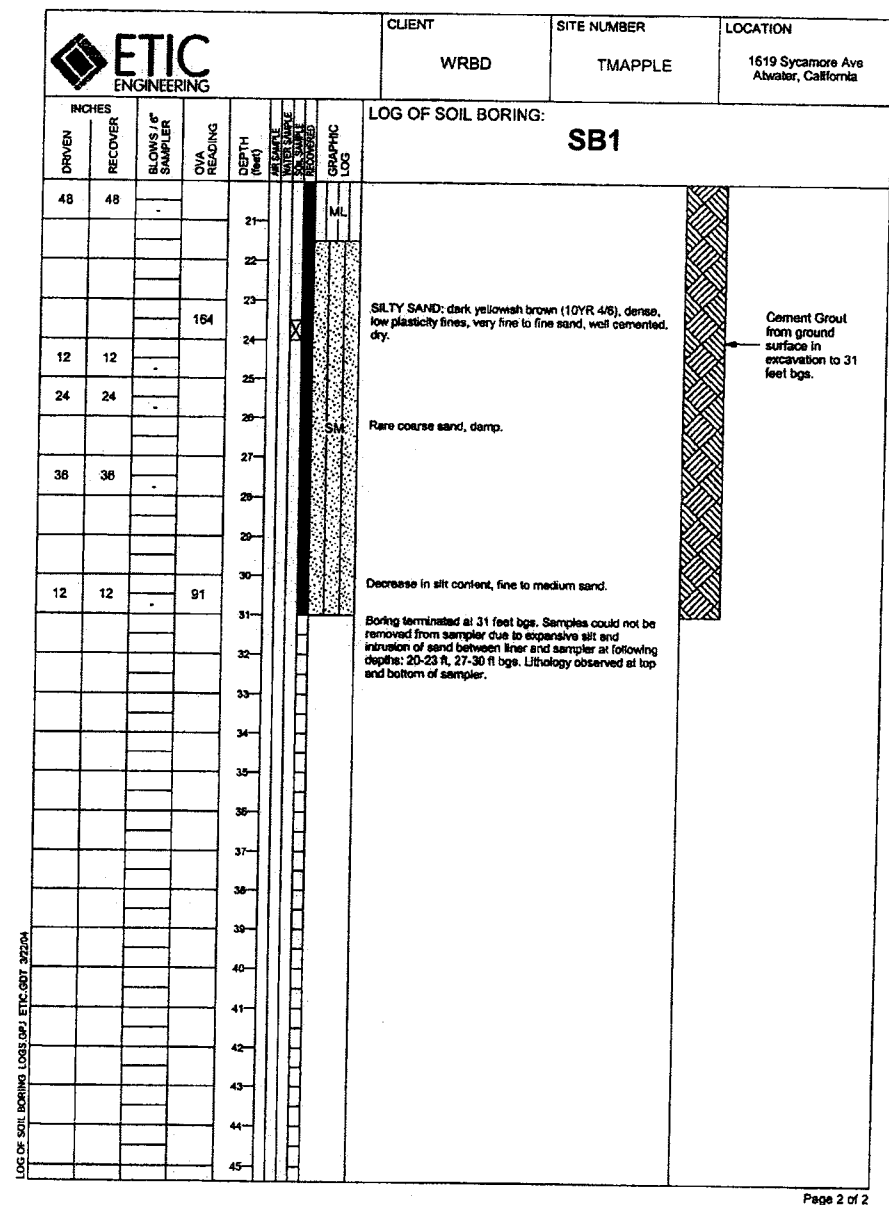
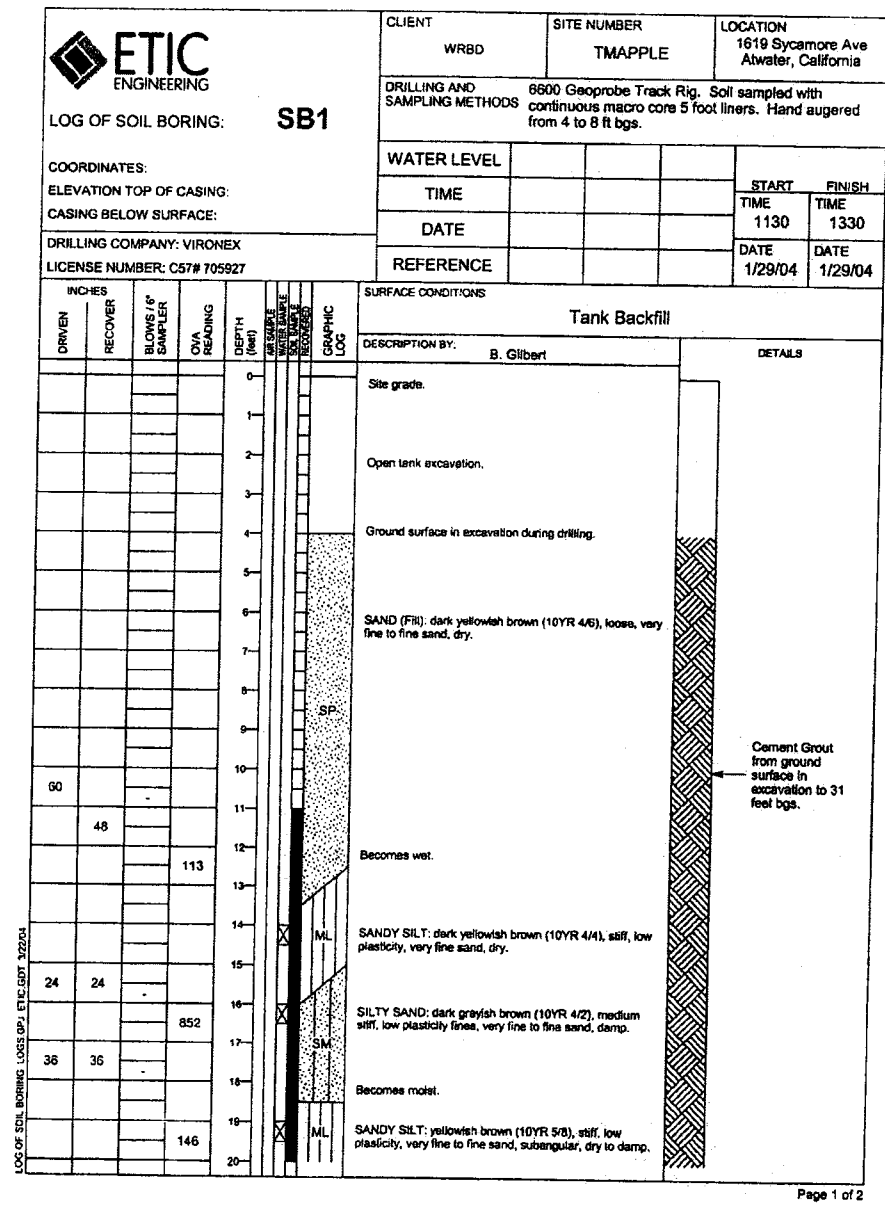


HWY 99/APPLEGATE INTERCHANGE  
P.M. 15.60

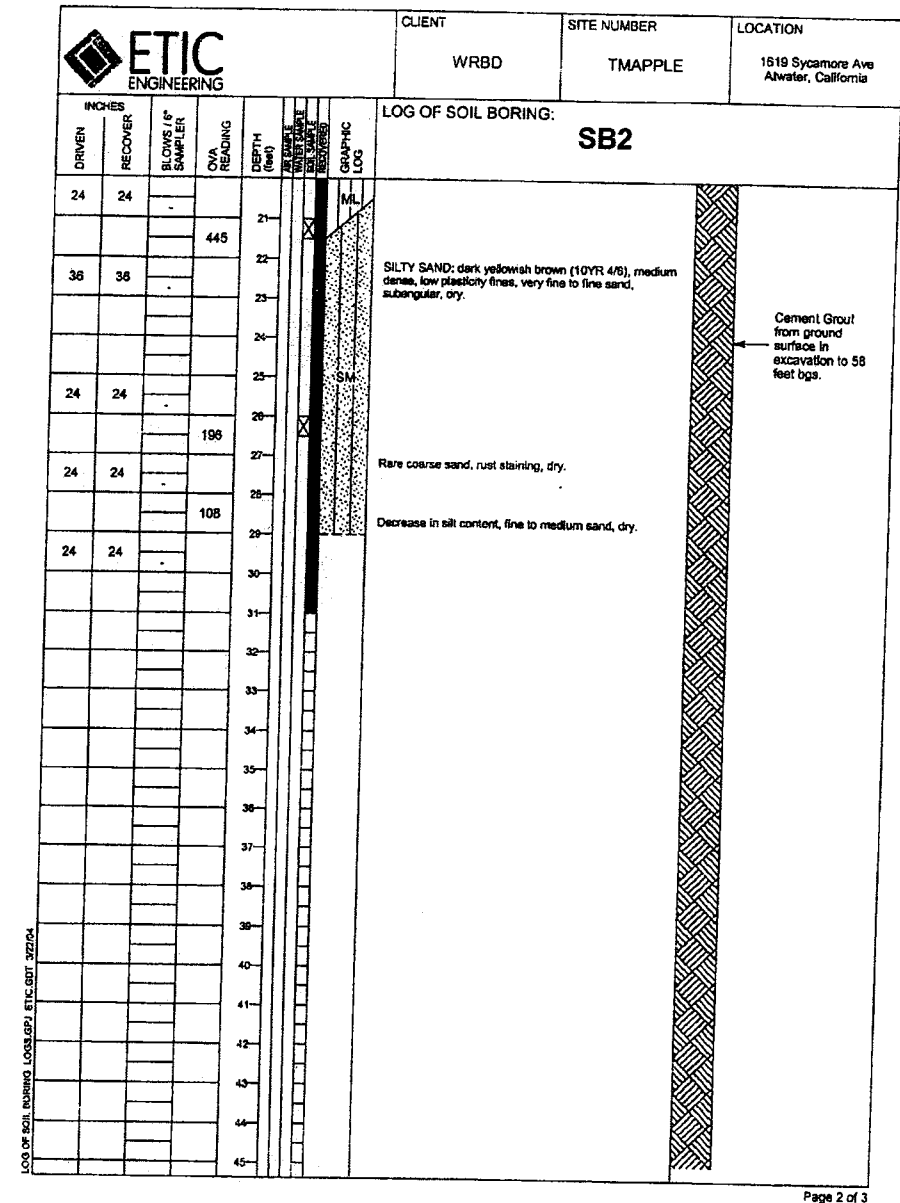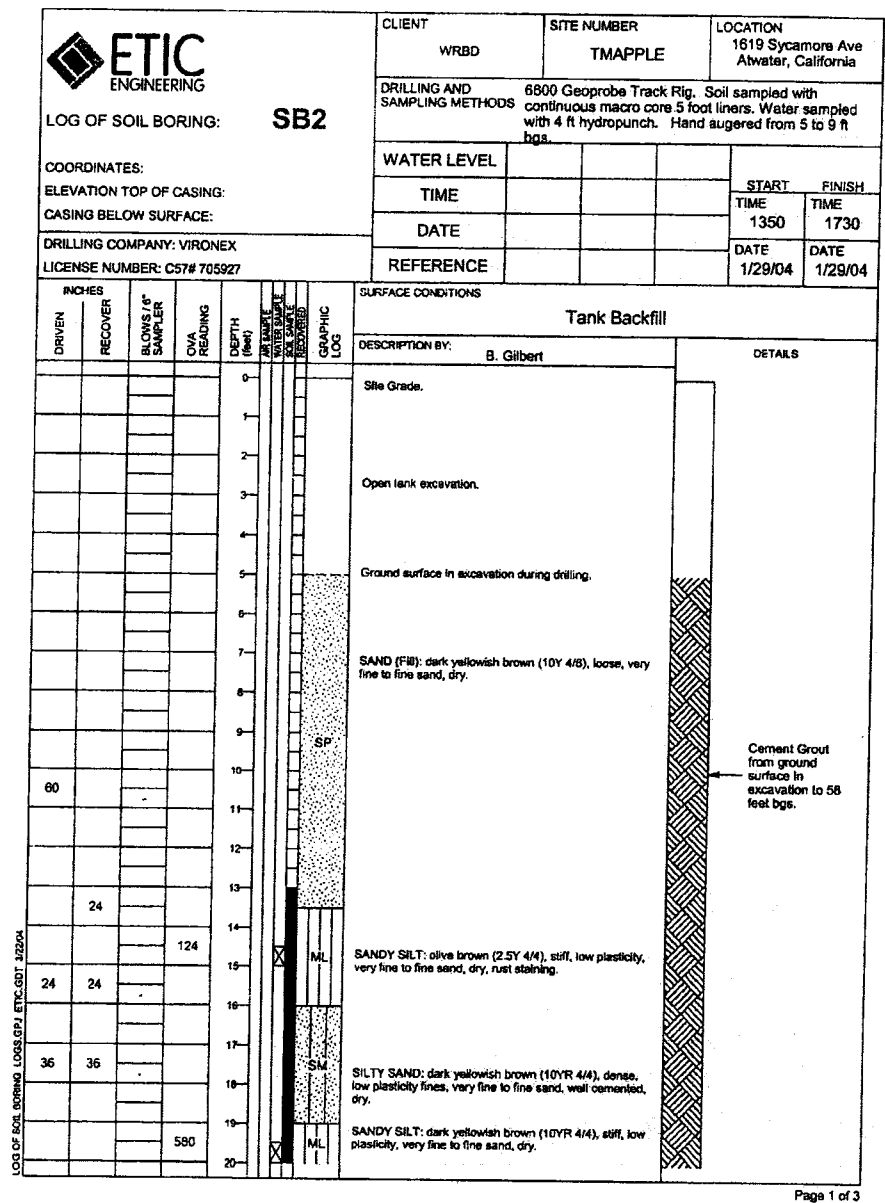


HWY 99/APPLEGATE INTERCHANGE  
P.M. 15.60




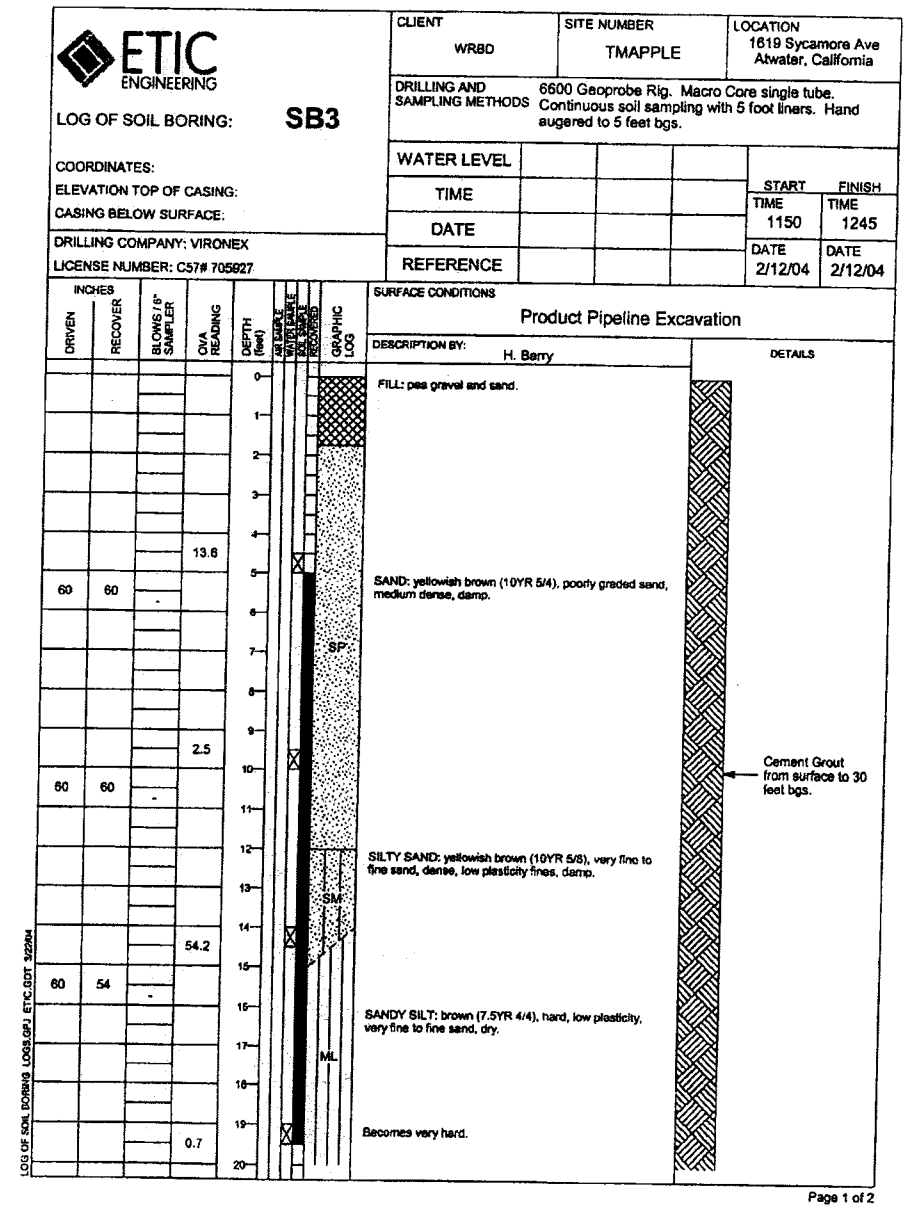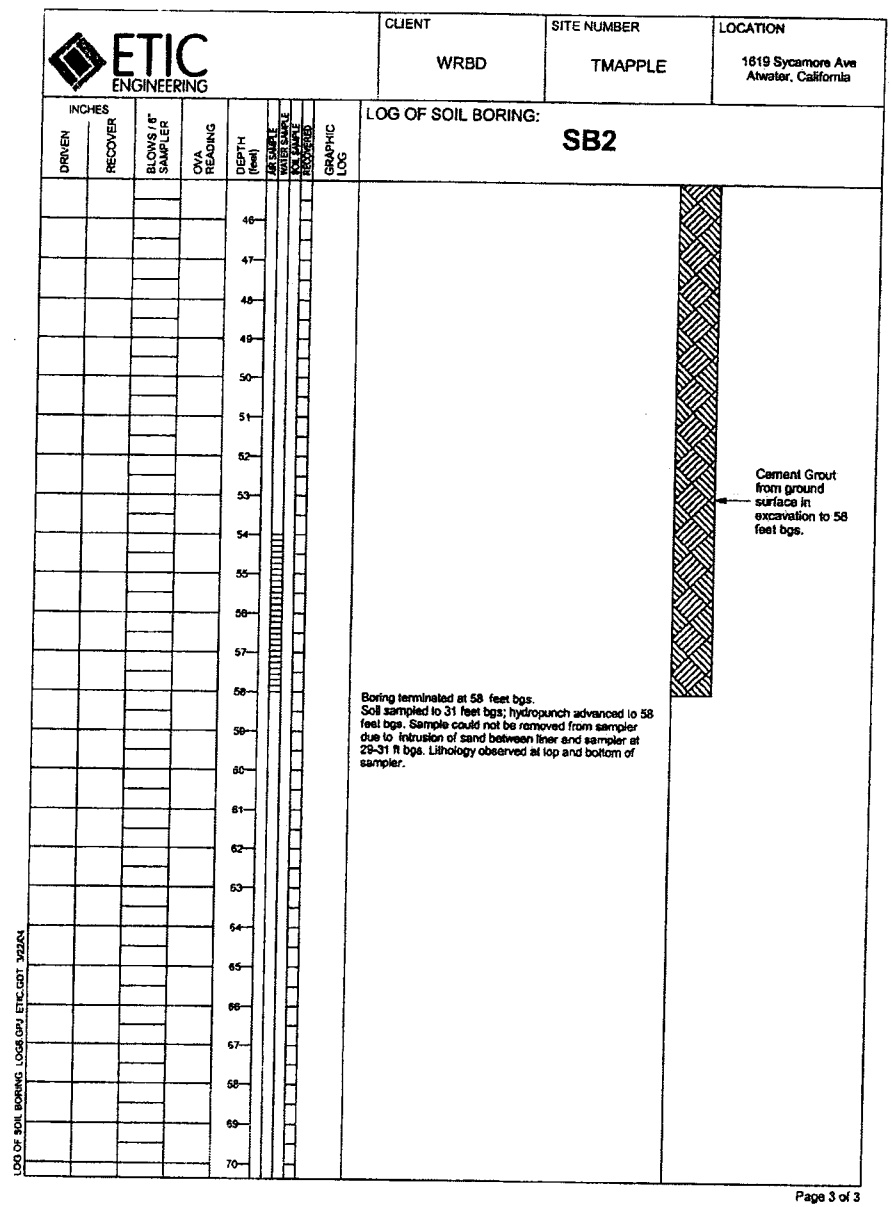

HWY 99/APPLEGATE INTERCHANGE  
P.M. 15.60

					CLIENT	SITE NUMBER	LOCATION
					WRBD	TMAPPLE	1619 Sycamore Ave Abwater, California
					LOG OF SOIL BORING: <b>SB3</b>		
					Sieve stuck in sampler (20-24.5 ft bgs).		
					SILTY SAND: reddish brown (5YR 5/3), fine to medium sand, dense, low plasticity fines, comp.		
					Boring terminated at 30 feet bgs. Sample could not be removed from sampler due to expansive silt at 20-24.5 ft bgs. Lithology observed at top and bottom of sampler.		
					Cement Grout from surface to 30 feet bgs.		

HWY 99/APPLEGATE INTERCHANGE  
P.M. 15.60

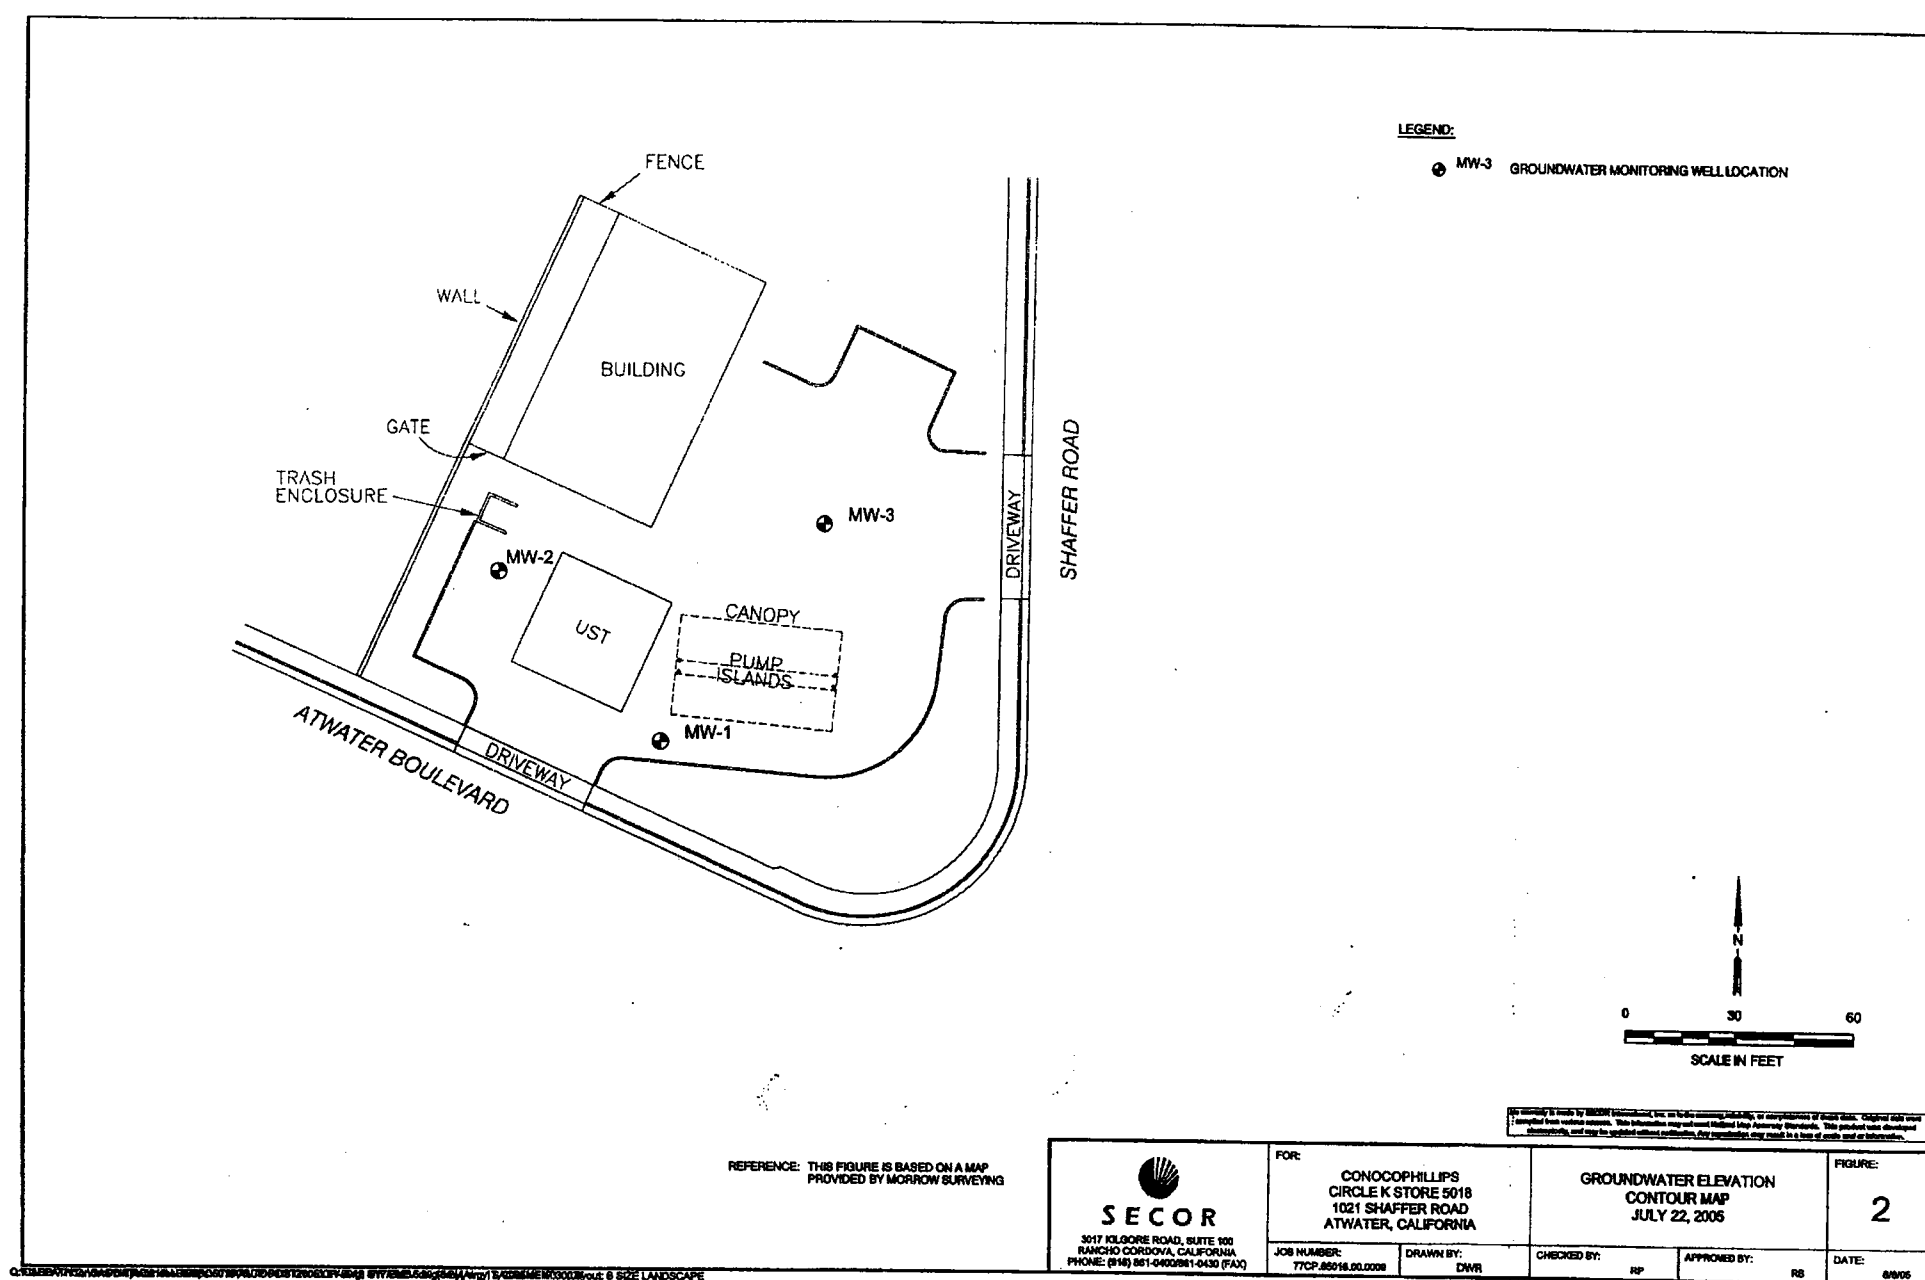

**HWY 99/APPLEGATE INTERCHANGE  
P.M. 15.60**





Logged By:	Date Drilled:	Drilling Contractor	Project Name:	Method/Equipment:	Well Number:	
RP	5/26/05	CASCADE	Circle K Store #05018 Atwater, California	HSA CA SPLIT SPOON	MW-1	
		Boring Diam.(in.): 8	Surface Elev.(ft.): 50.5 First Water 41.5 Static Water	Total Depth (ft.): 60.5	Drive wt.(lbs.): 140	Drop Dist.(in.): 30
Well Construction	Depth, (ft.)	Sample Recovery Blows/6"	Description	PID [PPM]	SAMPLE NAME	
8" Well Box Concrete			ASPHALT POORLY GRADED SAND (SP): Brown, fine-grained sand, loose, no hydrocarbon odor, (0,100,0).			
Neat Cement	5	10 10 12	Same as above, strongly cemented hardpan, (0,95,5).	0	MW-1 @5'	
	10	11 12 14	SILT WITH SAND (ML): Pale brown, fine-grained sand, dry, low plasticity, no hydrocarbon odor, (0,20,80).	0	MW-1 @10'	
2" SCH. 40 PVC Blank	15	9 12 12	POORLY GRADED SAND (SP): Pale brown, fine-grained sand, dry, no hydrocarbon odor, (0,100,0).	0	MW-1 @15'	
	20	10 14 15	Same as above, light gray, loose. SILTY SAND (SM): Reddish brown, fine-grained sand, dry, strongly cemented, no hydrocarbon odor, (0,75,25).	0 0	MW-1 @19' MW-1 @20'	
	25	13 15 16	Same as above, medium to fine-grained sand, moist.	0	MW-1 @25'	
	30	9 15 16	POORLY GRADED SAND (SP): Brown, fine-grained sand, dry, no hydrocarbon odor, (0,100,0).	0	MW-1 @30'	
The substrata descriptions above are generalized representations and based upon visual/manual classification of cuttings and/or samples obtained during drilling. Predominant material types shown on the log may contain different materials and the change from one predominant material type to another could be different than indicated. Descriptions on this log apply only at the specific location at the time of drilling and may not be representative of subsurface conditions at other locations or times.						

Project No. 77CP.65018.00.0009 Date 6/29/05 RP


5018 MW1-3.GPJ  
LOG OF BOREHOLE

Log of Well

Figure

(sheet 1 of 2)



Logged By:	Date Drilled:	Drilling Contractor	Project Name:		Method/Equipment:		Well Number:	
RP	5/26/05	CASCADE	Circle K Store #05018 Atwater, California		HSA CA SPLIT SPOON		MW-1	
		Boring Diam.(in.): 8	Surface Elev.(ft.):	Groundwater Depth (ft.): ▽ 50.5 First Water ▽ 41.5 Static Water	Total Depth (ft.): 60.5	Drive wt.(lbs.): 140	Drop Dist.(ft.): 30	
Well Construction	Depth (ft.)	Sample Recovery Blows/6"	Description				PID [PPM]	SAMPLE NAME
	35	9 12 12	SILTY SAND (SM): Yellowish brown, medium to fine-grained well graded sand, moist, moderately cemented, no hydrocarbon odor, (0,85,15).				0	MW-1 @35'
	40	10 10 13	POORLY GRADED SAND (SP): Brown, fine-grained sand, moist, no hydrocarbon odor, (0,100,0).				0	MW-1 @40'
	45	11 11 15	SILTY SAND (SM): Reddish brown, medium to fine-grained sand, moist, moderately cemented, no hydrocarbon odor, (0,75,25).				0	MW-1 @45'
	50	10 14 16	Same as above.				0	MW-1 @50'
	55	10 10 12	WELL GRADED SAND (SW): Yellowish brown to olive brown, coarse to fine-grained sand, saturated, no hydrocarbon odor, (0,95,5).				0	MW-1 @55'
	60	9 11 12	Same as above, very micaceous, heaving sands.				0	MW-1 @60'
The substrata descriptions above are generalized representations and based upon visual/manual classification of cuttings and/or samples obtained during drilling. Predominant material types shown on the log may contain different materials and the change from one predominant material type to another could be different than indicated. Descriptions on this log apply only at the specific location at the time of drilling and may not be representative of subsurface conditions at other locations or times.								

Project No. 77CP.65018.00.0009 Date 6/29/05 RP

5018 MW1-3.GPJ  
LOG OF BOREHOLE

Log of Well

Figure

(sheet 2 of 2)

HWY 99/APPLEGATE INTERCHANGE  
P.M. 15.60



Logged By:	Date Drilled:	Drilling Contractor	Project Name:	Method/Equipment:	Well Number:	
RP	5/26/05	CASCADE	Circle K Store #05018 Atwater, California	HSA CA SPLIT SPOON	MW-2	
		Boring Diam.(in.): 8	Surface Elev.(ft.): 50.5 First Water 47 Static Water	Total Depth (ft.): 56.0	Drive wt.(lbs.): 140	Drop Dist.(in.): 30
Well Construction	Depth (ft.)	Sample Recovery Blows/6"	Description	PID [PPM]	SAMPLE NAME	
8" Well Box Concrete			ASPHALT			
			POORLY GRADED SAND (SP): Brown, fine-grained sand, dry, loose, no hydrocarbon odor, (0,100,0).			
	5	12 16 17	Same as above, strongly cemented hardpan, (0,95,5).	0	MW-2 @5'	
Neat Cement	10	11 12 14	SILTY SAND (SM): Grayish brown, fine-grained sand, dry, no hydrocarbon odor, (0,80,20).	0	MW-2 @10'	
2" SCH. 40 PVC Blank	15	11 13 14	POORLY GRADED SAND (SP): Light yellowish brown, fine-grained sand, dry, no hydrocarbon odor, (0,95,5).	0	MW-2 @15'	
	20	12 12 13	Same as above, light gray, (0,100,0).	0	MW-2 @19'	
			SILTY SAND (SM): Light reddish brown, fine-grained sand, dry, moderately cemented, no hydrocarbon odor, (0,75,25).	0	MW-2 @20'	
	25	15 16 17	SILTY SAND (SM): Reddish brown, fine-grained sand, dry, strongly cemented, no hydrocarbon odor, (0,85,15).	0	MW-2 @25'	
Bentonite	30	13 15 17	Same as above, medium to fine-grained sand, moist, moderately cemented.	0	MW-2 @30'	
The substrata descriptions above are generalized representations and based upon visual/manual classification of cuttings and/or samples obtained during drilling. Predominant material types shown on the log may contain different materials and the change from one predominant material type to another could be different than indicated. Descriptions on this log apply only at the specific location at the time of drilling and may not be representative of subsurface conditions at other locations or times.						

Project No. 77CP.65018.00.0009 Date 6/29/05 RP

Log of Well

5018 MW1-3.GPJ  
LOG OF BOREHOLE

Figure

(sheet 1 of 2)



Logged By:	Date Drilled:	Drilling Contractor	Project Name:		Method/Equipment:		Well Number:	
RP	5/26/05	CASCADE	Circle K Store #05018 Atwater, California		HSA CA SPLIT SPOON		MW-2	
		Boring Diam.(in.):	Surface Elev.(ft.):	Groundwater Depth (ft.):	Total Depth (ft.):	Drive wt.(lbs.):	Drop Dist.(in.):	
		8		50.5 First Water 47 Static Water	56.0	140	30	
Well Construction	Depth (ft.)	Sample Recovery	Blows/6"	Description			PID [PPM]	SAMPLE NAME
	35		14 15 20	Same as above, tough drilling.			0	MW-2 @35'
	40		12 14 16	POORLY GRADED SAND (SP): Brown, 20% medium 80% fine-grained sand, moist, no hydrocarbon odor, (0,95,5).			0	MW-2 @40'
	45		12 12 14	SILTY SAND (SM): Reddish brown, poorly graded medium to fine-grained sand, moist, tough drilling, no hydrocarbon odor, (0,60,40).			0	MW-2 @45'
	50		11 13 13	Same as above, wet.			0	MW-2 @50'
	55		12 14 16	POORLY GRADED SAND (SP): Yellowish brown to olive brown, fine-grained sand, saturated, no hydrocarbon odor, (0,95,5).			0	MW-2 @56'
	60			Same as above.			0	MW-2 @56'

The substrata descriptions above are generalized representations and based upon visual/manual classification of cuttings and/or samples obtained during drilling. Predominant material types shown on the log may contain different materials and the change from one predominant material type to another could be different than indicated. Descriptions on this log apply only at the specific location at the time of drilling and may not be representative of subsurface conditions at other locations or times.

Project No. 77CP.65018.00.0009 Date 6/29/05 RP

Log of Well

5018 MW1-3.GPJ  
LOG OF BOREHOLE

Figure

(sheet 2 of 2)

HWY 99/APPLEGATE INTERCHANGE  
P.M. 15.60



Logged By:	Date Drilled:	Drilling Contractor	Project Name:	Method/Equipment:	Well Number:
RP	5/27/05	CASCADE	Circle K Store #05018 Atwater, California	HSA CA SPLIT SPOON	MW-3
		Boring Diam.(in.):	Surface Elev.(ft.):	Groundwater Depth (ft.):	Total Depth (ft.):
		8		47 First Water 42 Static Water	55.5
				Drive wt.(lbs.):	Drop Dist.(in.):
				140	30
Well Construction	Depth (ft.)	Sample Recovery	Blows/6'	Description	PID [PPM] SAMPLE NAME
8" Well Box Concrete				ASPHALT POORLY GRADED SAND (SP): Brown, fine-grained sand, dry, loose, no hydrocarbon odor, (0,100,0).	
	5	10 11 15		Same as above, dark brown, moderately cemented, (0,95,5).	0 MW-3 @5'
Neat Cement	10	12 12 14		SILTY SAND (SM): Yellowish brown, fine-grained sand, dry, no hydrocarbon odor, (0,80,20).	0 MW-3 @10'
	15	15 16 22		Same as above, brown, damp.	0 MW-3 @15'
2" SCH. 40 PVC Blank	20	12 15 16		Same as above, yellowish brown and gray, (0,60,40).	0 MW-3 @20'
	25	12 12 14		Same as above, red, moderately cemented, (0,85,15).	0 MW-3 @25'
Bentonite	30	13 16 18		POORLY GRADED SAND (SP): Orangish brown, fine-grained sand, moist, no hydrocarbon odor, (0,95,5).	0 MW-3 @30'
The substrate descriptions above are generalized representations and based upon visual/manual classification of cuttings and/or samples obtained during drilling. Predominant material types shown on the log may contain different materials and the change from one predominant material type to another could be different than indicated. Descriptions on this log apply only at the specific location at the time of drilling and may not be representative of subsurface conditions at other locations or times.					

Project No. 77CP.65018.00.0009 Date 6/29/05 RP

5018 MW1-3.GPJ  
LOG OF BOREHOLE

Log of Well

Figure

(sheet 1 of 2)



Logged By:	Date Drilled:	Drilling Contractor	Project Name:	Method/Equipment:	Well Number:
RP	5/27/05	CASCADE	Circle K Store #05018 Atwater, California	HSA CA SPLIT SPOON	MW-3
		Boring Diam.(in.):	Surface Elev.(ft.):	Groundwater Depth (ft.):	Total Depth (ft.):
		8		47 First Water 42 Static Water	55.5
				Drive wt.(lbs.):	Drop Dist.(in.):
				140	30
Well Construction	Depth (ft.)	Sample Recovery	Blows/6'	Description	PID [PPM] SAMPLE NAME
Bentonite				SILTY SAND (SM): Orangish brown, medium to fine-grained sand, moist, moderately cemented, no hydrocarbon odor, (0,85,15).	0 MW-3 @35'
#2/12 Sand	35	10 11 15		Same as above.	0 MW-3 @40'
2" SCH. 40 PVC 0.020" Slotted Screen	40	12 14 14		Same as above, light yellowish brown, fine-grained sand, not cemented, (0,70,30).	0 MW-3 @45'
	45	10 12 14		Same as above, saturated.	0 MW-3 @50'
	50	10 10 14			0 MW-3 @55'
Threaded End Cap	55	8 11 12		WELL GRADED SAND (SW): Yellowish brown, coarse to fine-grained sand, saturated, heaving sands, no hydrocarbon odor, (0,100,0).	0 MW-3 @55'
	60				
The substrate descriptions above are generalized representations and based upon visual/manual classification of cuttings and/or samples obtained during drilling. Predominant material types shown on the log may contain different materials and the change from one predominant material type to another could be different than indicated. Descriptions on this log apply only at the specific location at the time of drilling and may not be representative of subsurface conditions at other locations or times.					

Project No. 77CP.65018.00.0009 Date 6/29/05 RP

5018 MW1-3.GPJ  
LOG OF BOREHOLE

Log of Well


Figure

(sheet 2 of 2)


HWY 99/APPLEGATE INTERCHANGE  
P.M. 15.60



DATE WRITTEN MOY 16, 1961

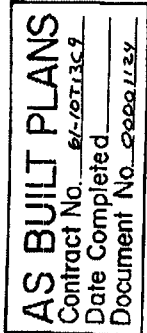


THIS SET OF PLANS HAS BEEN CORRECTED TO  
CORRESPOND TO THE "AS BUILT" PRINTS DATE  
4/15/61. AS SUBMITTED BY RESIDENT  
ENGINEER R. HIRAWAKA A.D.C.  
TRACINGS CORRECTED BY: G.W. DATE: 6/1/62

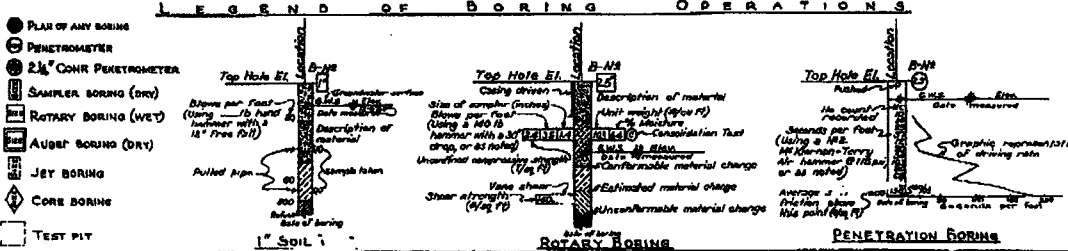

<p align="center"><b>NOTES</b></p> <p>Classification of work indicated as being on this sheet is based upon field inspection and is not to be construed to imply mechanical analysis.</p> <p align="center">STATE OF CALIFORNIA DEPARTMENT OF PUBLIC WORKS DIVISION OF HIGHWAYS</p> <p align="center"><u>RTE 4422 SEPARATION</u></p> <p align="center"><b>LOG OF TEST BORINGS</b></p>	
SCALE 1"=10' BORE 38-1384 FILE E-39	DRAWING C-975-10


I HEREBY CERTIFY THAT THIS IS A TRUE AND ACCURATE COPY OF THE ABOVE DOCUMENT TAKEN UNDER MY DIRECTION AND CONTROL ON THIS DATE IN SACRAMENTO, CALIFORNIA PURSUANT TO AUTHORIZATION BY THE DIRECTOR OF PUBLIC WORKS.

DATE 1-22-44 SIGNATURE [Signature] TITLE Asst. Dir.

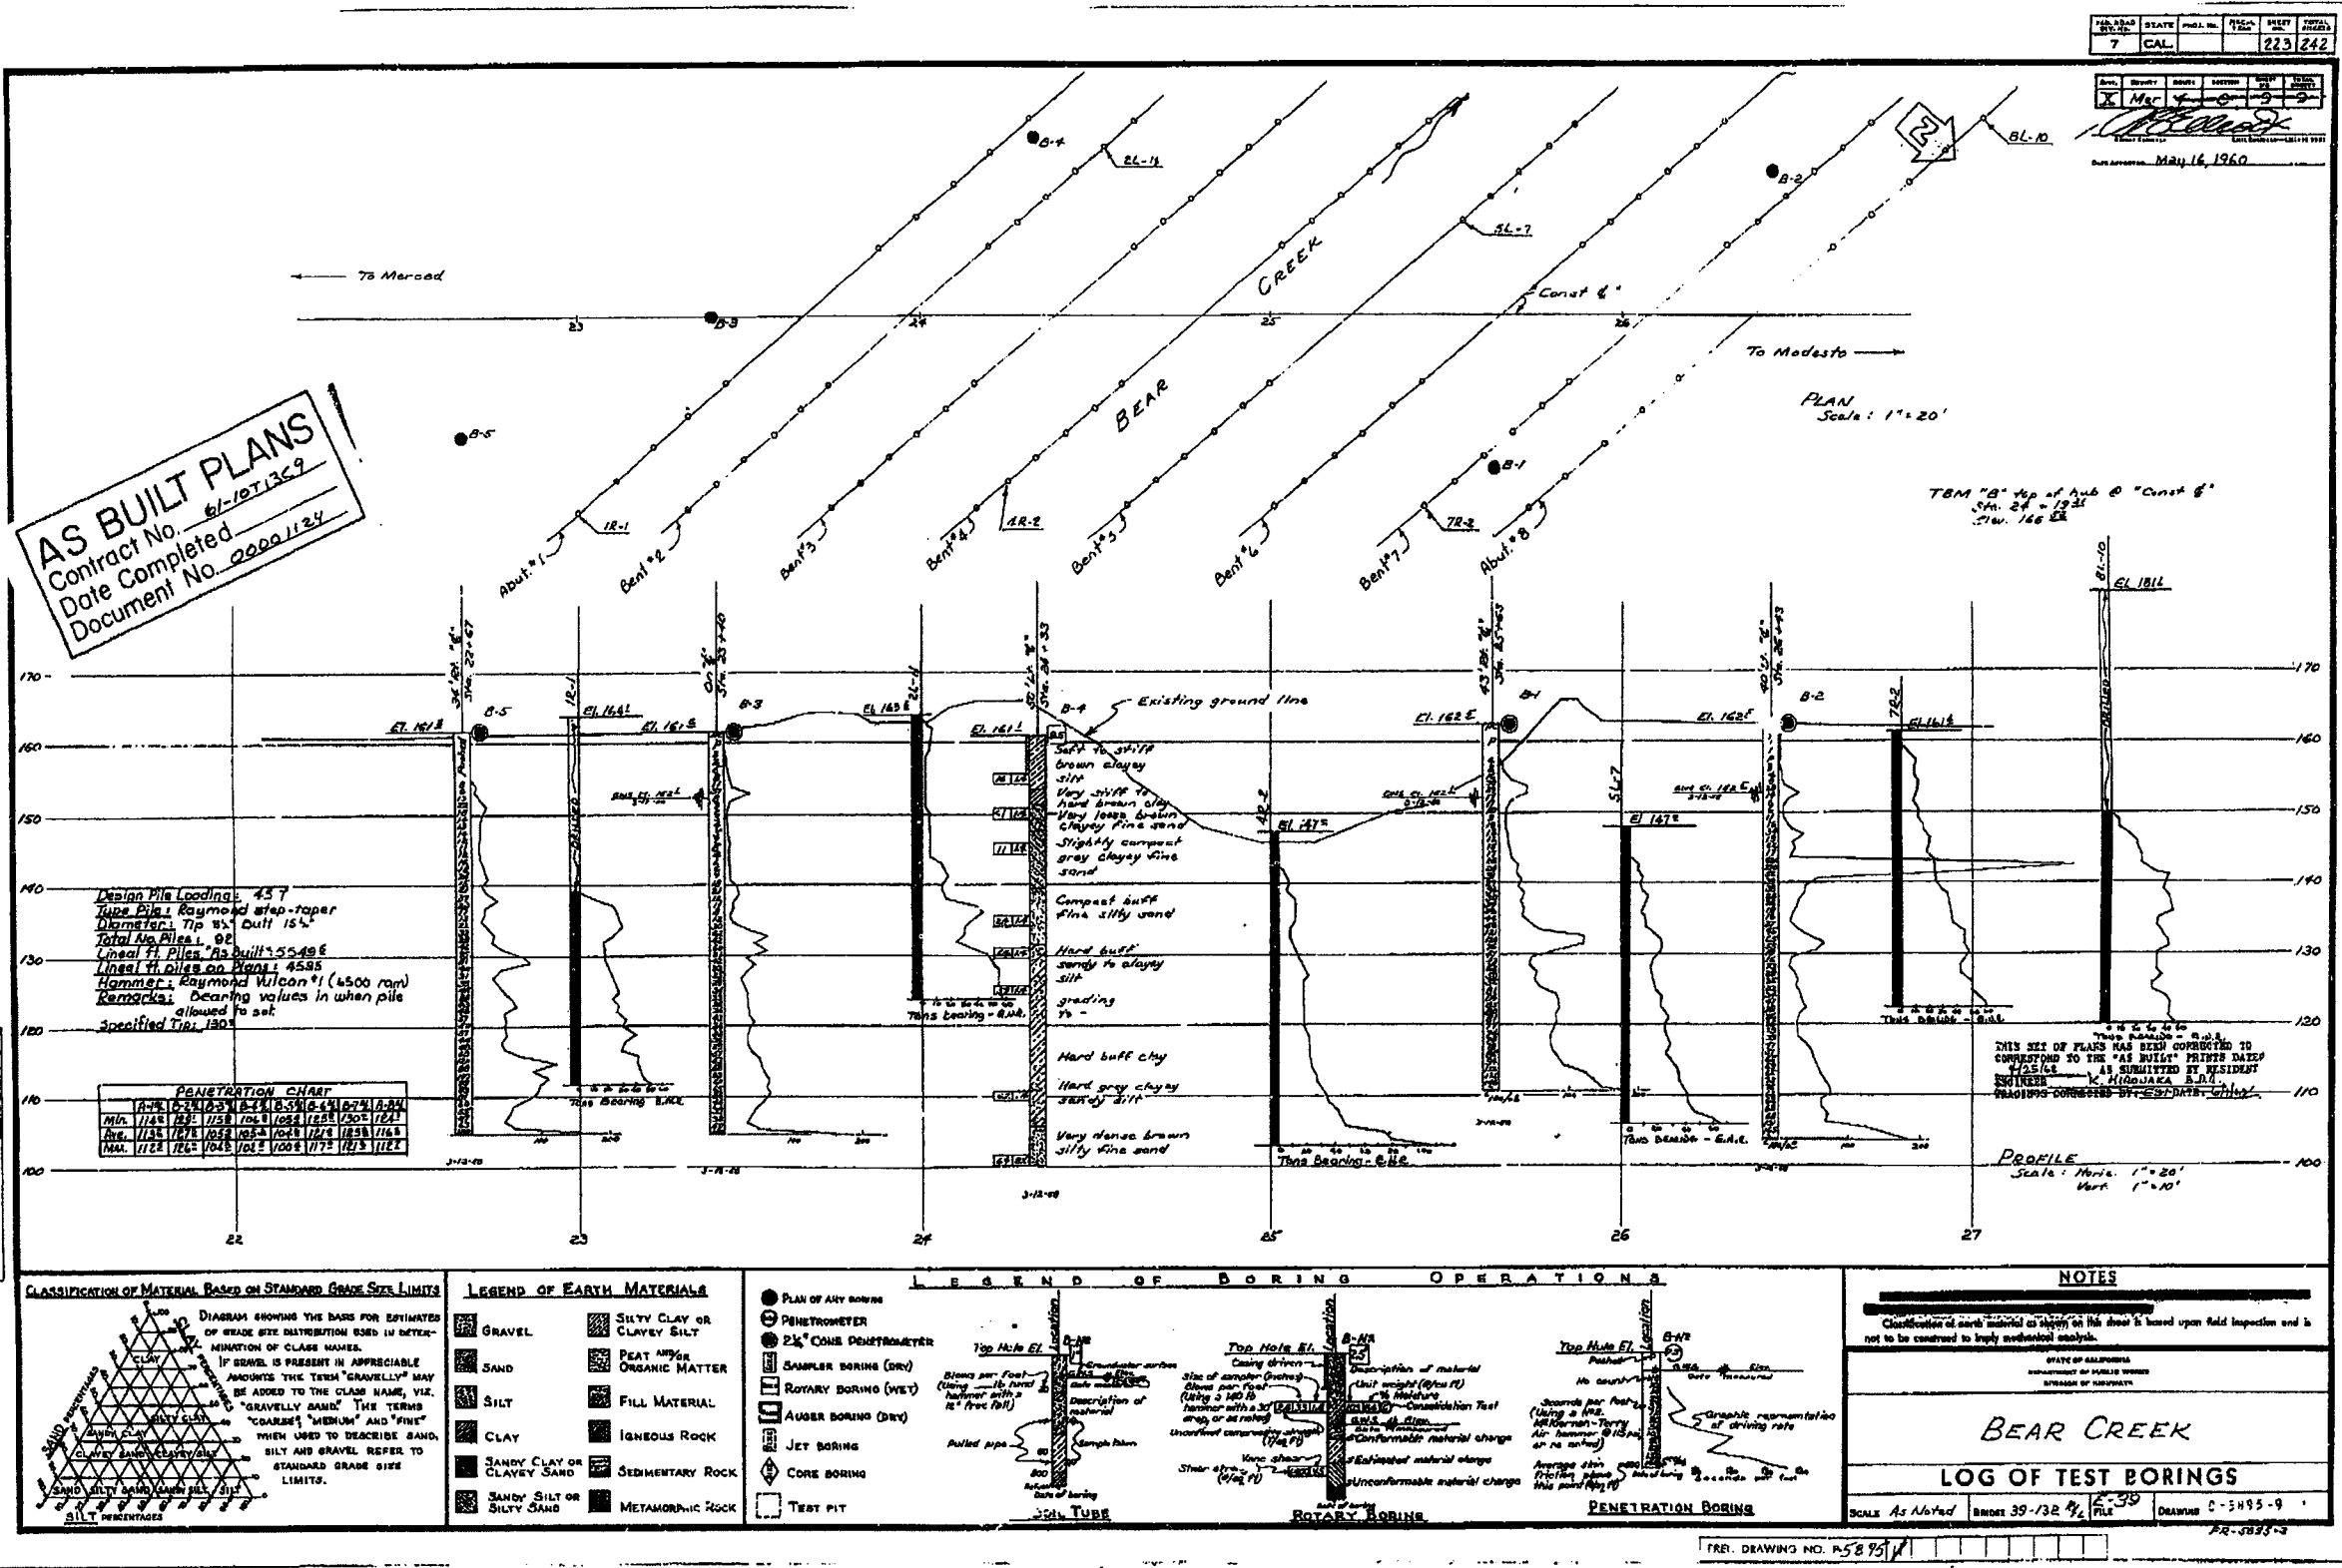


I HEREBY CERTIFY THAT THIS IS A TRUE AND ACCURATE COPY OF THE ABOVE DOCUMENT TAKEN UNDER MY DIRECTION AND CONTROL ON THIS DATE IN SACRAMENTO, CALIFORNIA PURSUANT TO AUTHORIZATION BY THE DIRECTOR OF PUBLIC WORKS.

DATE: 11/11/60 SIGNATURE: [Signature] TITLE: [Title]

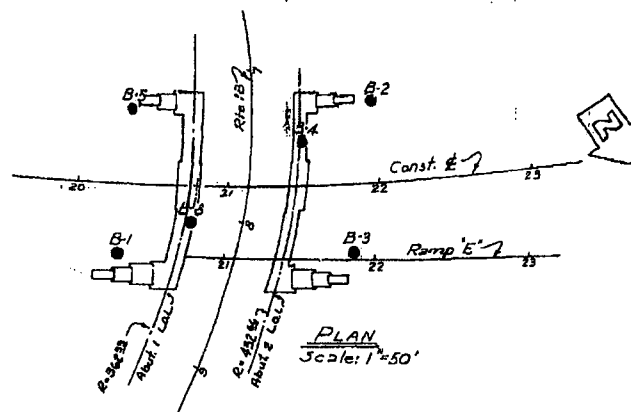

**AS BUILT PLANS**  
 Contract No. 61-10T13C9  
 Date Completed  
 Document No. 00001124

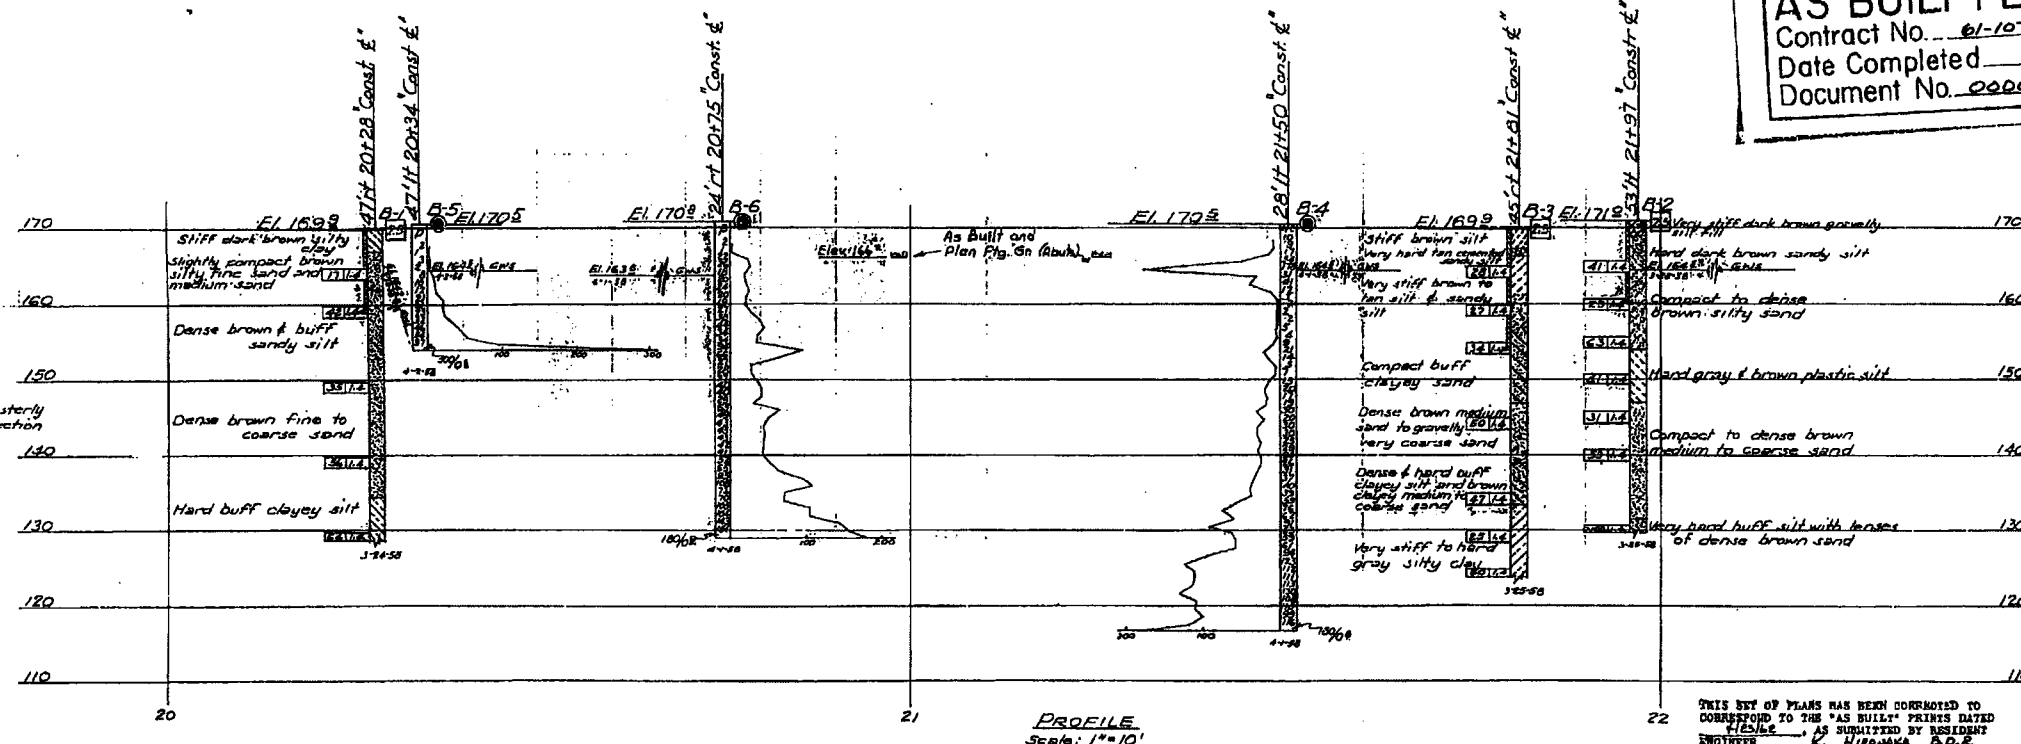


BM Mon 12

Located in gutter at Easterly  
 traffic island at intersection  
 Hwy 99 & Bennett Ave.  
 Elev 171.46

THIS SET OF PLANS HAS BEEN CORRECTED TO  
 CORRESPOND TO THE "AS BUILT" PRINTS DATED  
 1/25/68. AS SUBMITTED BY SUBMITTER  
 ENGINEER P. HIRAKAWA, P.E.  
 TRACINGS CORRECTED BY: G.W. DAVIS, S.E.


# CLASSIFICATION OF MATERIAL BASED ON STANDARD GRADE SIZE LIMITS

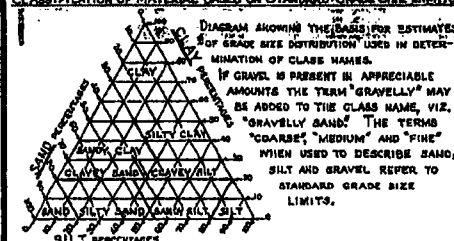

# LEGEND OF EARTH MATERIALS

GRAVEL	SILTY CLAY OR CLAYEY SILT
SAND	PEAT AND/OR ORGANIC MATTER
SILT	FILL MATERIAL
CLAY	IGNEOUS ROCK
SANDY CLAY OR CLAYEY SAND	SEDIMENTARY ROCK
SANDY SILT OR SILTY SAND	METAMORPHIC ROCK

# LEGEND OF BORING OPERATIONS

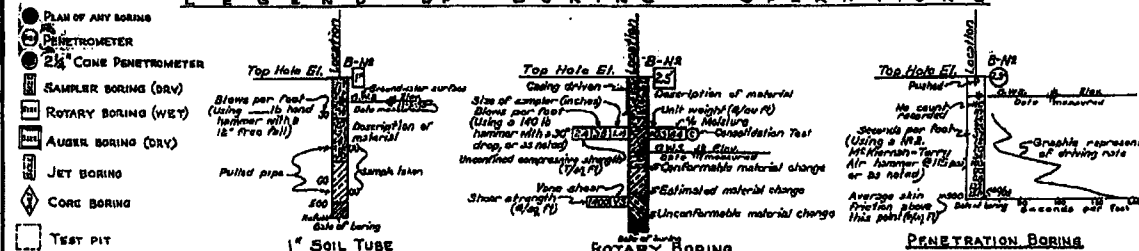

# NOTES

STATE OF CALIFORNIA  
 DEPARTMENT OF PUBLIC WORKS  
 DIVISION OF HIGHWAYS


**RTE 99 SEPARATION**

**LOG OF TEST BORINGS**


SCALE As shown BRIDGE 38-140 R/L FILE C-6007-11 DRAWING C-6007-3

I HEREBY CERTIFY THAT THIS IS A TRUE AND ACCURATE COPY OF THE ABOVE DOCUMENT TAKEN  
 UNDER MY DIRECTION AND CONTROL ON THIS DATE IN SACRAMENTO, CALIFORNIA PURSUANT TO  
 AUTHORIZATION BY THE DIRECTOR OF PUBLIC WORKS.

DATE: 1/25/68 SIGNATURE: P. HIRAKAWA TITLE: ENGINEER

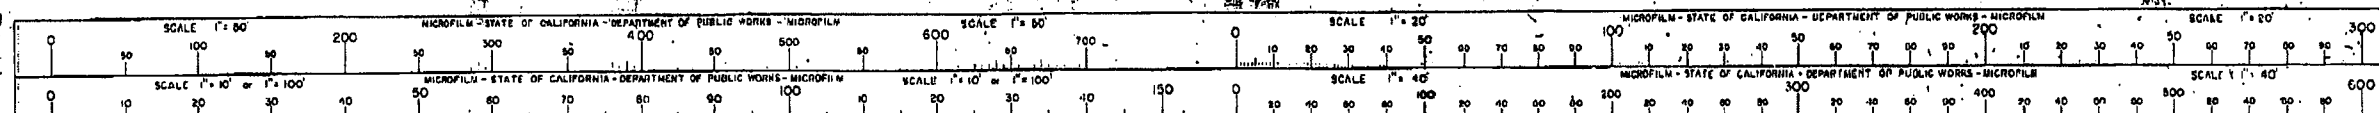




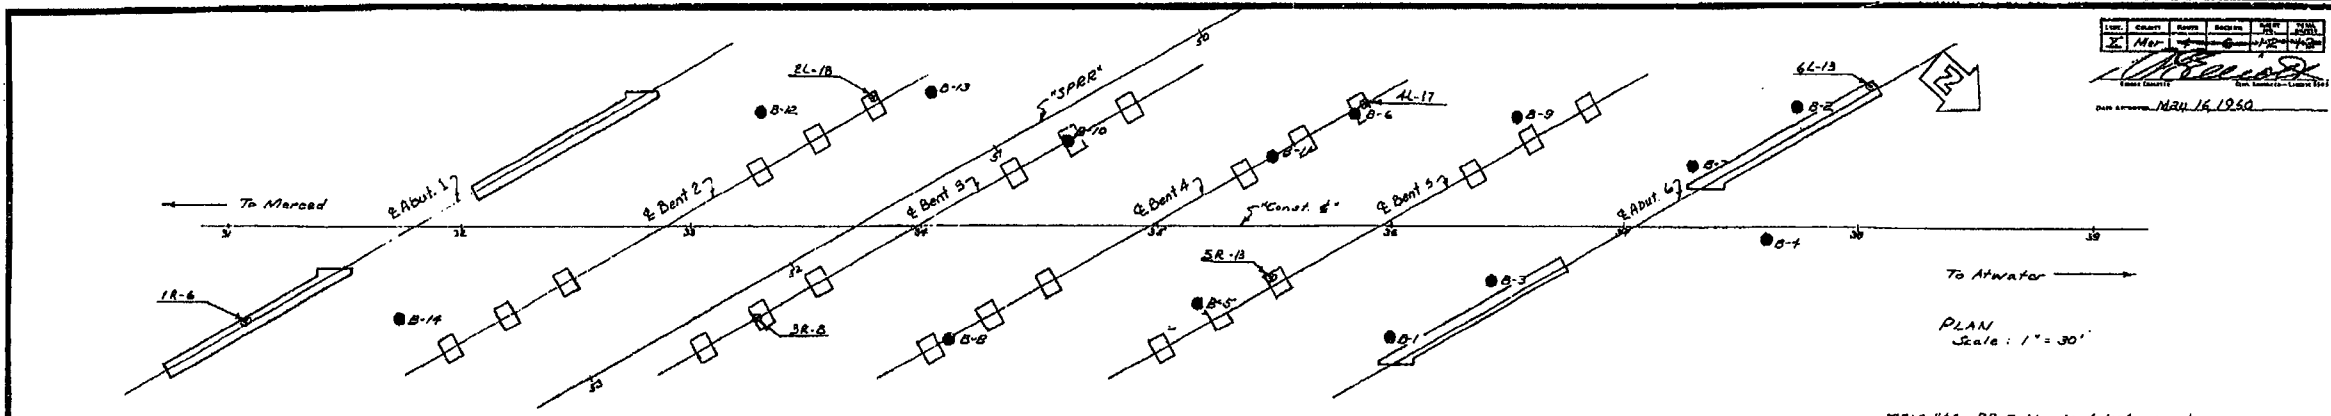

**AS BUILT PLANS**  
 Contract No. 61-OT13C9  
 Date Completed \_\_\_\_\_  
 Document No. 00001124

TBM "A" RR Spike in telephone pole  
 34' x 4" LT. SPOR 2952 + 30 ±  
 Elev. 161.81

BM - Mon #33 - 367' ± of Sta. 20+99 ±  
 "Const. 6" Elev. 162.53

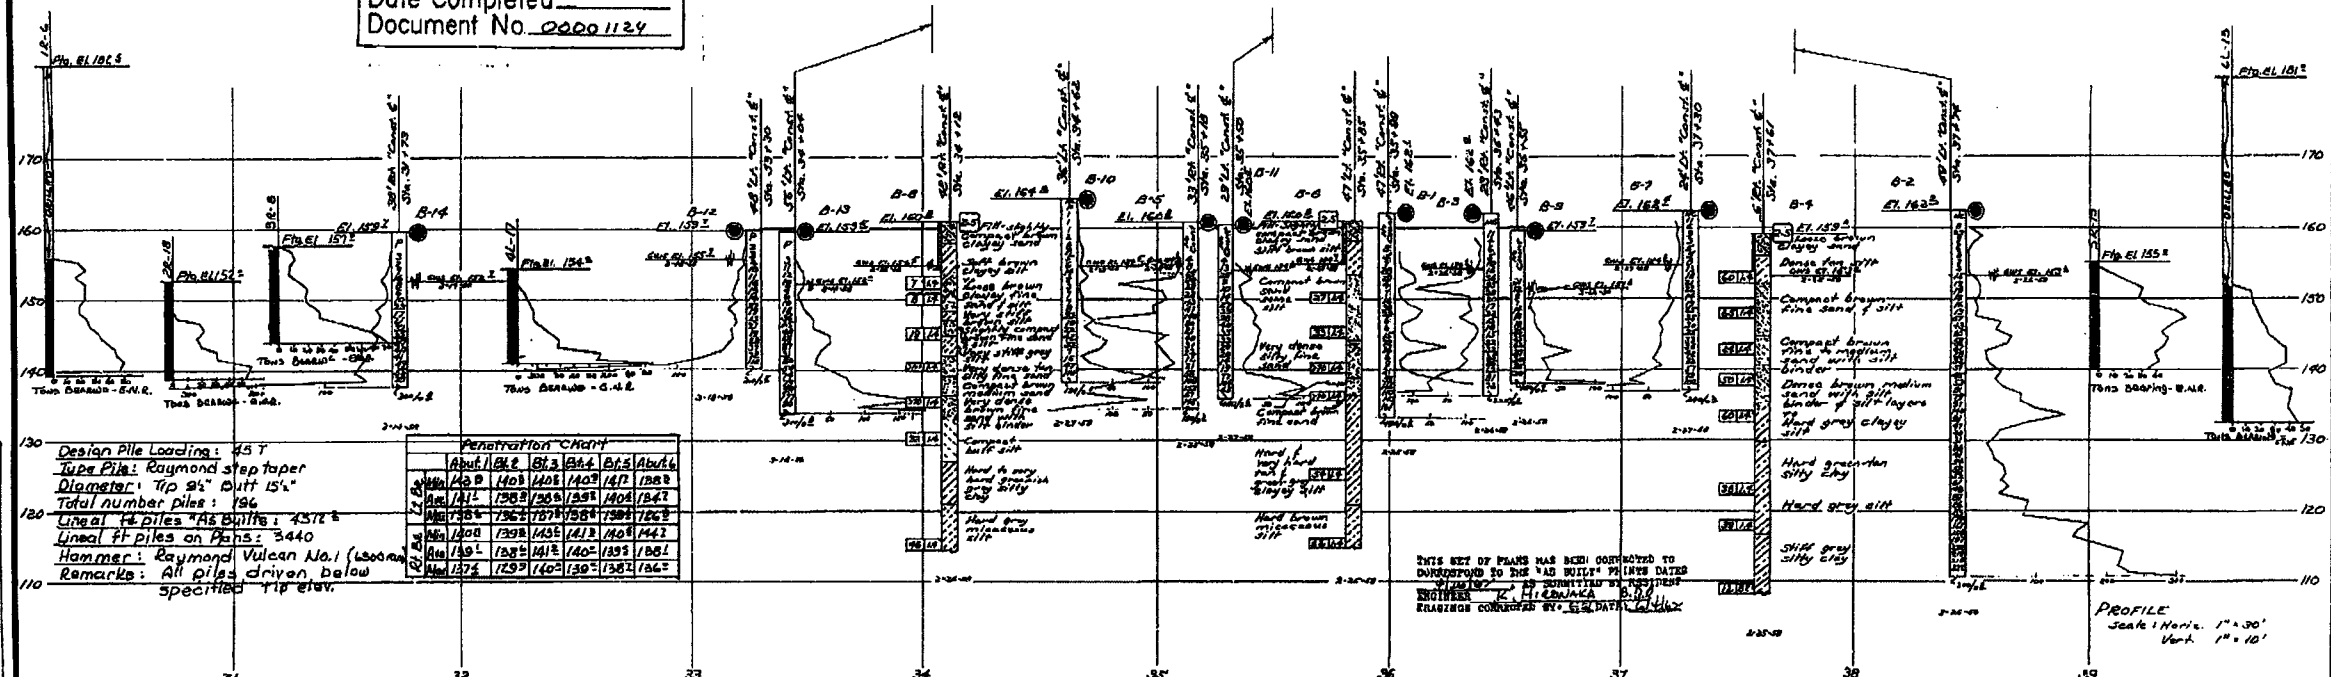

**CLASSIFICATION OF MATERIAL BASED ON STANDARD GRADE SIZE LIMITS**

**LEGEND OF EARTH MATERIALS**

GRAVEL	SILTY CLAY OR CLAYEY SILT
SAND	PEAT AND/OR ORGANIC MATTER
SILT	FILL MATERIAL
CLAY	IGNEOUS ROCK
SANDY CLAY OR CLAYEY SAND	SEDIMENTARY ROCK
SANDY SILT OR SILTY SAND	METAMORPHIC ROCK

**LEGEND OF BORING OPERATIONS**

**NOTES**

Classification of earth material as shown on this sheet is based upon field inspection and is not to be construed to imply mechanical analysis.

STATE OF CALIFORNIA  
 DEPARTMENT OF PUBLIC WORKS  
 DIVISION OF HIGHWAYS

**WEST MERCED OVERHEAD**


**LOG OF TEST BORINGS**

SCALE As Noted BRIDGE 39-131/41 FILE 59 DRAWING C-5839-12  
 PREL. DRAWING NO. P. 5839-12

I HEREBY CERTIFY THAT THIS IS A TRUE AND ACCURATE COPY OF THE ABOVE DOCUMENT TAKEN UNDER MY DIRECTION AND CONTROL ON THIS DATE IN SACRAMENTO, CALIFORNIA PURSUANT TO AUTHORIZATION BY THE DIRECTOR OF PUBLIC WORKS.

DATE \_\_\_\_\_ SIGNATURE \_\_\_\_\_ TITLE \_\_\_\_\_

May 16 1960

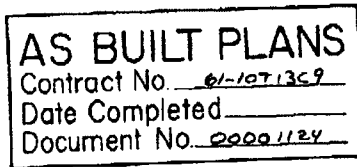


PENETRATION					
Black Russell Canal Rt. Fr. Road					
Min.	118 $\frac{1}{2}$	125 $\frac{1}{2}$	112 $\frac{1}{2}$	121 $\frac{1}{2}$	127 $\frac{1}{2}$
Ave.	118 $\frac{1}{2}$	116 $\frac{1}{2}$	112 $\frac{1}{2}$	116 $\frac{1}{2}$	127 $\frac{1}{2}$
Max.	117 $\frac{1}{2}$	123 $\frac{1}{2}$	113 $\frac{1}{2}$	113 $\frac{1}{2}$	127 $\frac{1}{2}$
	1	2	3	4	5







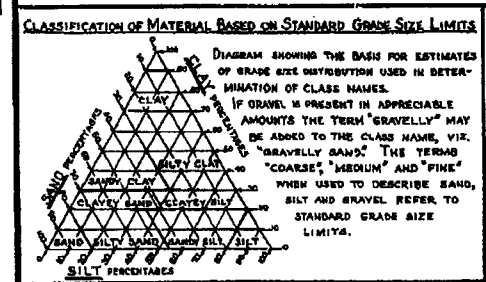





  


Black Russell Canal Br.					
Min.	118 $\frac{1}{2}$	115 $\frac{1}{2}$	112 $\frac{1}{2}$	115 $\frac{1}{2}$	120 $\frac{1}{2}$
Ave.	116 $\frac{1}{2}$	112 $\frac{1}{2}$	112 $\frac{1}{2}$	115 $\frac{1}{2}$	118 $\frac{1}{2}$
Max.	116 $\frac{1}{2}$	112 $\frac{1}{2}$	110 $\frac{1}{2}$	114 $\frac{1}{2}$	117 $\frac{1}{2}$

THIS SET OF PLANS HAS BEEN CONTRIBUTED TO  
CORRESPOND TO THE "AS BUILT" PRINTS DATED  
4/26/62. AS SUBMITTED BY RESIDENT  
ENGINEER R. HIRAWAKA, O.D.C.  
E.LACINGS CONDUCTED BY: E.S./ DATE: 6/6/62



## LEGEND OF EARTH MATERIALS

	GRAVEL		SILTY CLAY OR CLAYEY SILT
	SAND		PEAT AND/OR ORGANIC MATTER
	SILT		FILL MATERIAL
	CLAY		IGNEOUS ROCK
	SANDY CLAY OR CLAYEY SAND		SEDIMENTARY ROCK
	SANDY SILT OR SILTY SAND		METAMORPHIC ROCK

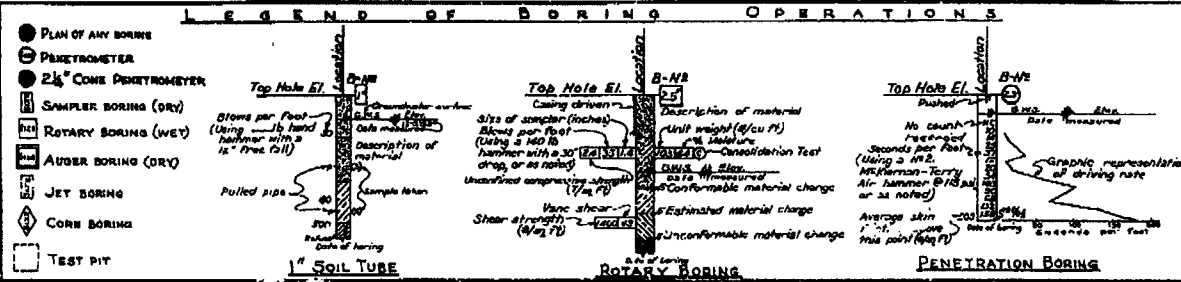


<b>NOTES</b>			
<p>Classification of earth material as shown on this sheet is based upon field inspection and is not to be construed to imply mechanical analysis.</p>			
STATE OF CALIFORNIA DEPARTMENT OF PUBLIC WORKS DIVISION OF HIGHWAYS			
BLACK RASCAL CANAL			
LOG OF TEST BORINGS			
SCALE	As Noted	39-104 L BRIDGE 39C-37	5-39 FILE DRAWING E-6490-7

PR-6436-  
PR-6450-


I HEREBY CERTIFY THAT THIS IS A TRUE AND ACCURATE COPY OF THE ABOVE DOCUMENT TAKEN UNDER MY DIRECTION AND CONTROL ON THIS DATE IN SACRAMENTO, CALIFORNIA PURSUANT TO AUTHORIZATION BY THE DIRECTOR OF PUBLIC WORKS.

DATE 1-24-68 SIGNATURE [Signature] TITLE Asst. Dir.

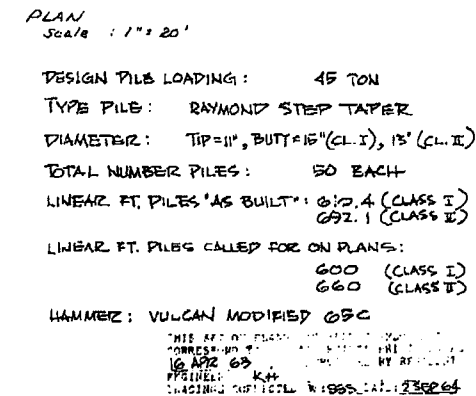

FIELD STAFF	by R. H. Hager
DRAWN	by R. H. Hager
CHECKED	by R. H. Hager

Approved Recommended by: *[Signature]* *10/1/54*  
 SPECIAL AGENT IN CHARGE  
 UNITED STATES DEPARTMENT OF JUSTICE  
 FEDERAL BUREAU OF INVESTIGATION  
 WASHINGTON, D. C.

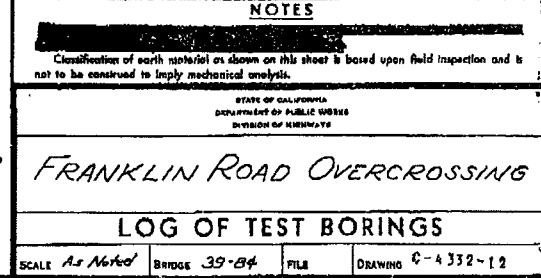

ChPDF - www.fasio.com